
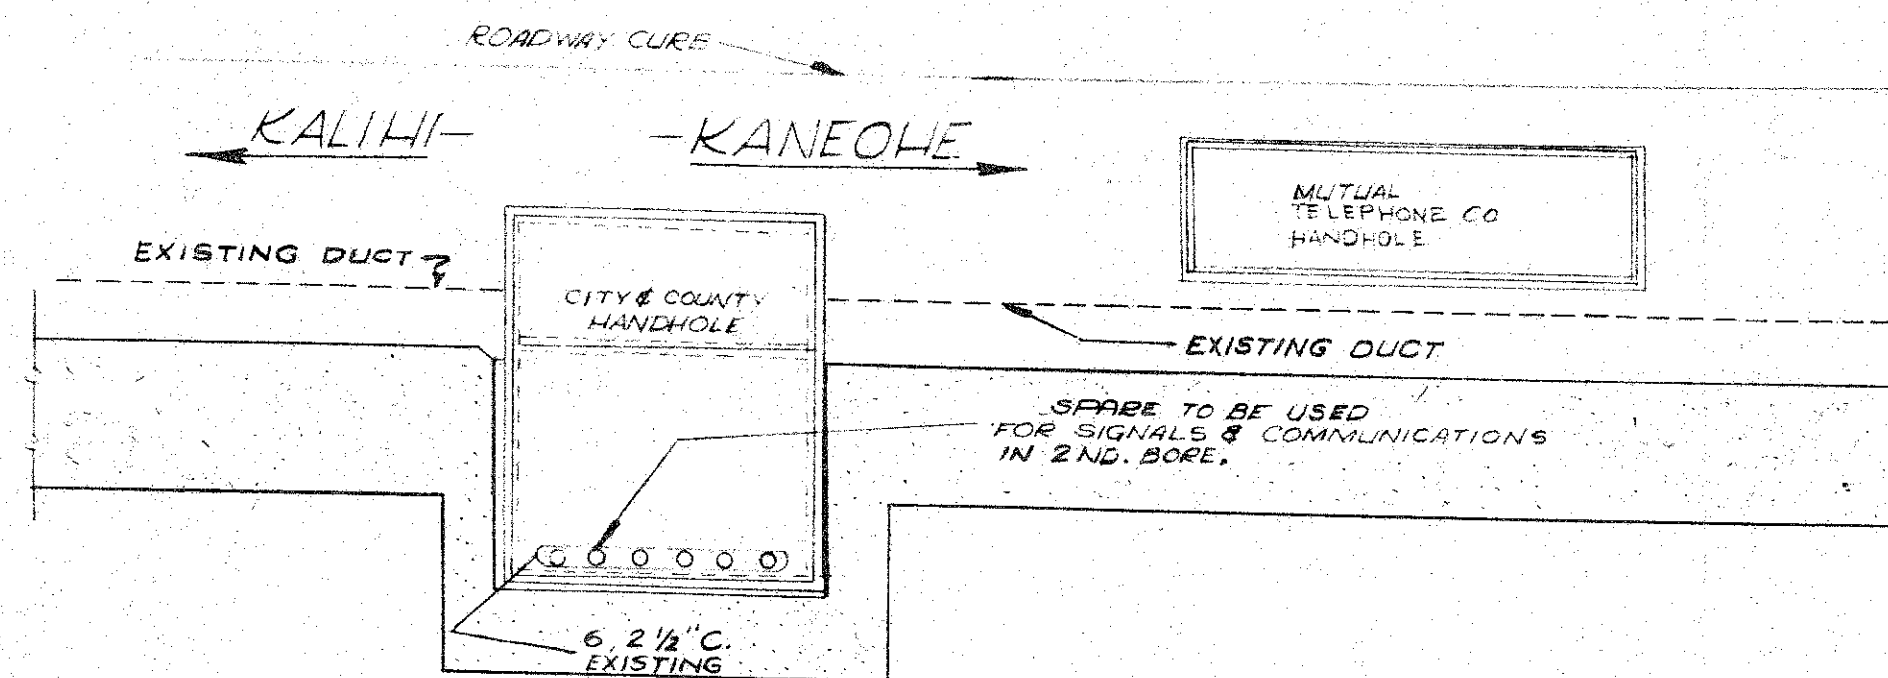
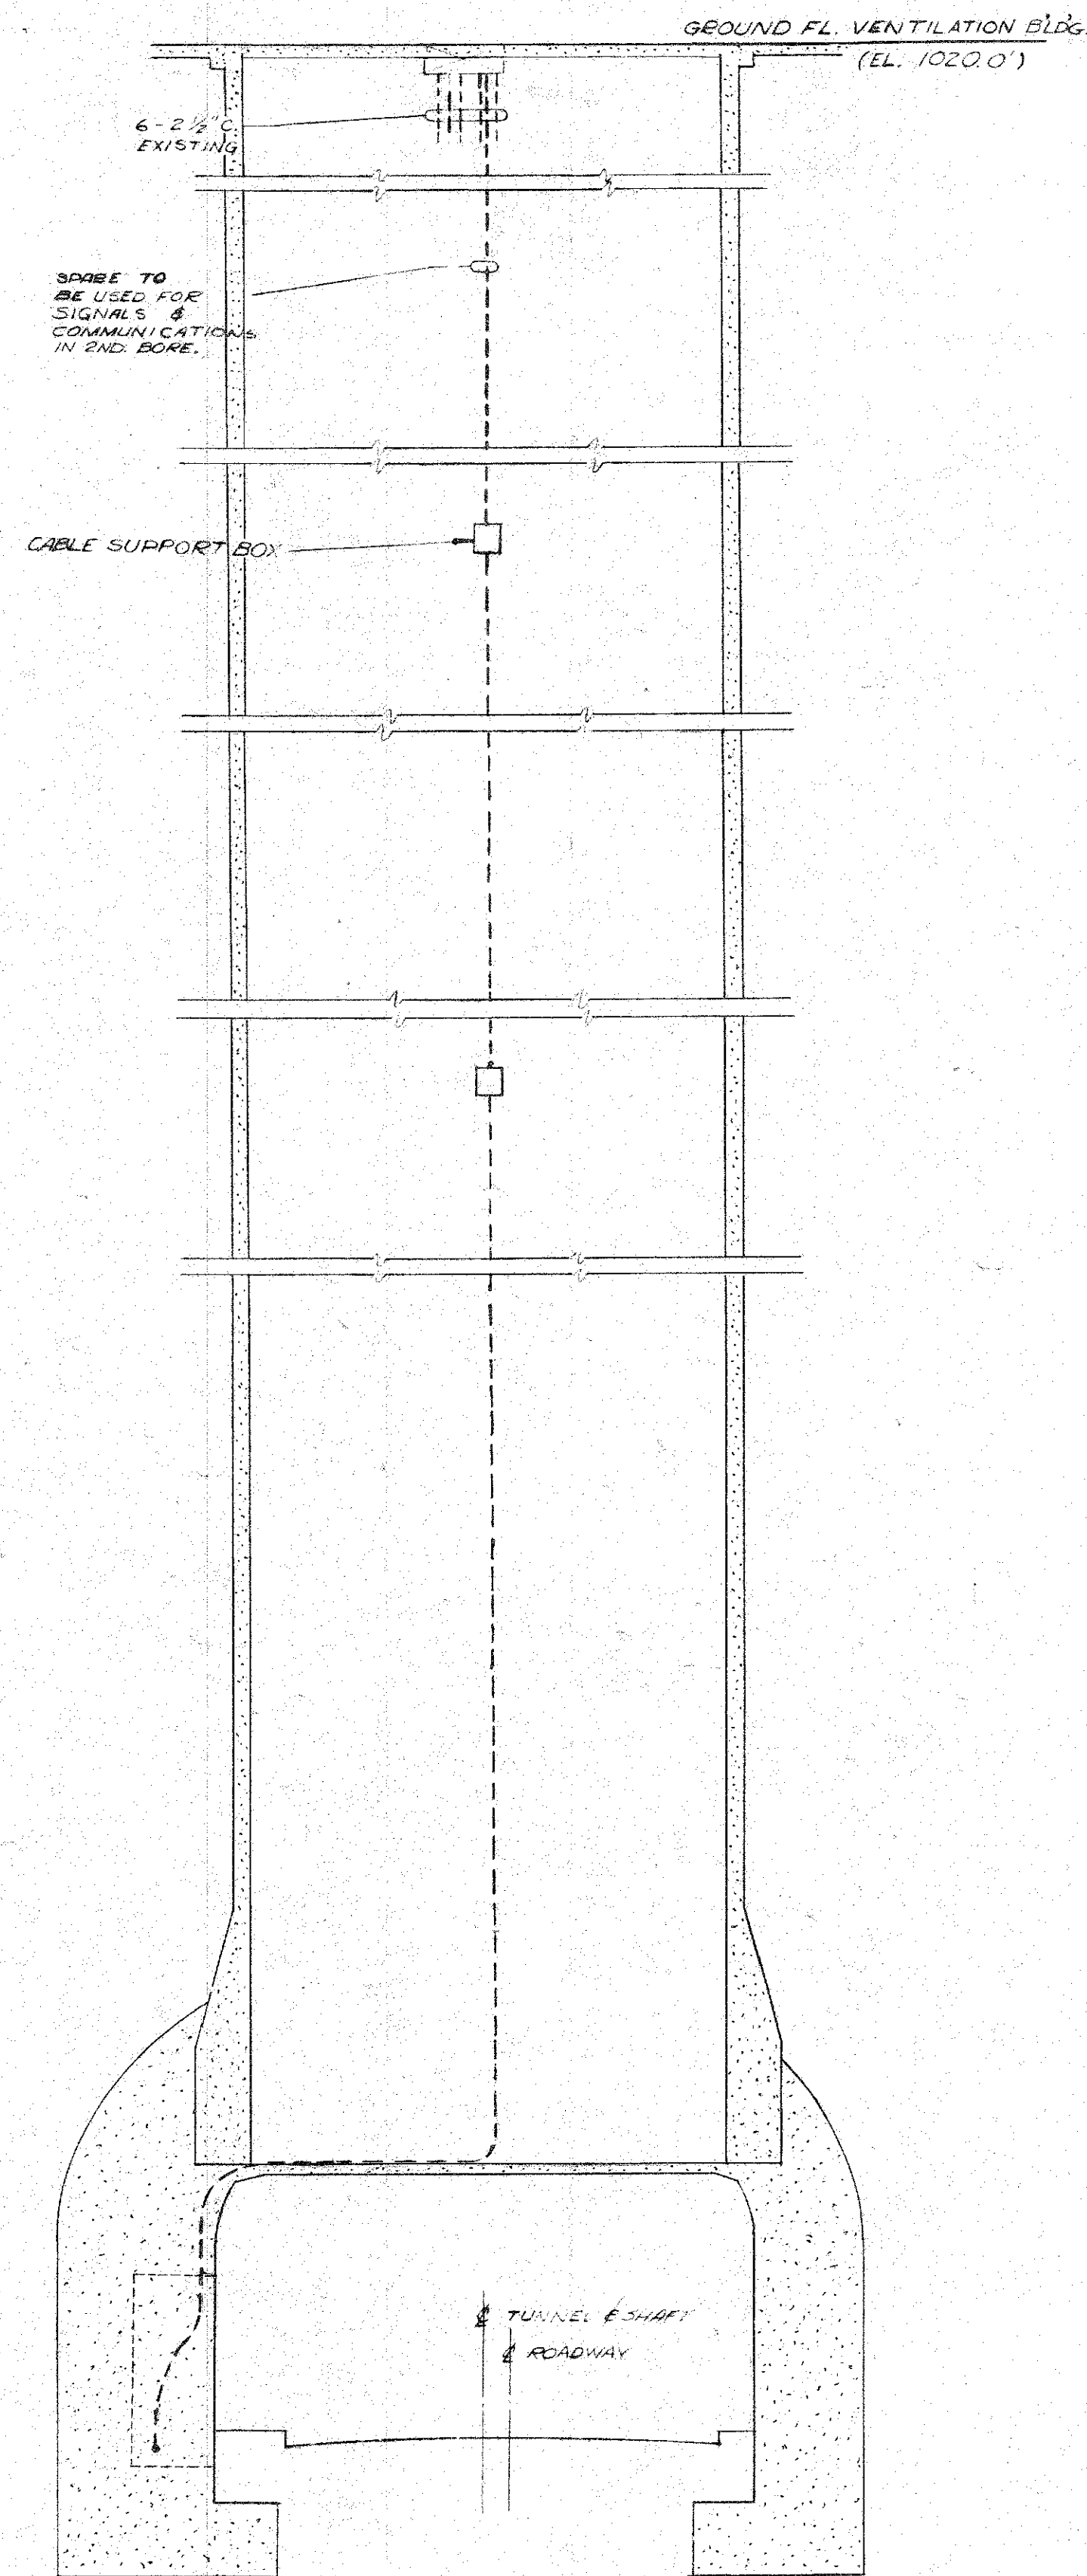


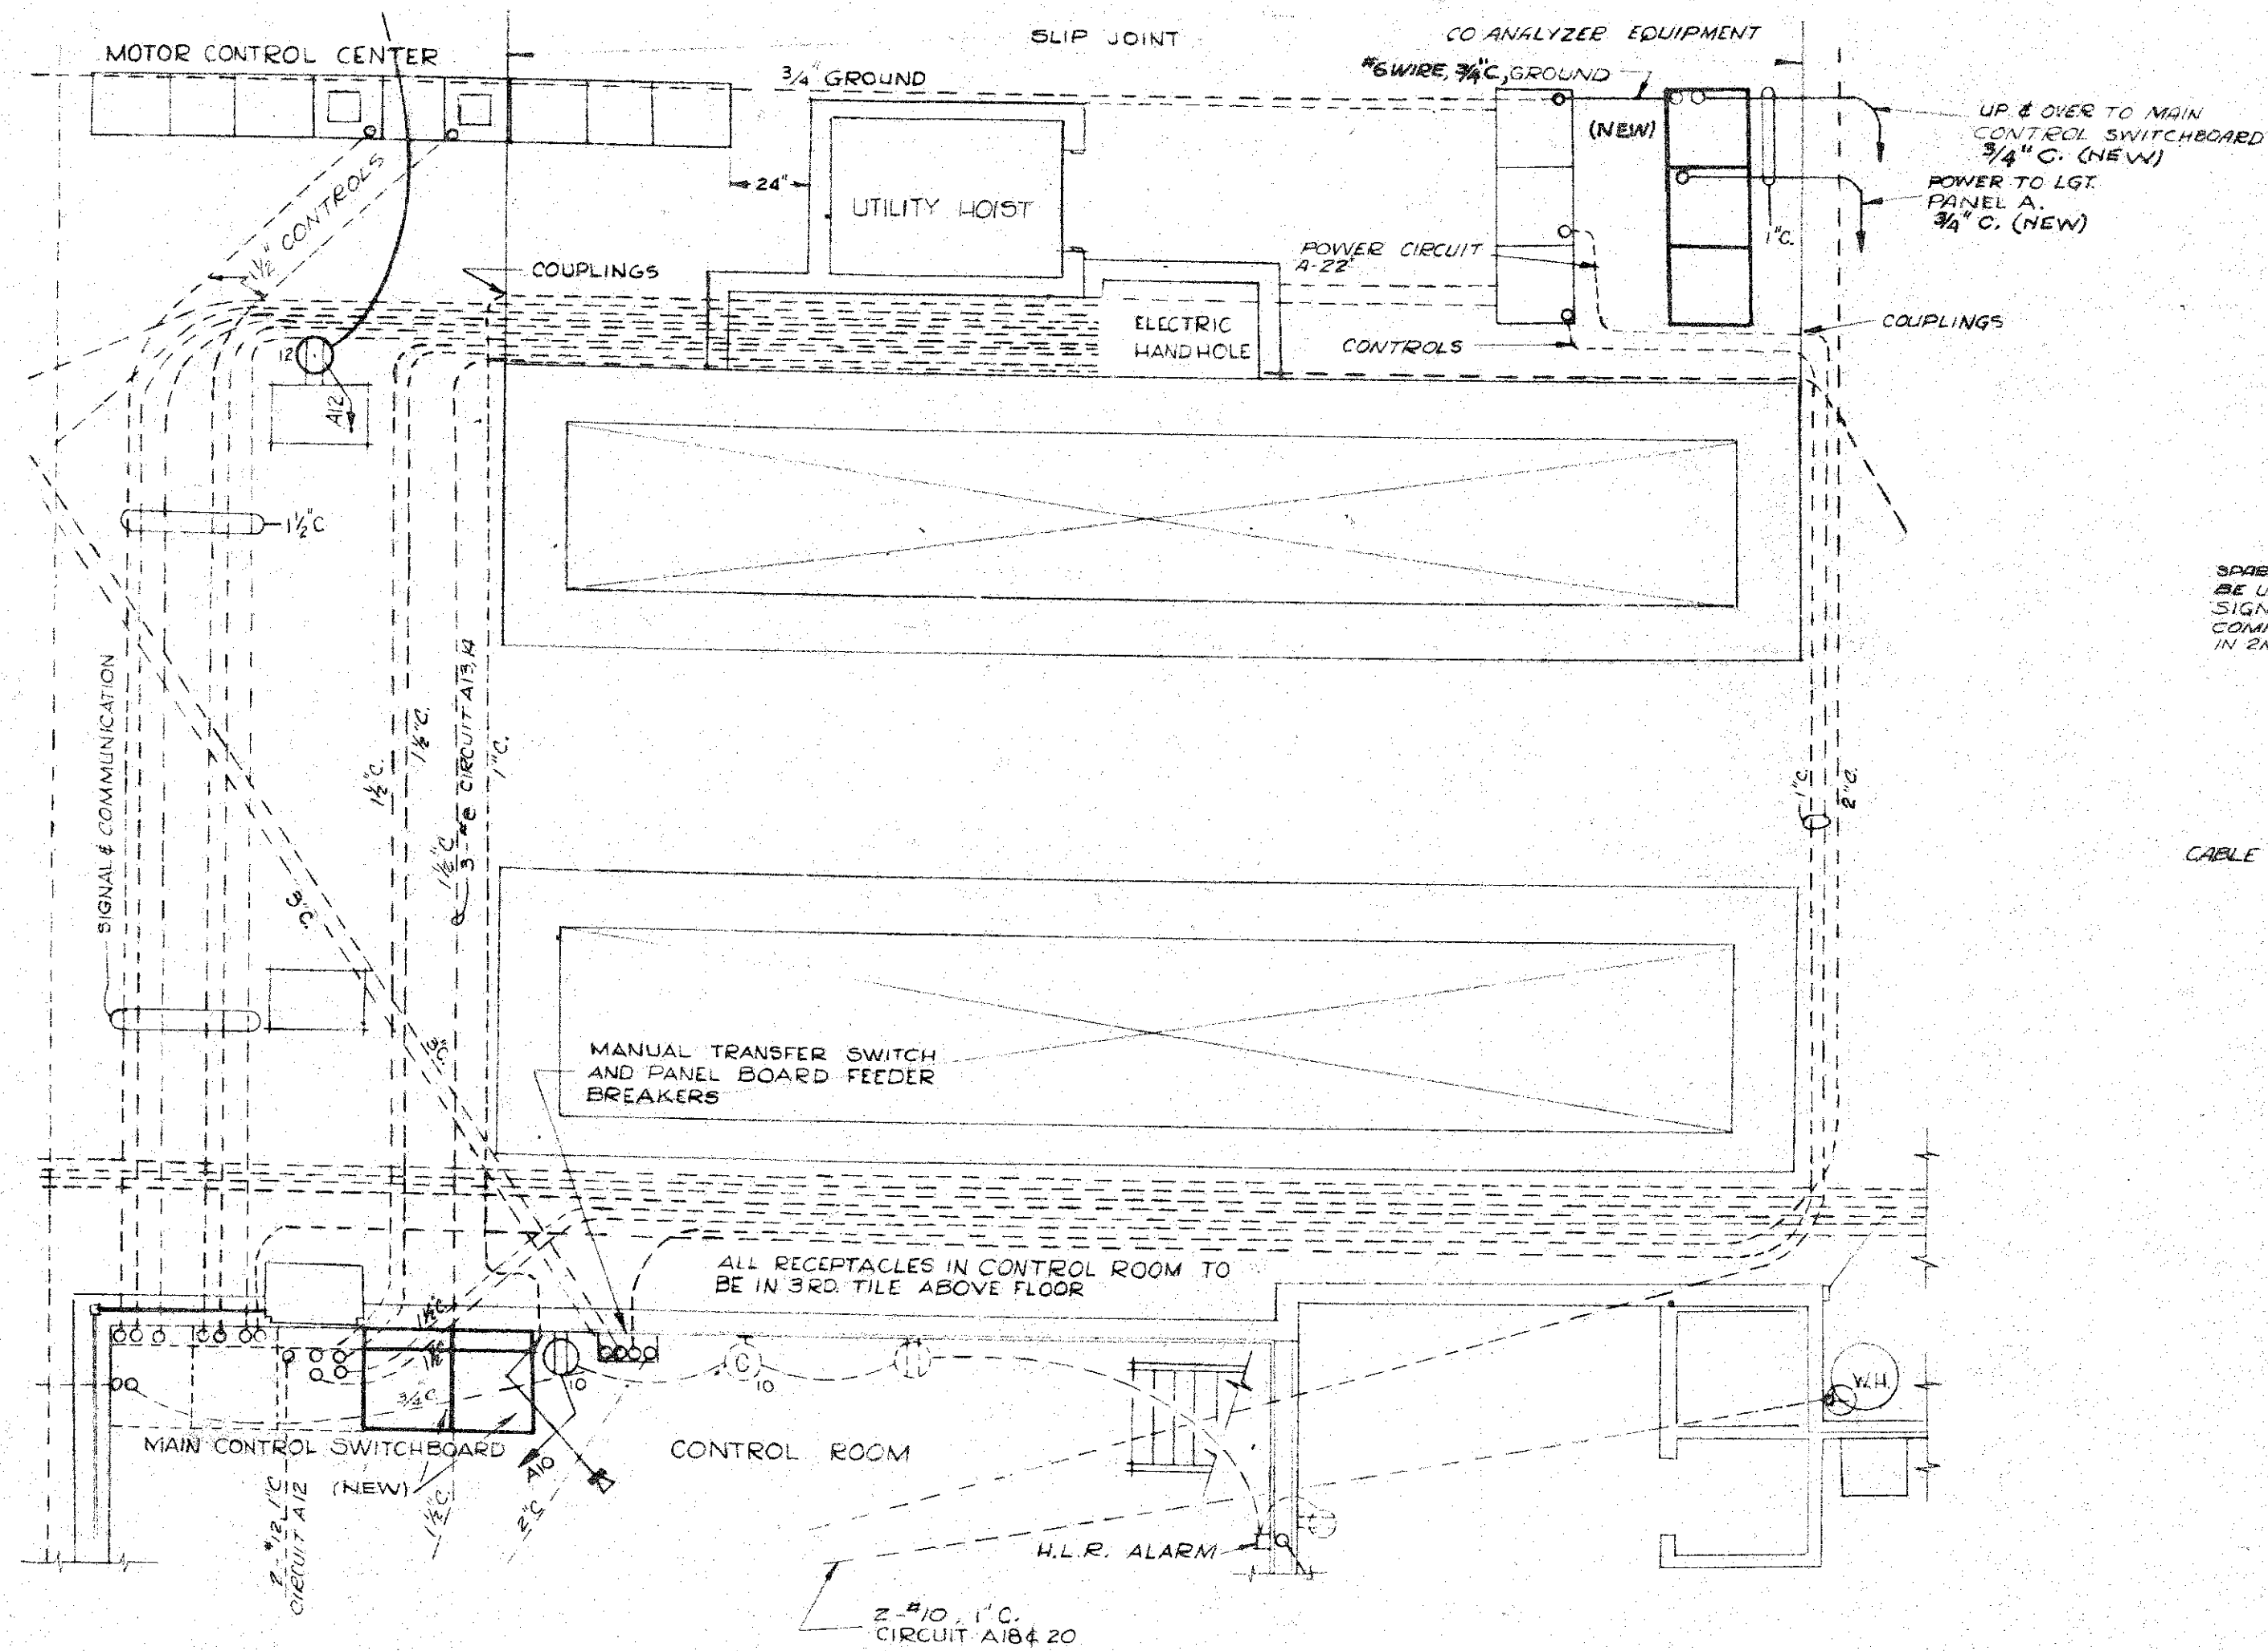

NOTE "A"

CONTRACTOR TO EMPLOY EXISTING SPARE CONDUITS WHERE AVAILABLE. NEW CONDUITS SHALL BE RUN EXPOSED.

DE LEUW, CATHER & COMPANY ENGINEERS			
CHICAGO			ILLINOIS
DEPARTMENT OF PUBLIC WORKS CITY AND COUNTY OF HONOLULU BUREAU OF PLANS			
WILSON TUNNEL 2nd BORE			
MODIFICATIONS TO EXISTING VENTILATION BUILDING & SHAFT			
ENGINEER	W.F.H.	DATE	AUG. 16, 1957
DRAFTSMAN	G.R.M.	CHECKED BY	
SCALE	AS SHOWN	TRACER	
APPROVED	<i>[Signature]</i>	APPROVED	<i>[Signature]</i>
CHIEF ENGINEER		BUREAU ENGINEER	
W.S.	PROFILE	C.B.	
C.R. SEC.	F.S.	S.B.	
W.M. BY	F.W. BY	S. BY	
JOB NO. 13-57		DWG. NO. E-7	