


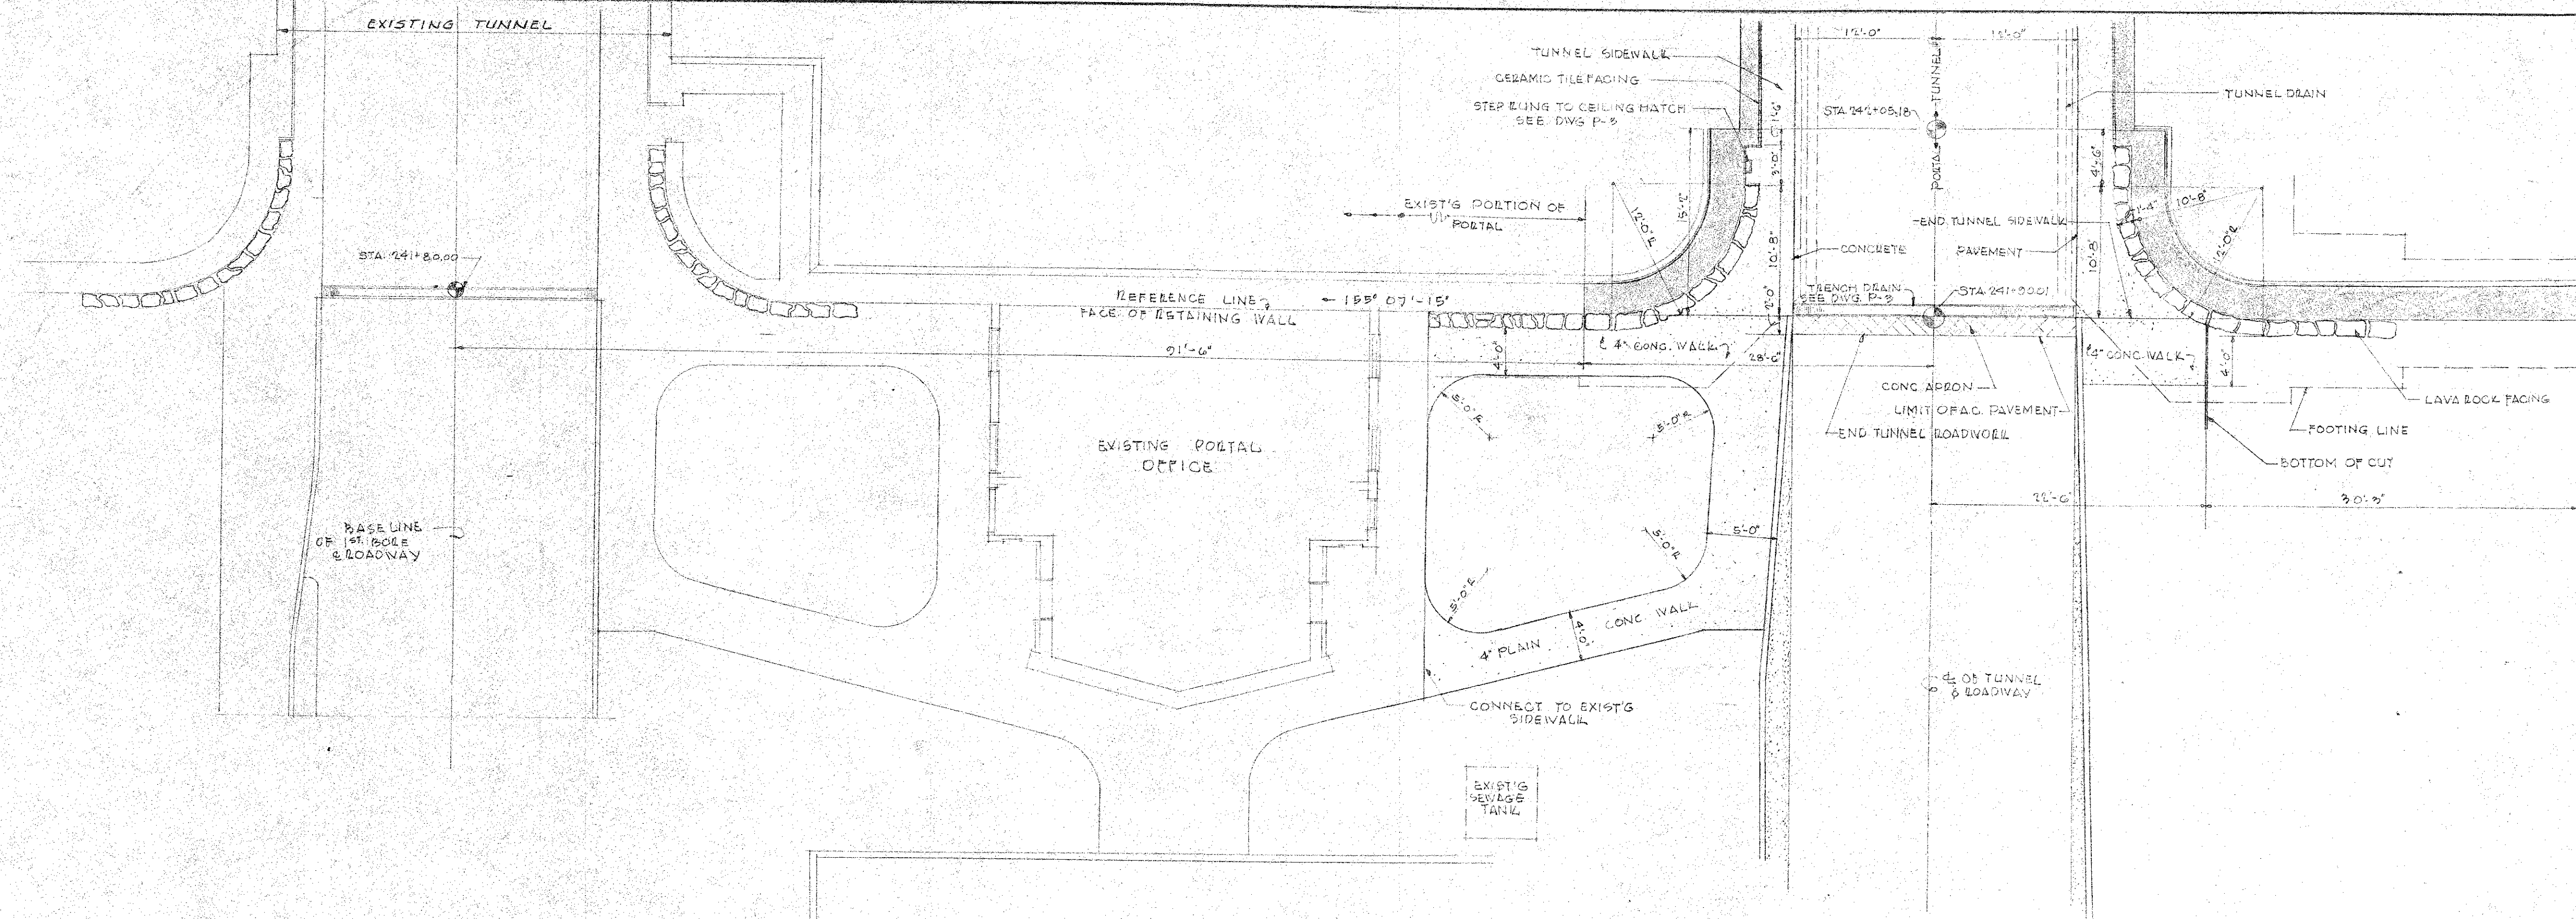


KALIHI PORTAL PLAN

SCALE: 1/8" = 1'-0"

PERMIT NO. 0-96-36
WILSON TUNNEL CELLULAR PHONE SITES
(REFER TO PERMIT PLAN FOR DETAILS)
COMP: 04/04/97

Permit # 0-96-36
Wilson Tunnel Cellular Phone Sites
Comp: 04/04/97

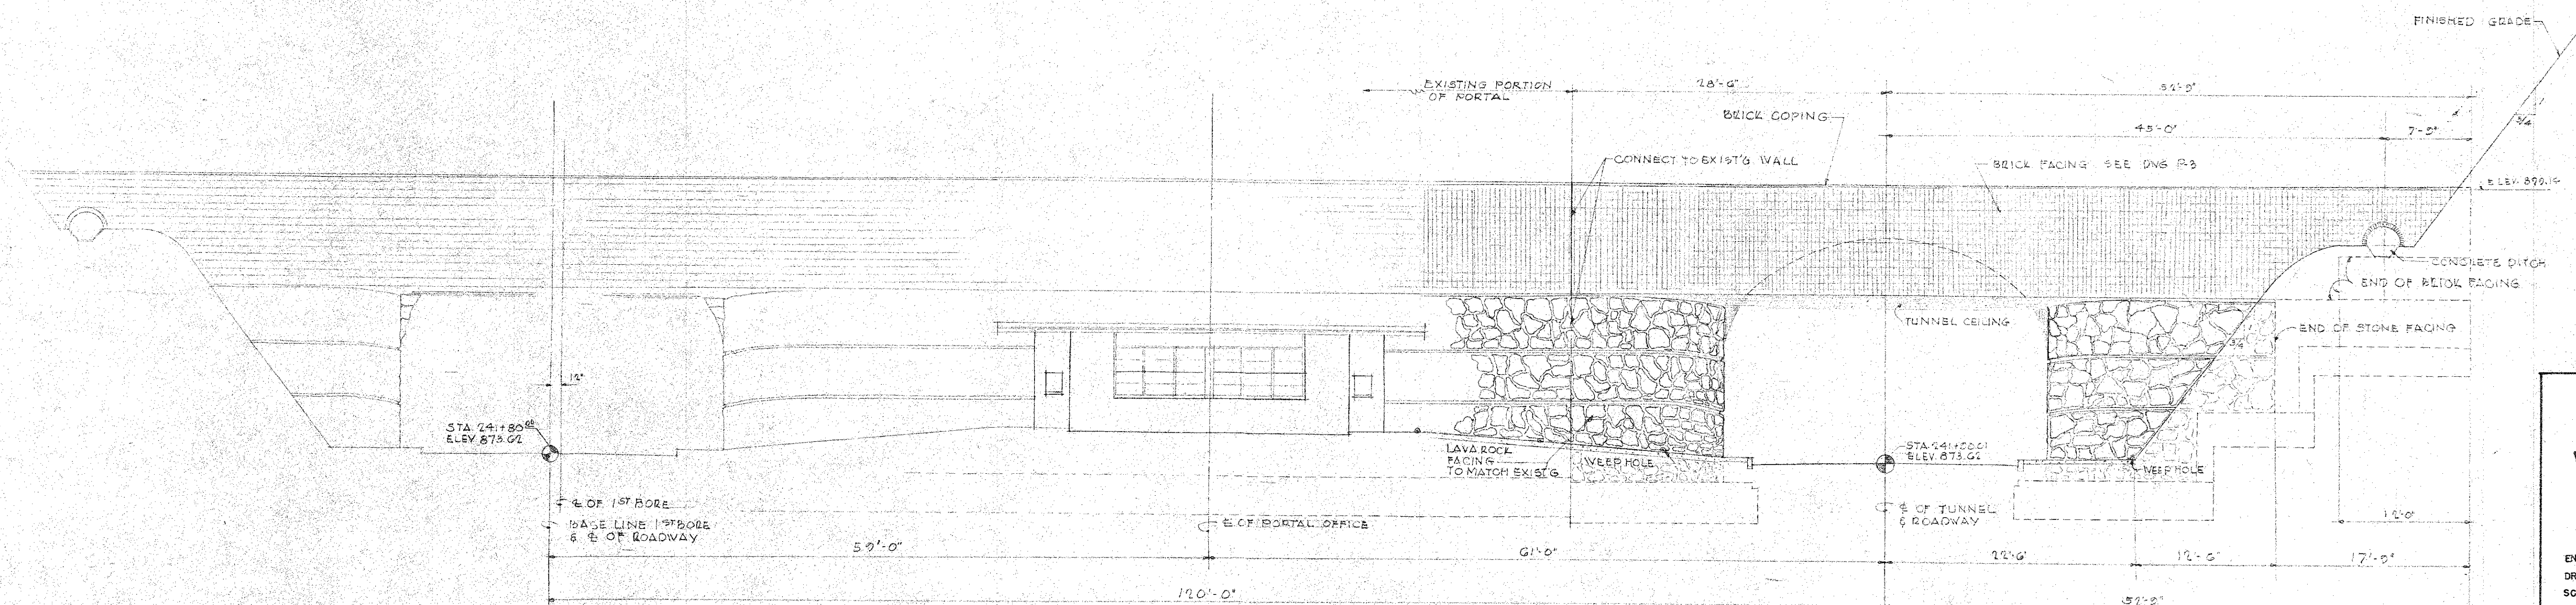

KALIHI PORTAL ELEVATION

SCALE: 1/8" = 1'-0"

DEPARTMENT OF PUBLIC WORKS CITY AND COUNTY OF HONOLULU BUREAU OF PLANS			
WILSON TUNNEL 2 ND BORE KALIHI PORTAL PLAN & ELEVATION			
ENGINEER <i>W. Linn</i>	DATE <i>8-8-57</i>		
DRAFTSMAN <i>L.W.</i>	CHECKED BY <i>Rek</i>		
SCALE	TRACER		
APPROVED <i>John Kuan</i>	APPROVED <i>Sum</i>		
CHIEF ENGINEER	BUREAU ENGINEER		
W.S.	PROFILE	C.B.	
DR. SEC.	P.S.	S.D.	
W.M.BY	F.W.BY	S.BY	
JOB NO. 13-57		DWG. NO. P-2	