
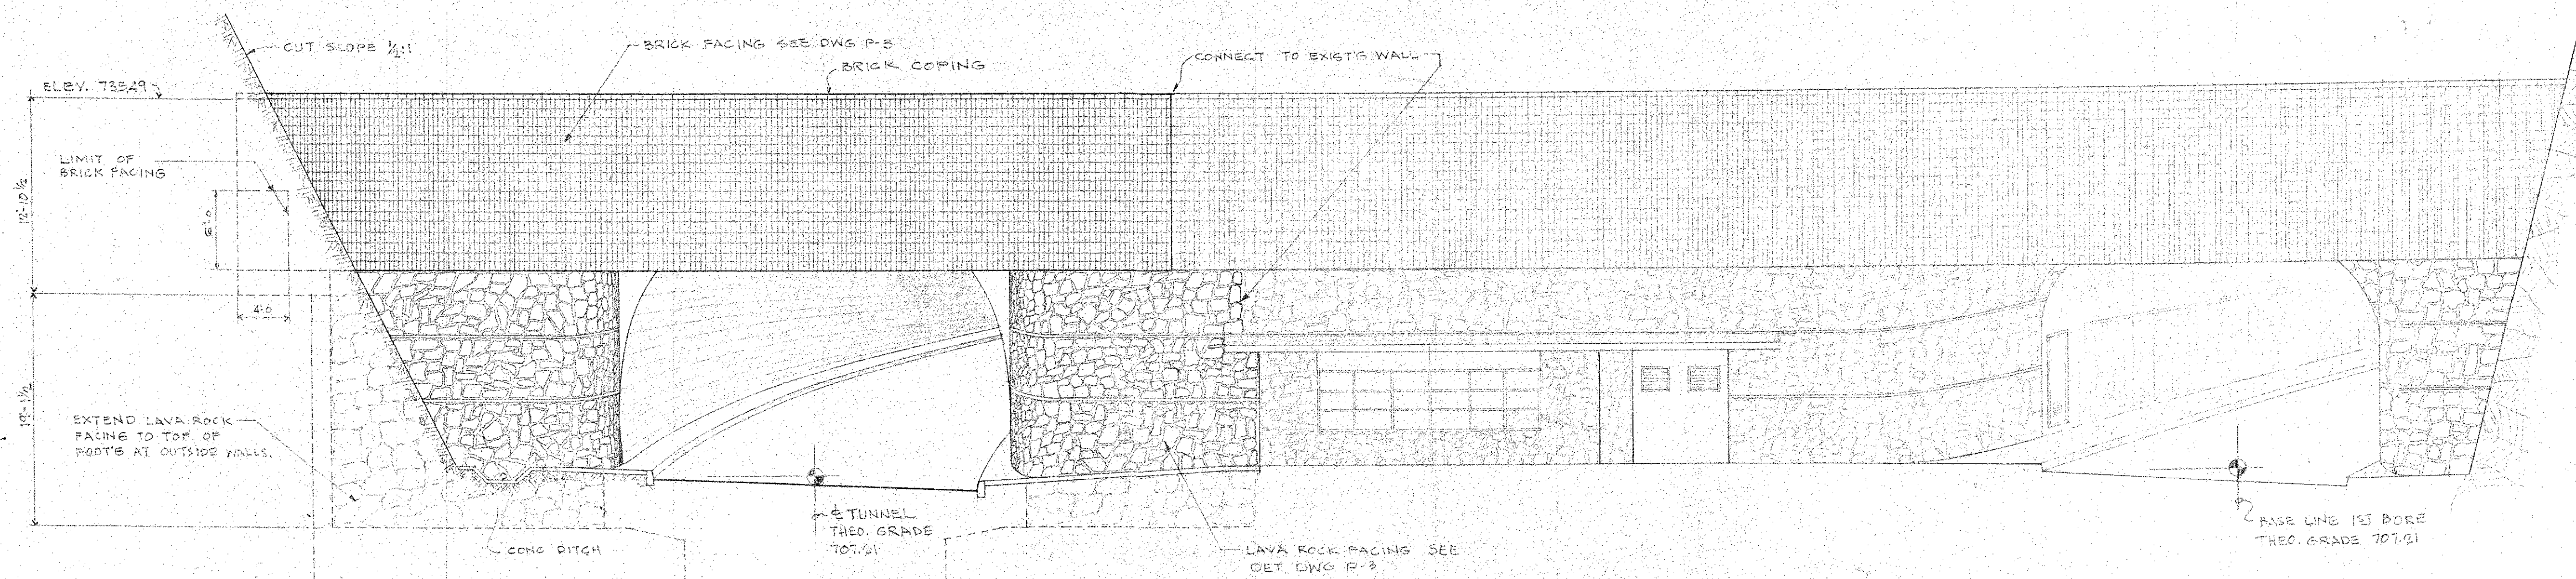


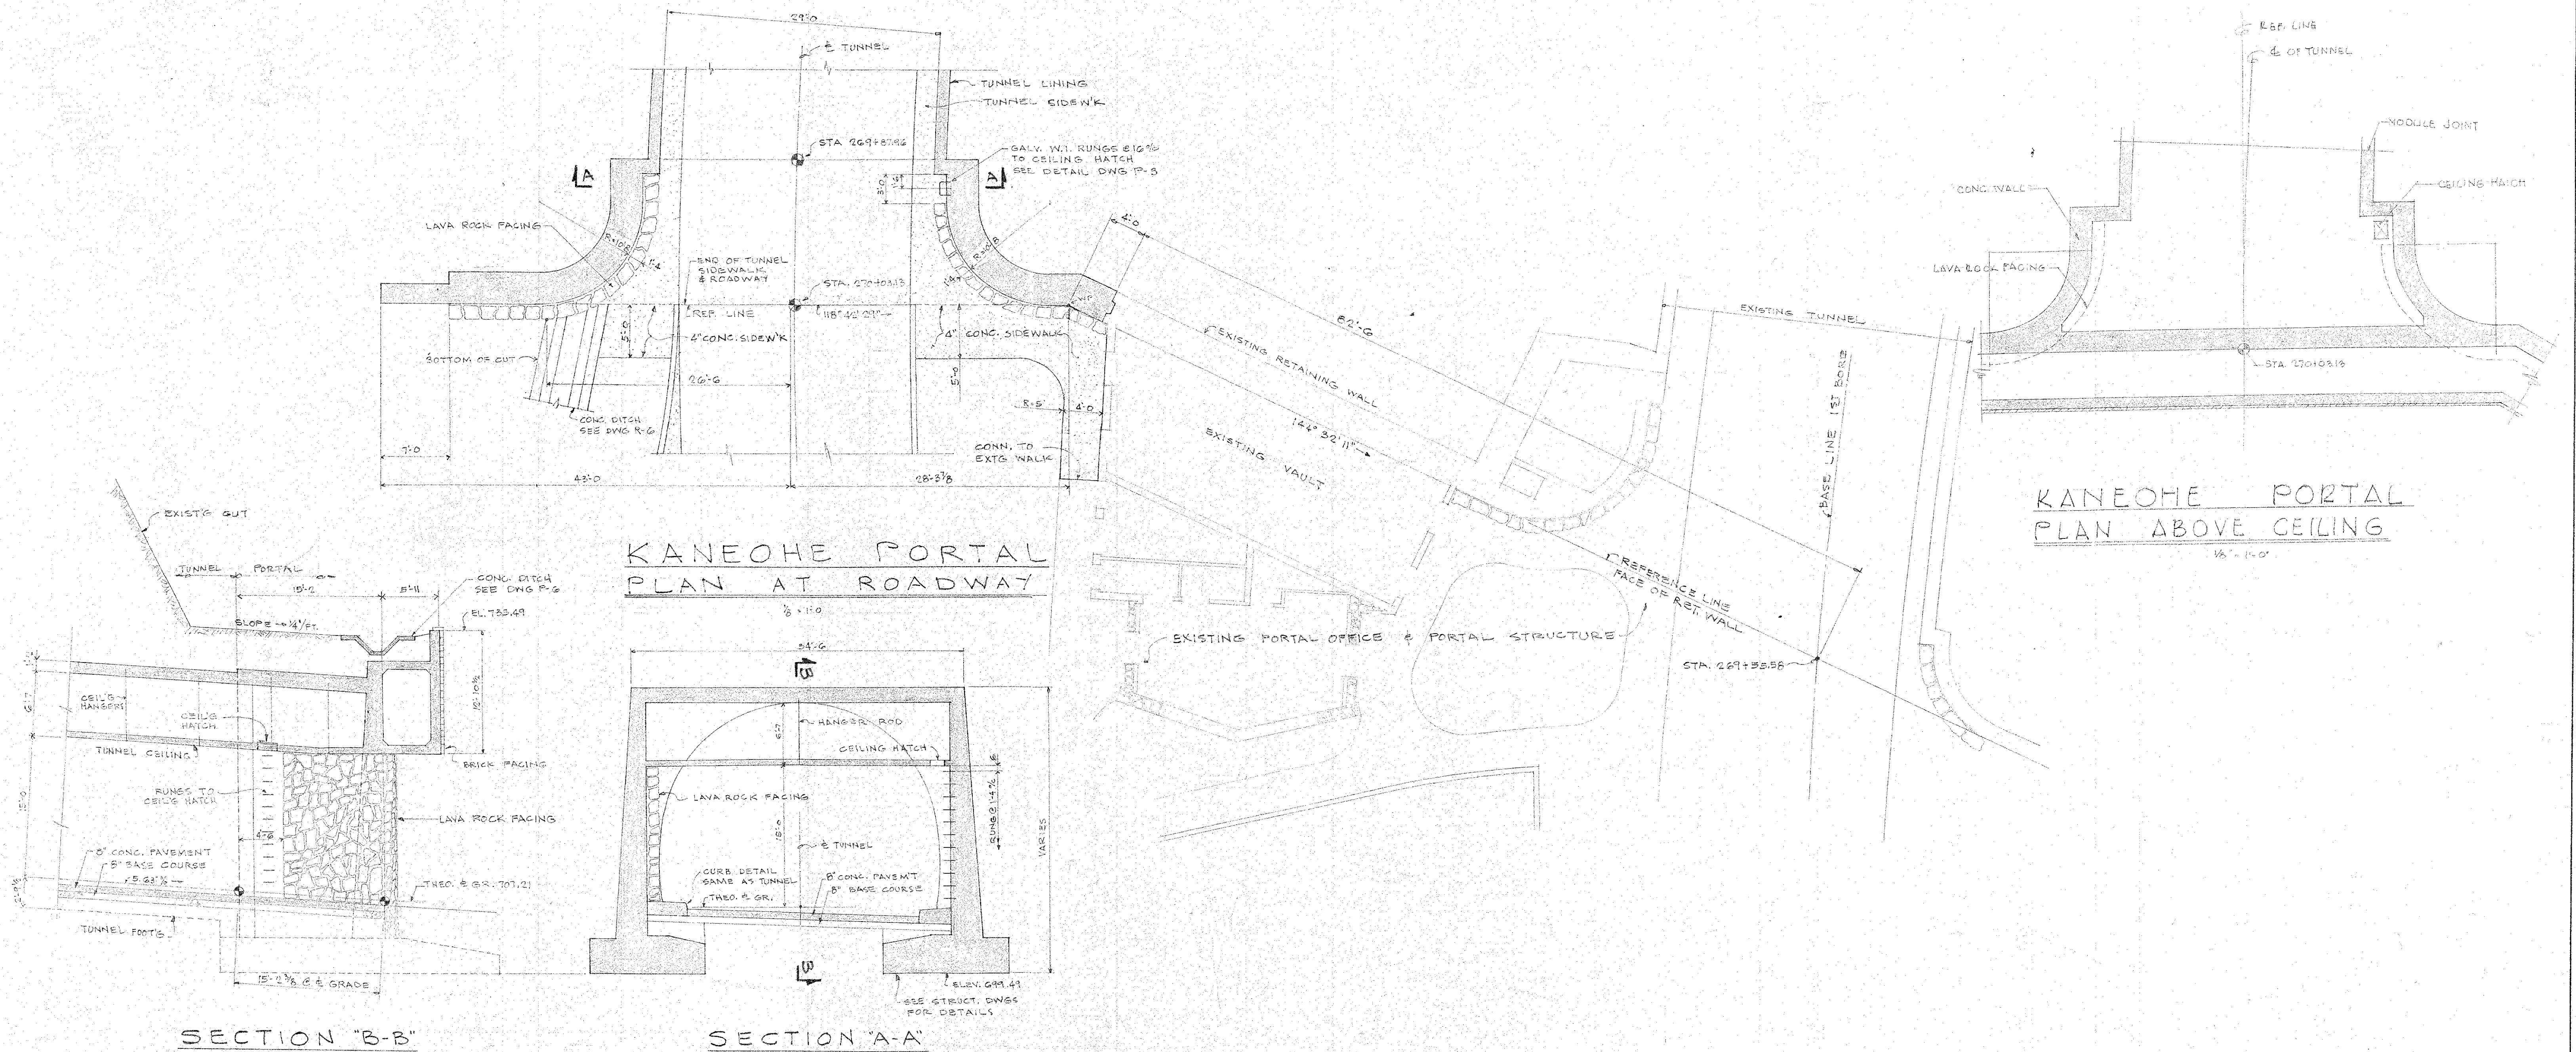

DEPARTMENT OF PUBLIC WORKS CITY AND COUNTY OF HONOLULU BUREAU OF PLANS			
WILSON TUNNEL 2ND BORE KANEOHE PORTAL PLAN, ELEVATION & DETAILS			
ENGINEER <i>W. L. Linn</i>	DATE 8-8-57		
DRAFTSMAN <i>ROK</i>	CHECKED BY <i>ROK</i>		
SCALE	TRACER		
APPROVED <i>W. L. Linn</i>	APPROVED <i>W. L. Linn</i>		
CHIEF ENGINEER	BUREAU ENGINEER		
W. L. Linn	PROFILE	C. B.	
CR. SEC.	F. S.	S. B.	
W. M. BY	F. W. BY	S. BY	
JOB NO. 13-57		DWG. P-7	