




SECTION B-B

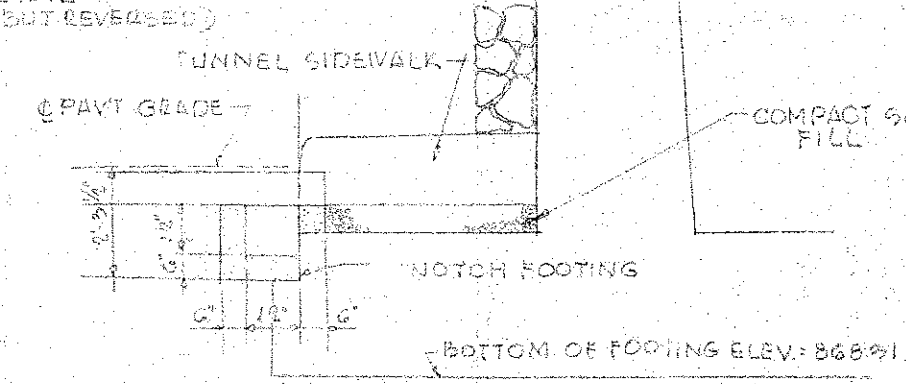


SECTION C-C

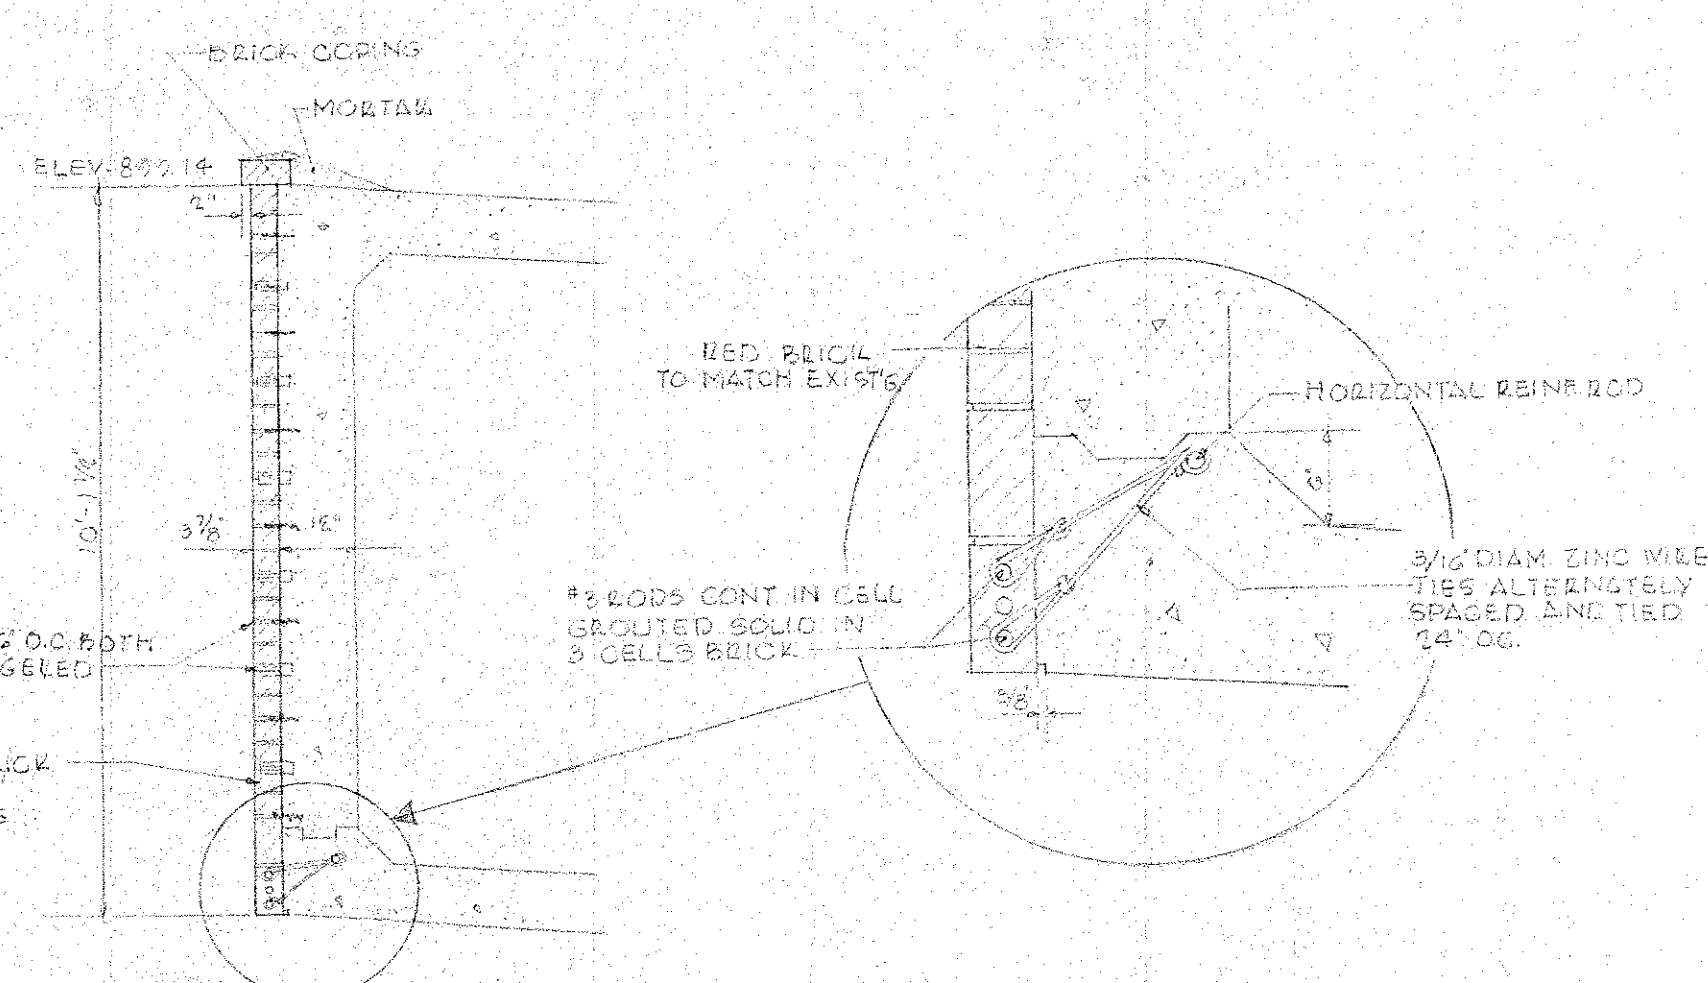


BRICK FACING DETAIL

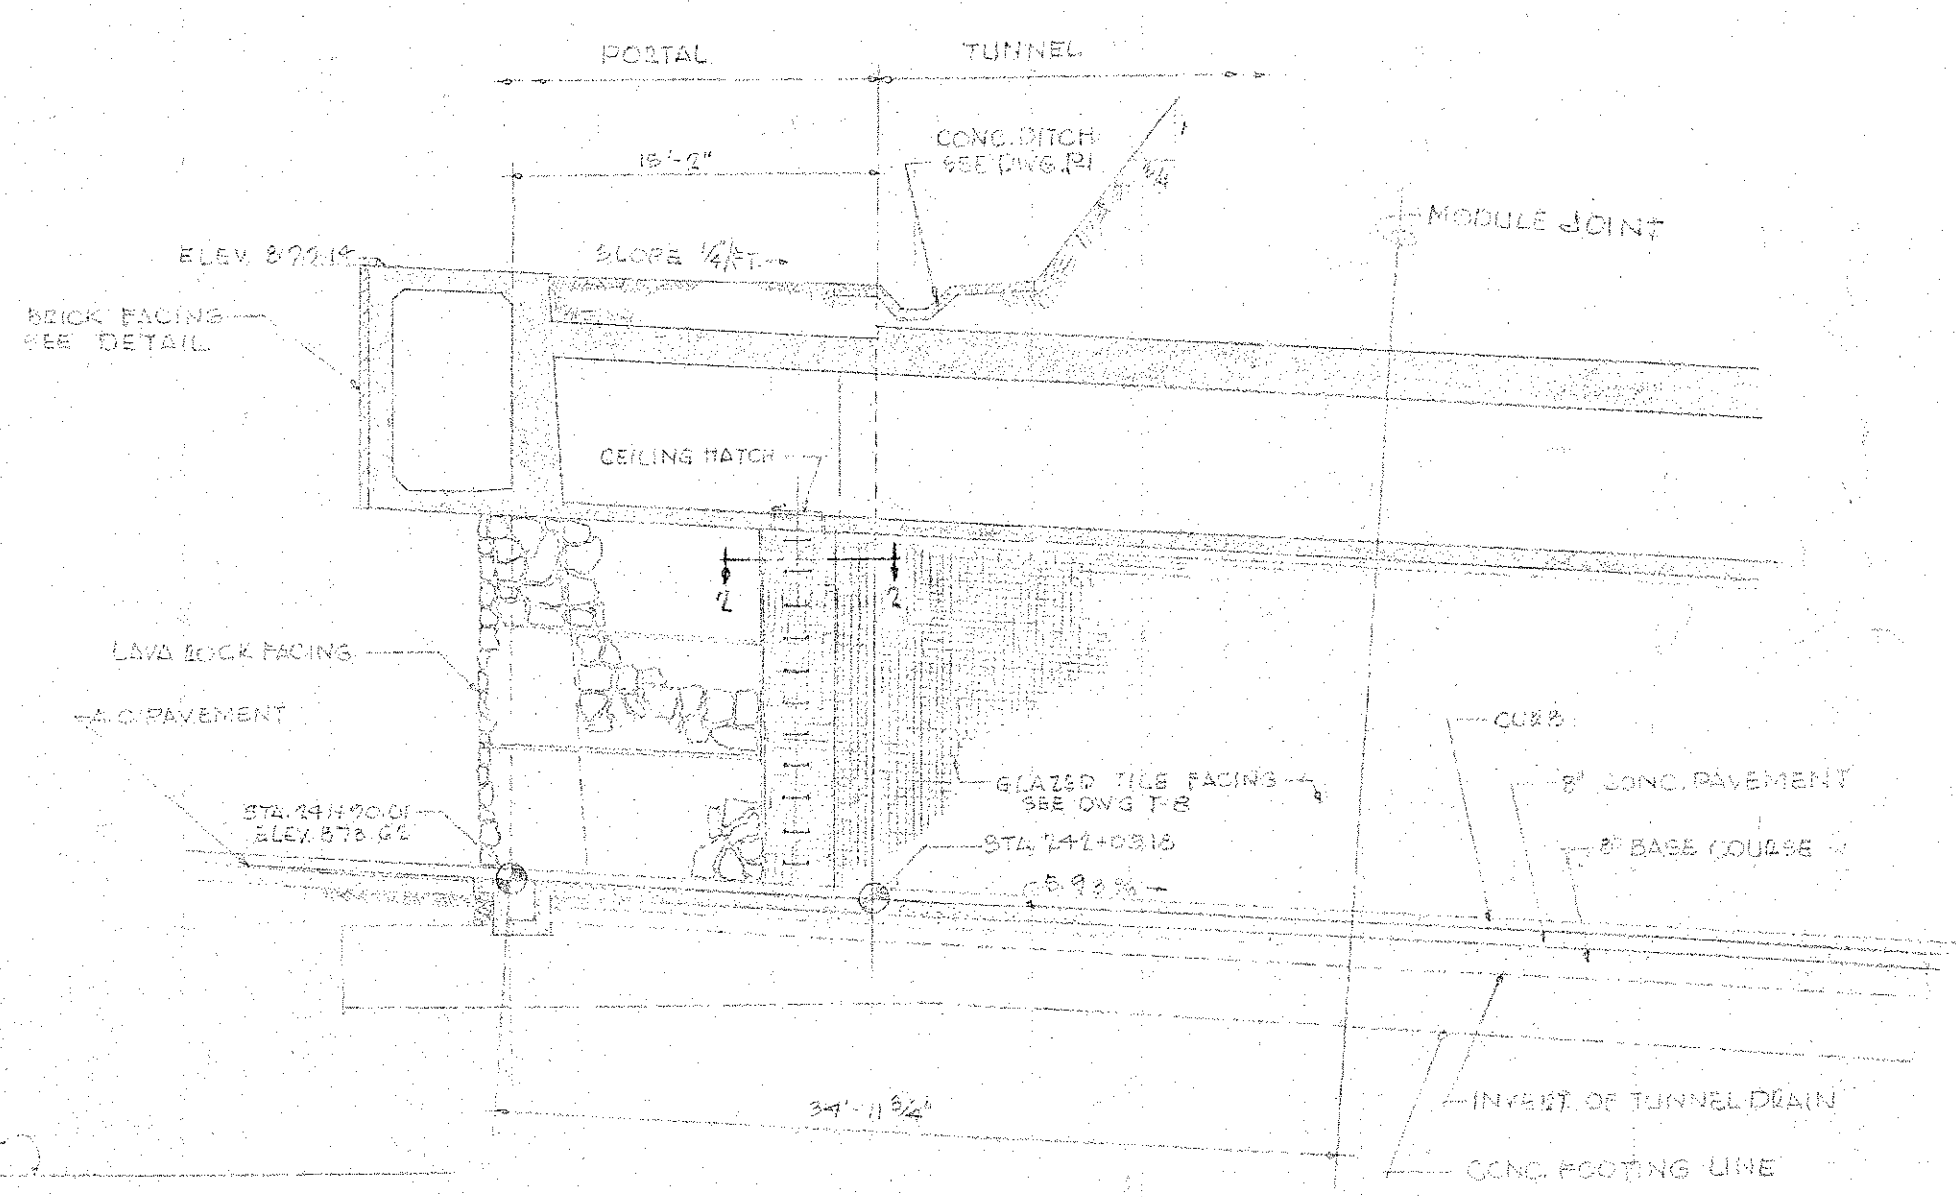


SECTION 1-1

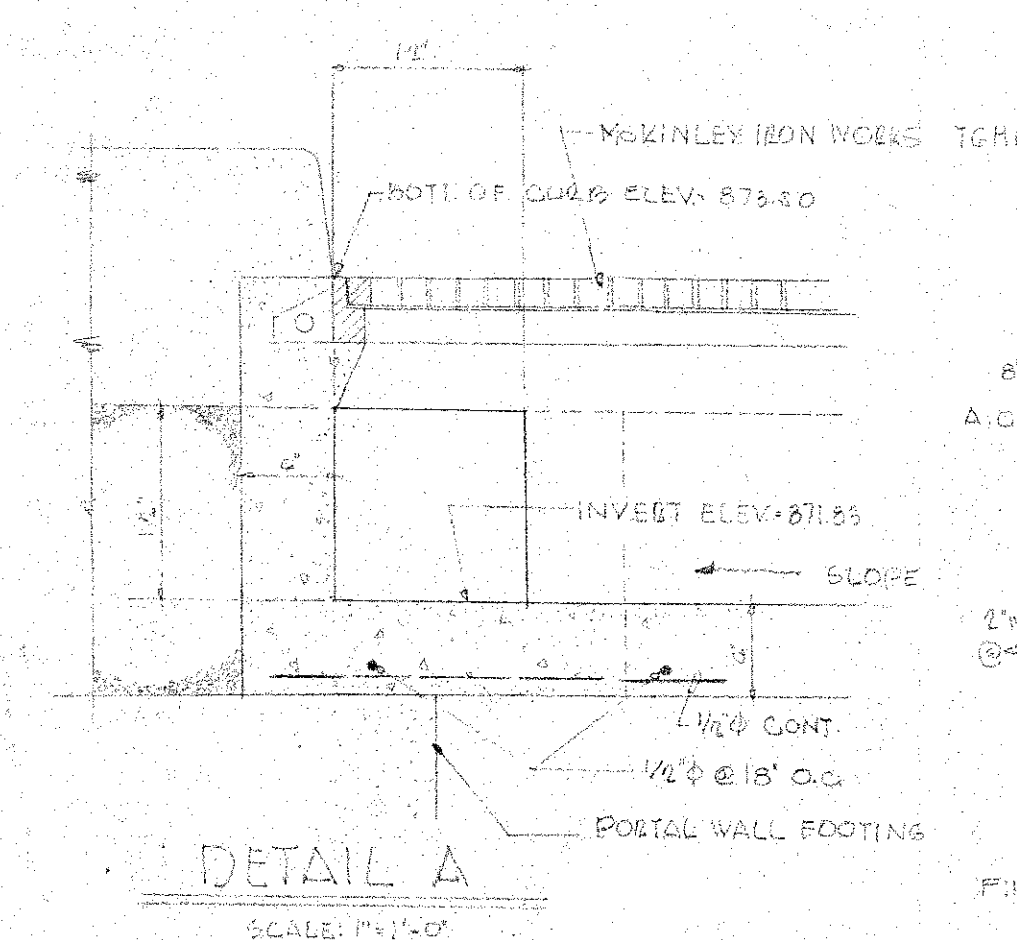


DETAIL A

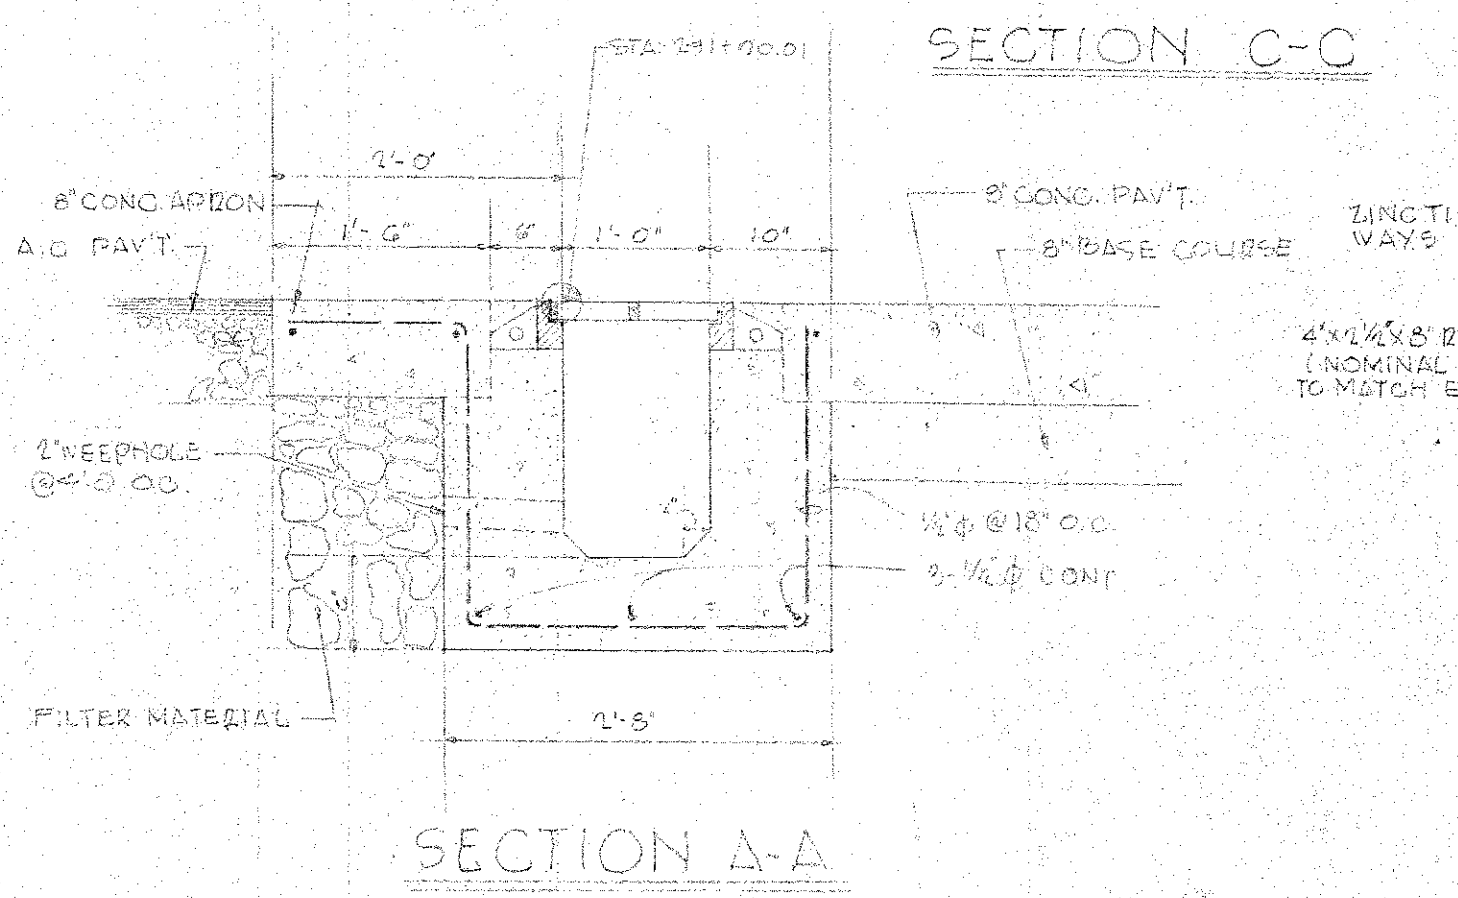


SECTION A-A

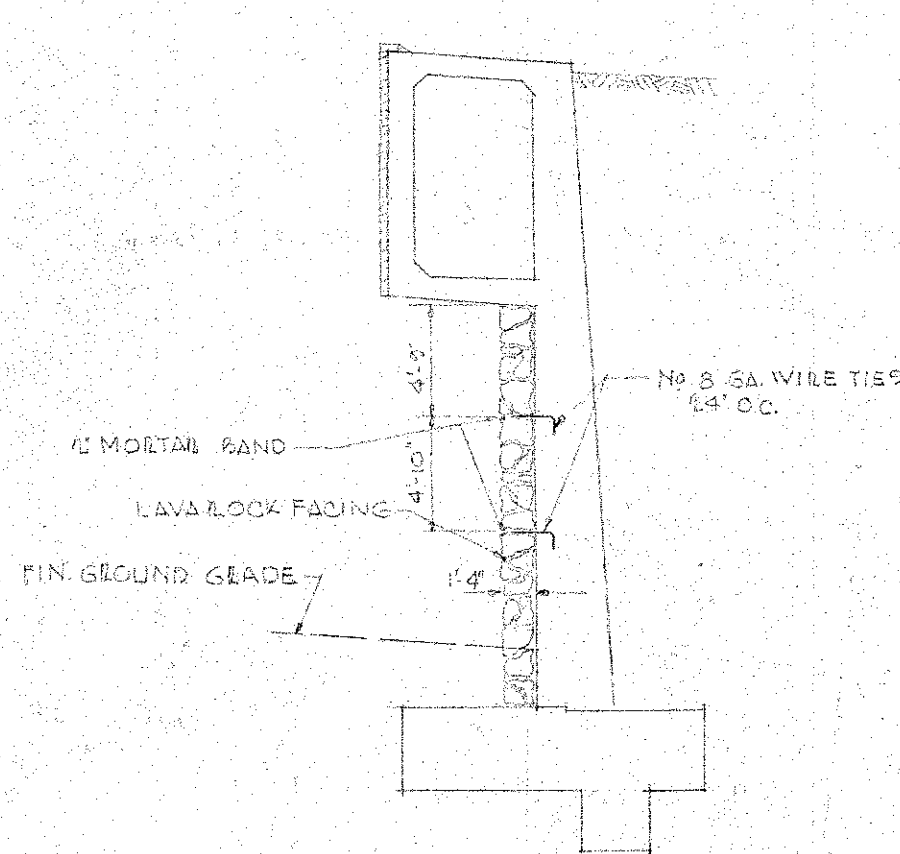

LAVA ROCK FACING DETAIL

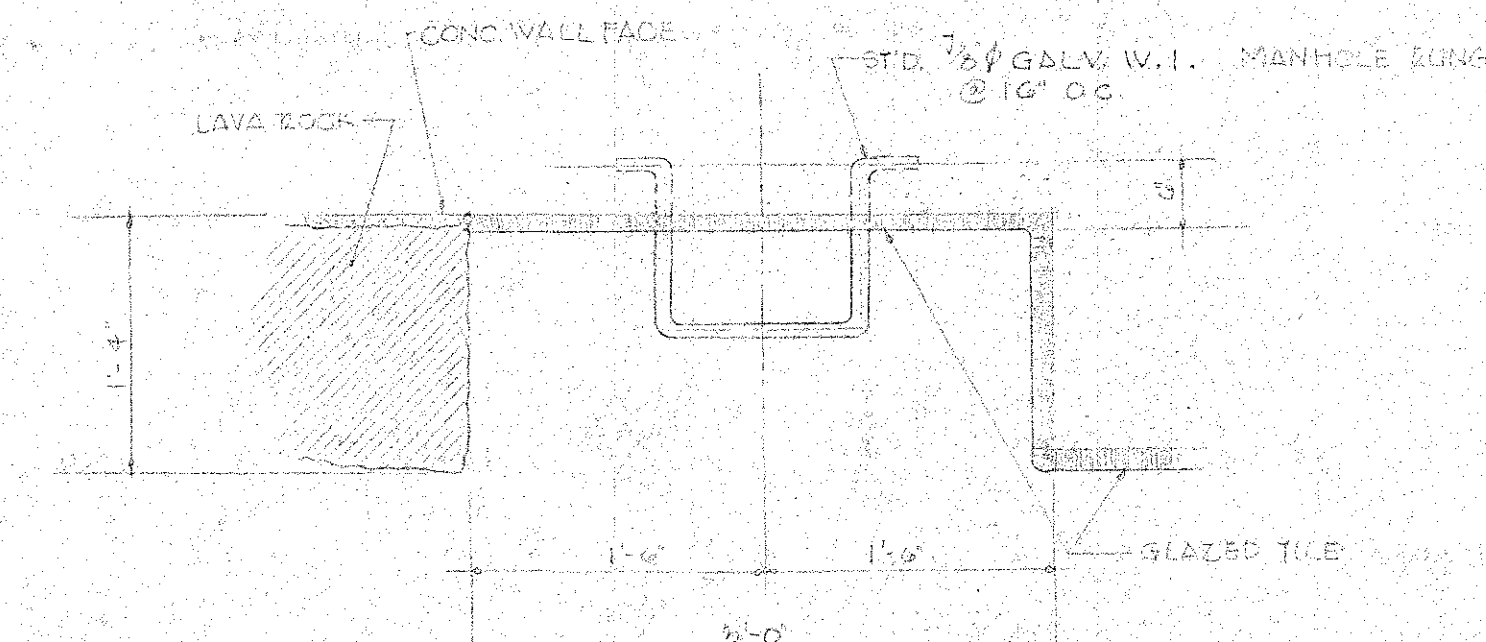

SECTION 2-2

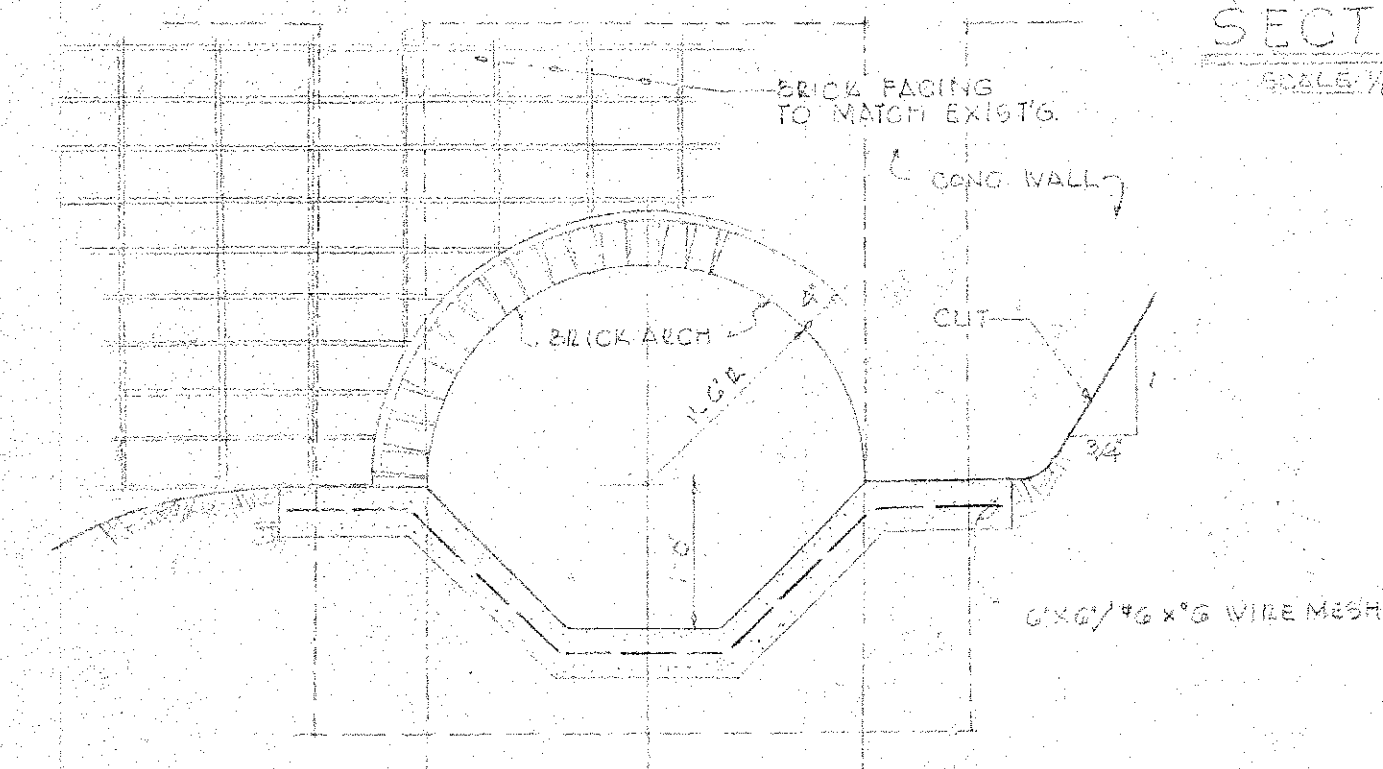

BRICK FACING DETAIL OF CULVERT AT PORTAL

DEPARTMENT OF PUBLIC WORKS CITY AND COUNTY OF HONOLULU BUREAU OF PLANS			
WILSON TUNNEL 2ND BORE			
KALIHI PORTAL			
PORTAL DETAILS			
ENGINEER <i>W. L. L.</i>	DATE <i>8-8-57</i>		
DRAFTSMAN <i>L.W.</i>	CHECKED BY <i>R.K.</i>		
SCALE	TRACER		
APPROVED <i>W. L. L.</i>	APPROVED <i>W. L. L.</i>		
CHIEF ENGINEER	BUREAU ENGINEER		
W. S. V.	PROFILE	C.B.	
OR. SEC.	P. S.	S.B.	
W. M. BY	P.W. BY	S. BY	
JOB NO. 13-57		DWG. P-3	