
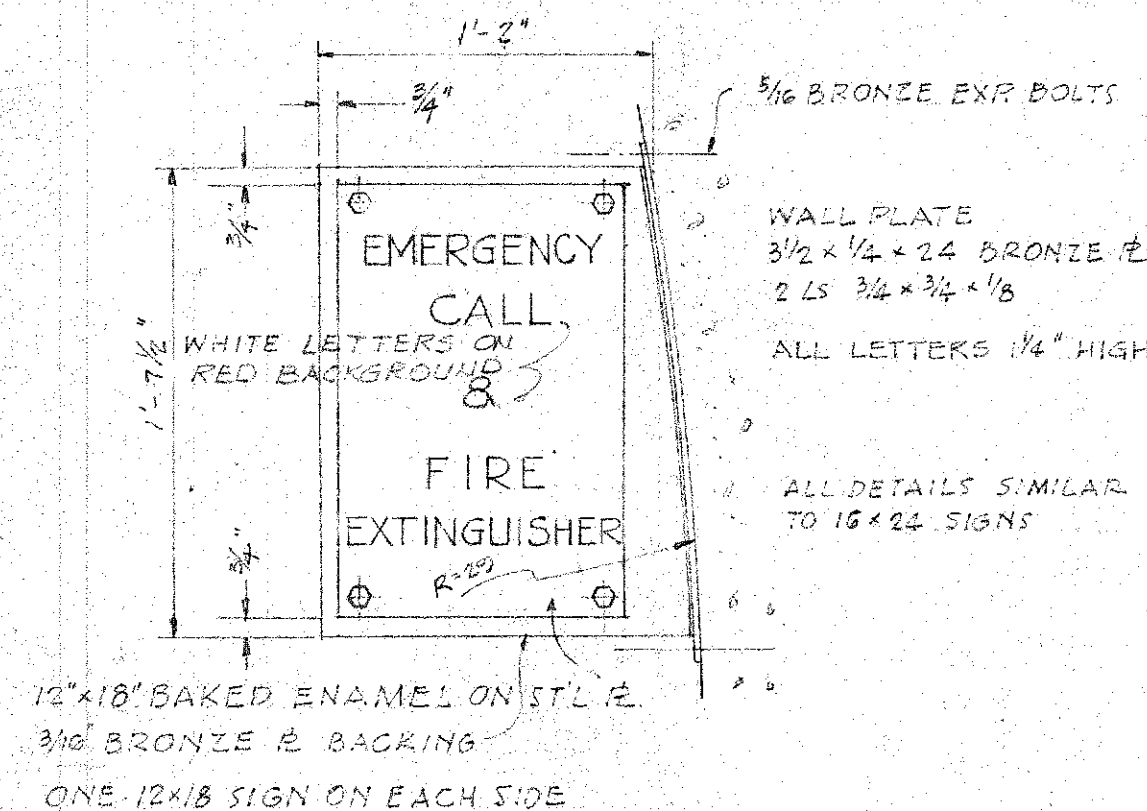
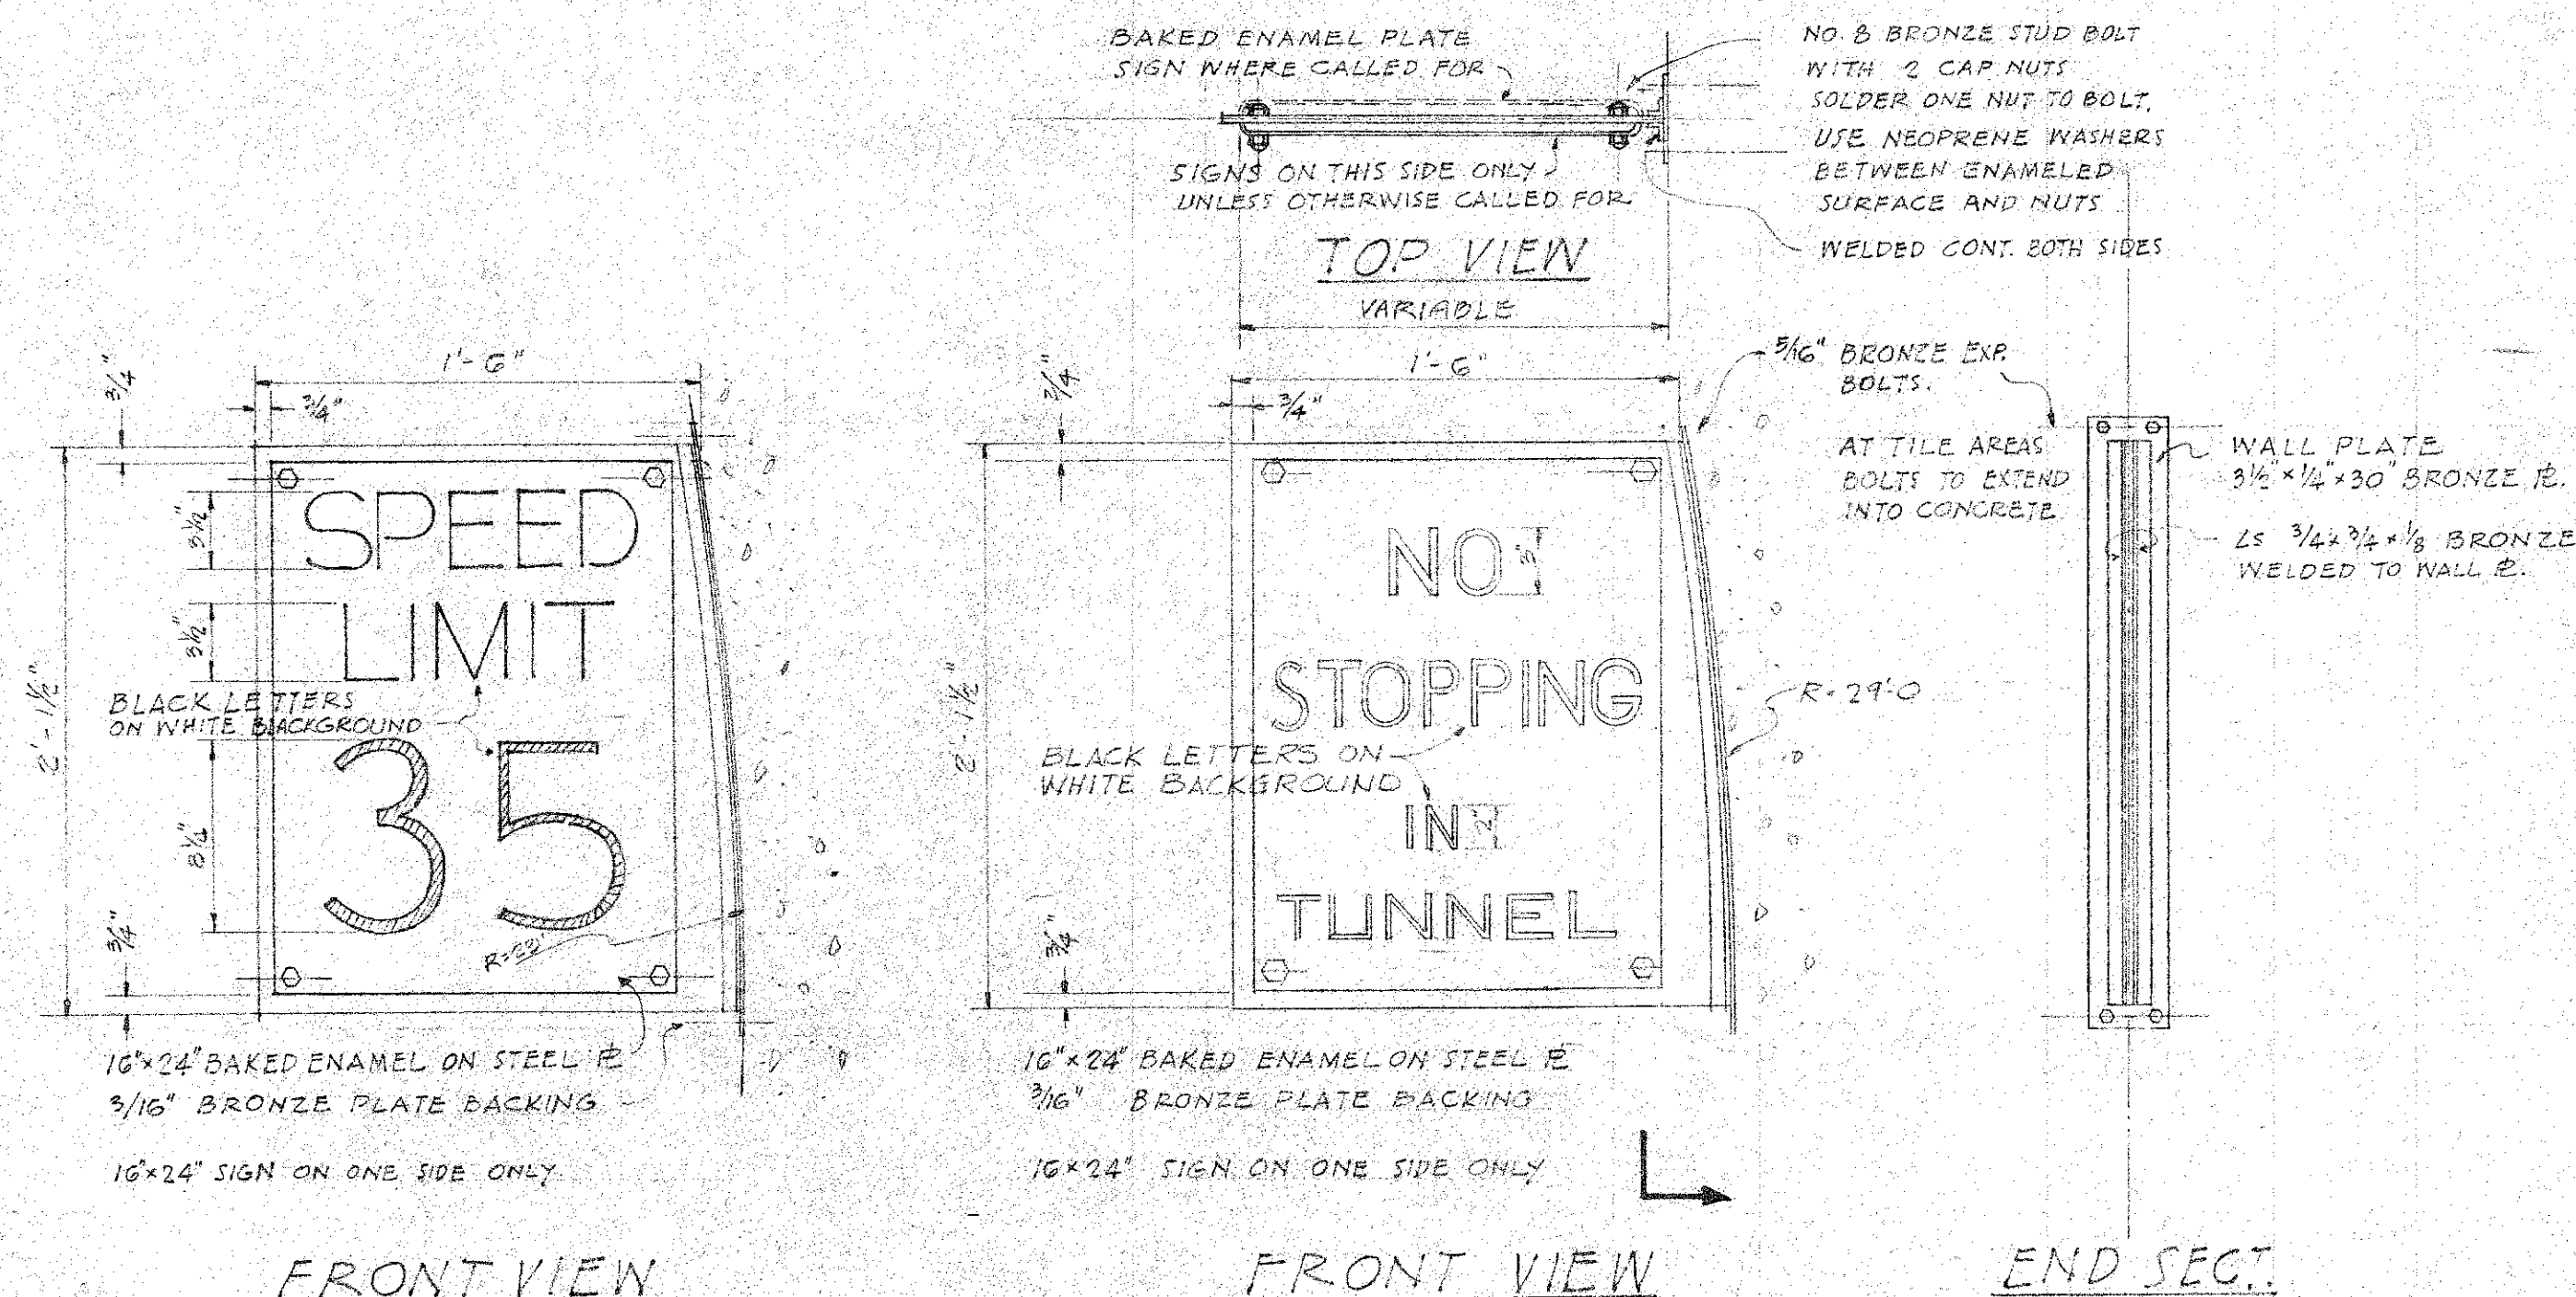


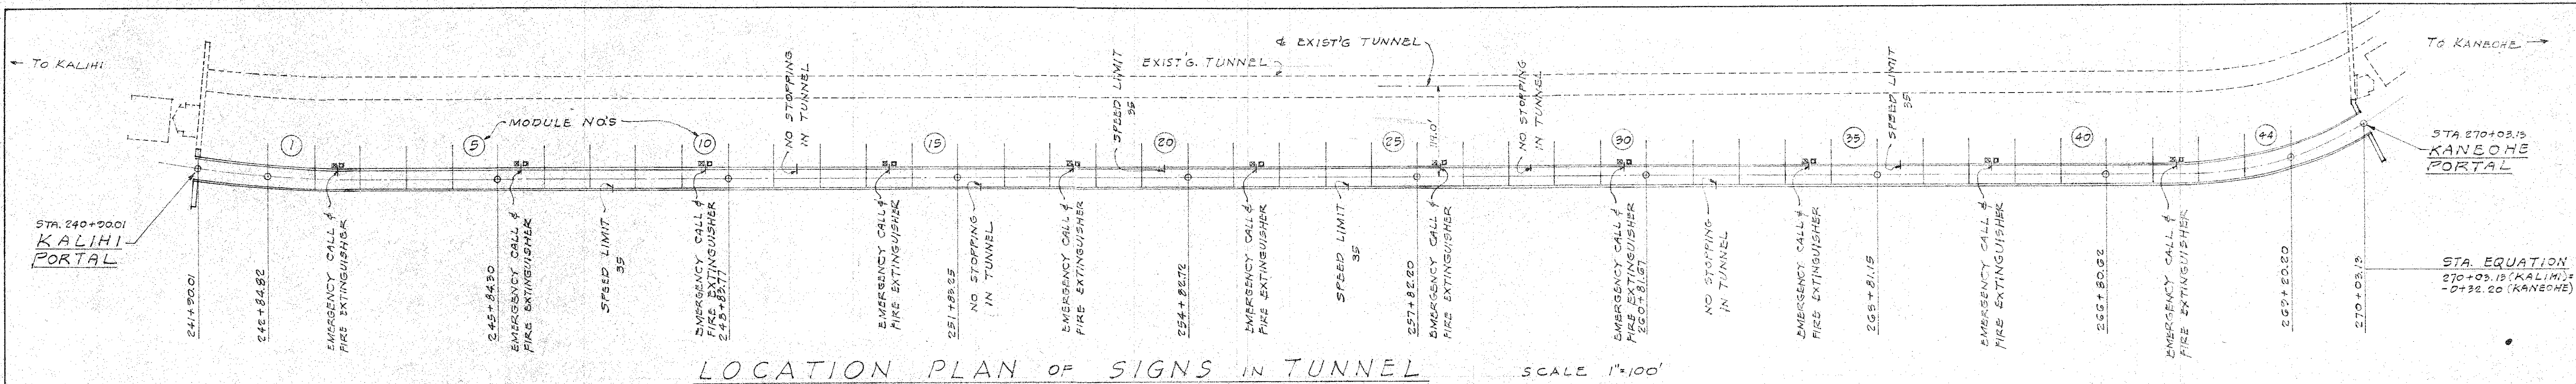

GENERAL NOTES




TOTAL NUMBER OF SIGNS REQ'D:

4 SPEED LIMIT = 35 } SIGNS ON ONE SIDE ONLY

4 NO STOPPING IN TUNNEL

11 EMERGENCY CALL & FIRE EXTINGUISHER } SIGNS ON 2 SIDES

ALL LETTERS AND FIGURE SHALL BE OF THE SIZE AND LAYOUT SHOWN AND SHALL CONFORM WITH "STANDARD ALPHABETS FOR HIGHWAY SIGNS" AS SET FORTH BY THE PUBLIC ROADS ADMINISTRATION, FEDERAL WORKS AGENCY. SERIES "C" LETTERS AND SERIES "D" NUMERALS SHALL BE USED.

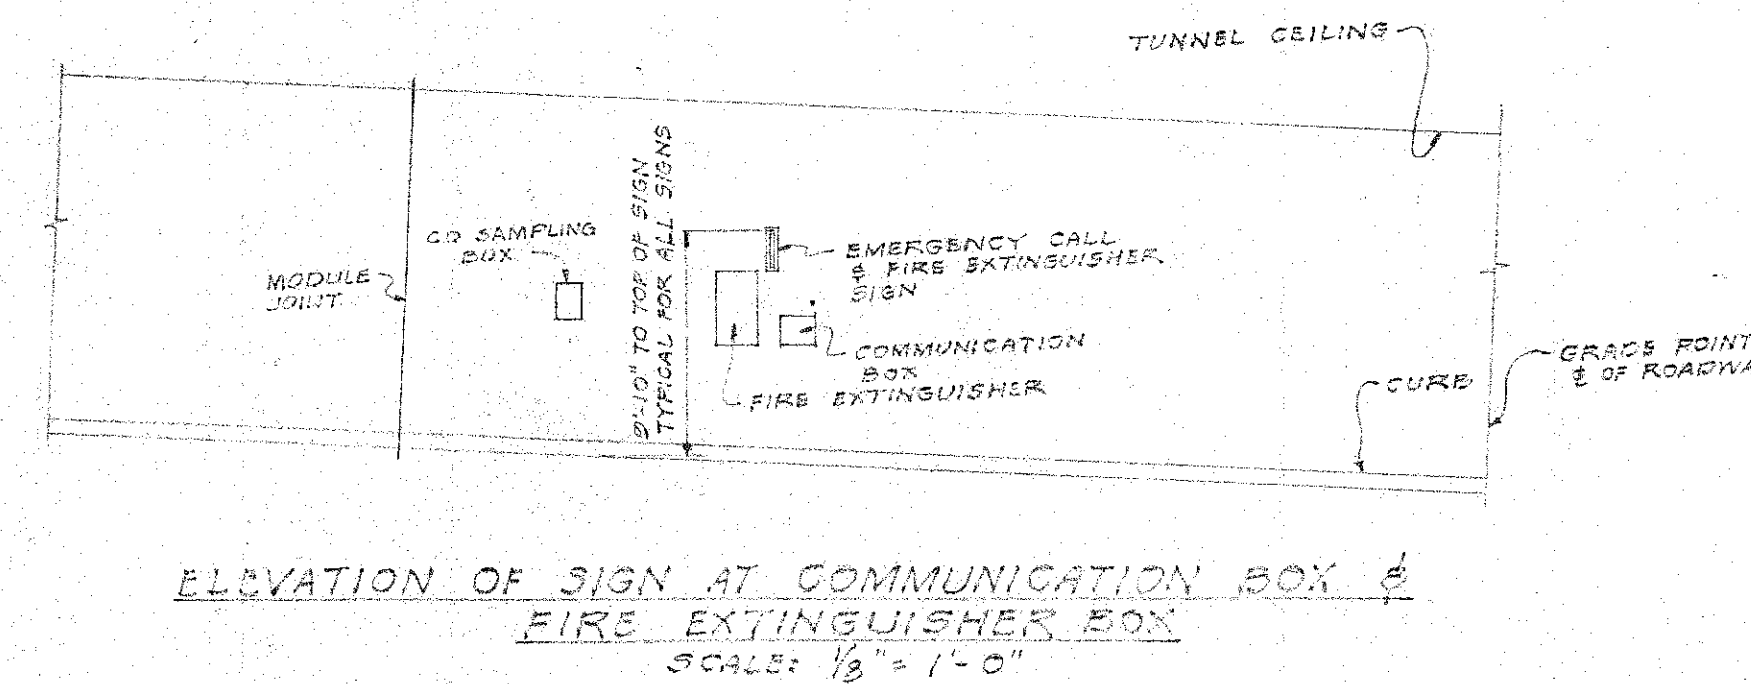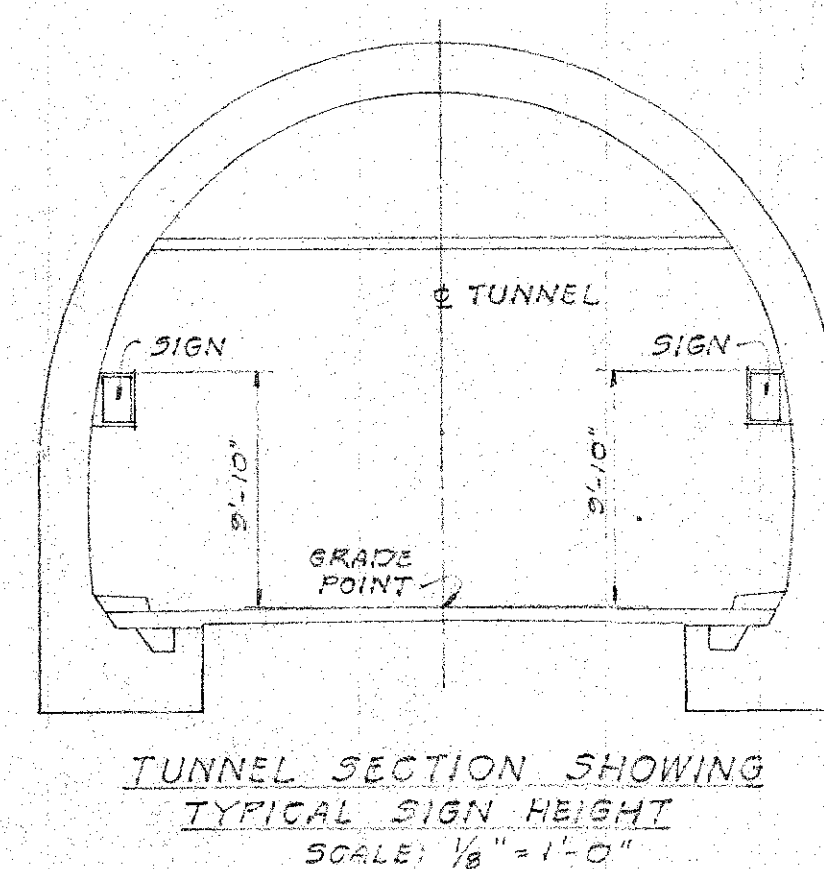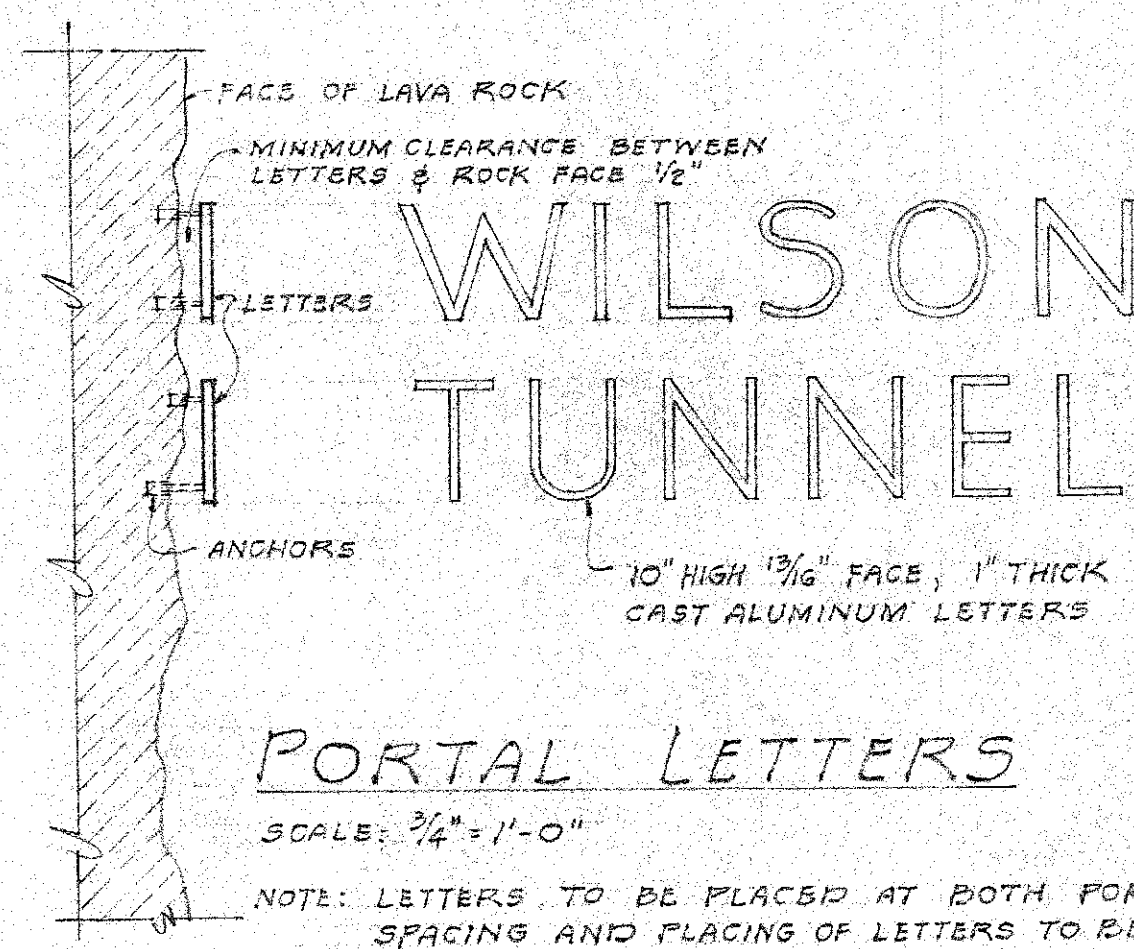

DEPARTMENT OF PUBLIC WORKS CITY AND COUNTY OF HONOLULU BUREAU OF PLANS			
WILSON TUNNEL 2 ND BORE			
TUNNEL			
SIGN DETAILS			
ENGINEER <i>W. L. L.</i>	DATE 8-8-57	CHECKED BY <i>Rel</i>	TRACER
DRAFTSMAN <i>N. L.</i>	APPROVED <i>W. L. L.</i>	APPROVED <i>W. L. L.</i>	BUREAU ENGINEER
SCALE	PROFILE	C.B.	
W.M. BY	F.B.	S.B.	
JOB NO. 13-57		DWG. NO. T-11	