


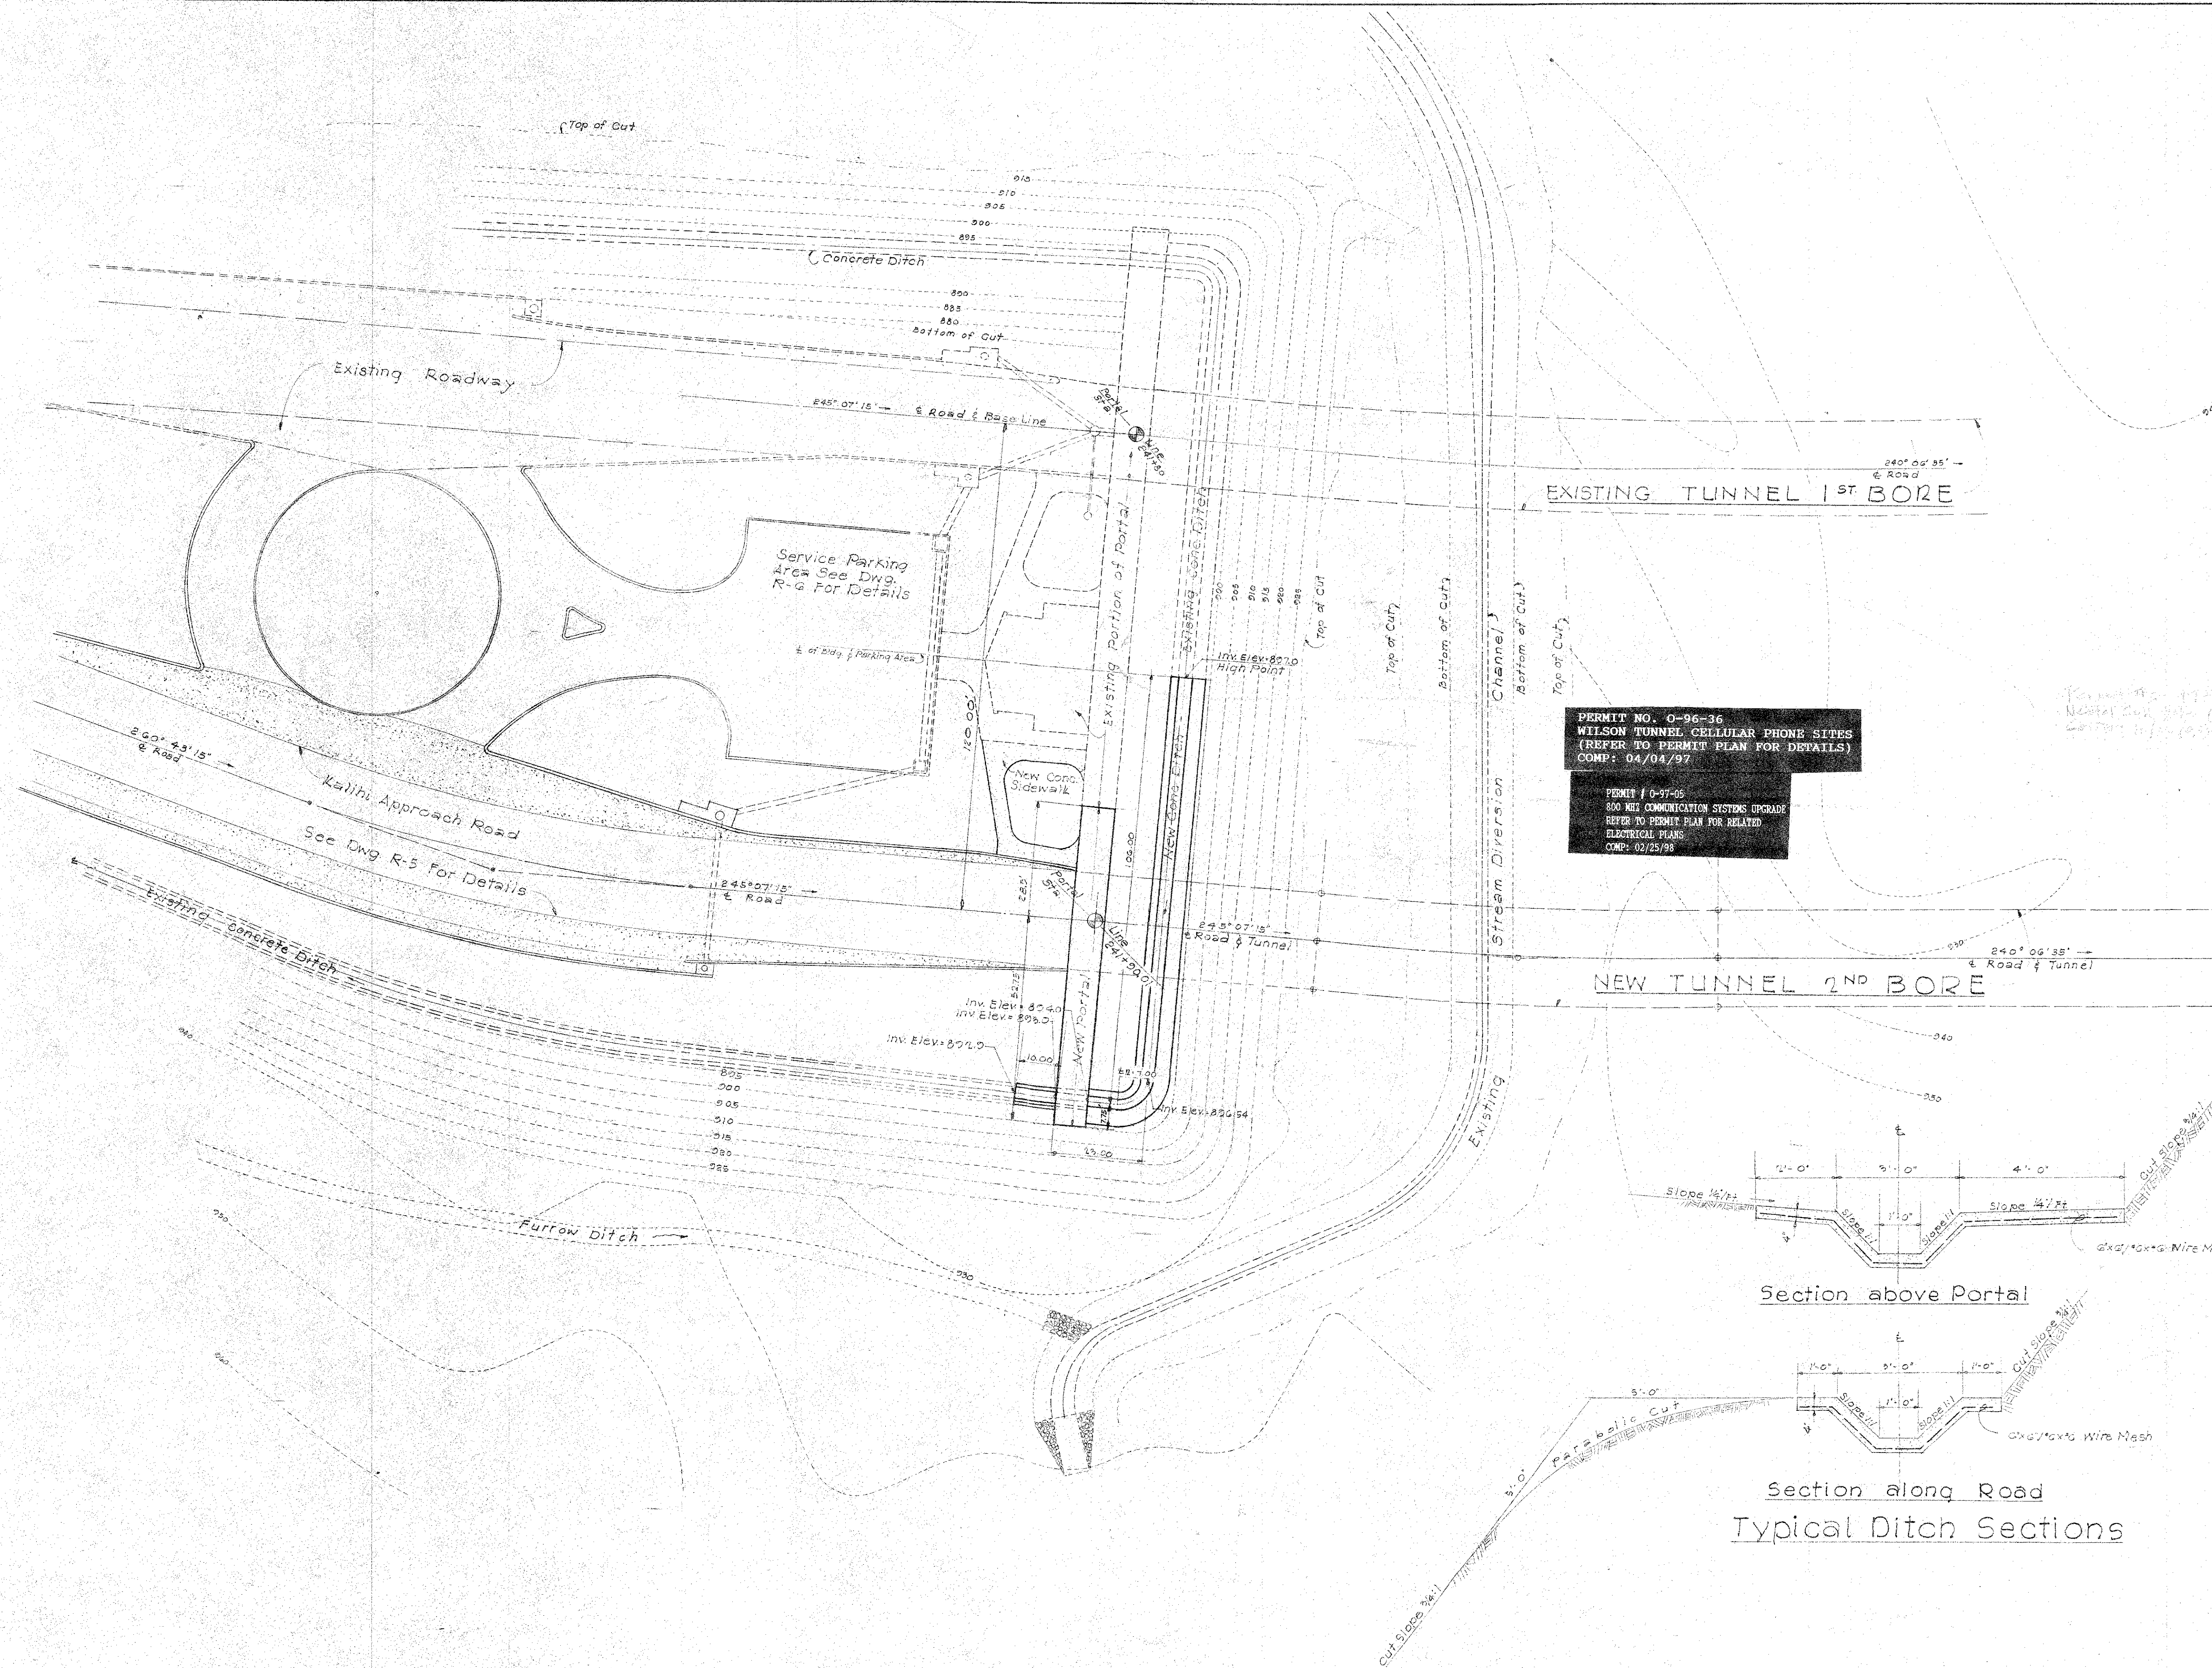

SYMBOLS

-----%0----- Exist Contour
----- Exist Structures
----- New Structures

NOTE:
All work shown as existing
shall be built by others.

DEPARTMENT OF PUBLIC WORKS
CITY AND COUNTY OF HONOLULU
BUREAU OF PLANS

WILSON TUNNEL 2nd BORE
KALIHI PORTAL
SITE PLAN

ENGINEER W. L. L. DATE 8-8-57
DRAFTSMAN L. W. CHECKED BY R. K.
SCALE _____ TRACER _____
APPROVED [Signature] APPROVED [Signature]
CHIEF ENGINEER BUREAU ENGINEER

W. S. E.	PROFILE	G. B.
GR. SEC.	F. S.	S. B.
W. M. BY	F. W. BY	S. BY

JOB NO. 13-57 DWG. P-1