

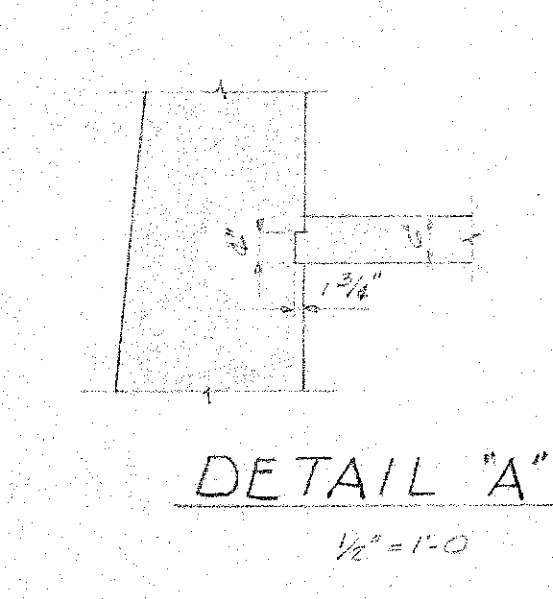
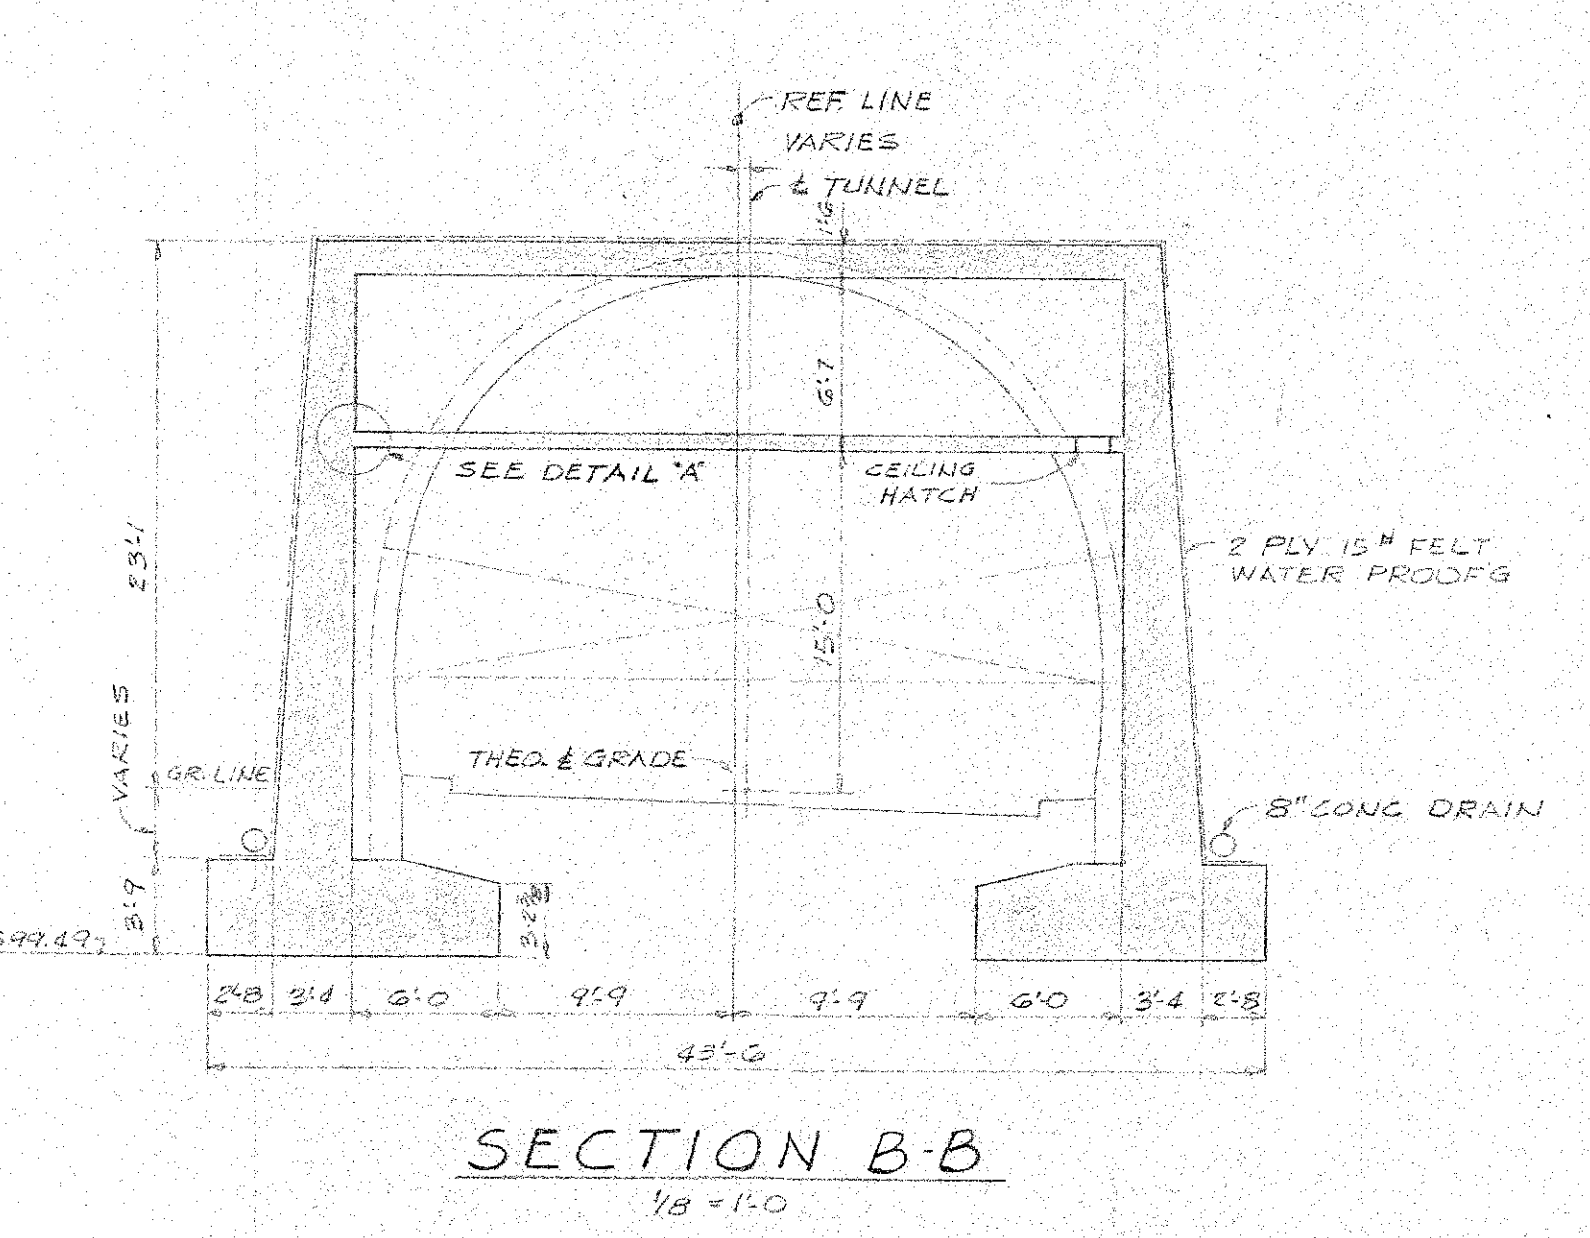
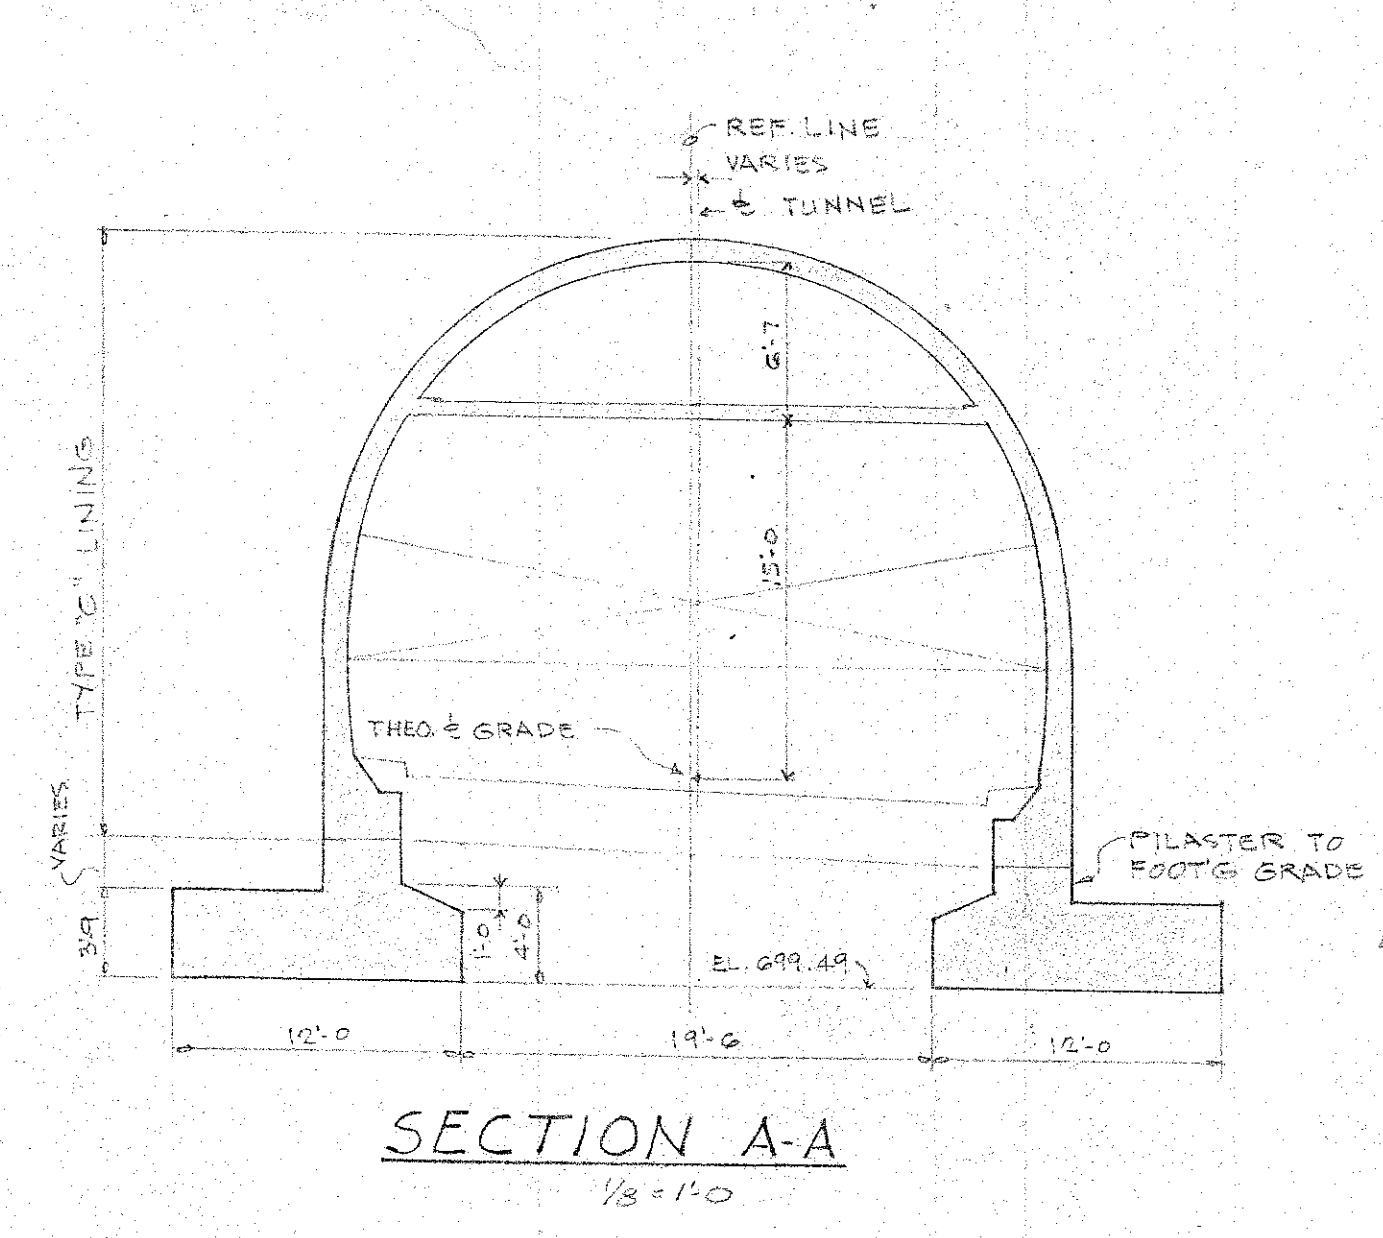
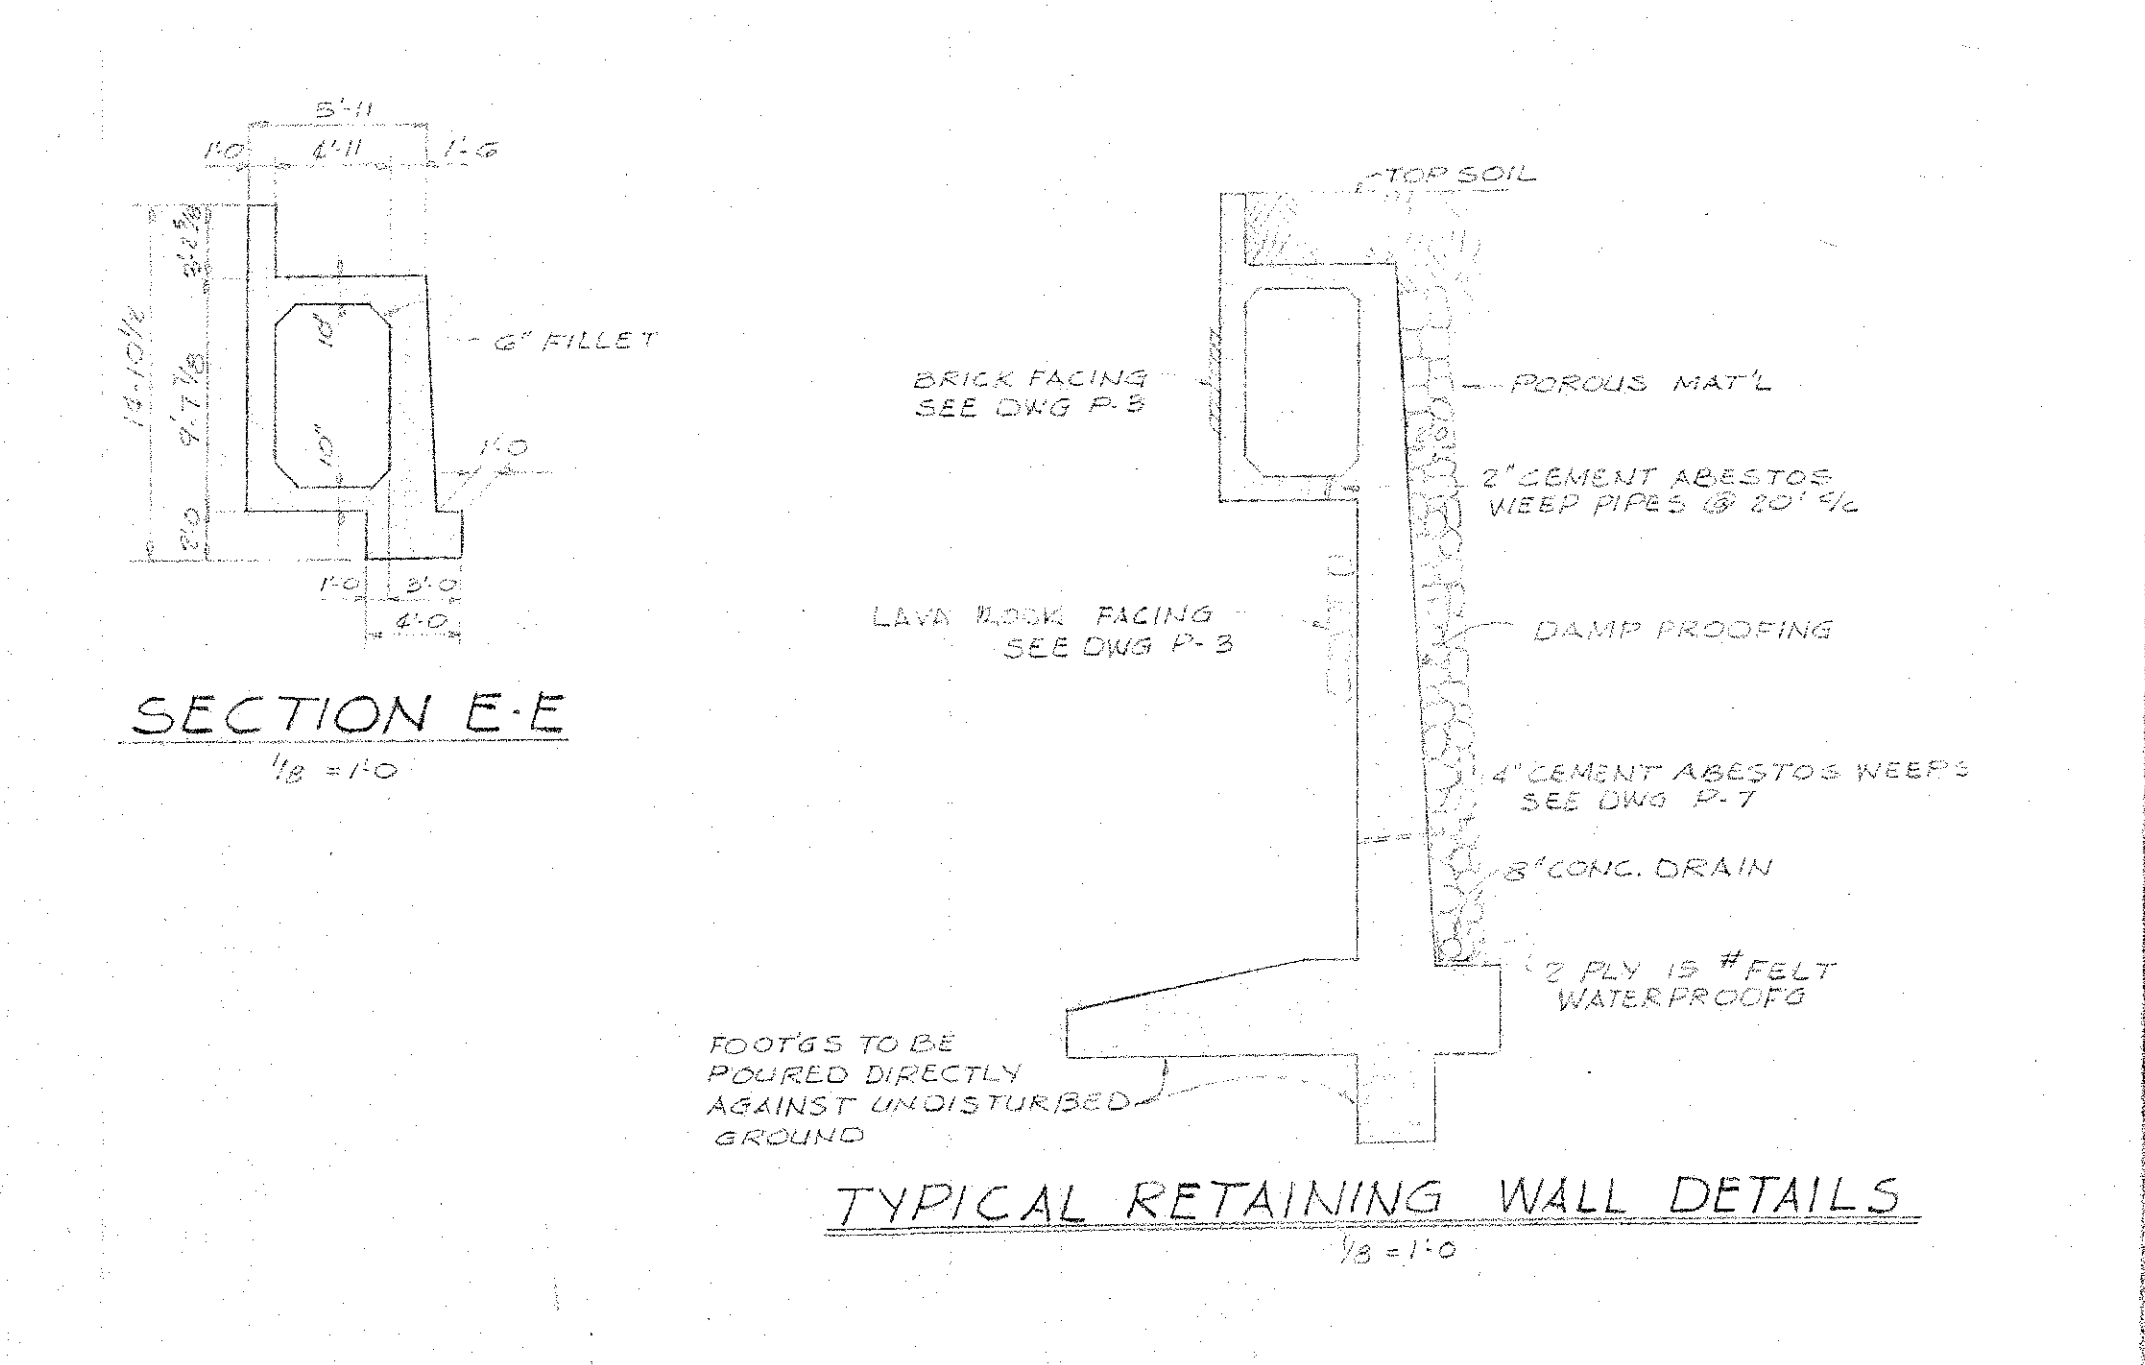
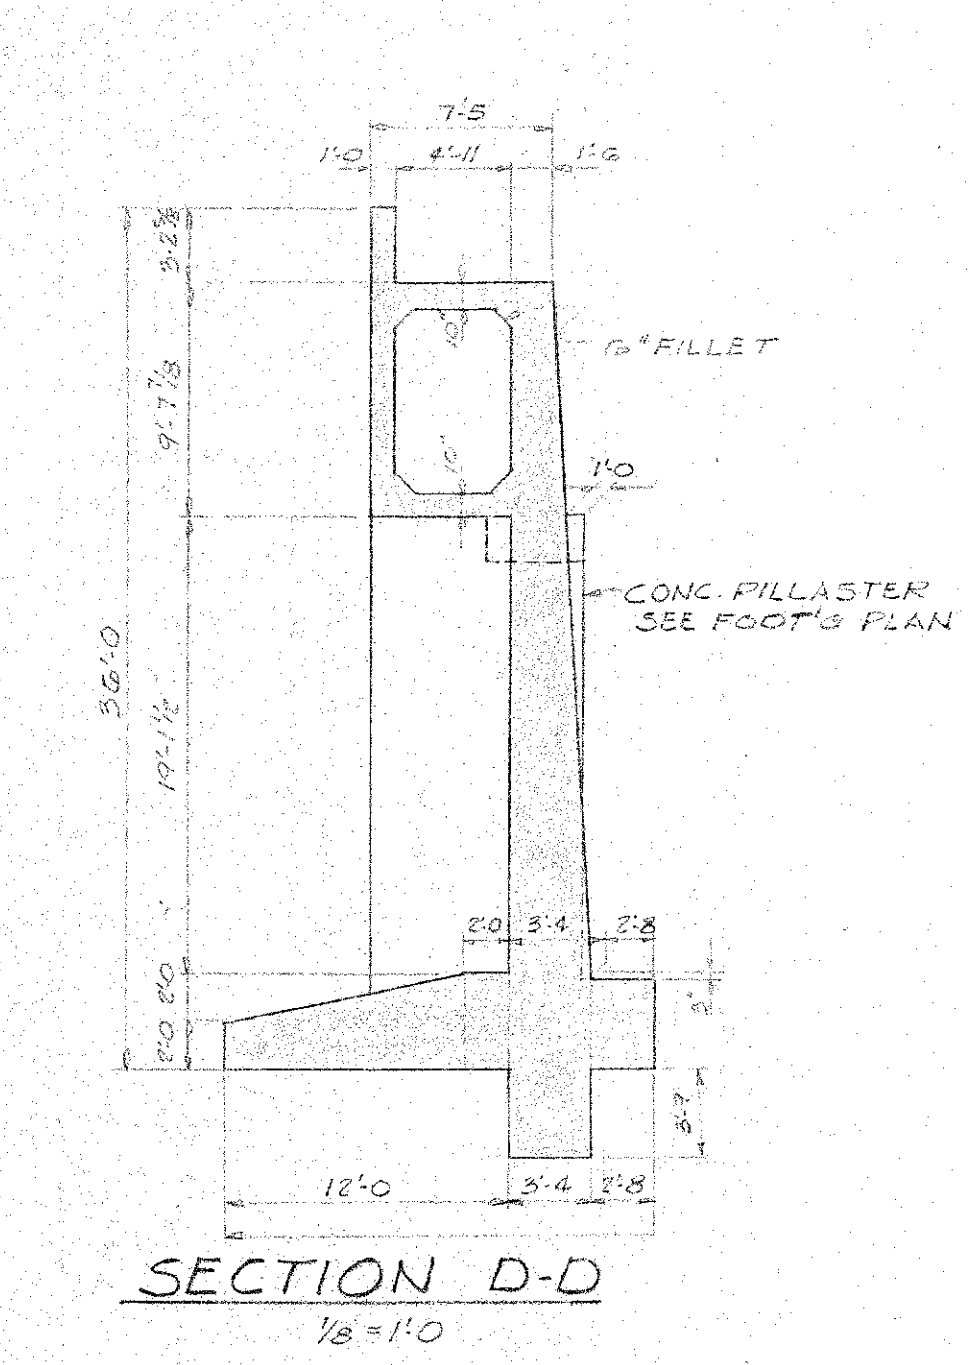
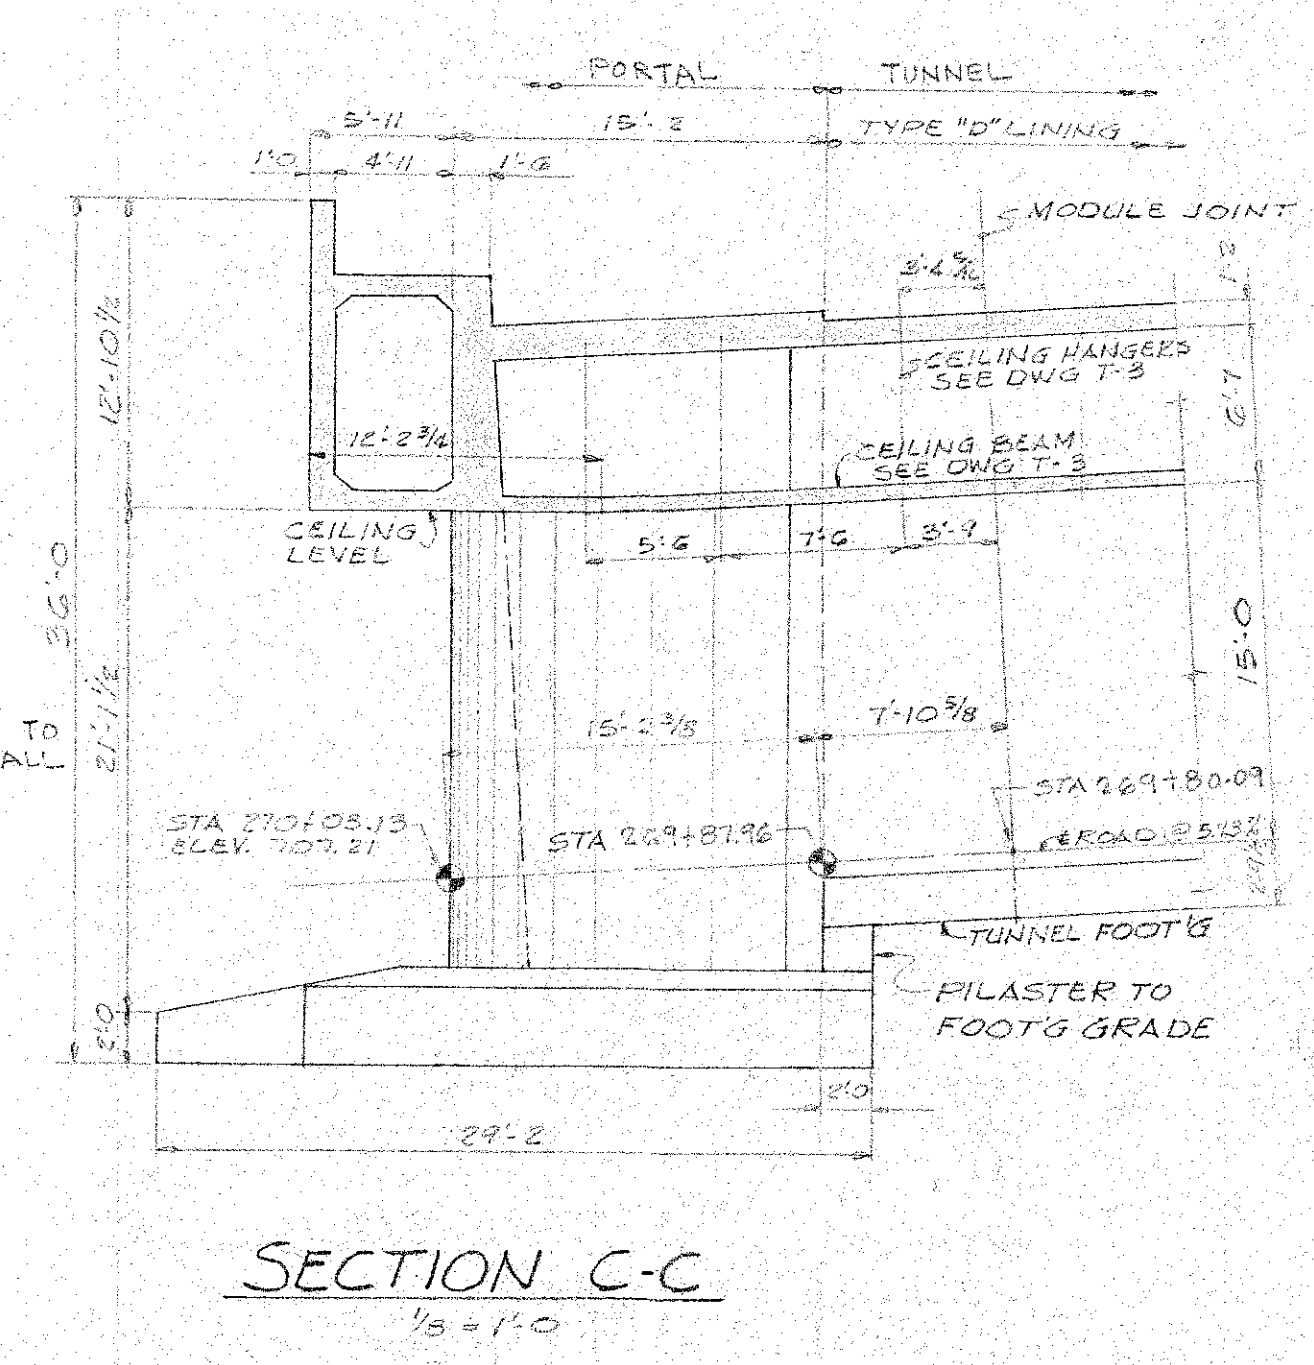
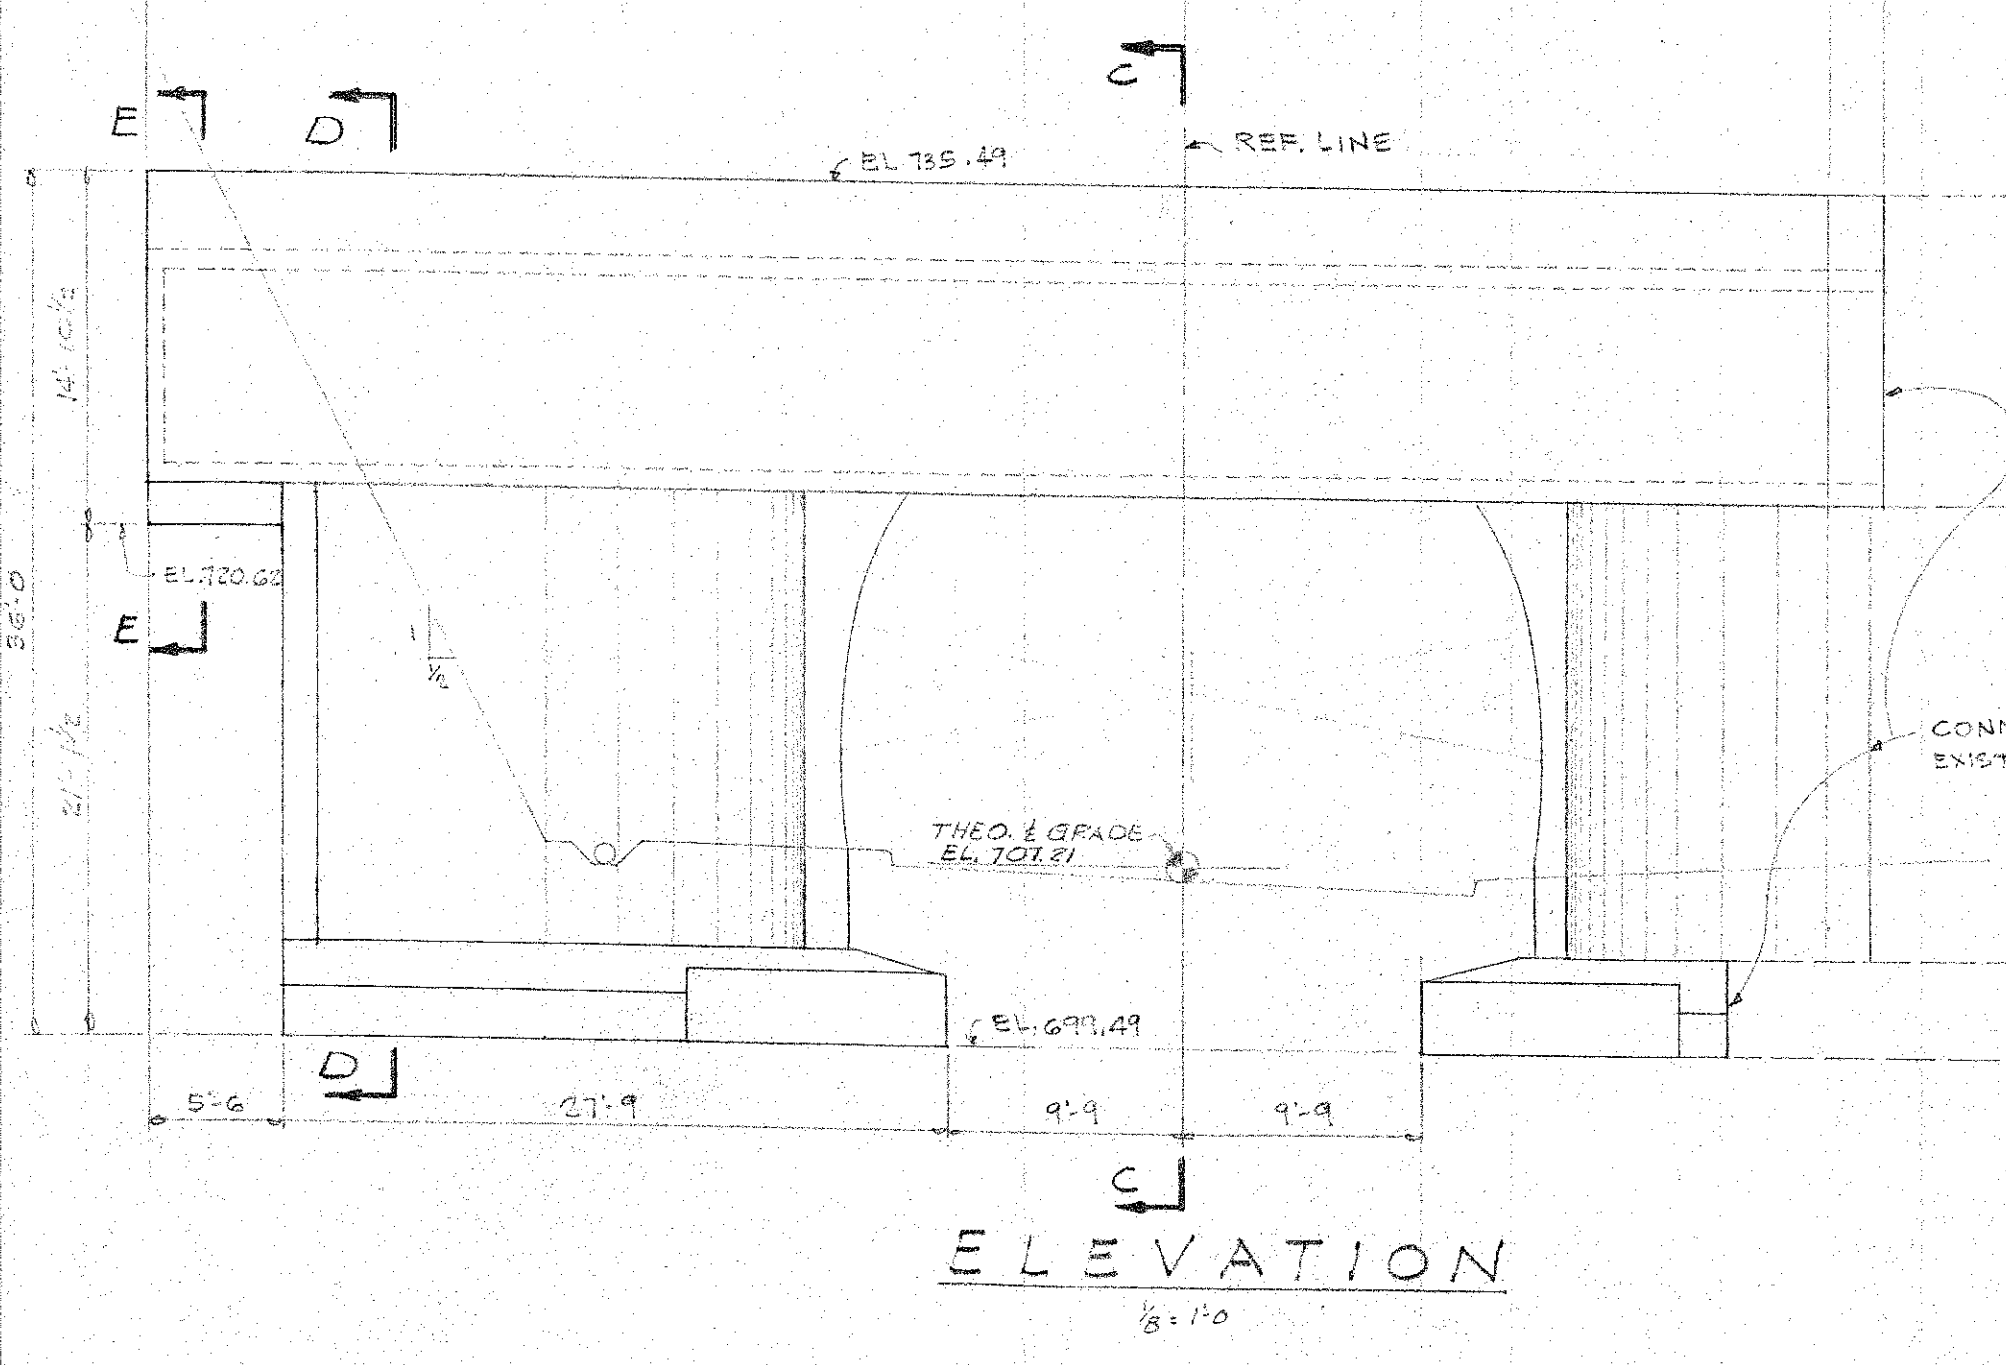
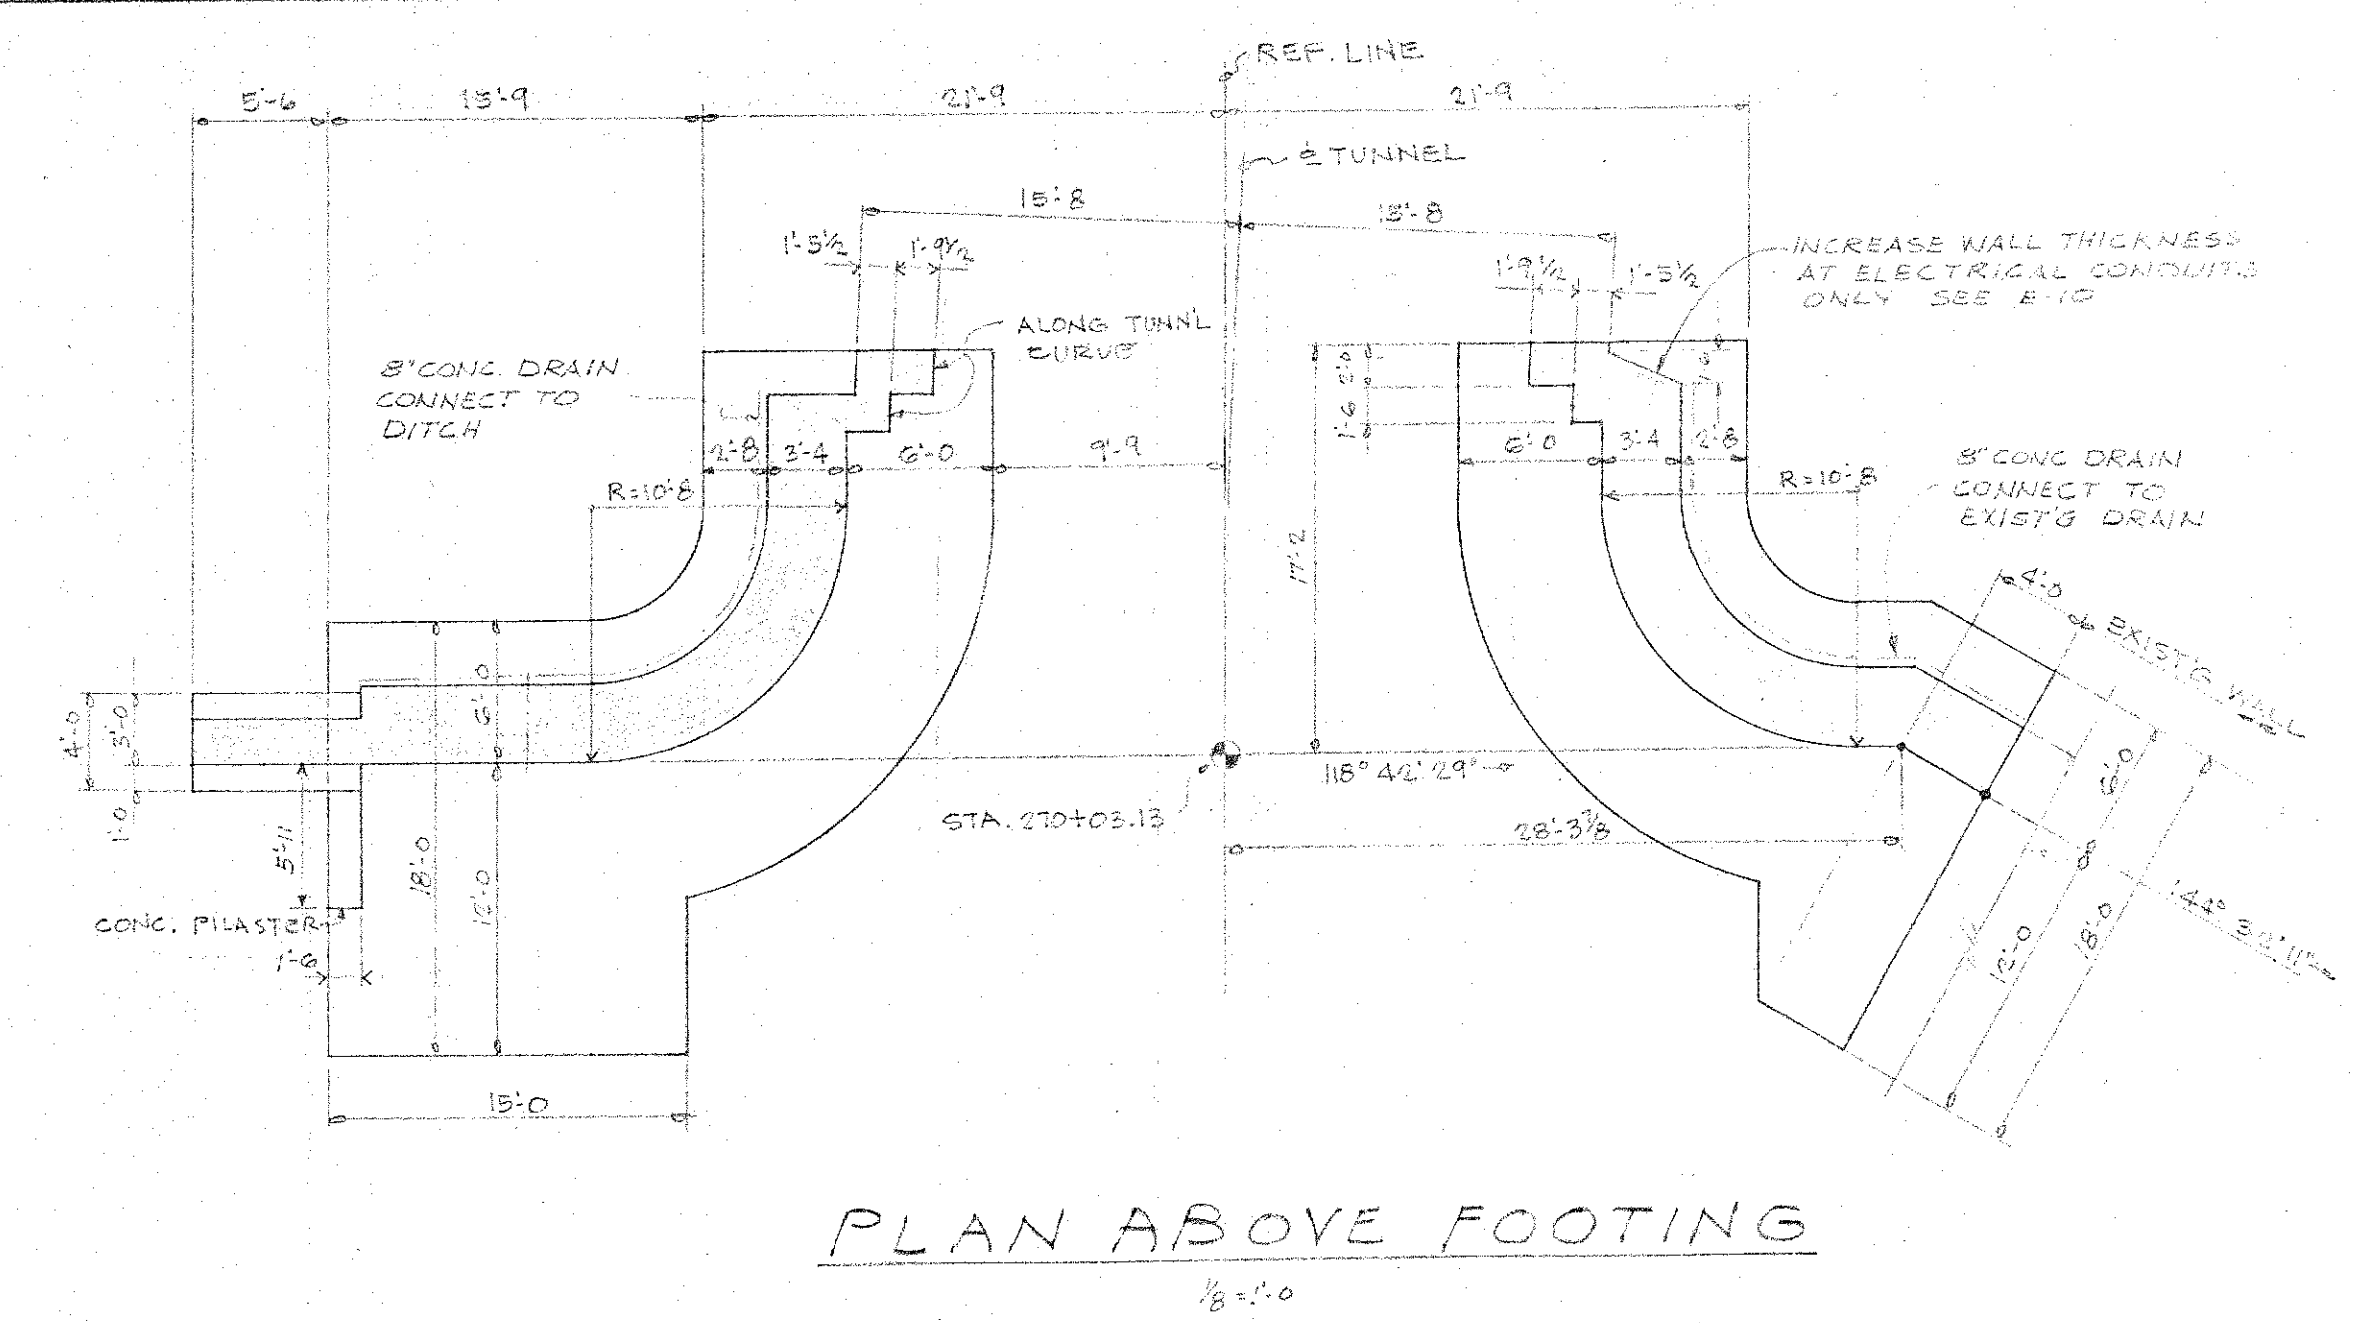
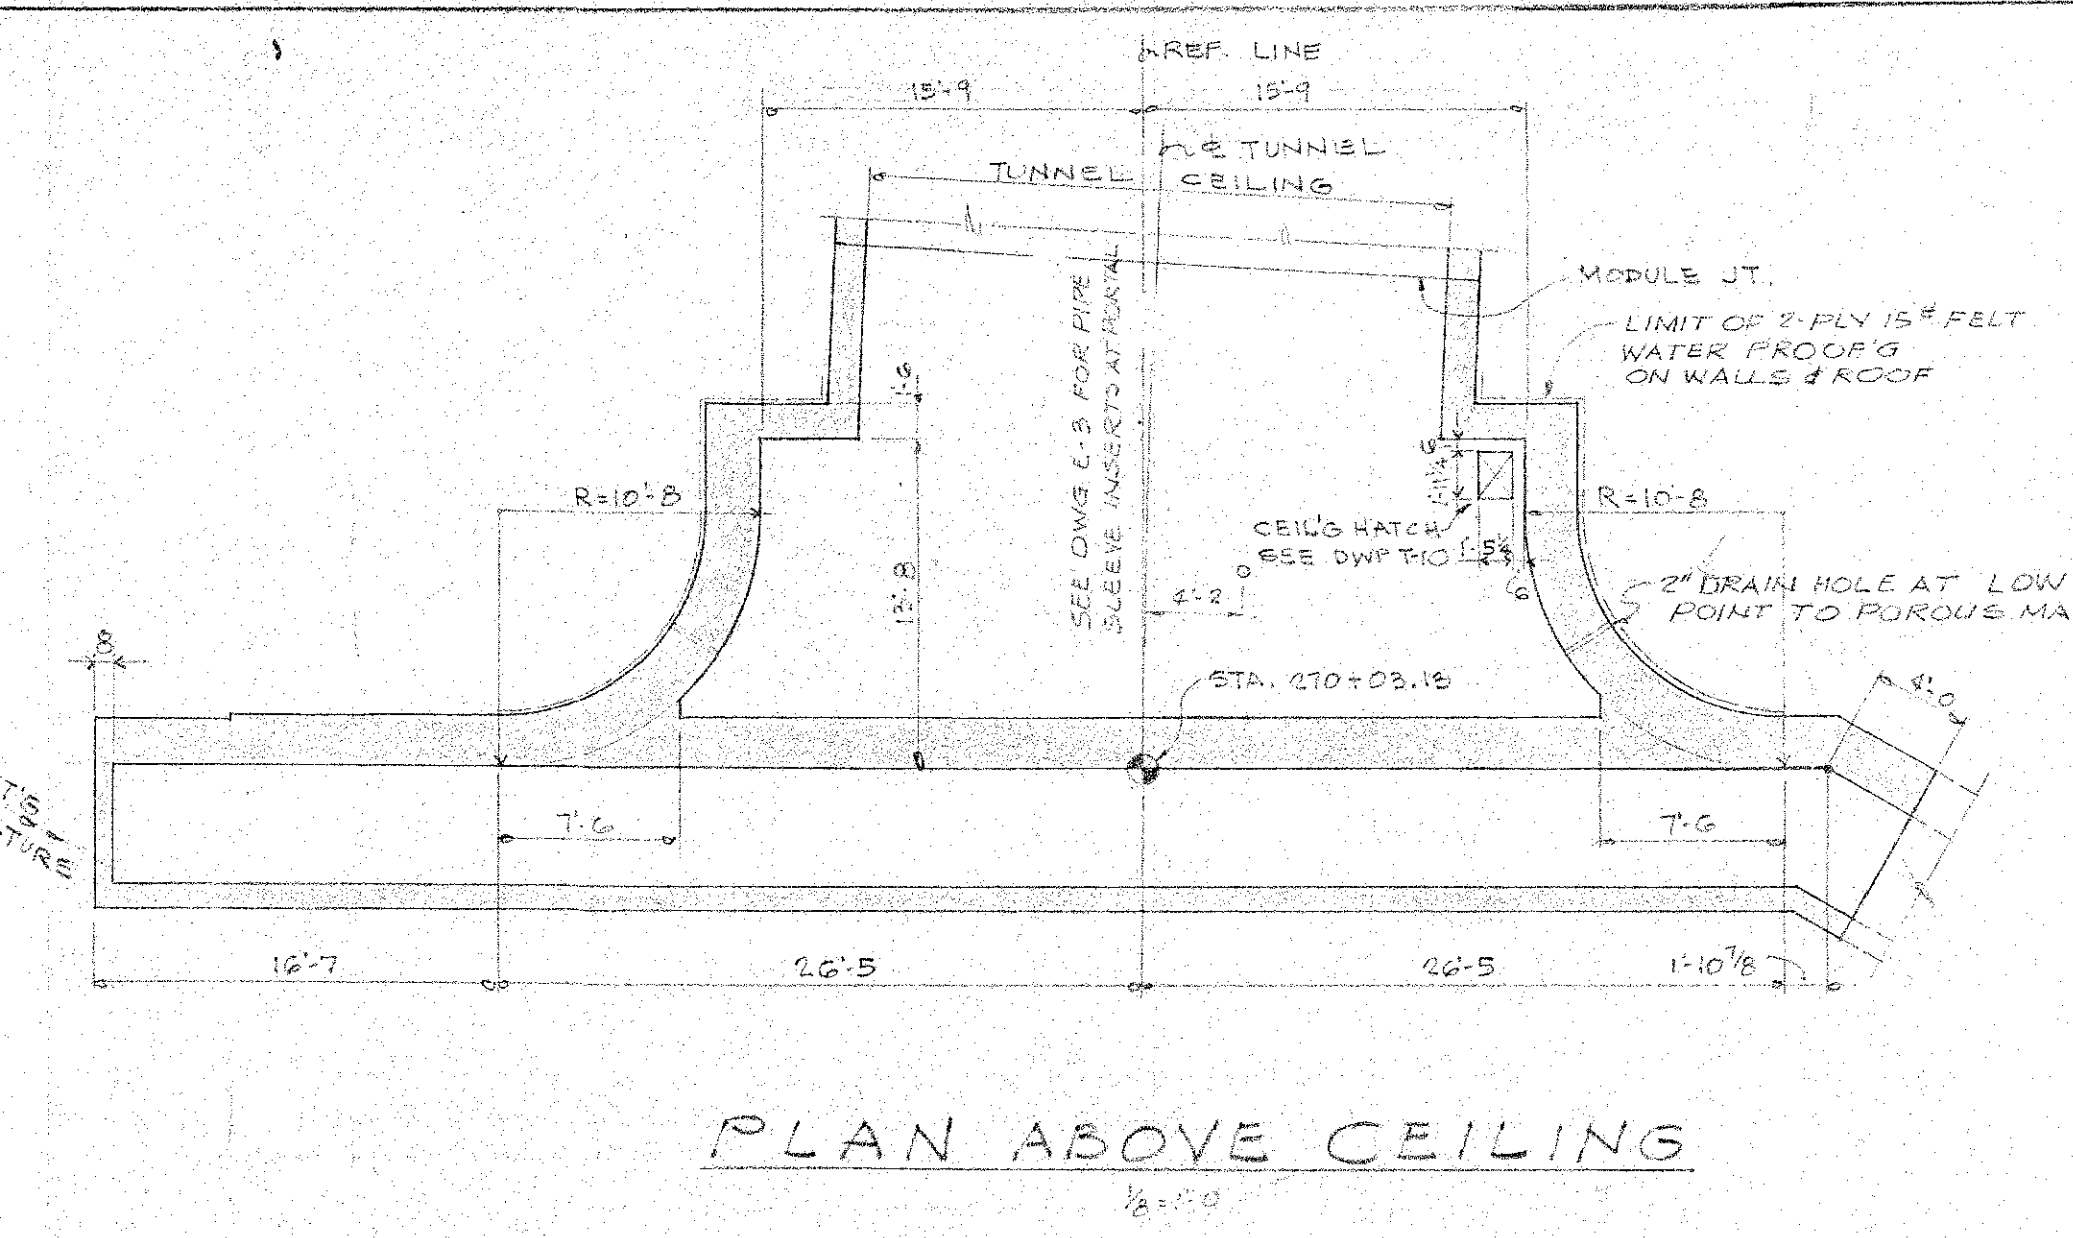
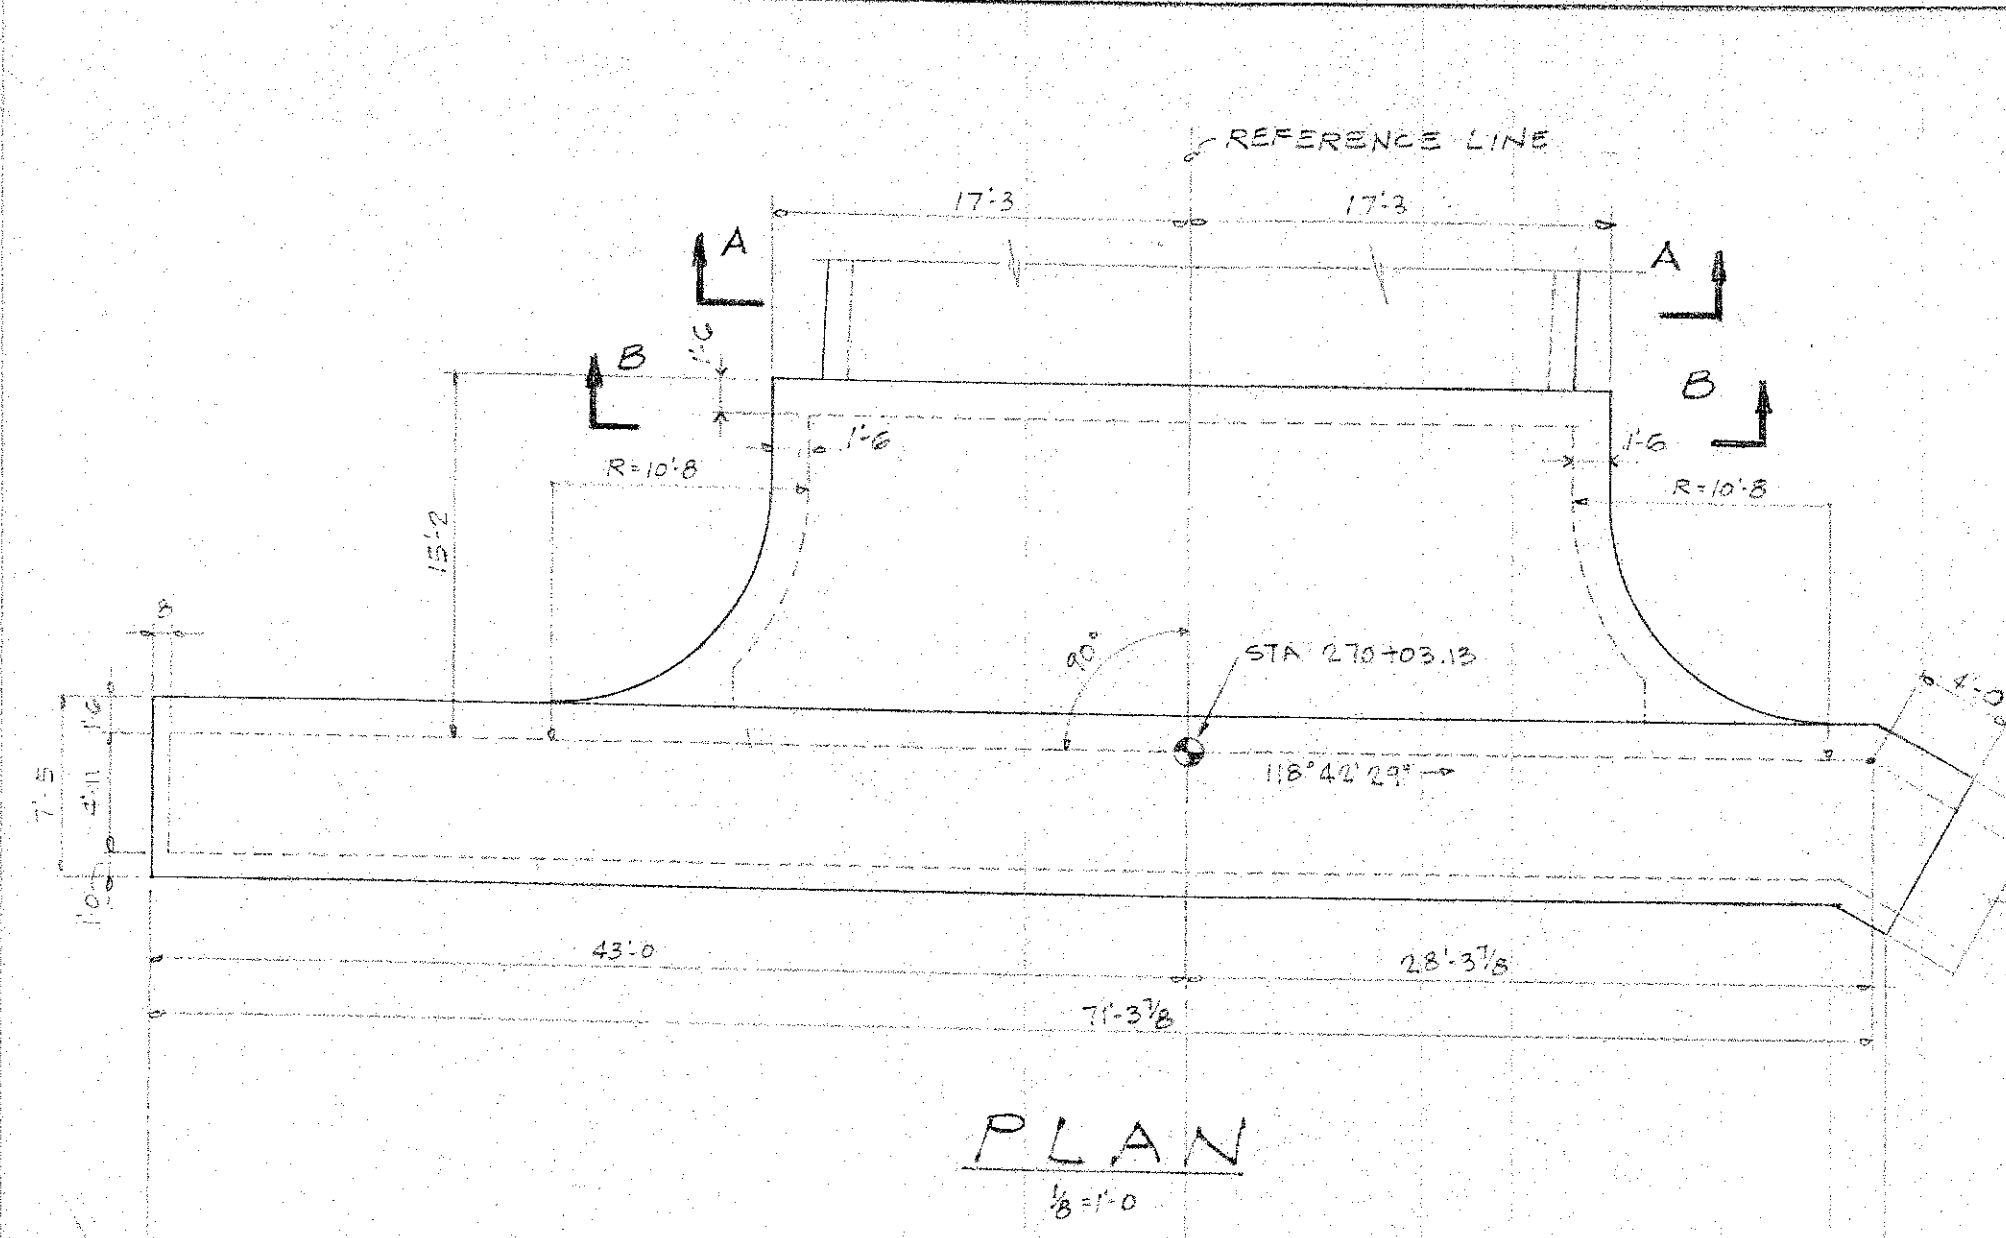
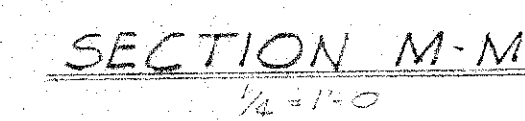
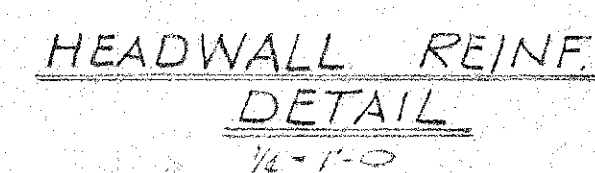
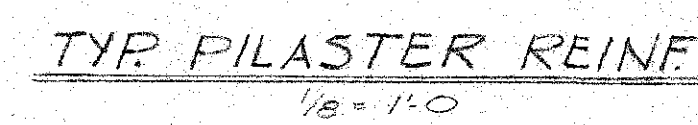
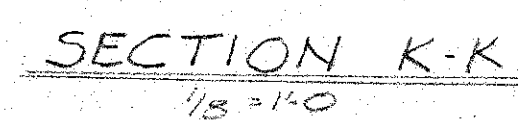
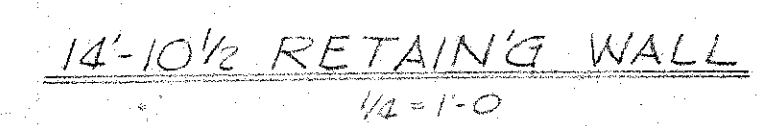
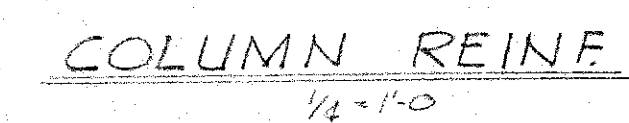
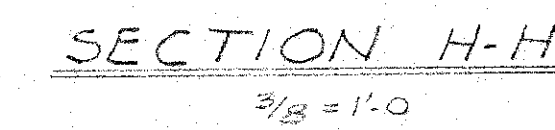
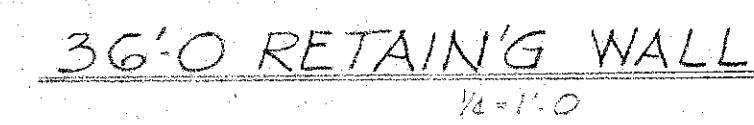
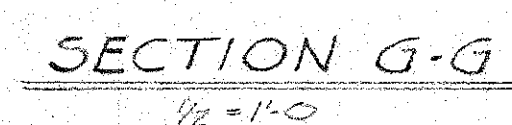
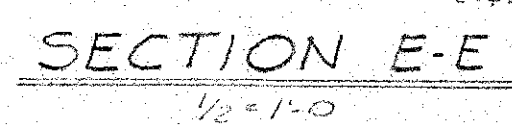
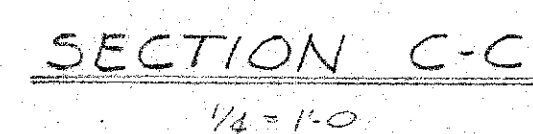
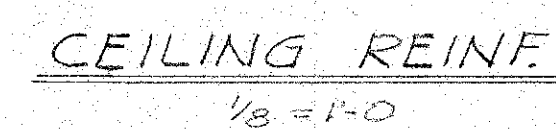
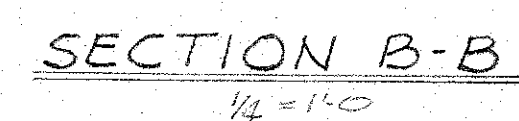


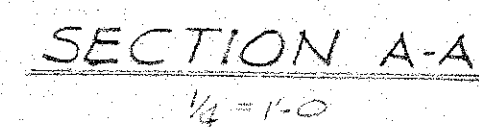

DEPARTMENT OF PUBLIC WORKS CITY AND COUNTY OF HONOLULU BUREAU OF PLANS			
WILSON TUNNEL 2 ND BORE KANE OHE PORTAL STRUCTURAL DETAILS			
ENGINEER	W. L. LAM	DATE	8-3-57
DRAFTSMAN	ROK	CHECKED BY	ROK
SCALE		TRACER	
APPROVED	W. L. LAM	APPROVED	W. L. LAM
CHIEF ENGINEER		BUREAU ENGINEER	
W. L. LAM	PROFILE	C. B.	
CR. SEC.	F. S.	S. B.	
W. M. BY	F. W. BY	S. BY	
JOB NO. 13-57		DWG. P-8	

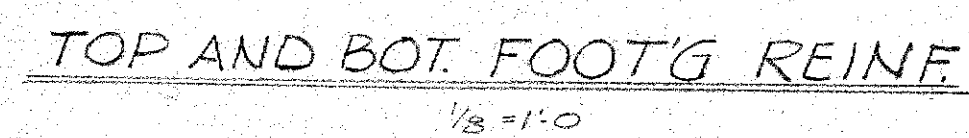

FILE	POCKET	FOLDER	N.O.
11	1	1	1