
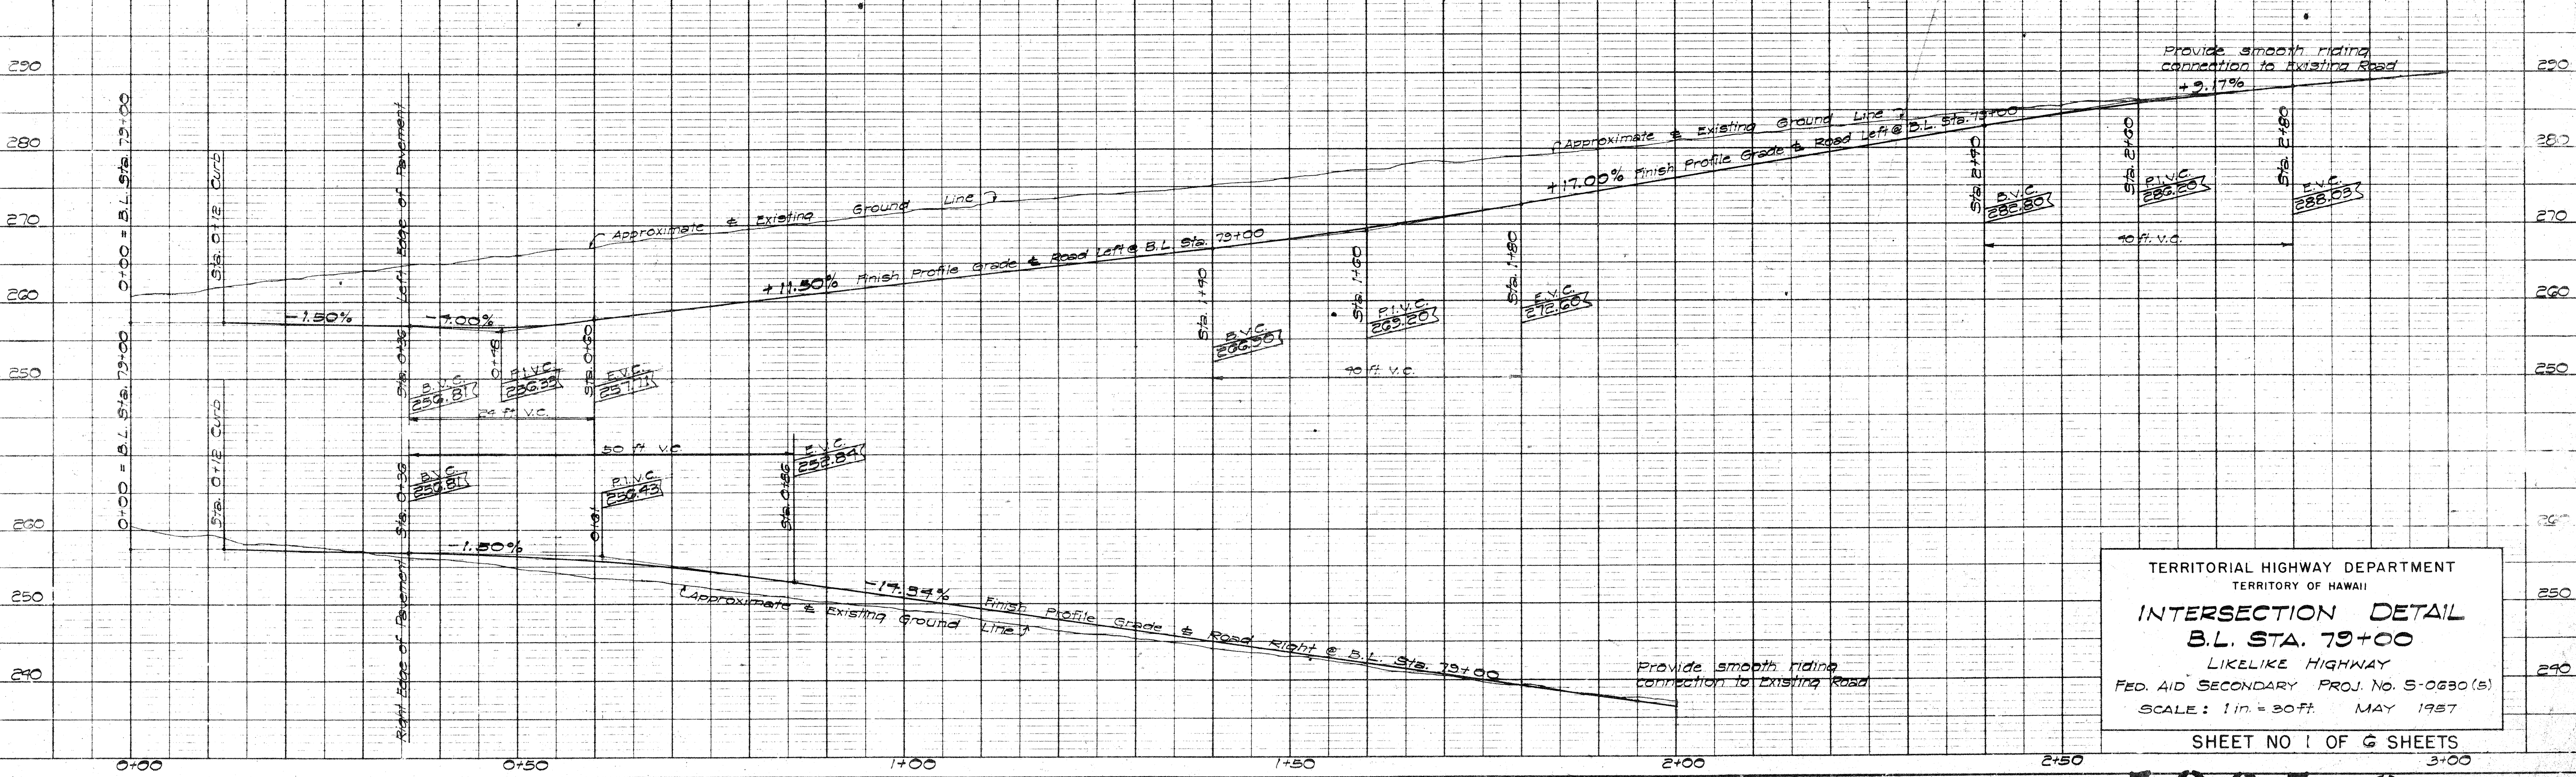
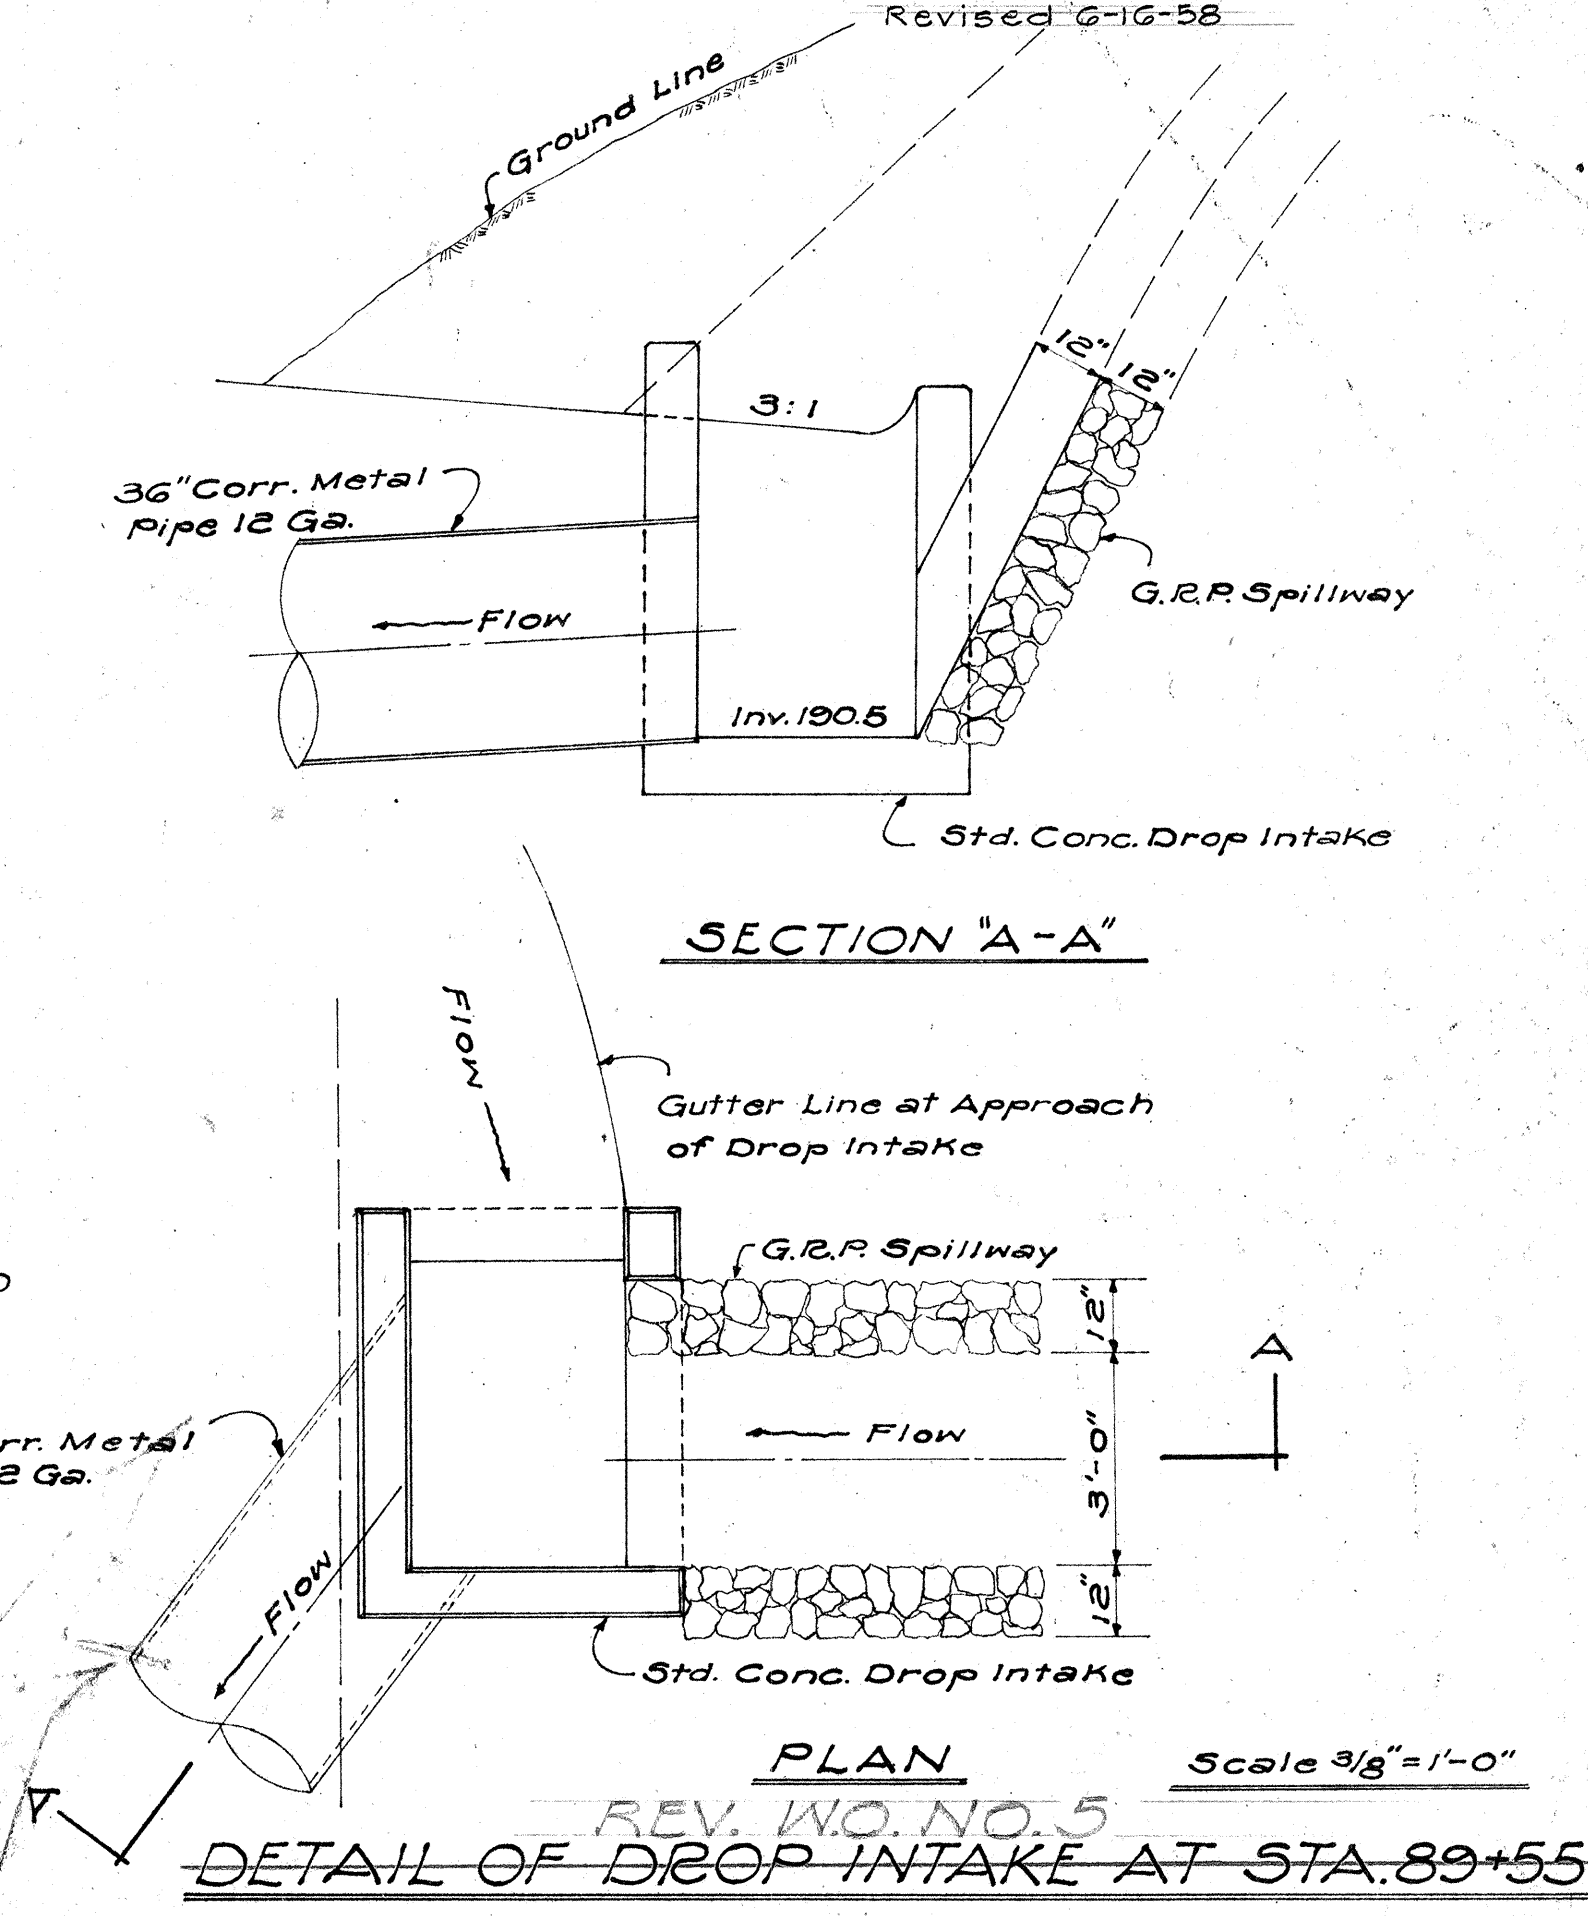


FED. ROAD DIST. NO.	STATE	FED. AID PROJ. NO.	FISCAL YEAR	SHEET NO.	TOTAL SHEETS
HAWAII	HAW.	5-0630(5)	1958	8	53

Revised 6-16-58

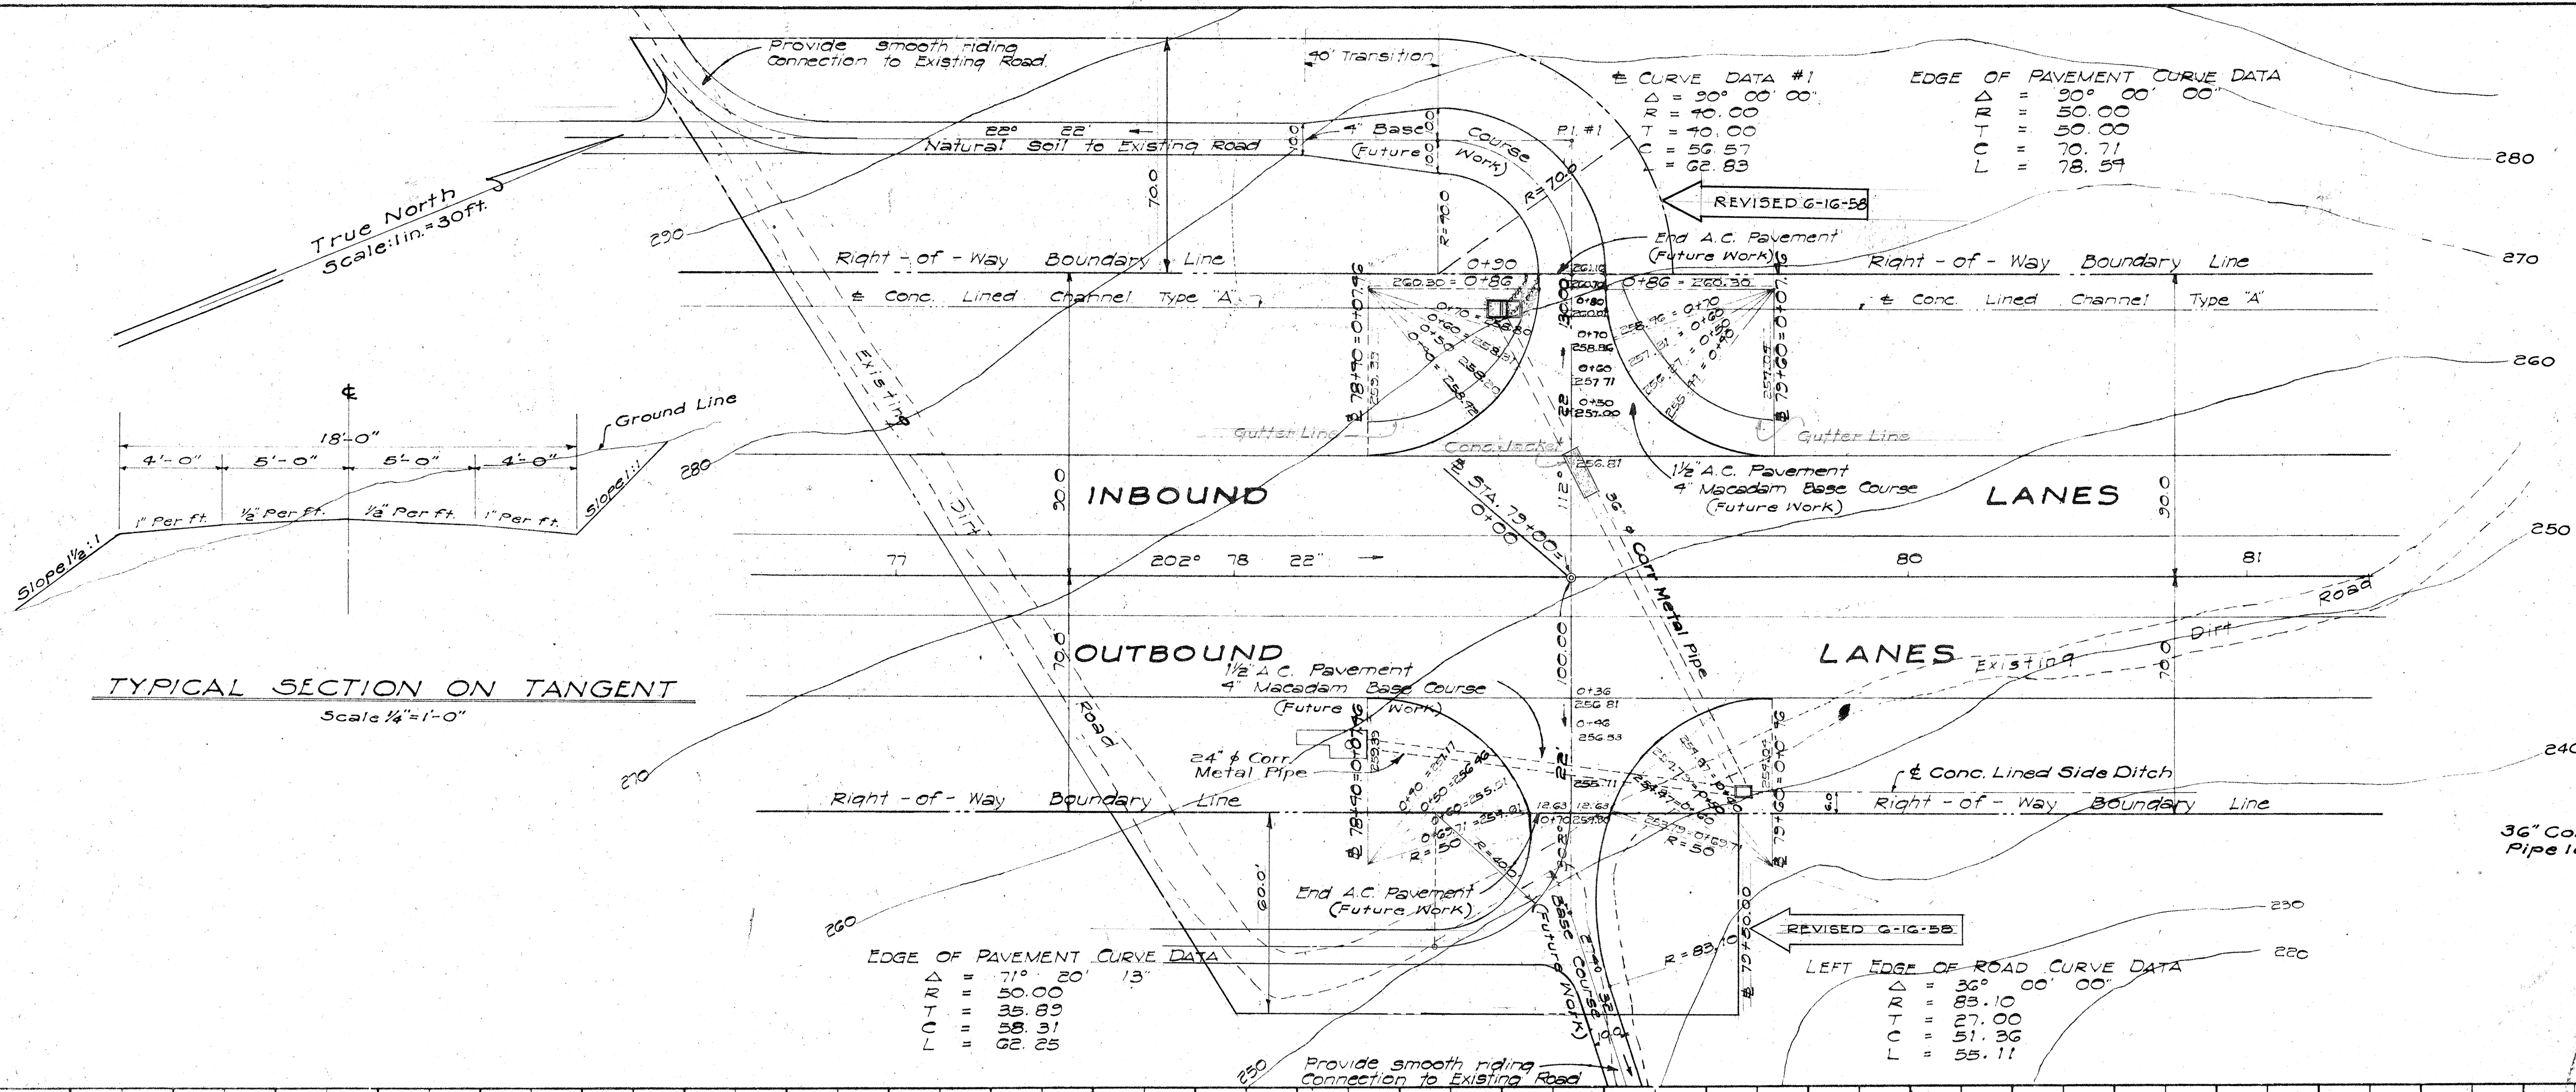


TERRITORIAL HIGHWAY DEPARTMENT
TERRITORY OF HAWAII
INTERSECTION DETAIL
B.L. STA. 79+00
LIKELIKE HIGHWAY
FED. AID SECONDARY PROJ. NO. 5-0630(5)
SCALE: 1 in. = 30 ft. MAY 1957
SHEET NO. 1 OF 6 SHEETS

5905.8


FED. ROAD DIST. NO.	STATE	FED. AID PROJ. NO.	FISCAL YEAR	SHEET NO.	TOTAL SHEETS
HAWAII	HAW.	5-0630(5)	1958	9	53

PLAN	SURVEYED	DATE
NOTE BOOK ALIGNMENT CHECKED	PLOTTED	2"
NO.	RT. OF WAY CHECKED	


PROFILE	SURVEYED	DATE
NOTE BOOK CHECKED	PLOTTED	
NO.	STRUCTURE NOTATIONS CHD.	

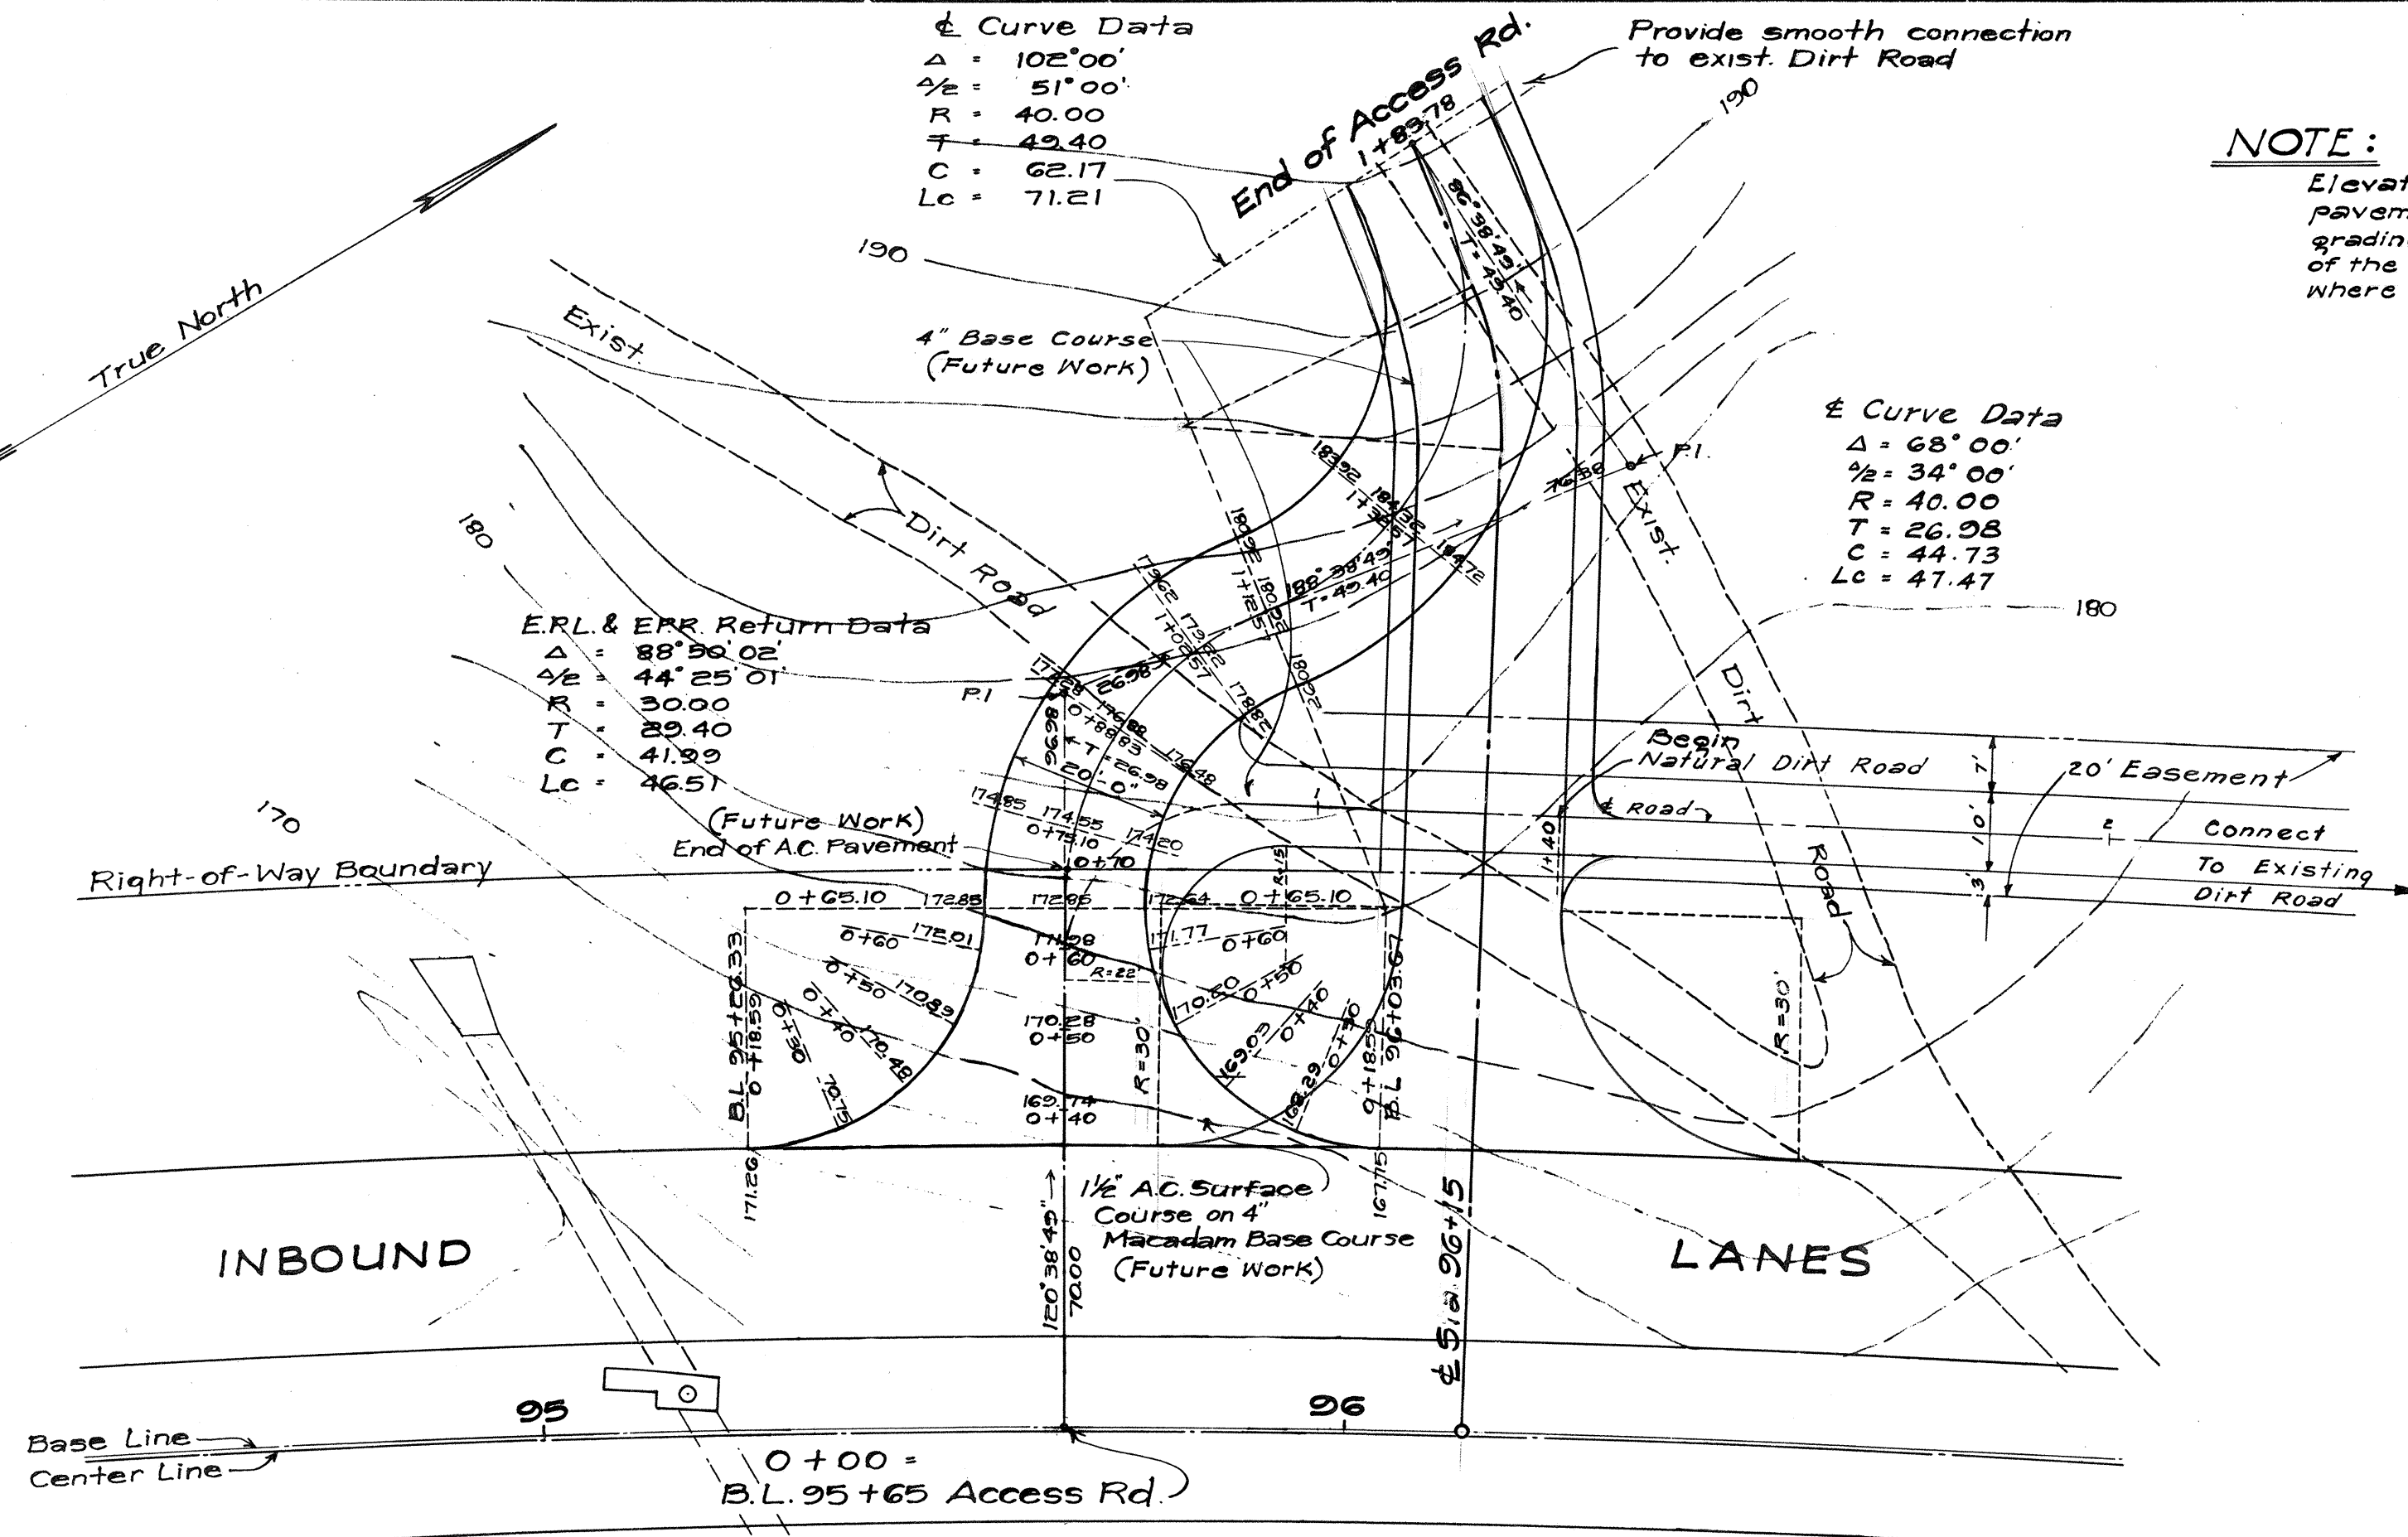


REV. W.O. NO. 3
 PLAN OF ACCESS ROAD AT B.L. STA. 95+65
 Scale: 1 in. = 20 ft.

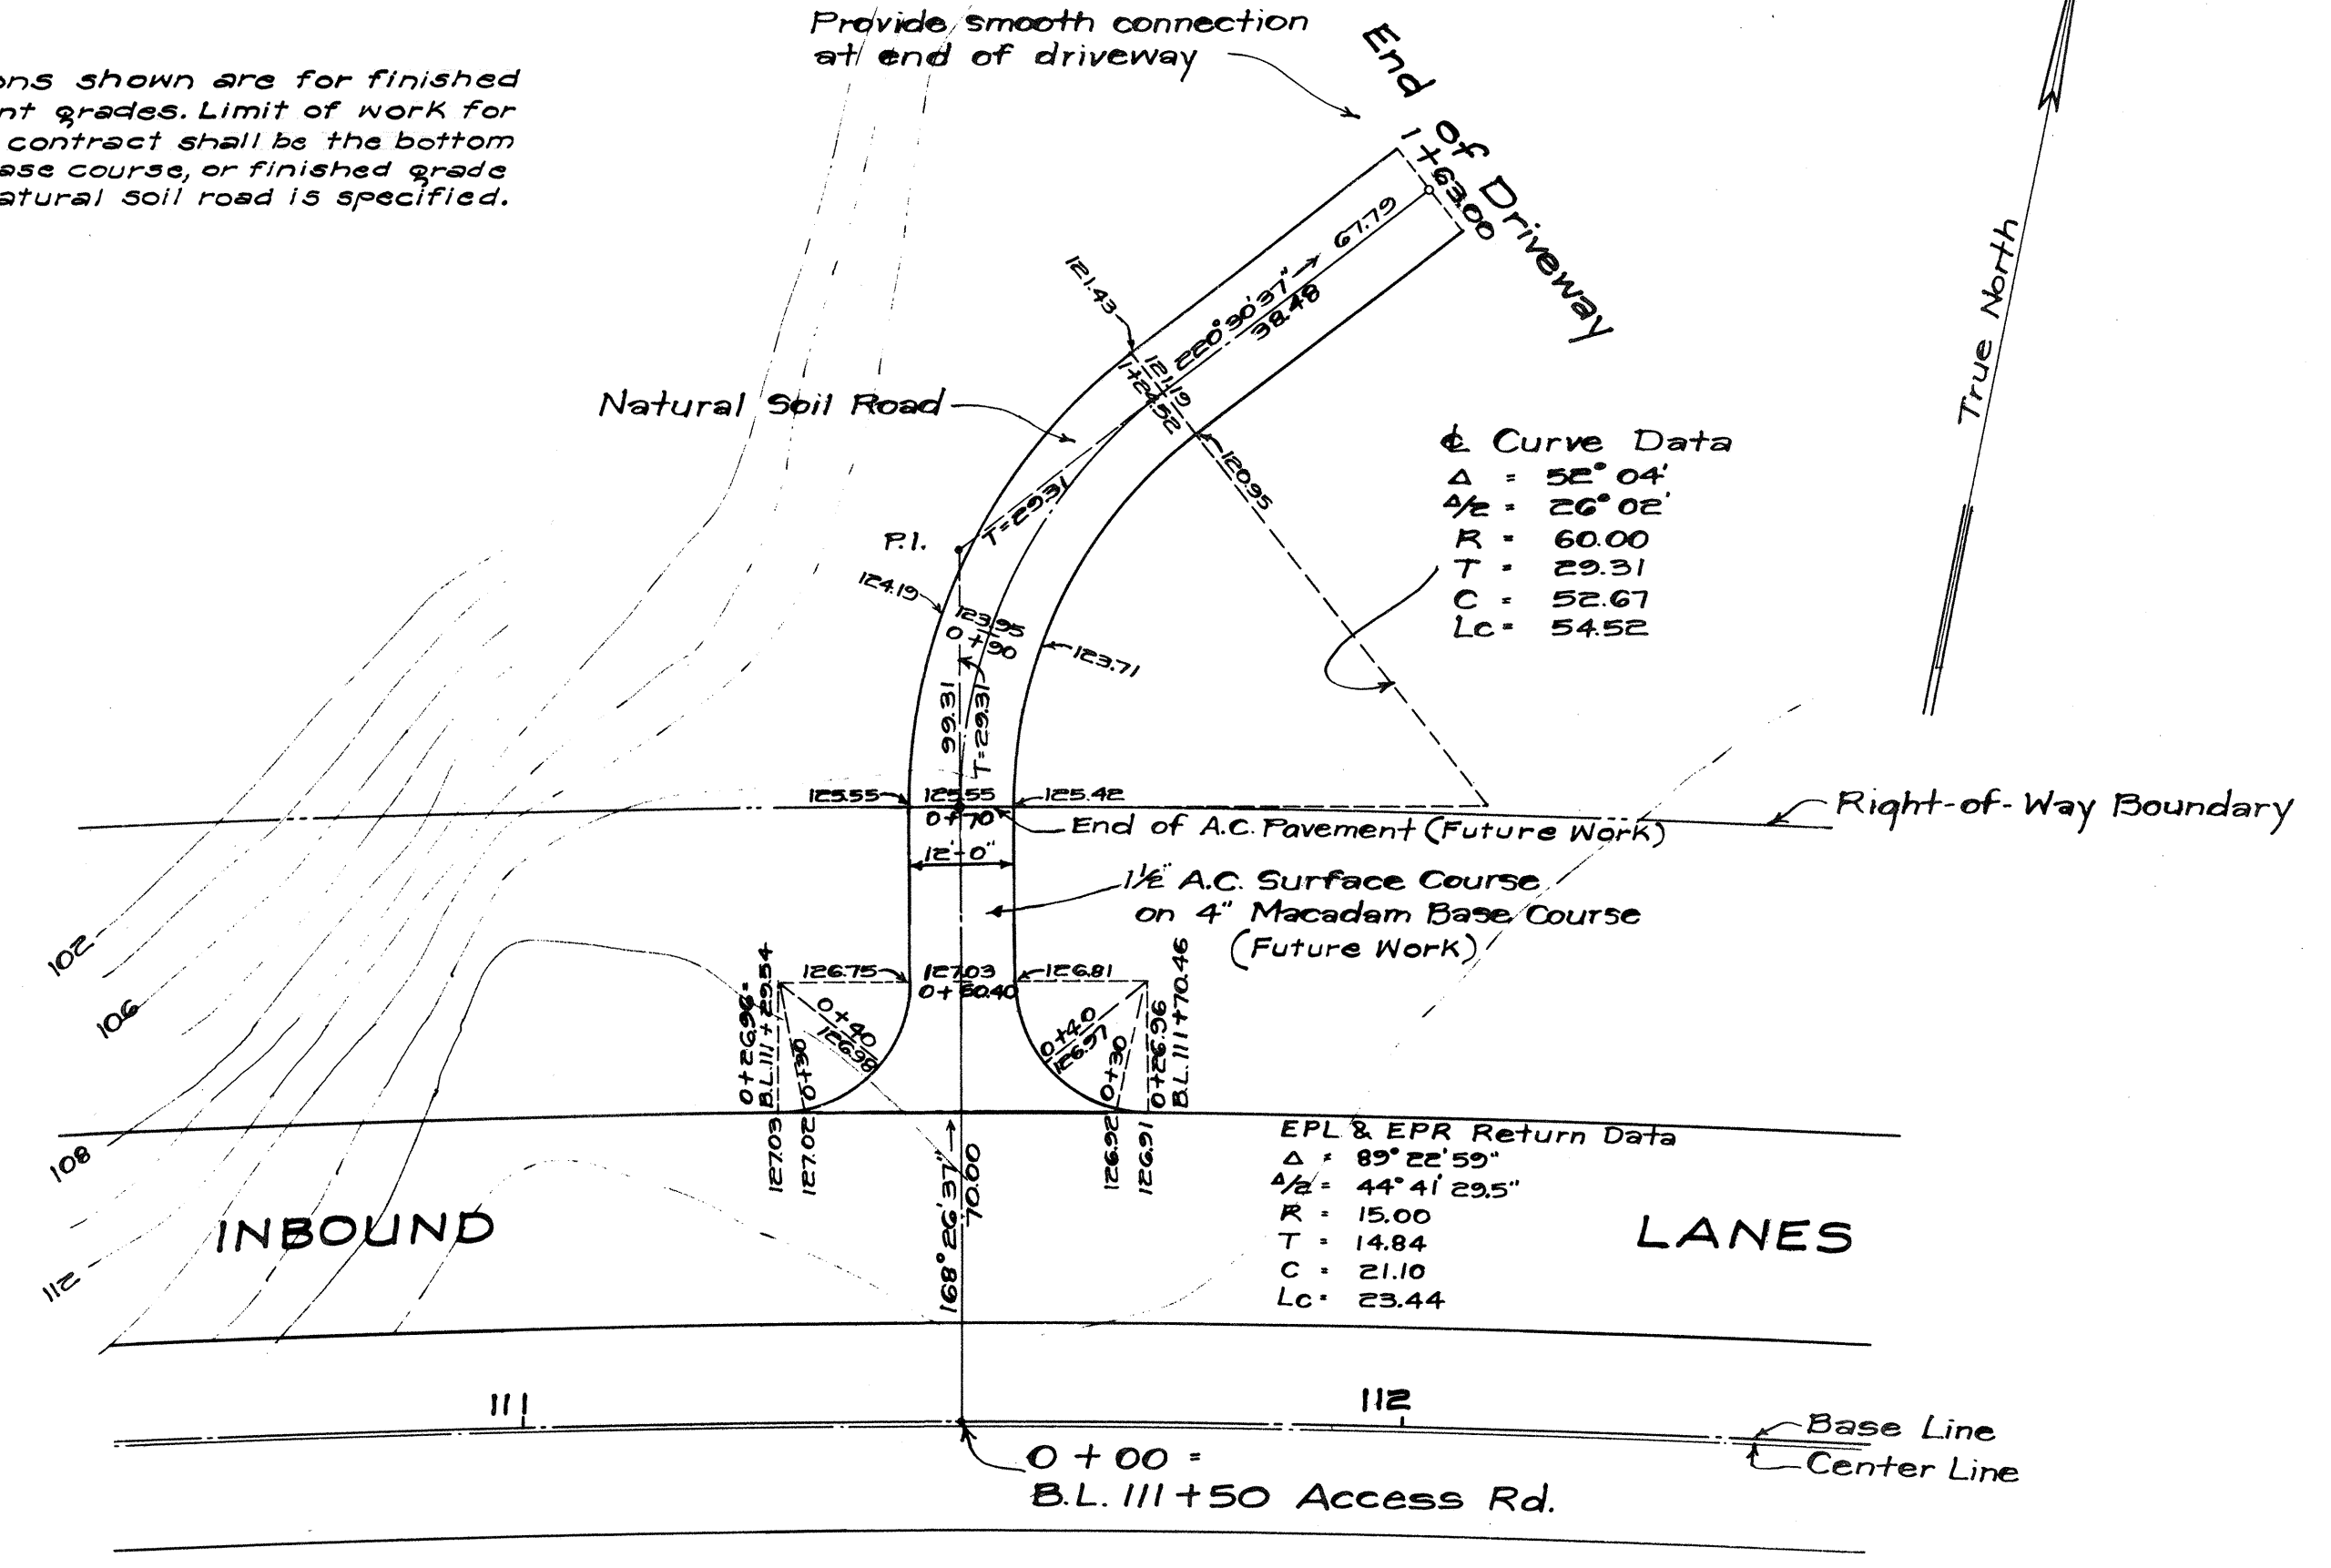

PLAN OF DRIVEWAY AT B.L. STA. 111+50
 Scale: 1 in. = 20 ft.

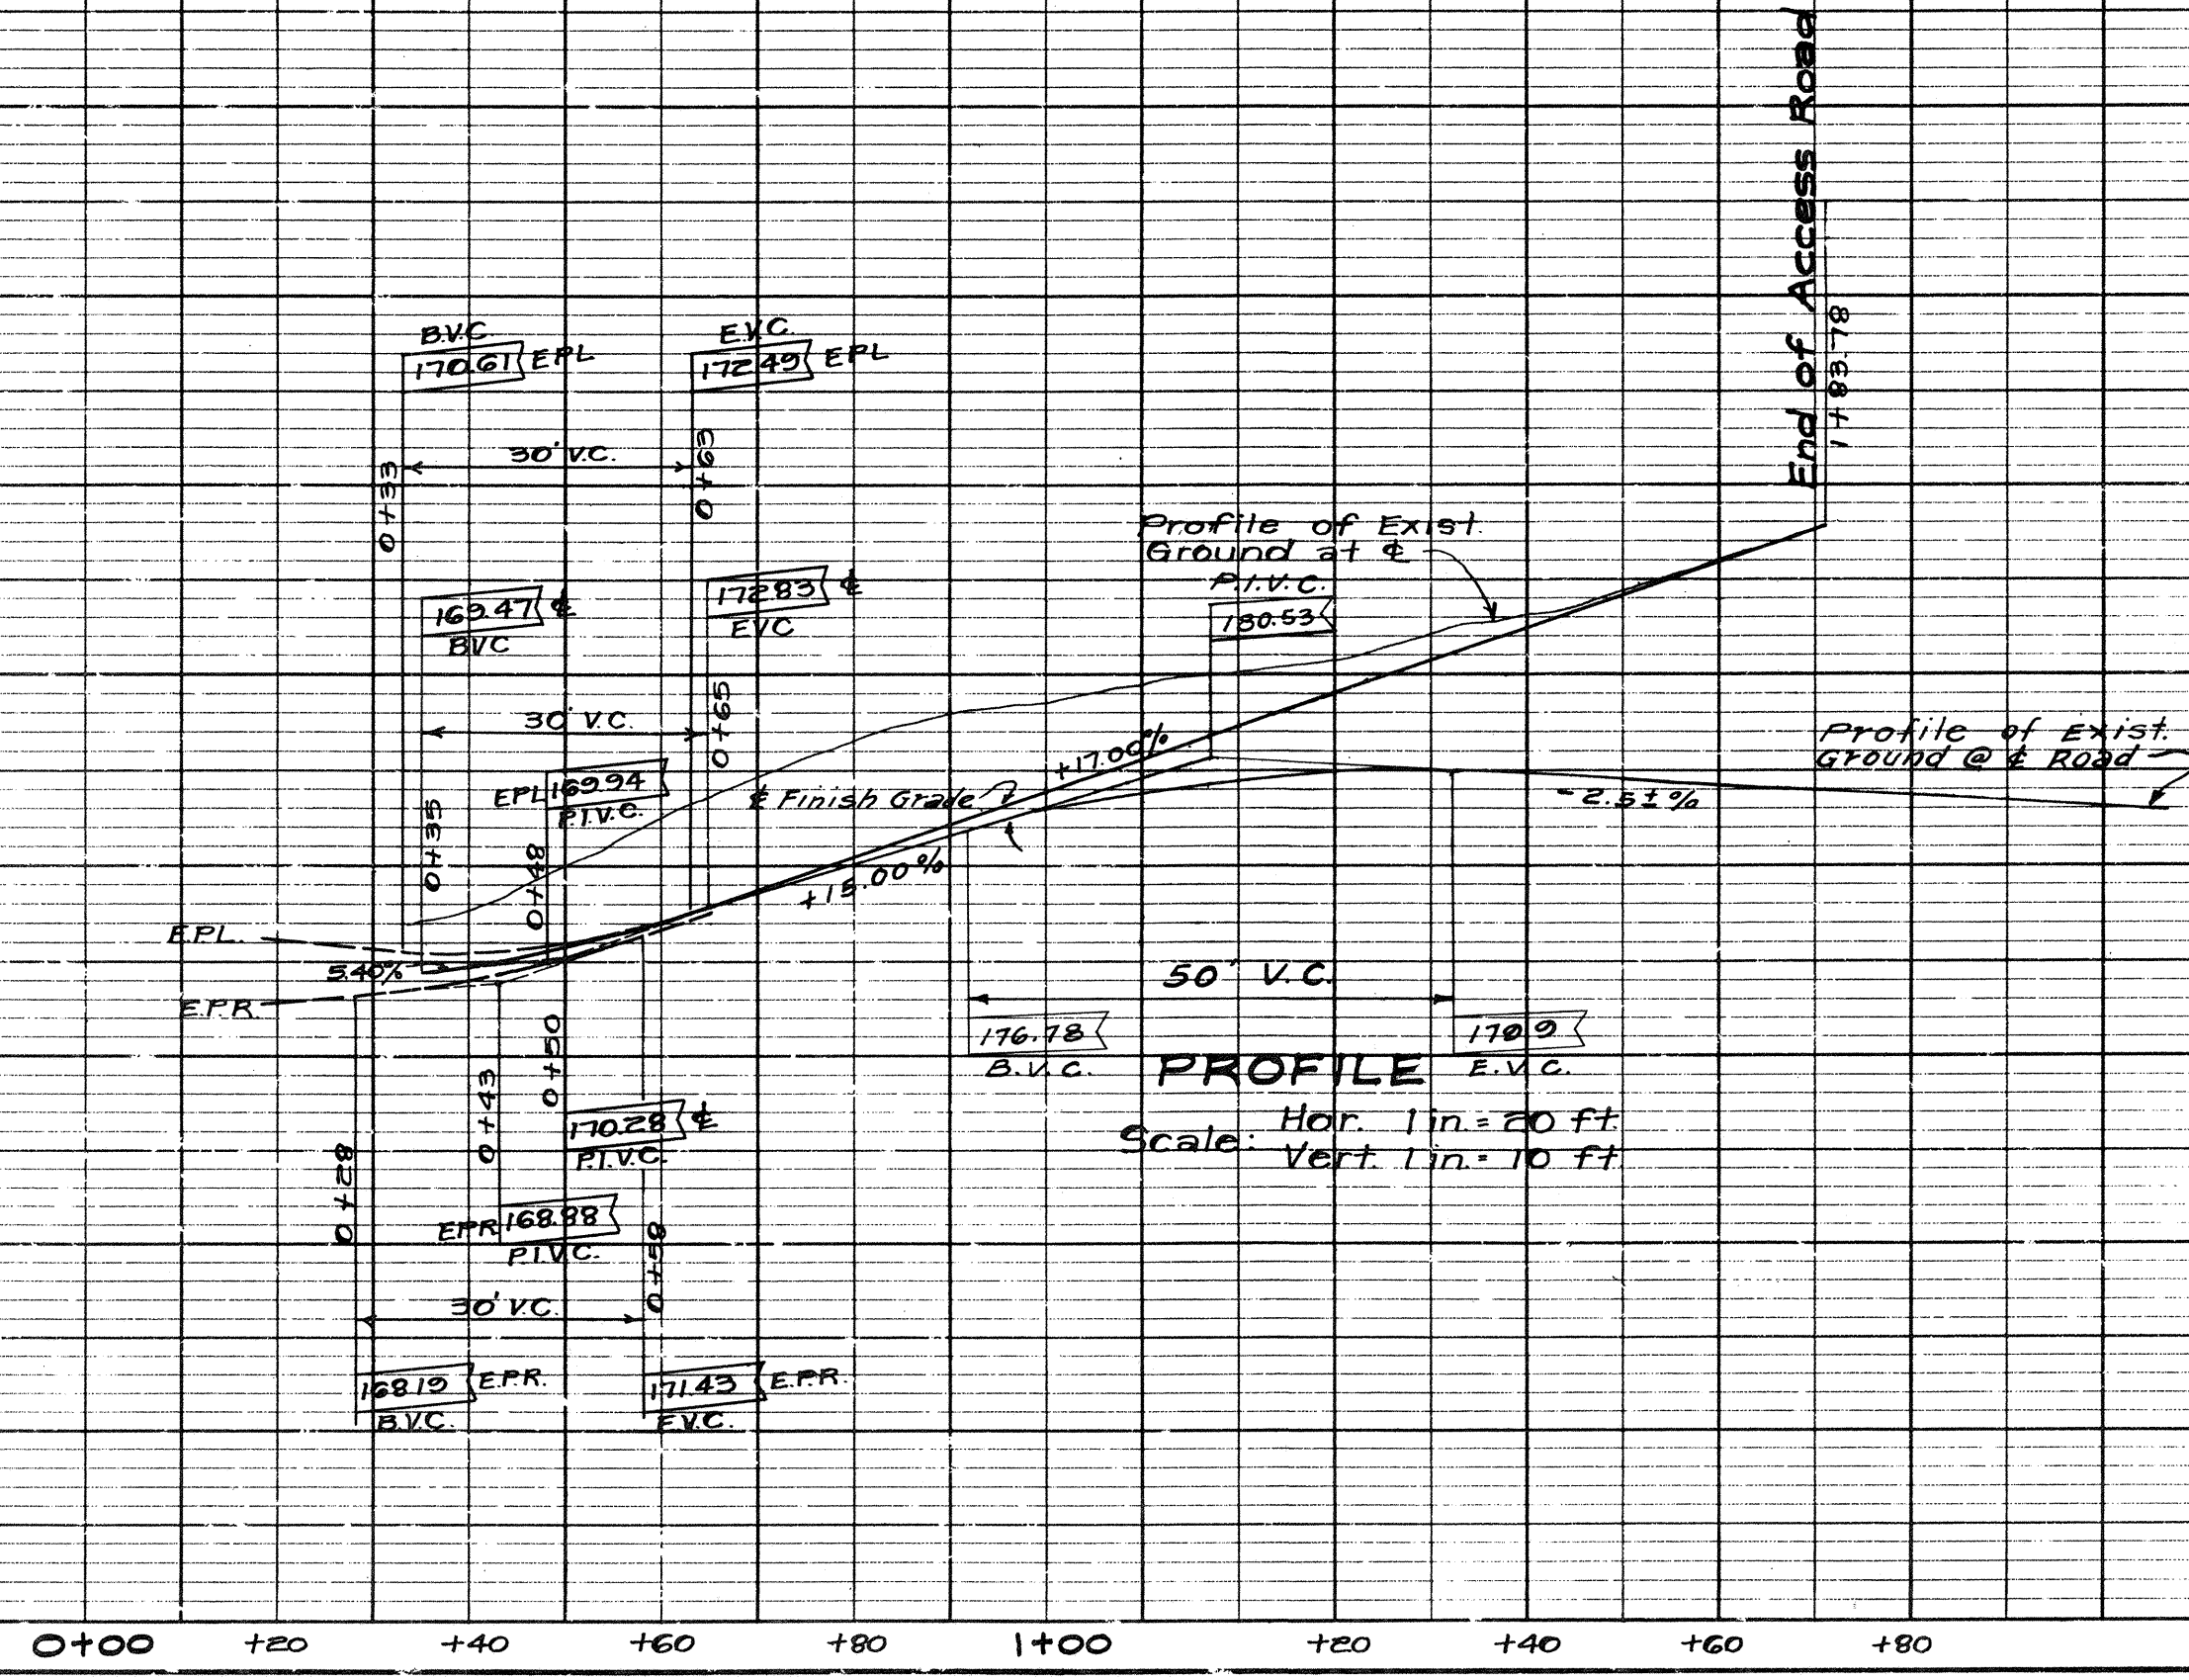

PROFILE
 Scale: Hor. 1 in. = 20 ft.
 Vert. 1 in. = 10 ft.




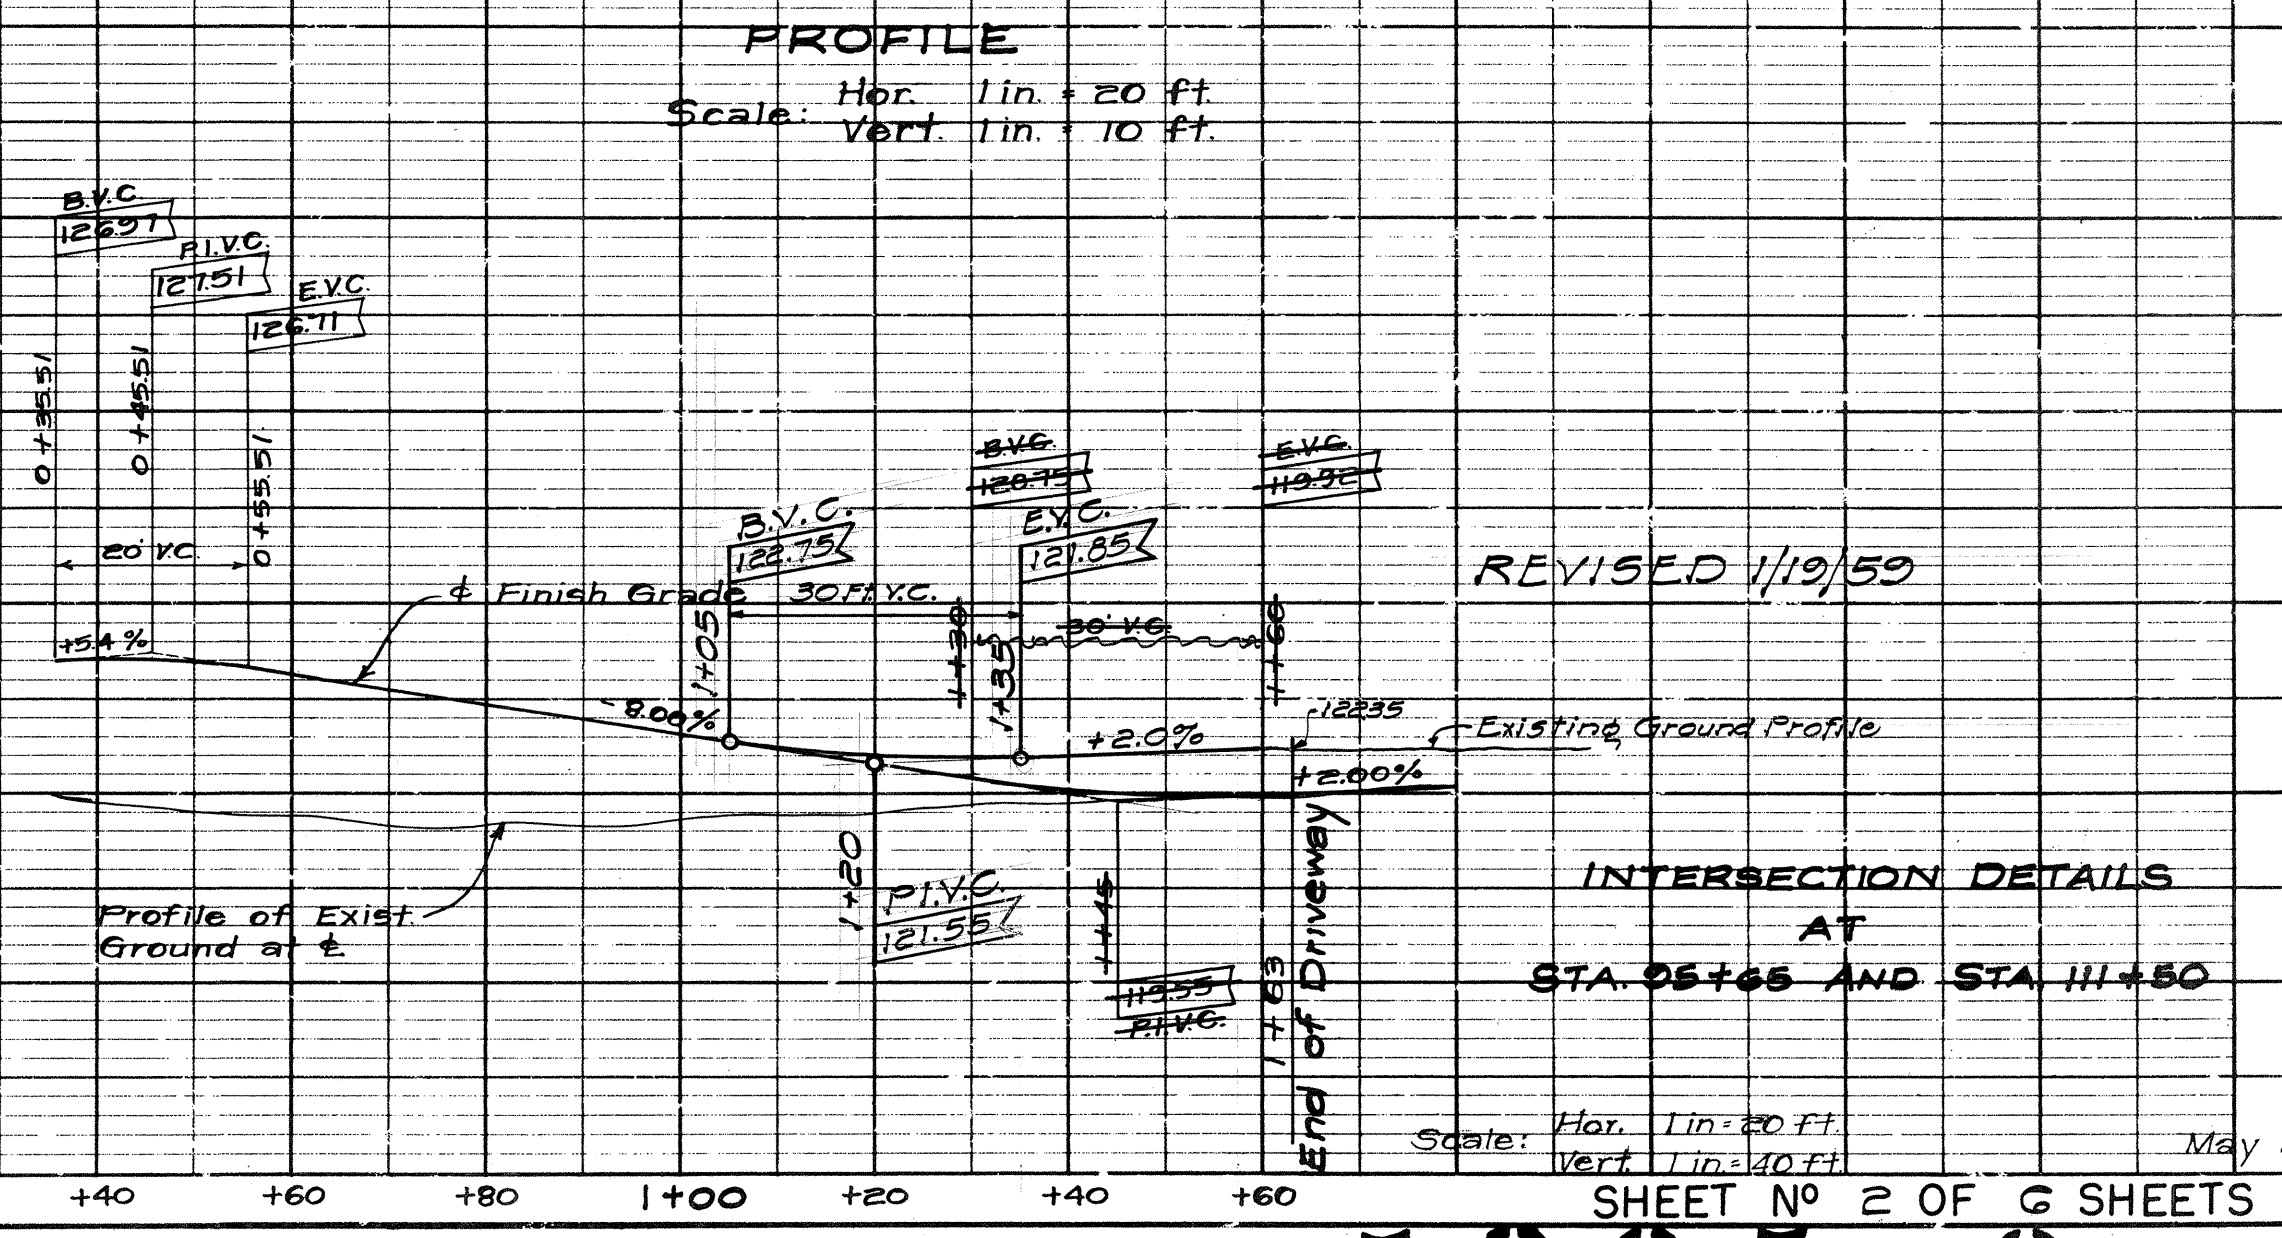


REVISED 1/19/59


INTERSECTION DETAILS
 AT
 STA. 95+65 AND STA. 111+50

Scale: Hor. 1 in. = 20 ft.
 Vert. 1 in. = 10 ft.

True North
Scale: 1" = 20 ft.

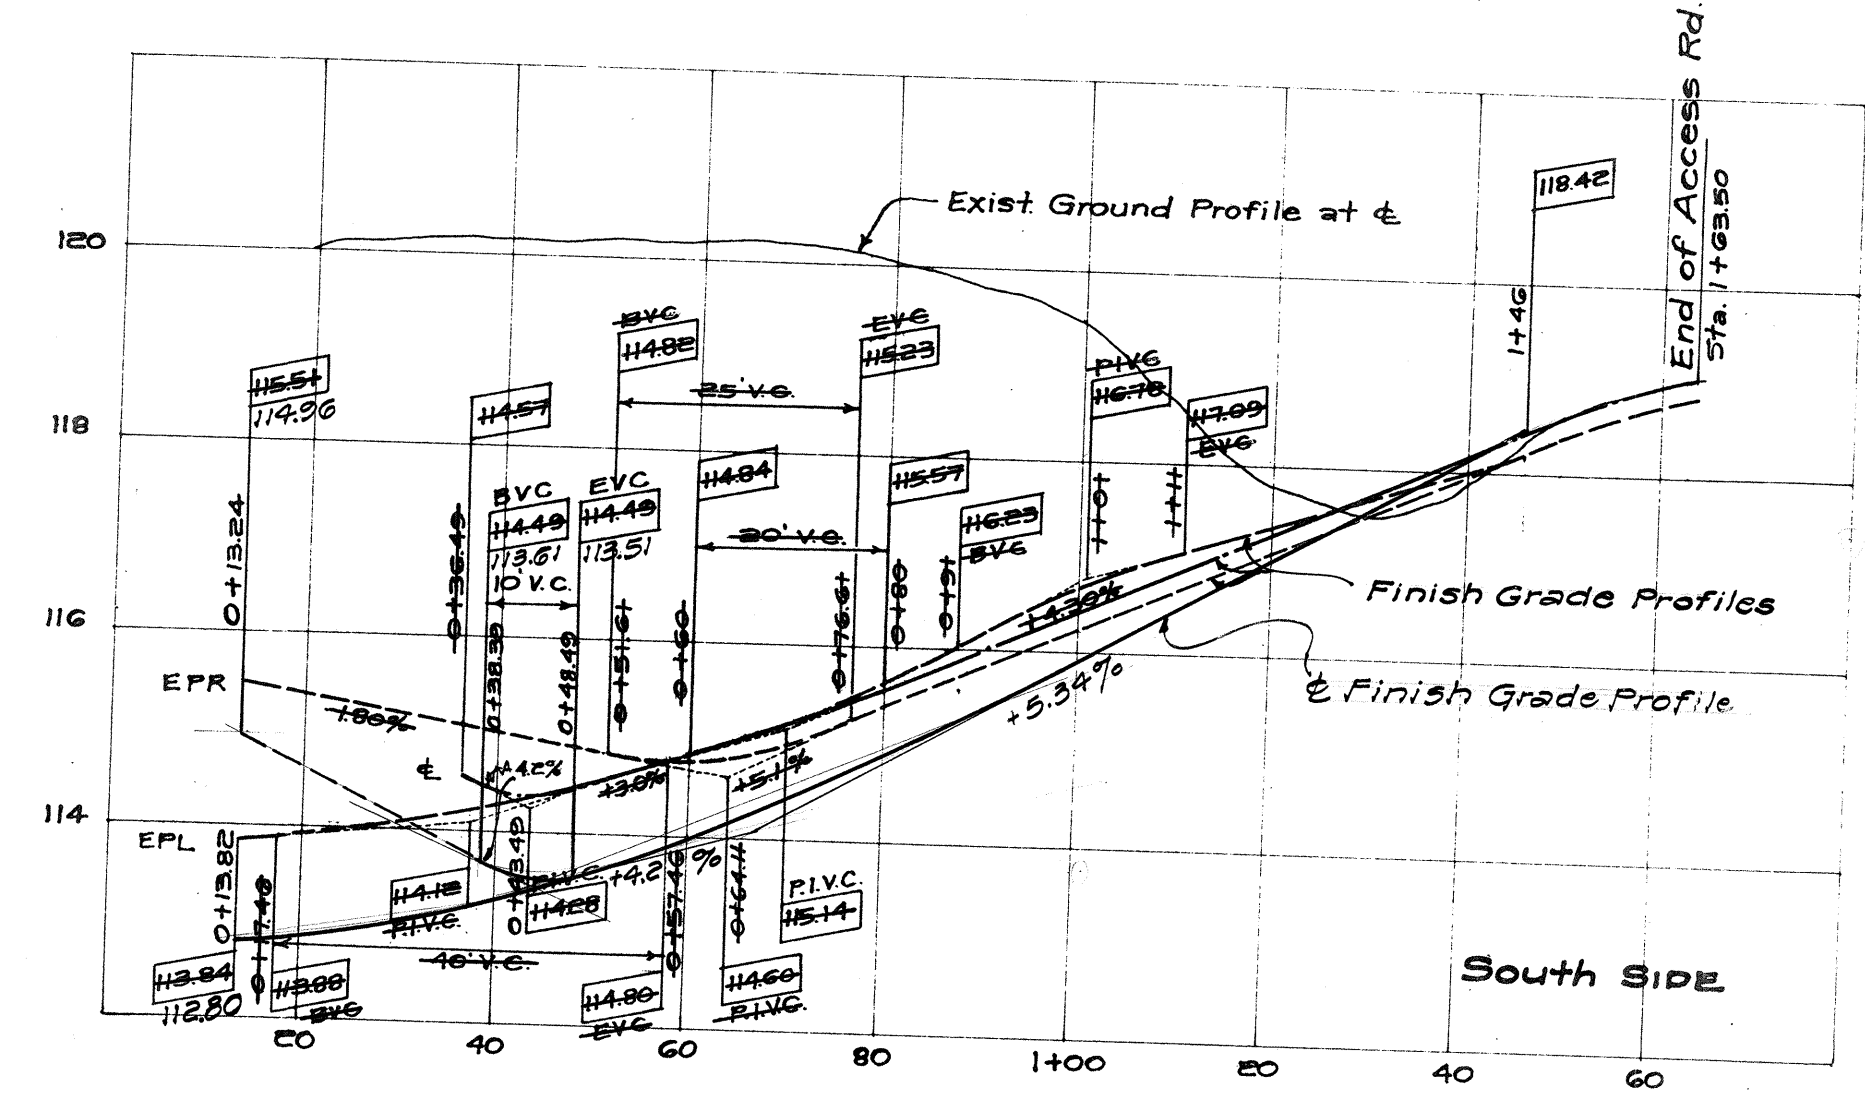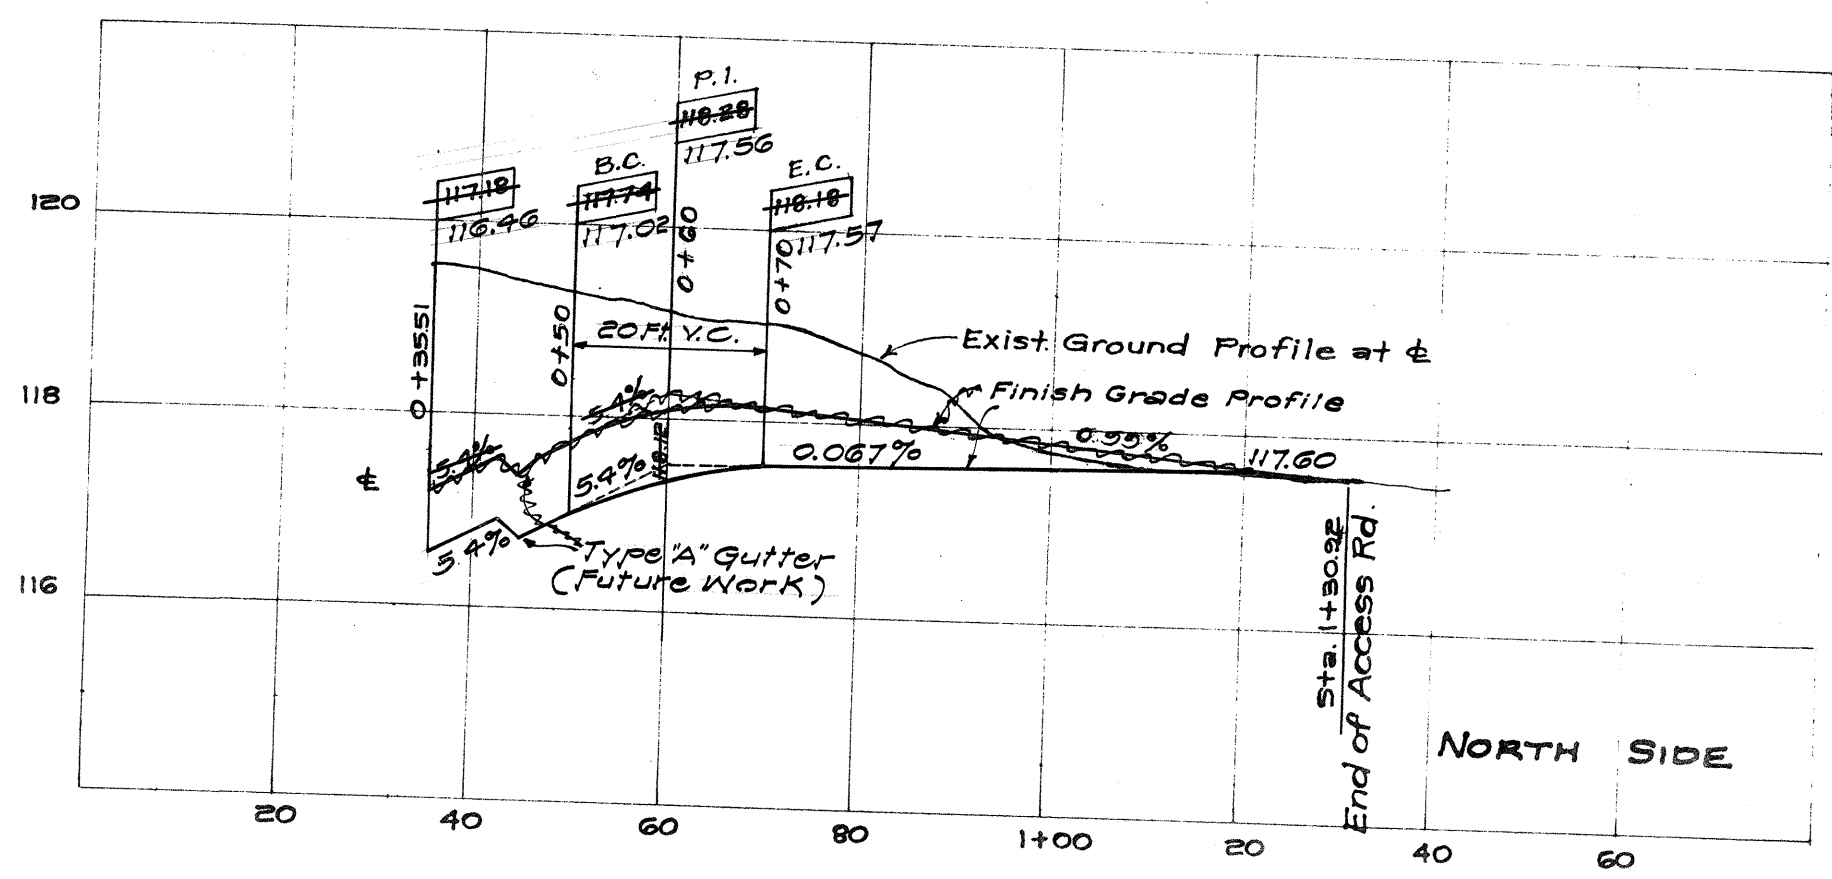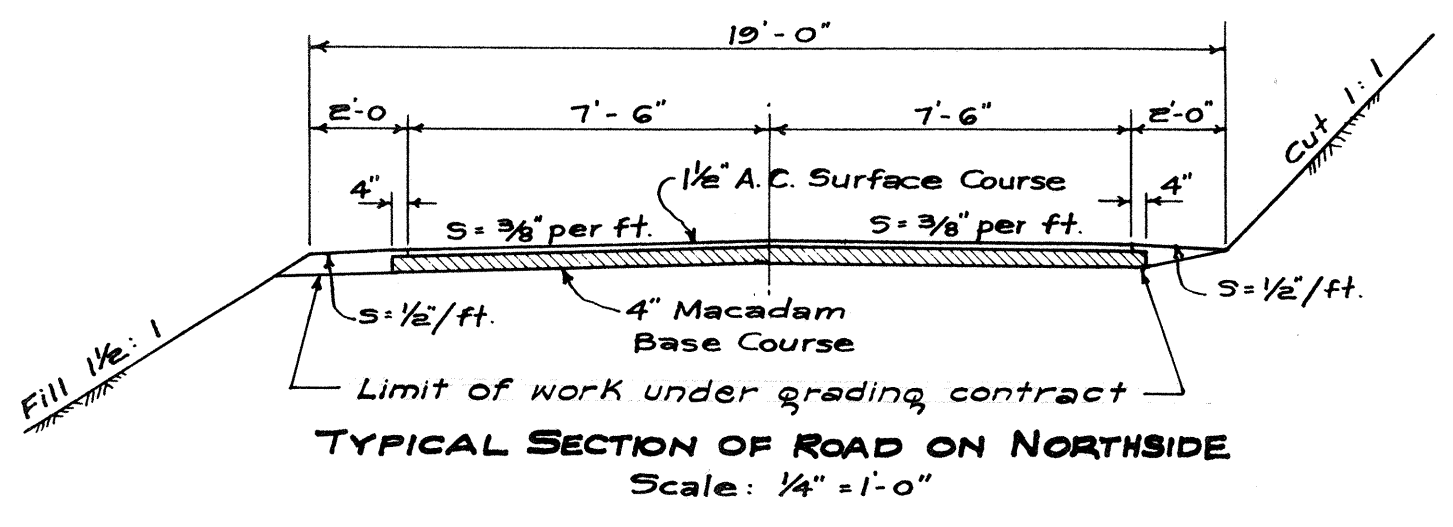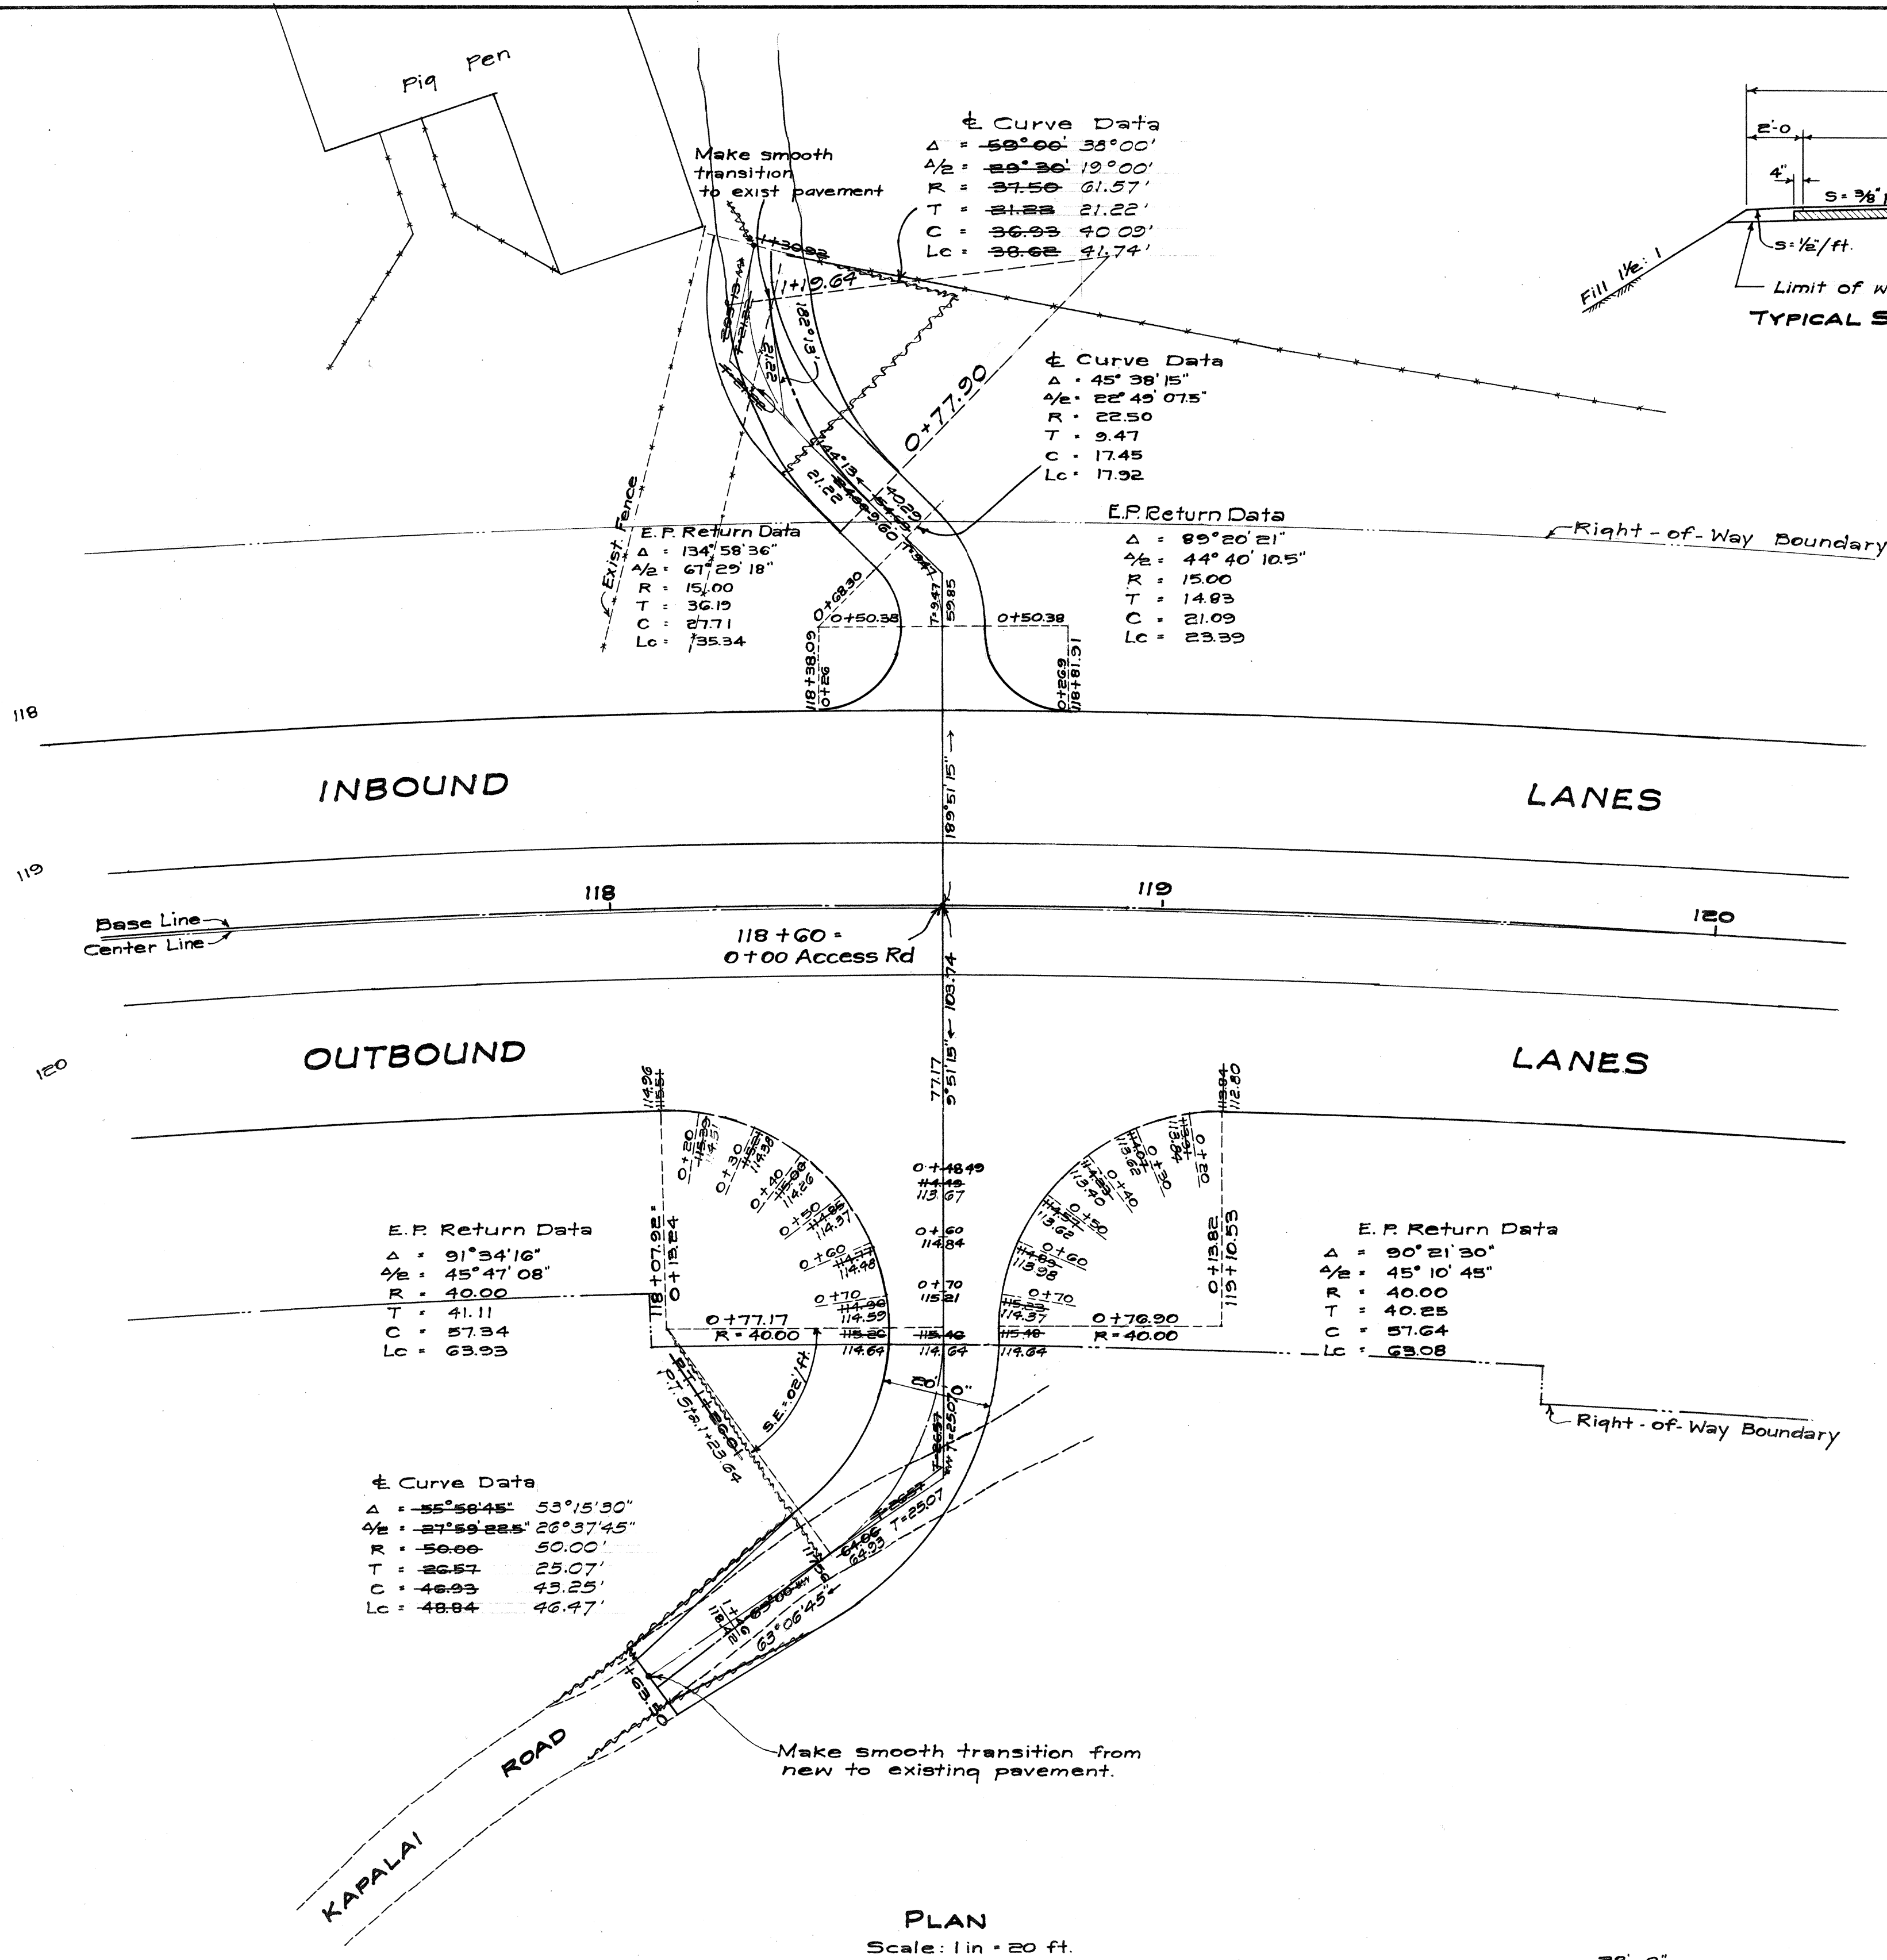

PROFILE DETAIL OF INTERSECTIONS
AT STA. 118+60
Hor. 1 in = 20 ft.
Ver. 1 in = 2 ft.

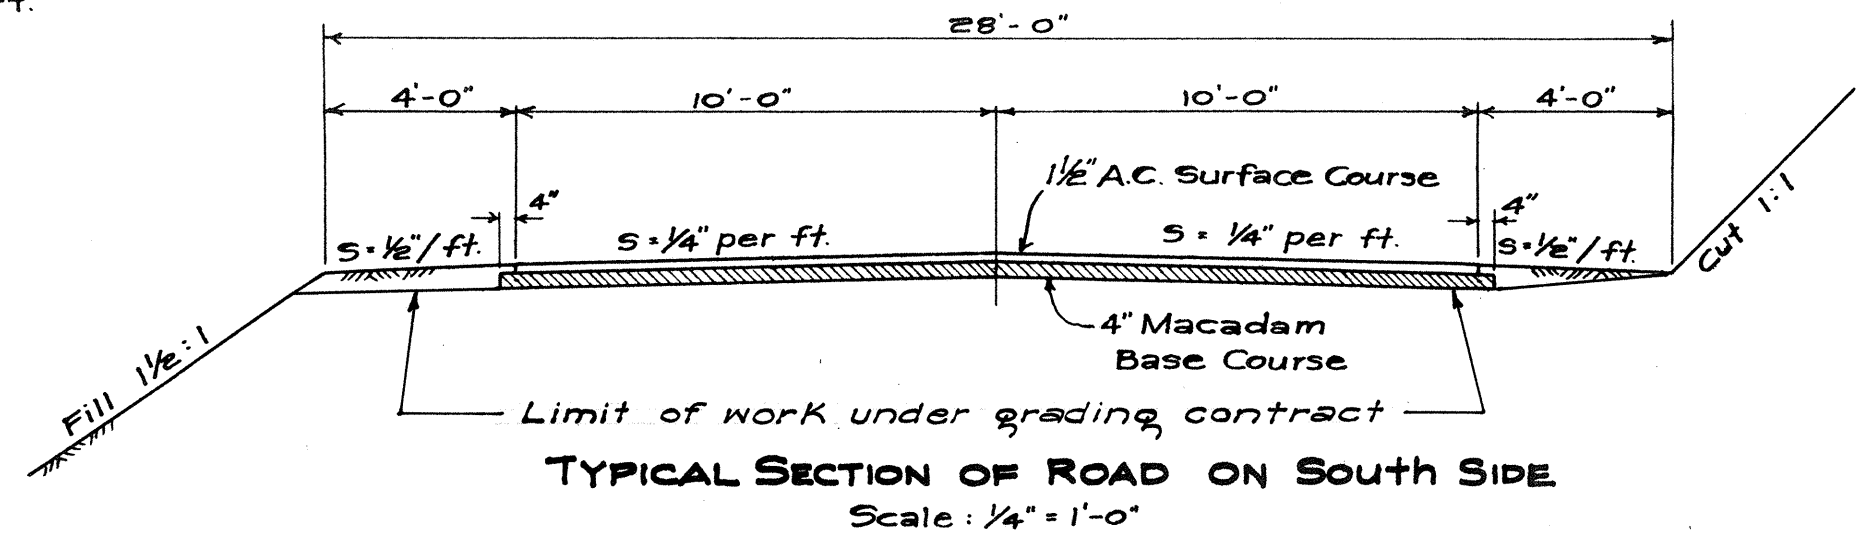

NOTE:
Base Course and A.C. Paving Work shall be done under a separate contract.

TERRITORIAL HIGHWAY DEPARTMENT
TERRITORY OF HAWAII









INTERSECTION DETAIL
AT
STA. 118+60

LIKELIKE HIGHWAY
F.A.S.R. No. 5-0630(S)

Scale: As Noted May 1957

SURVEY PLOTTED BY: DATE: _____
 DESIGNED BY: _____
 DRAWN BY: _____
 CHECKED BY: _____
 NOTE BOOK NO. _____

FED. ROAD DIST. NO.	STATE	FED. AID PROJ. NO.	FISCAL YEAR	SHEET NO.	TOTAL SHEETS
HAWAII	HAW.	5-0630(5)	1988	11	33

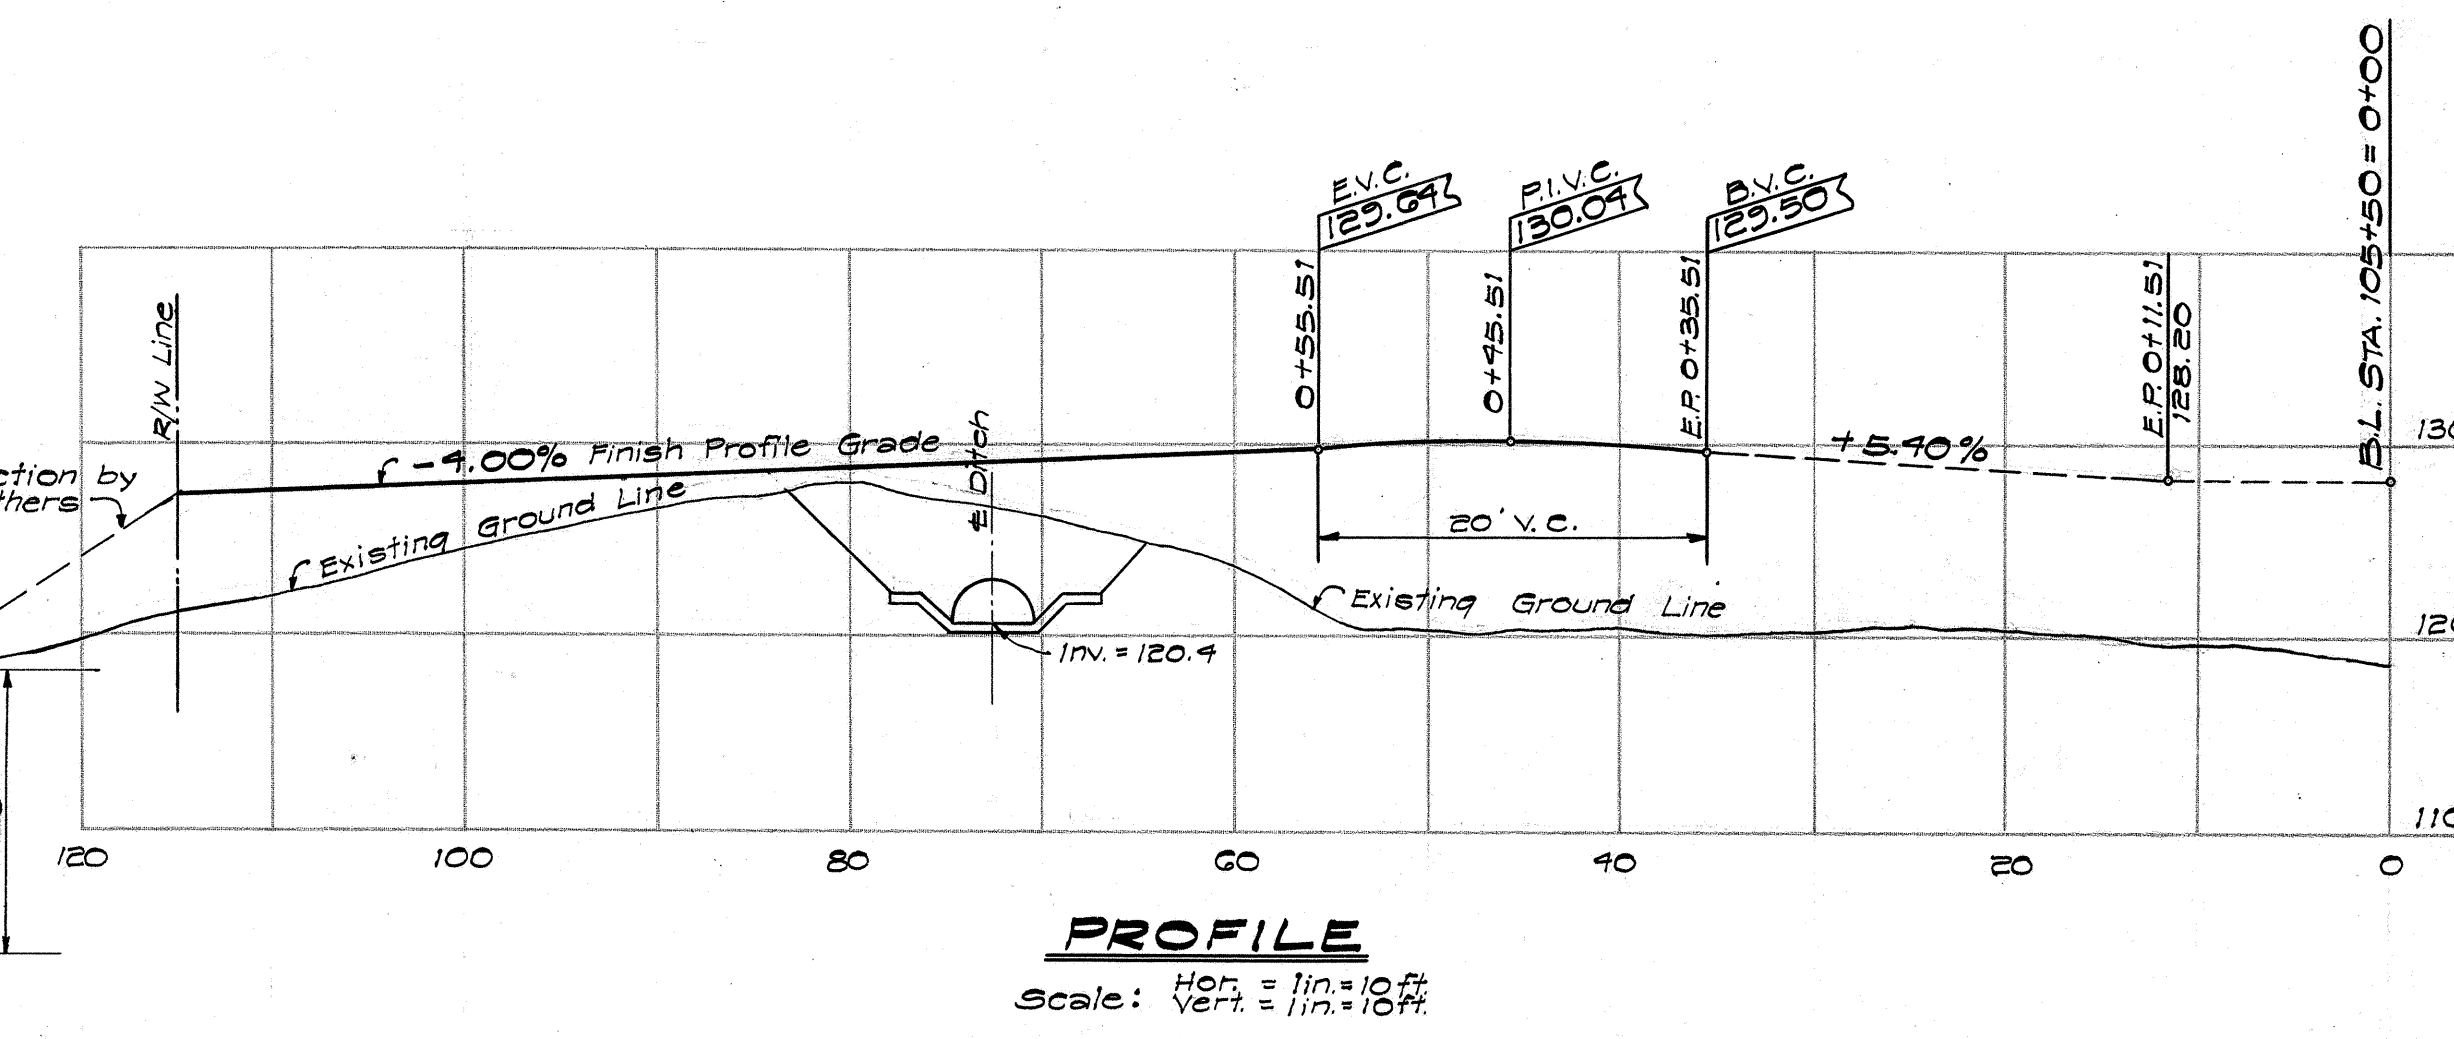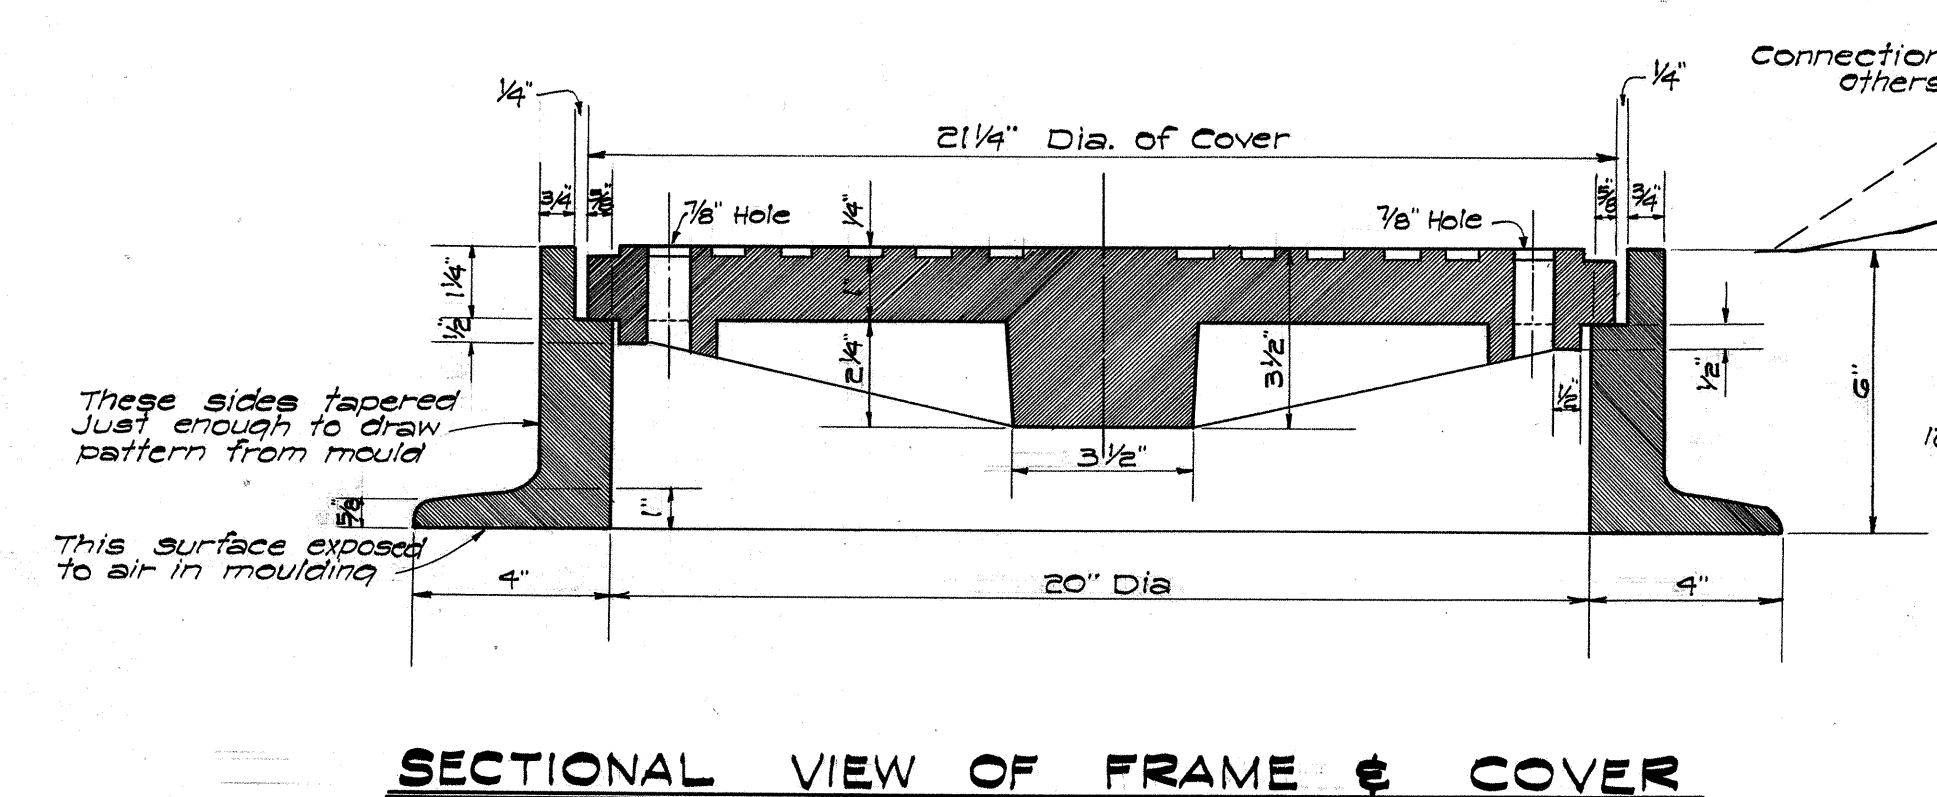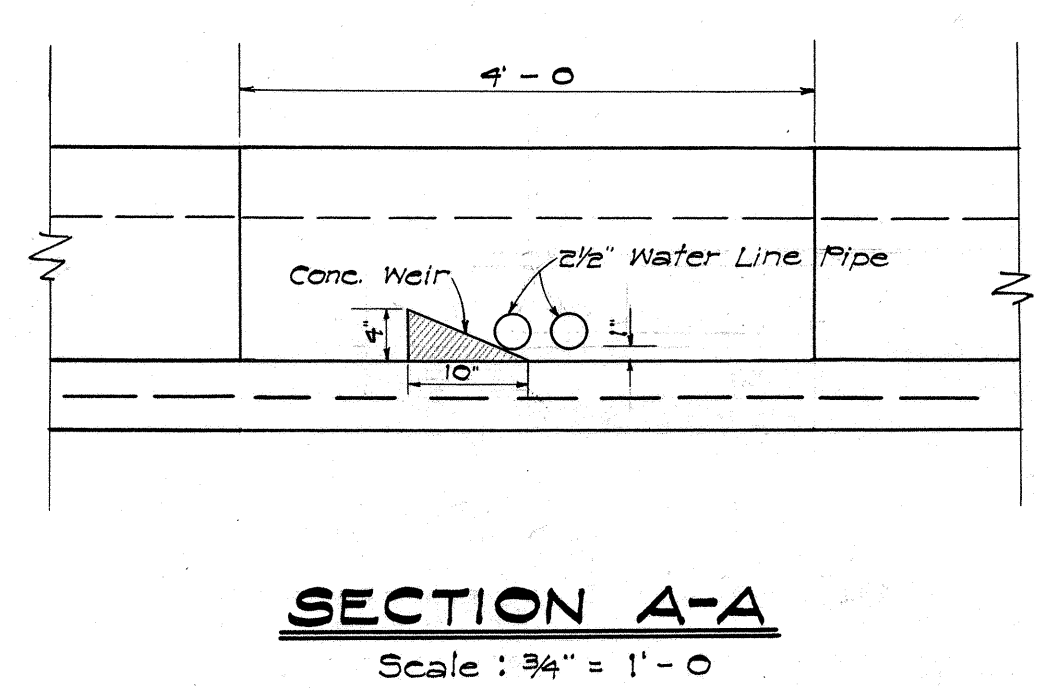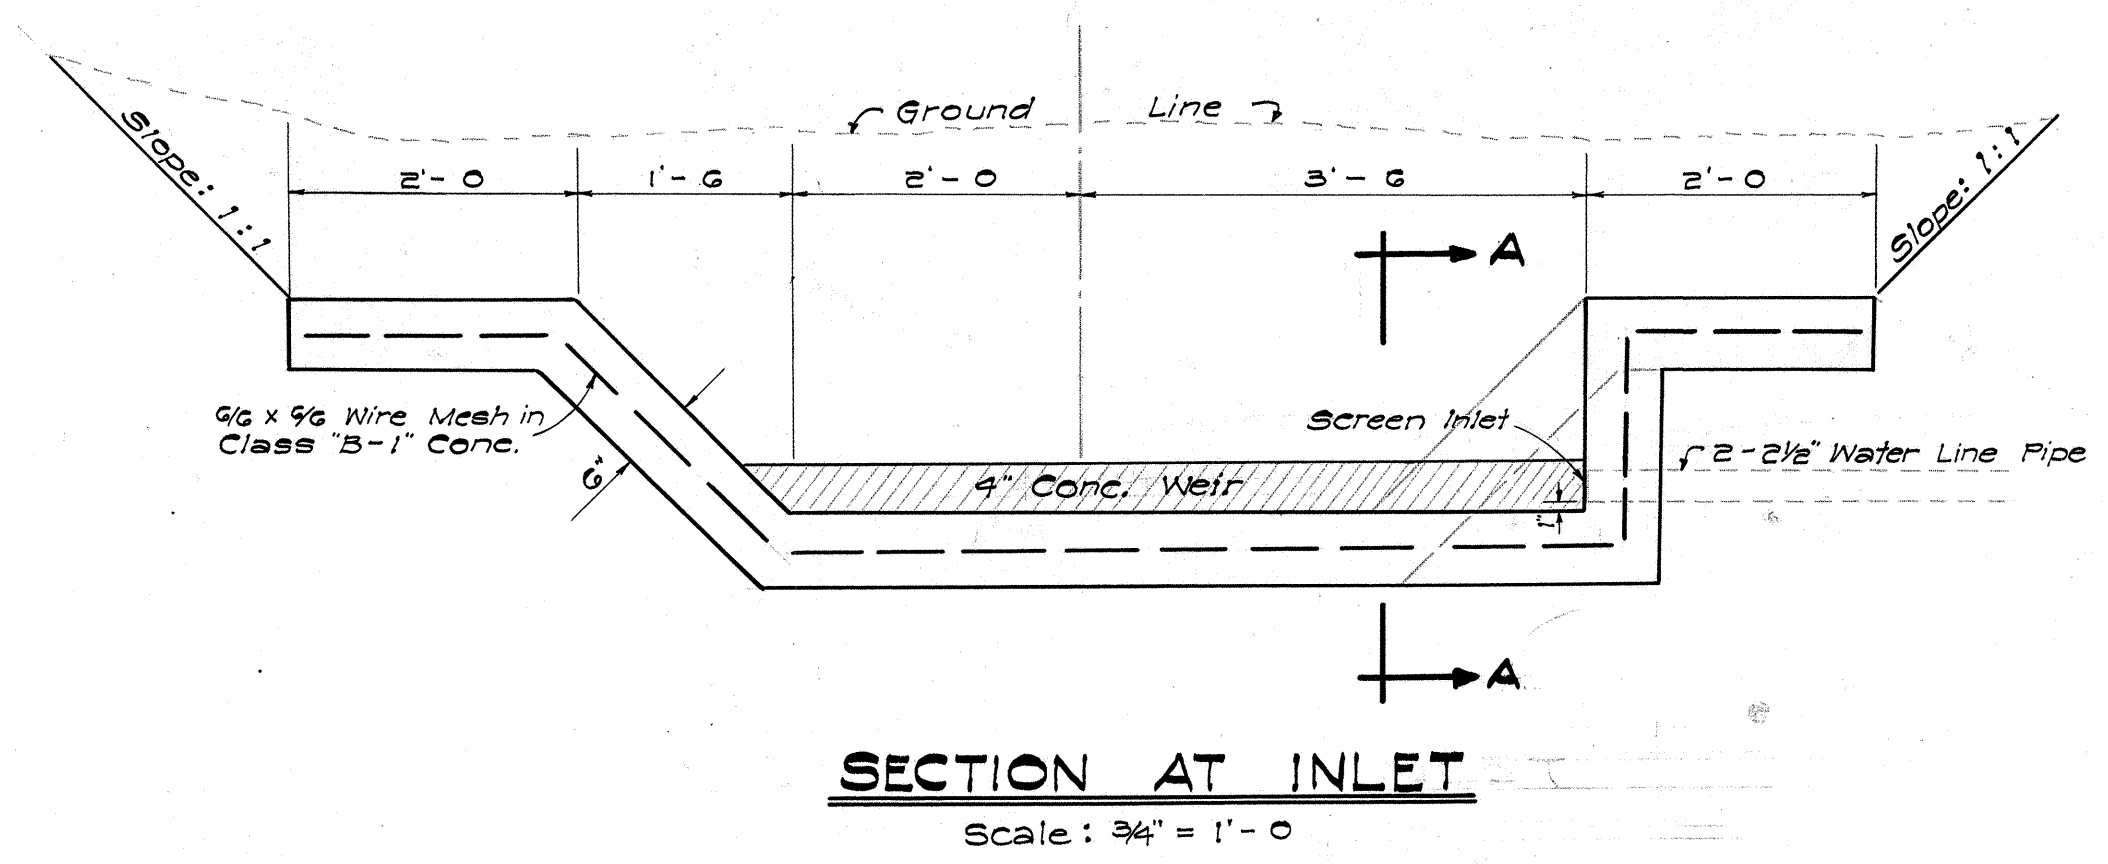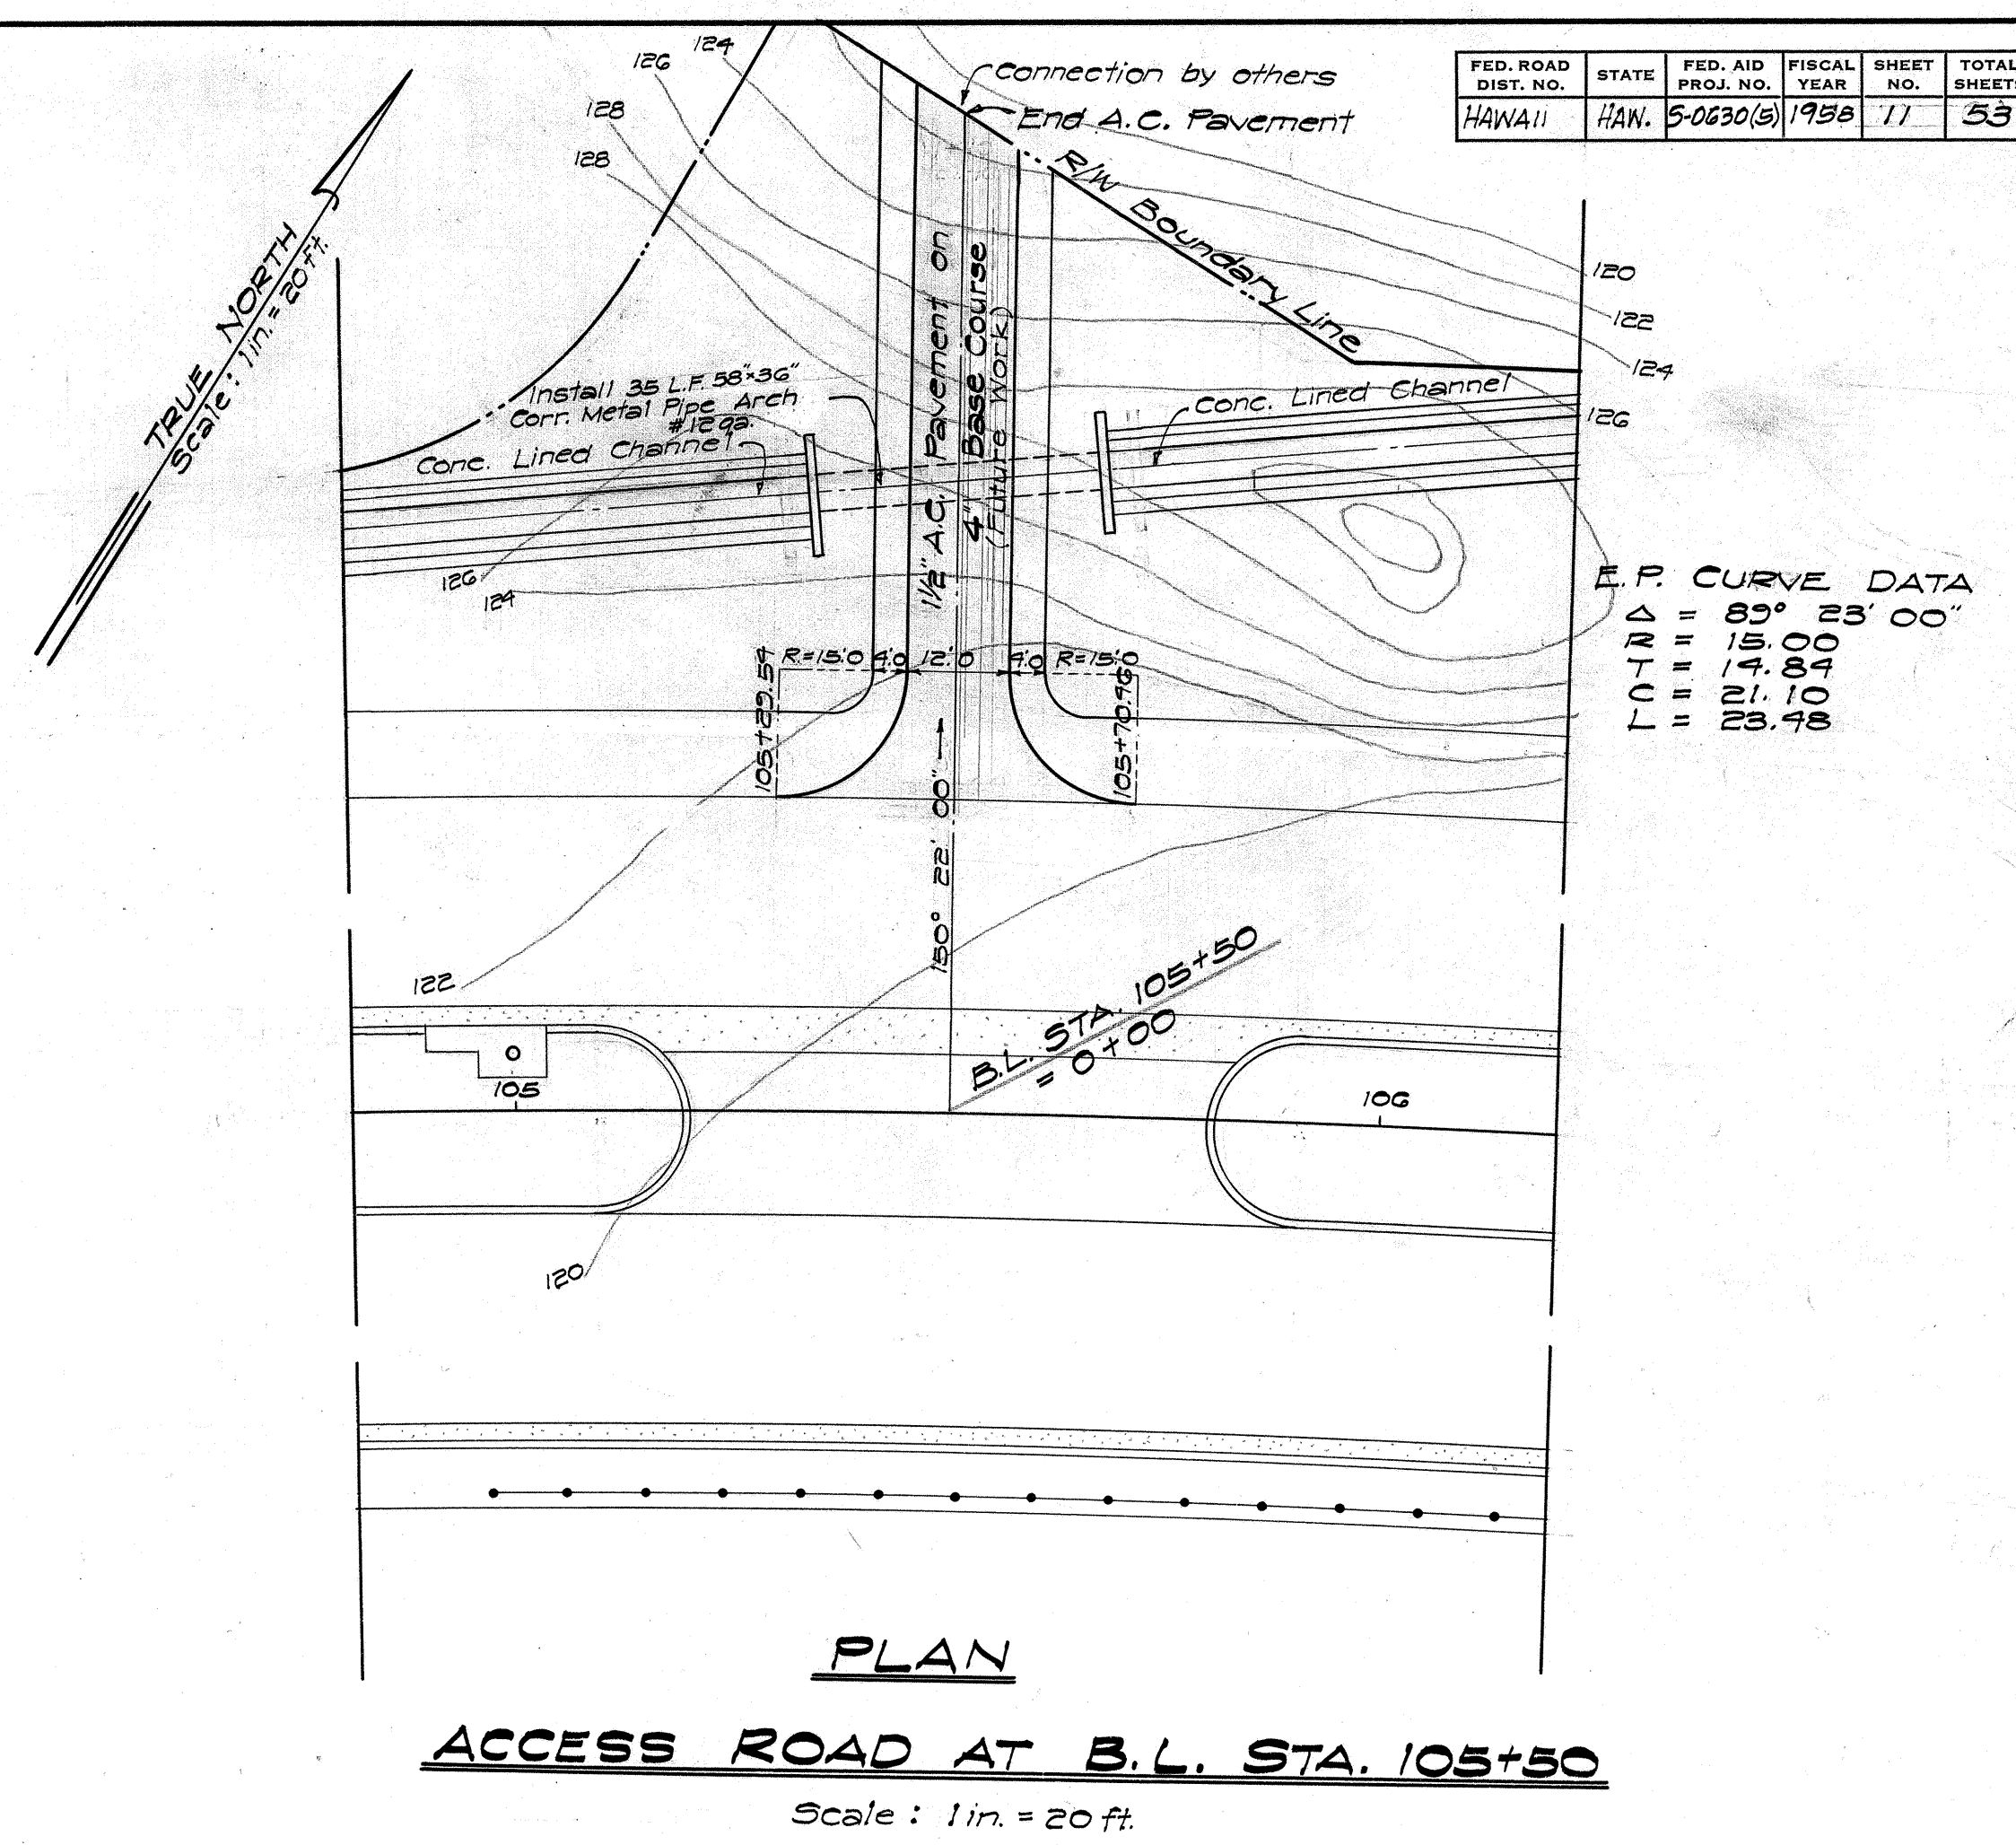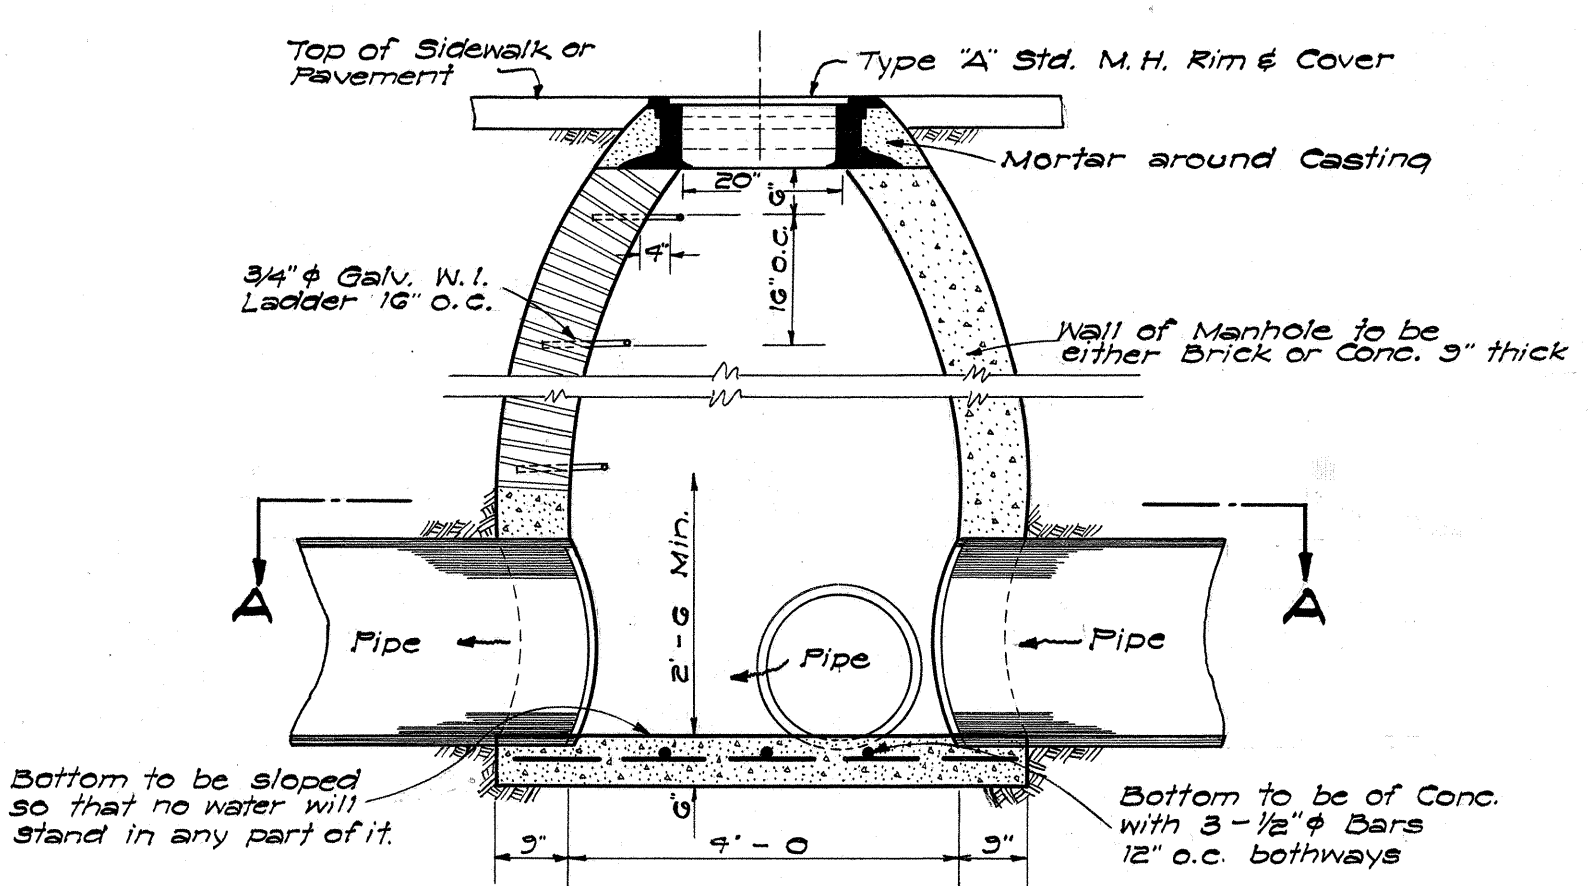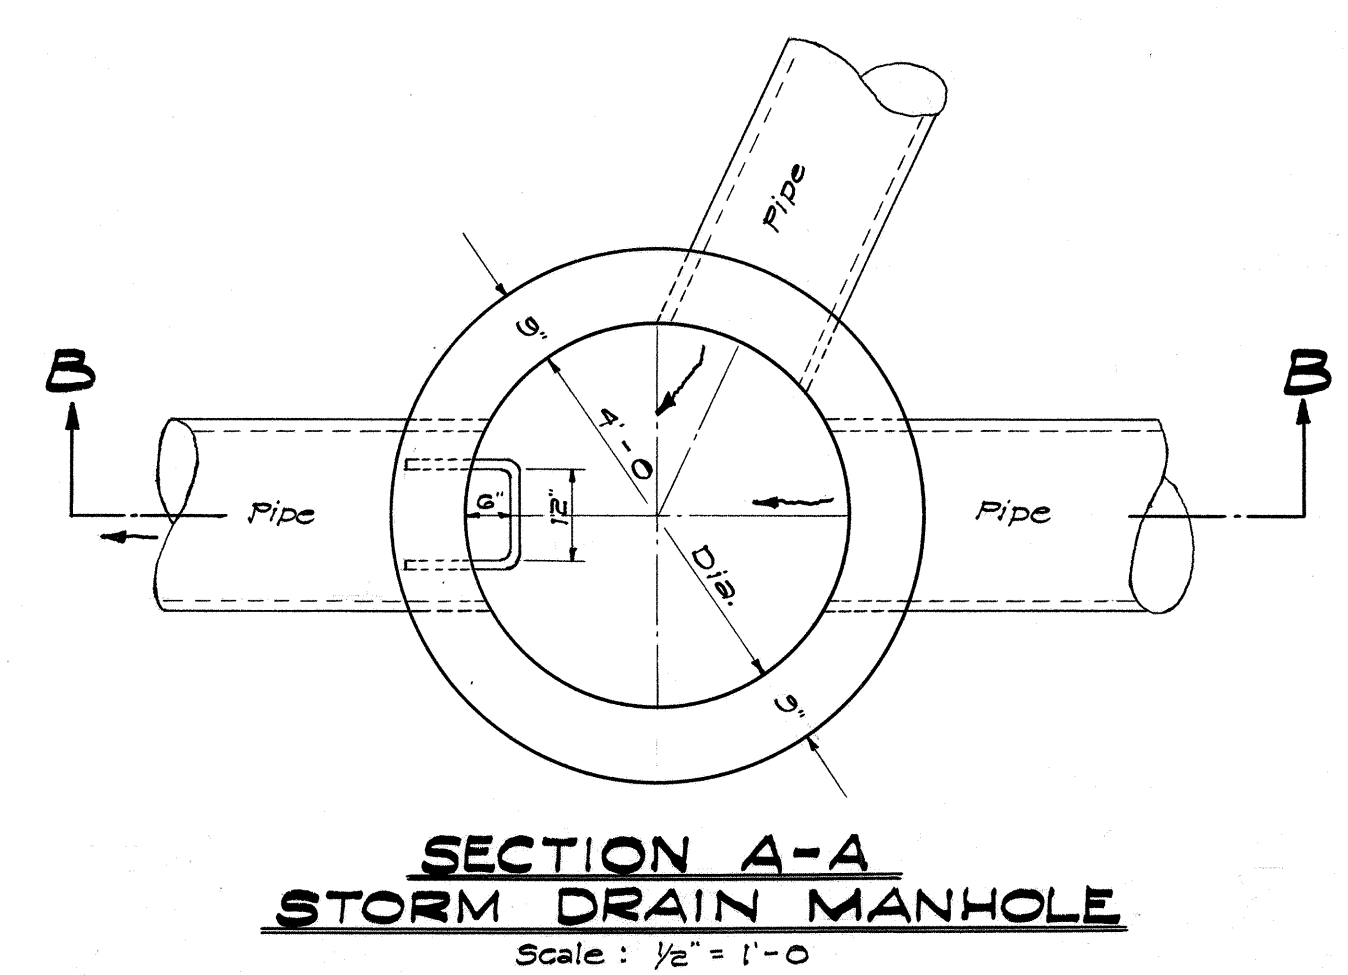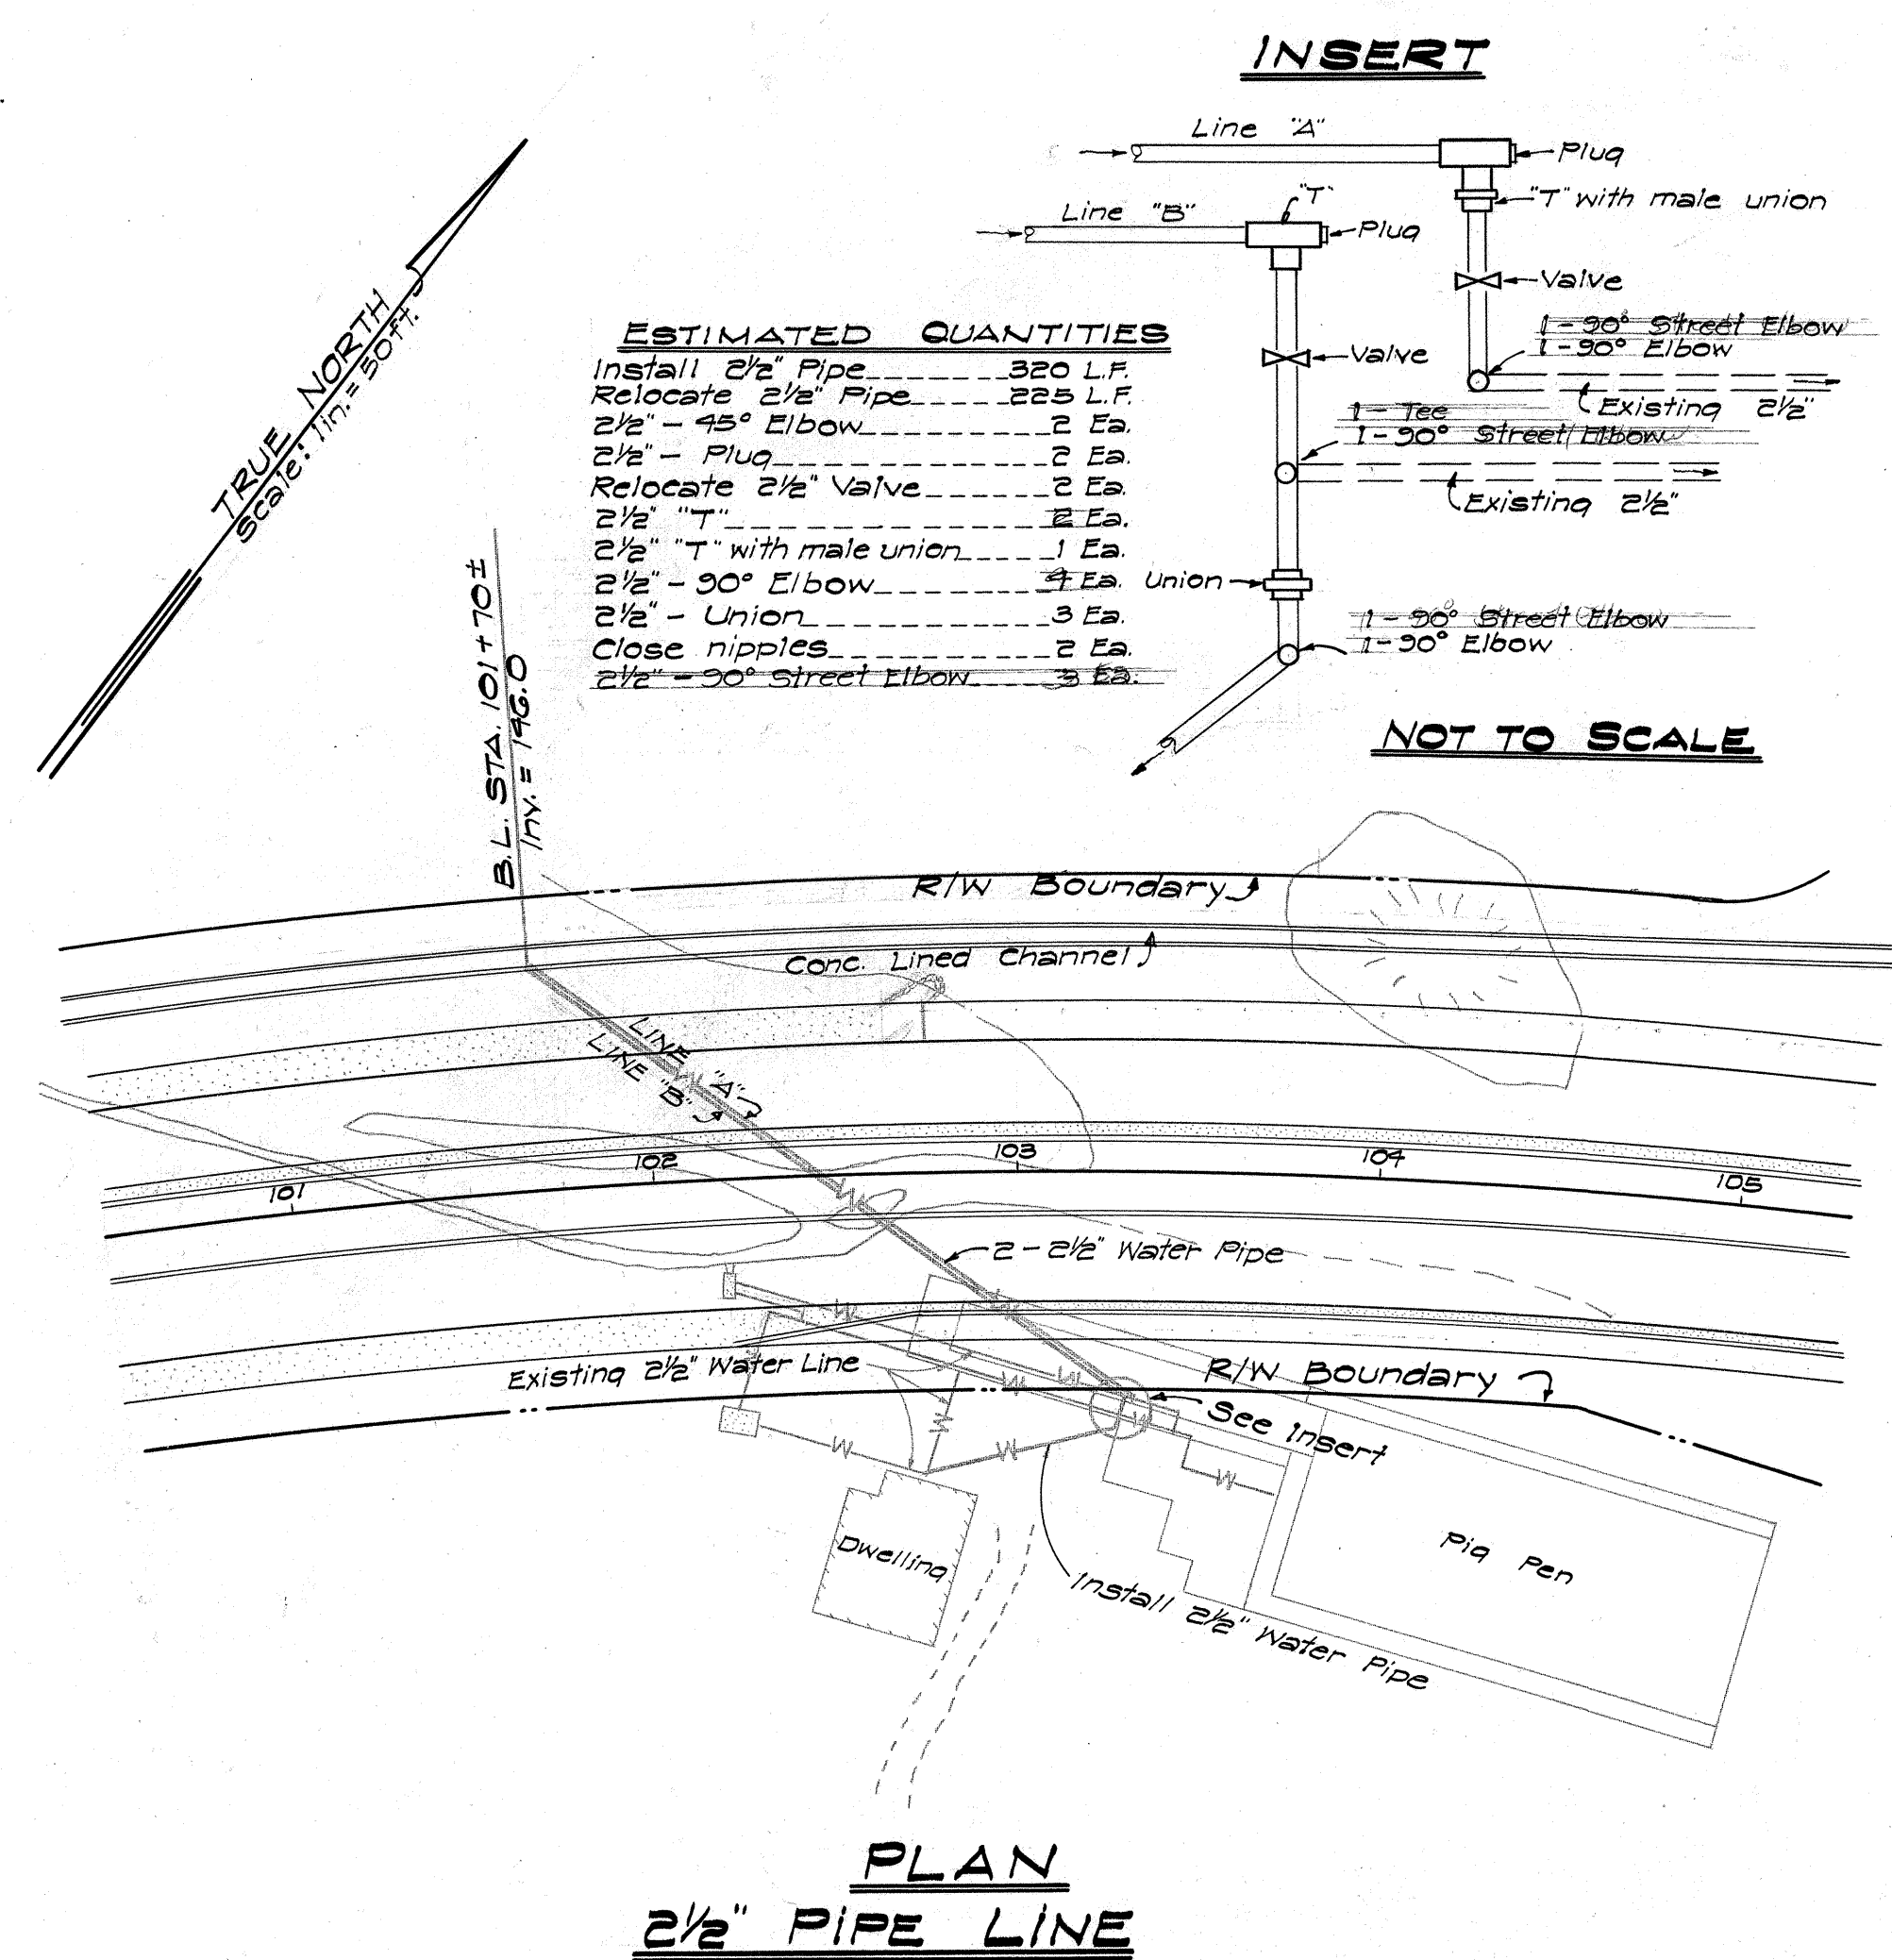

TERRITORIAL HIGHWAY DEPARTMENT
TERRITORY OF HAWAII

STORM DRAIN MANHOLE DETAIL
PLAN & DETAILS OF 2 1/2" WATER LINE
INTERSECTION DETAIL - B.L. STA. 105+50

LIKELIKE HIGHWAY
FED. AID SECONDARY PROJ. NO. 5-0630 (5)
SCALE: AS NOTED
MAY 1987

SHEET NO. 6 OF 6 SHEETS

5905.11

SURVEY PLOTTED BY	DATE
PLAN	
TRACED BY	
NOTE BOOK	
QUANTITIES BY	
CHECKED BY	
No.	