

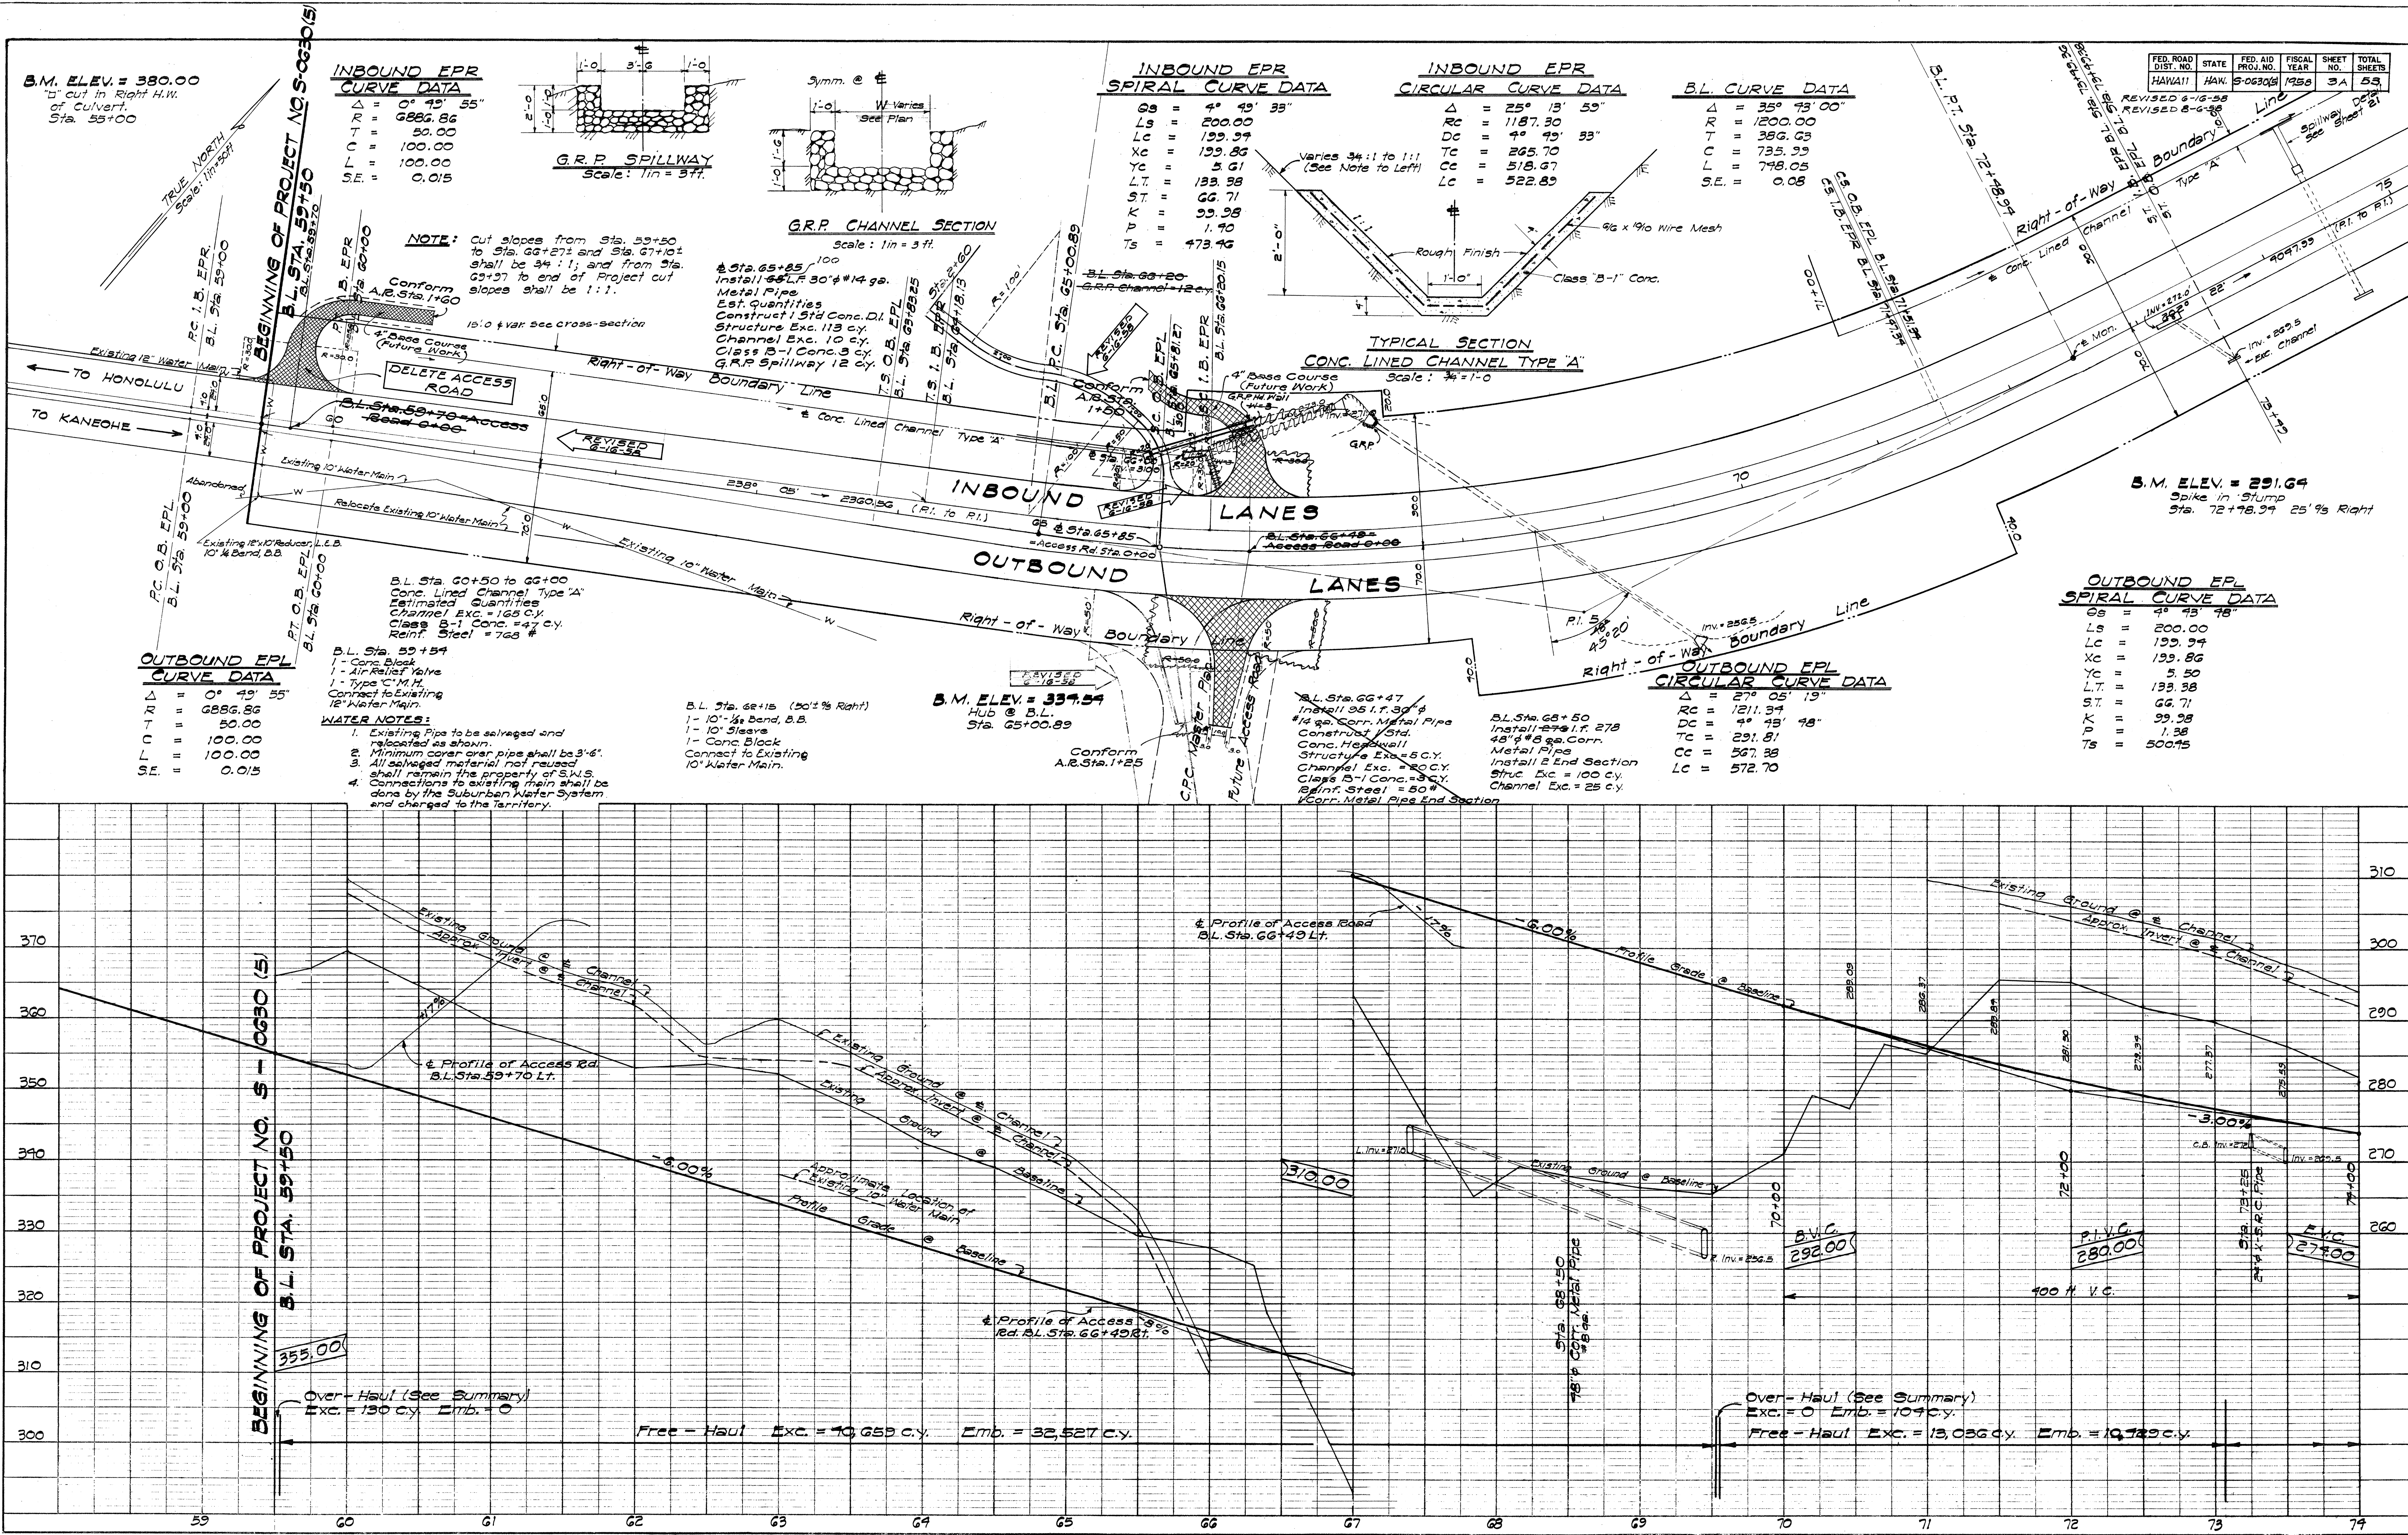


PROFILE	SURVEYED	BY	DATE
	PLOTTED		
NOTE BOOK	GRADES CHECKED		
NO.	B. M.'S NOTED		
	STRUCTURE NOTATIONS CH. NO.		


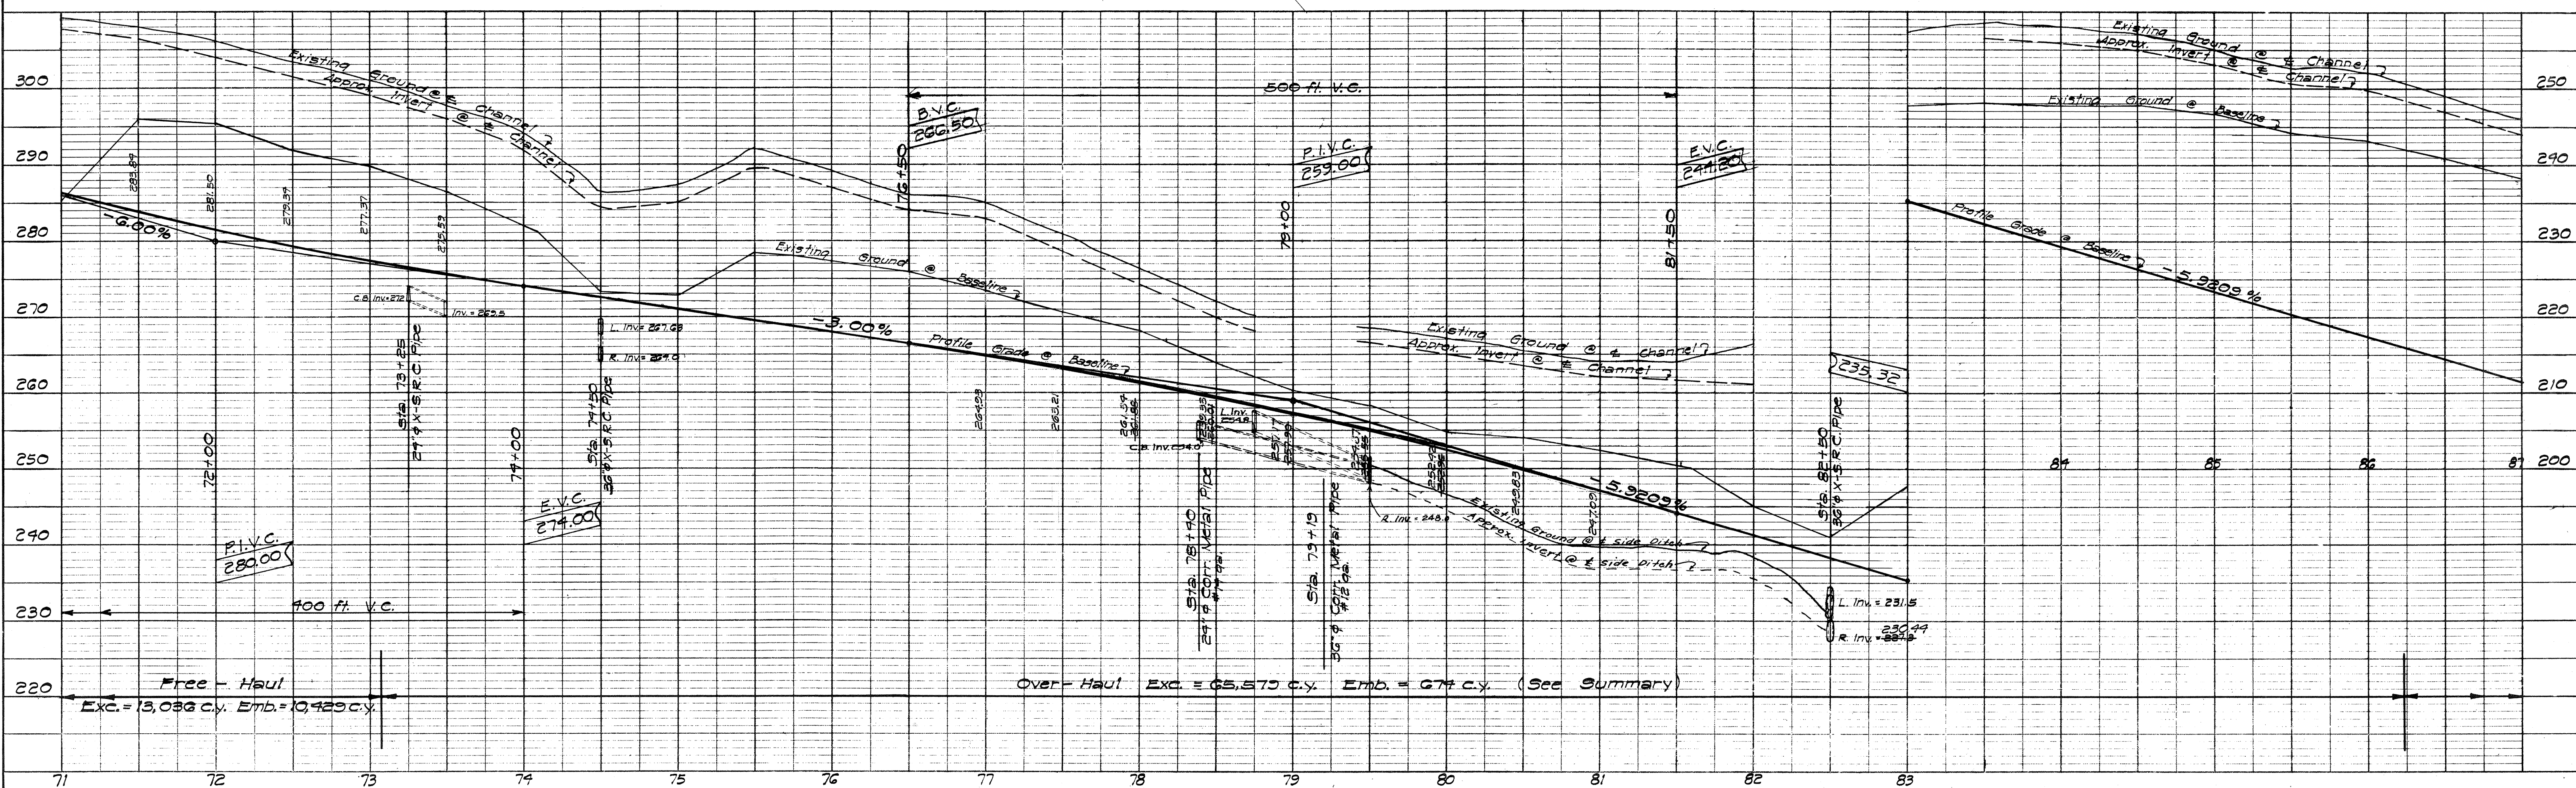


B.M. ELEV. = 245.11
Spike in Plum Tree
Sta. 86+33

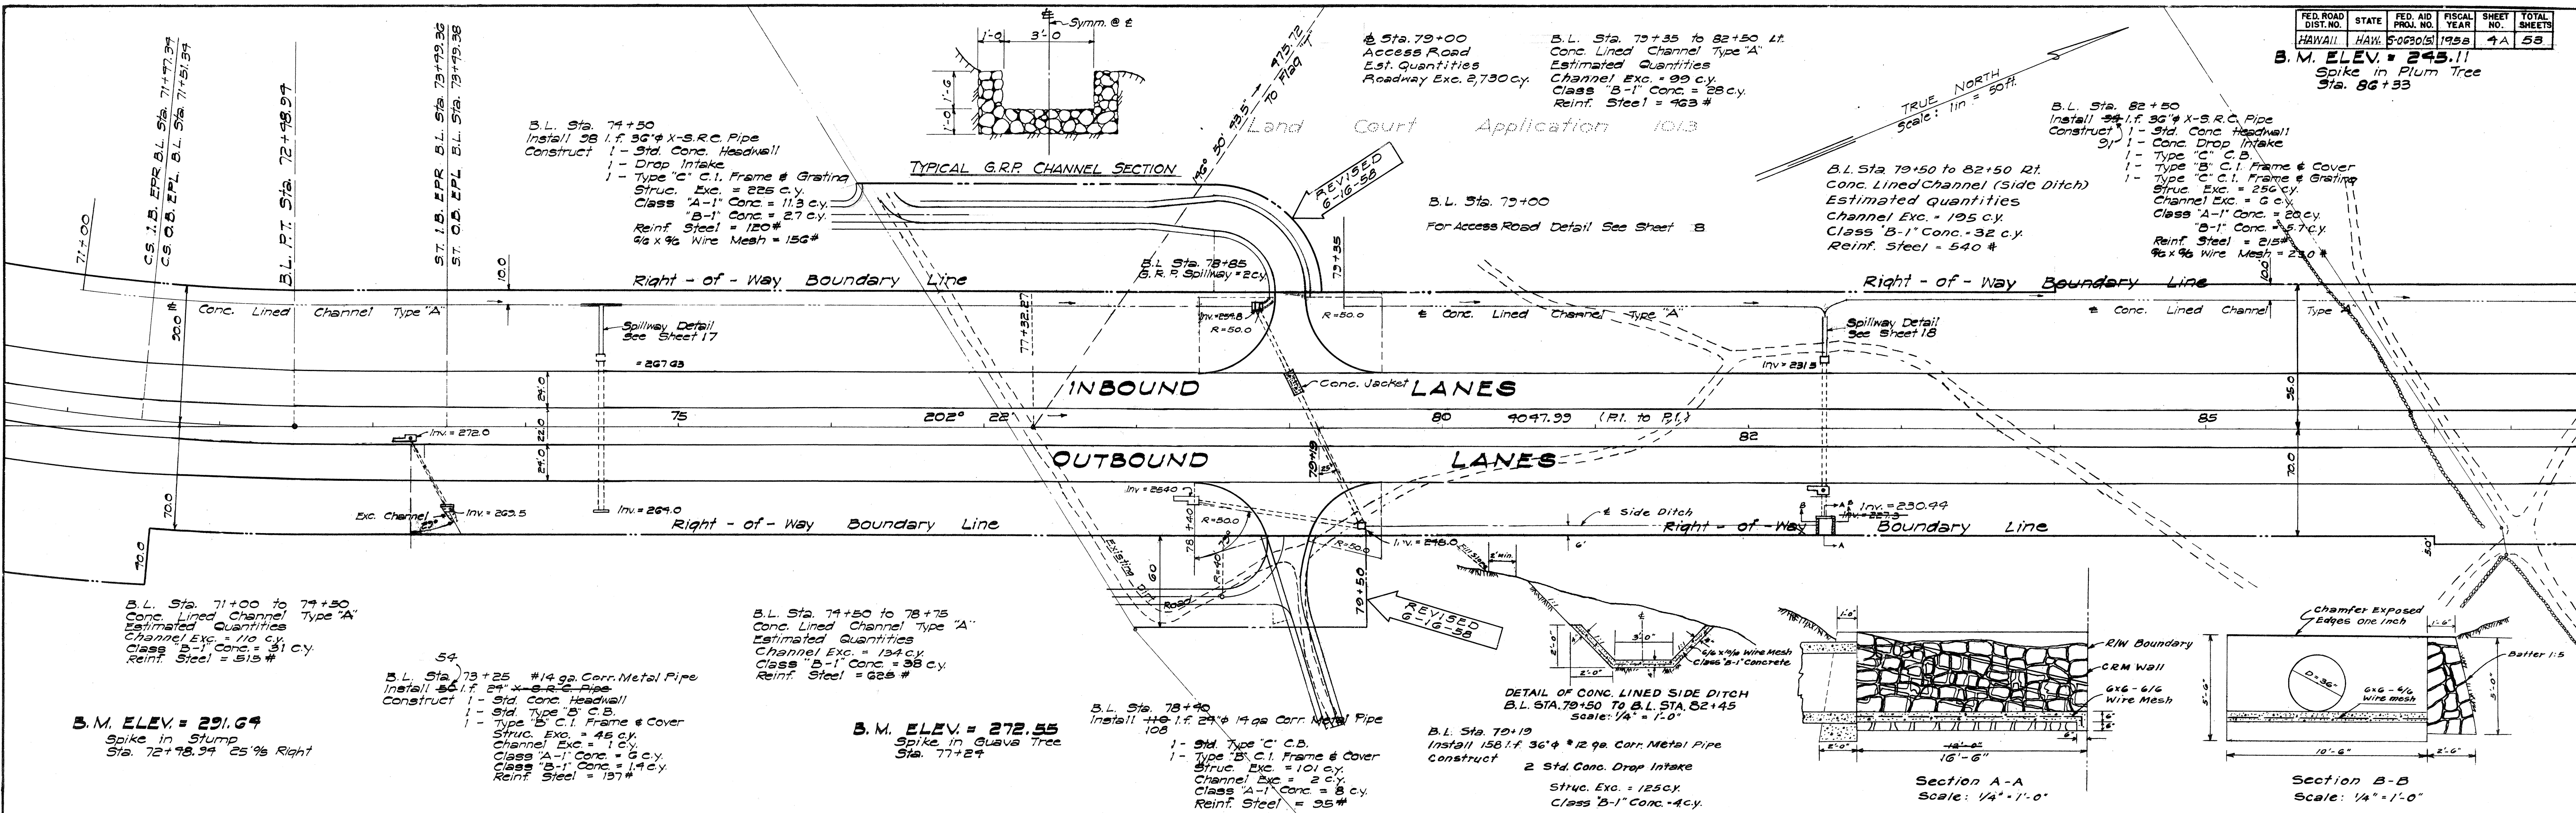

PLAN	SURVEYED	BY	DATE
NOTE BOOK	PLANNED		
NO.	ALIGNMENT CHECKED		
	RT. OF WAY CHECKED		

PROFILE	SURVEYED	BY	DATE
NOTE BOOK	PLANNED		
NO.	ALIGNMENT CHECKED		
	STRUCTURE NOTATIONS CHD.		

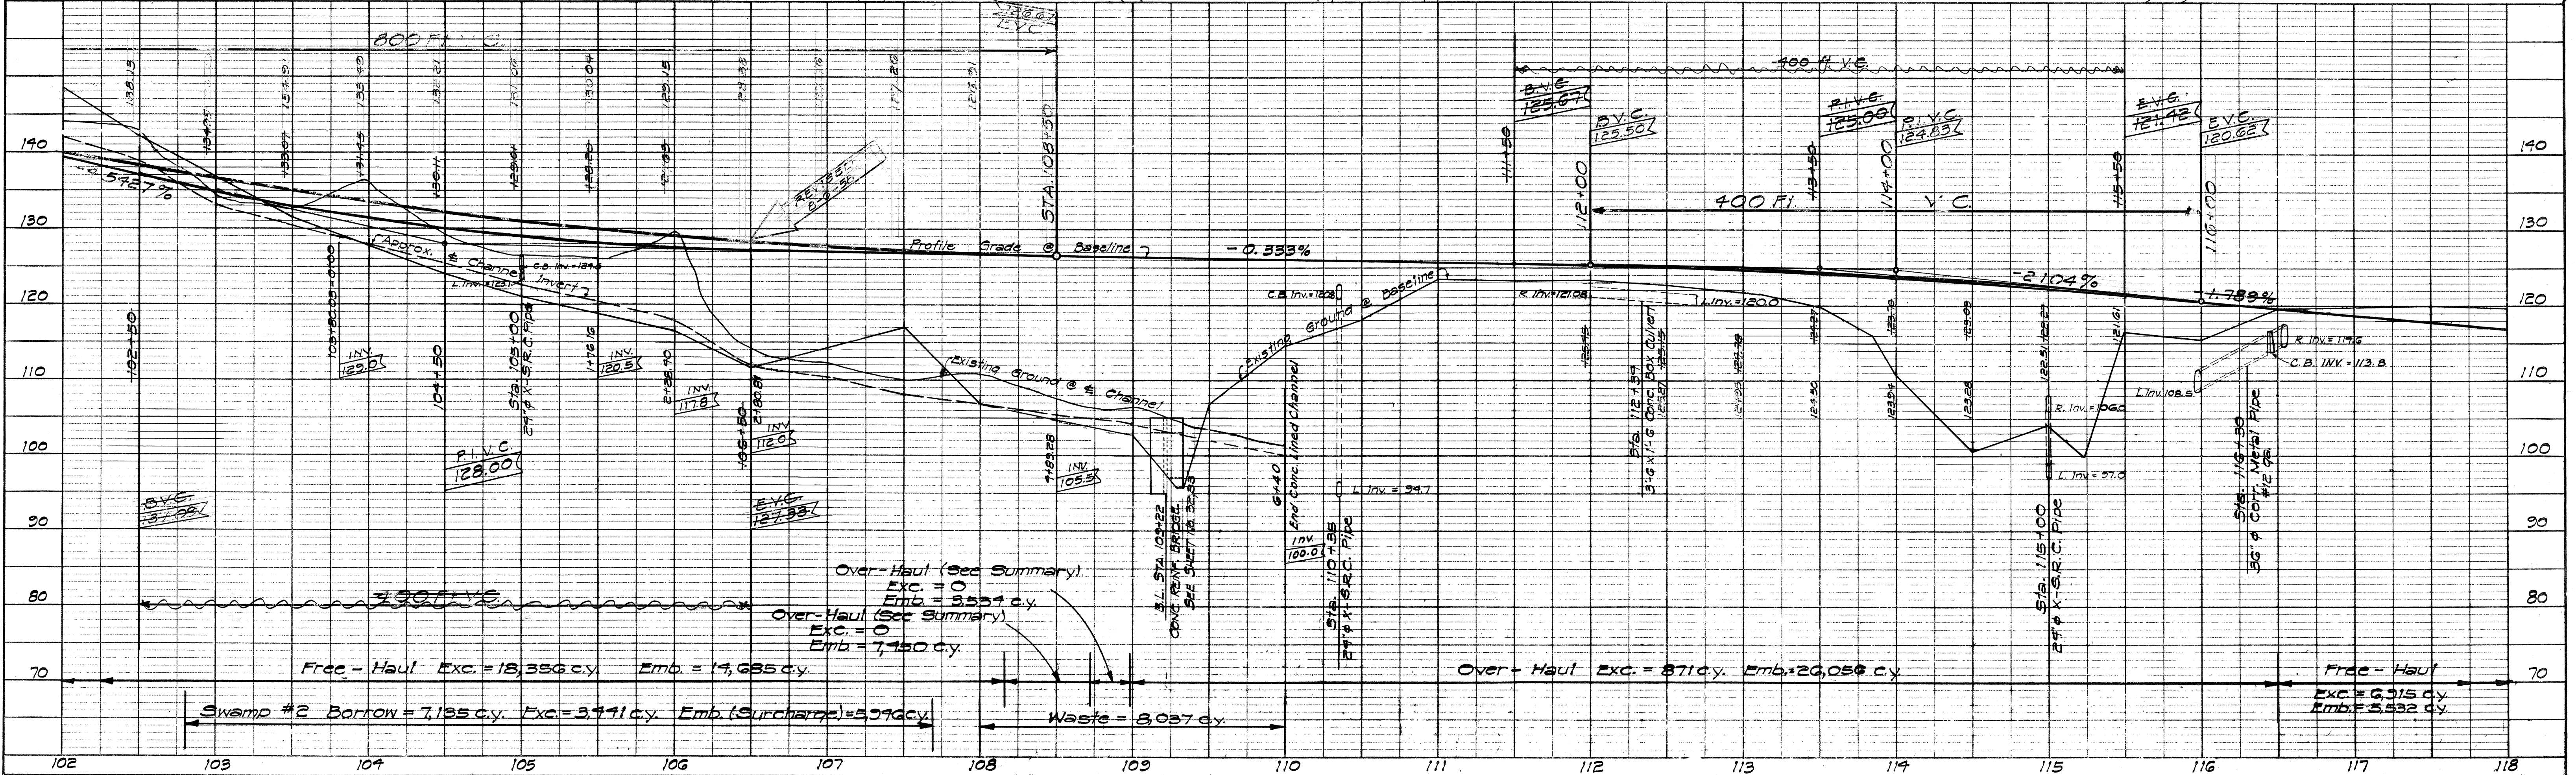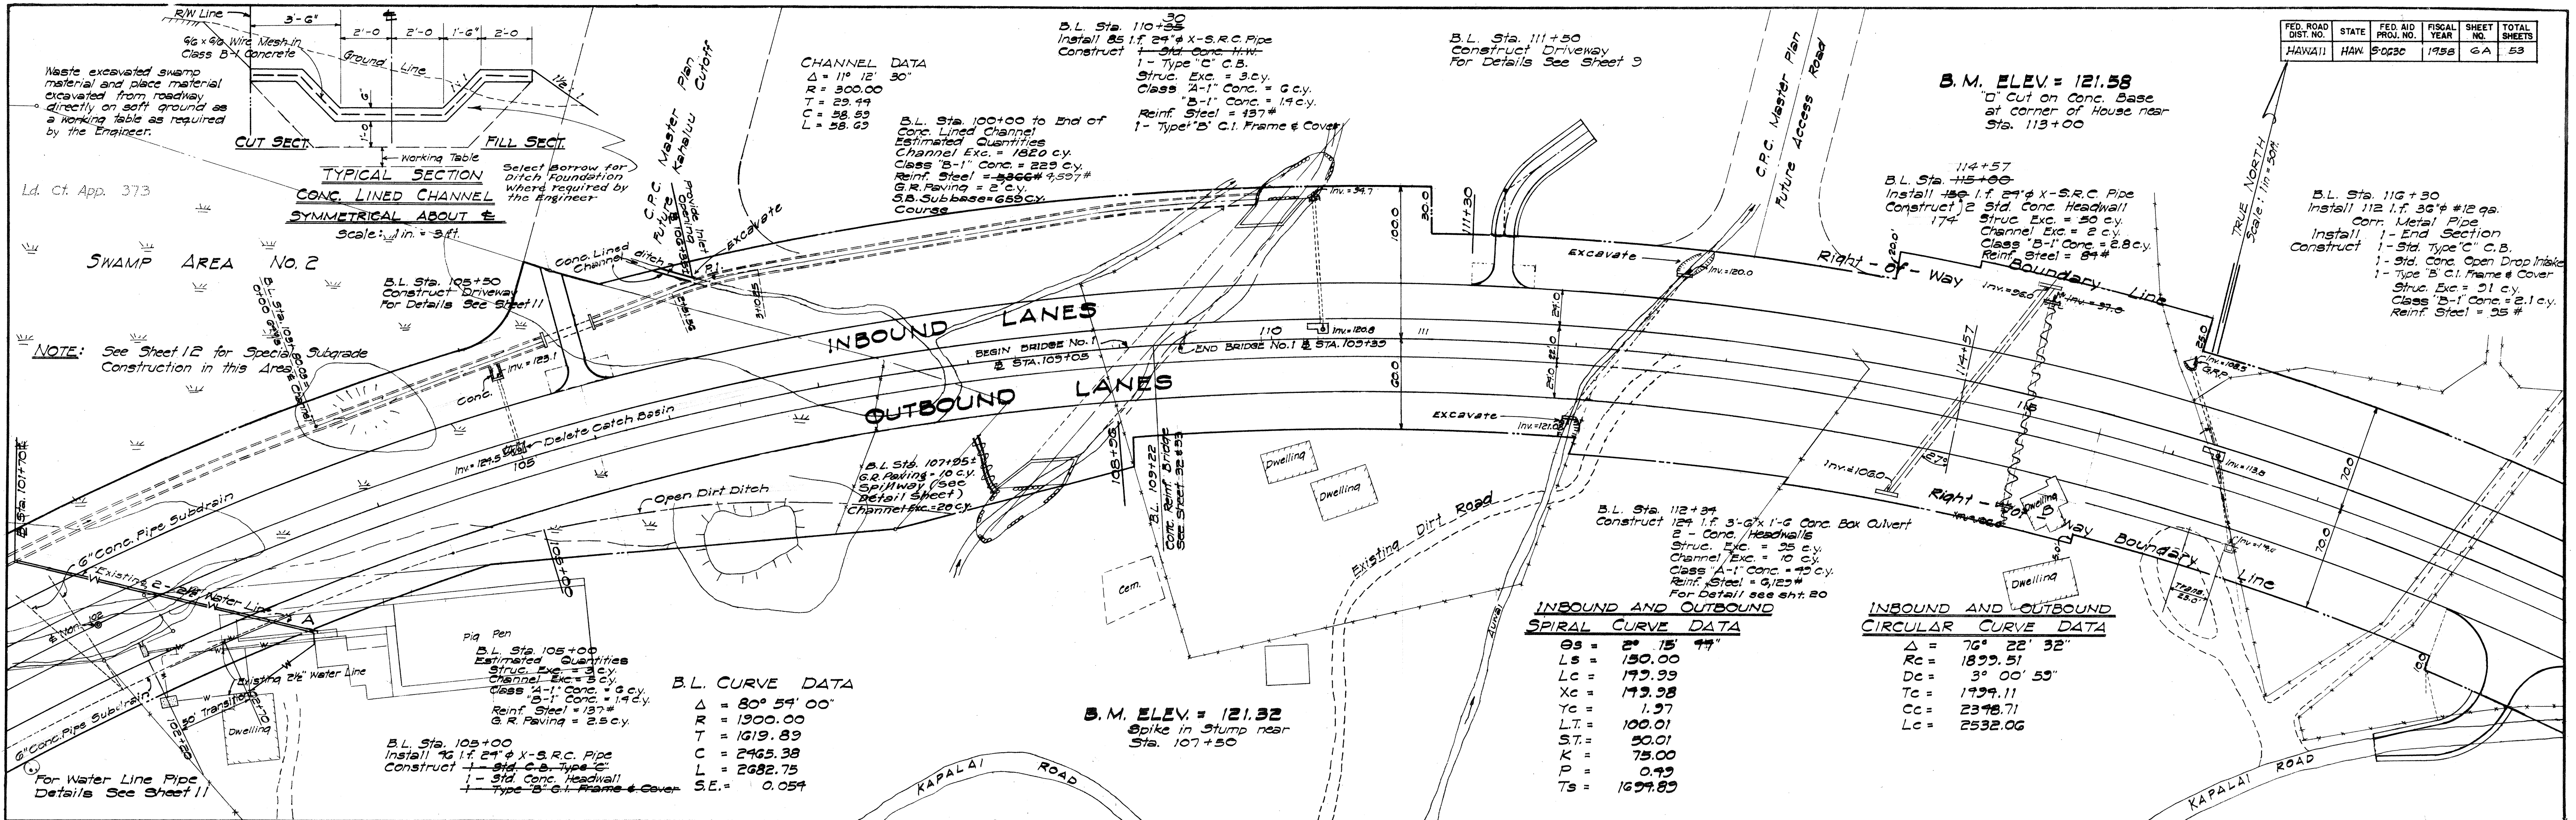


PLAN	DATE	BY
SURVEYED		
PLOTTED		
NOTE BOOK		
ALIGNMENT CHECKED		
RT. OF WAY CHECKED		
NO.		

PROFILE	DATE	BY
SURVEYED		
PLOTTED		
NOTE BOOK		
GRADES CHECKED		
STRUCTURE NOTATIONS CHECKED		
NO.		

NOTE: Before Construction is started in this area the U.S. Army Signal Corps must be notified and arrangements for protection and relocation of existing cable lines must be made.

B.M. ELEV. = 84.76
Spike in H.E. Pole #8 off Kapalei Road near Bridge Sta. 122+10.2, 157'9" Left

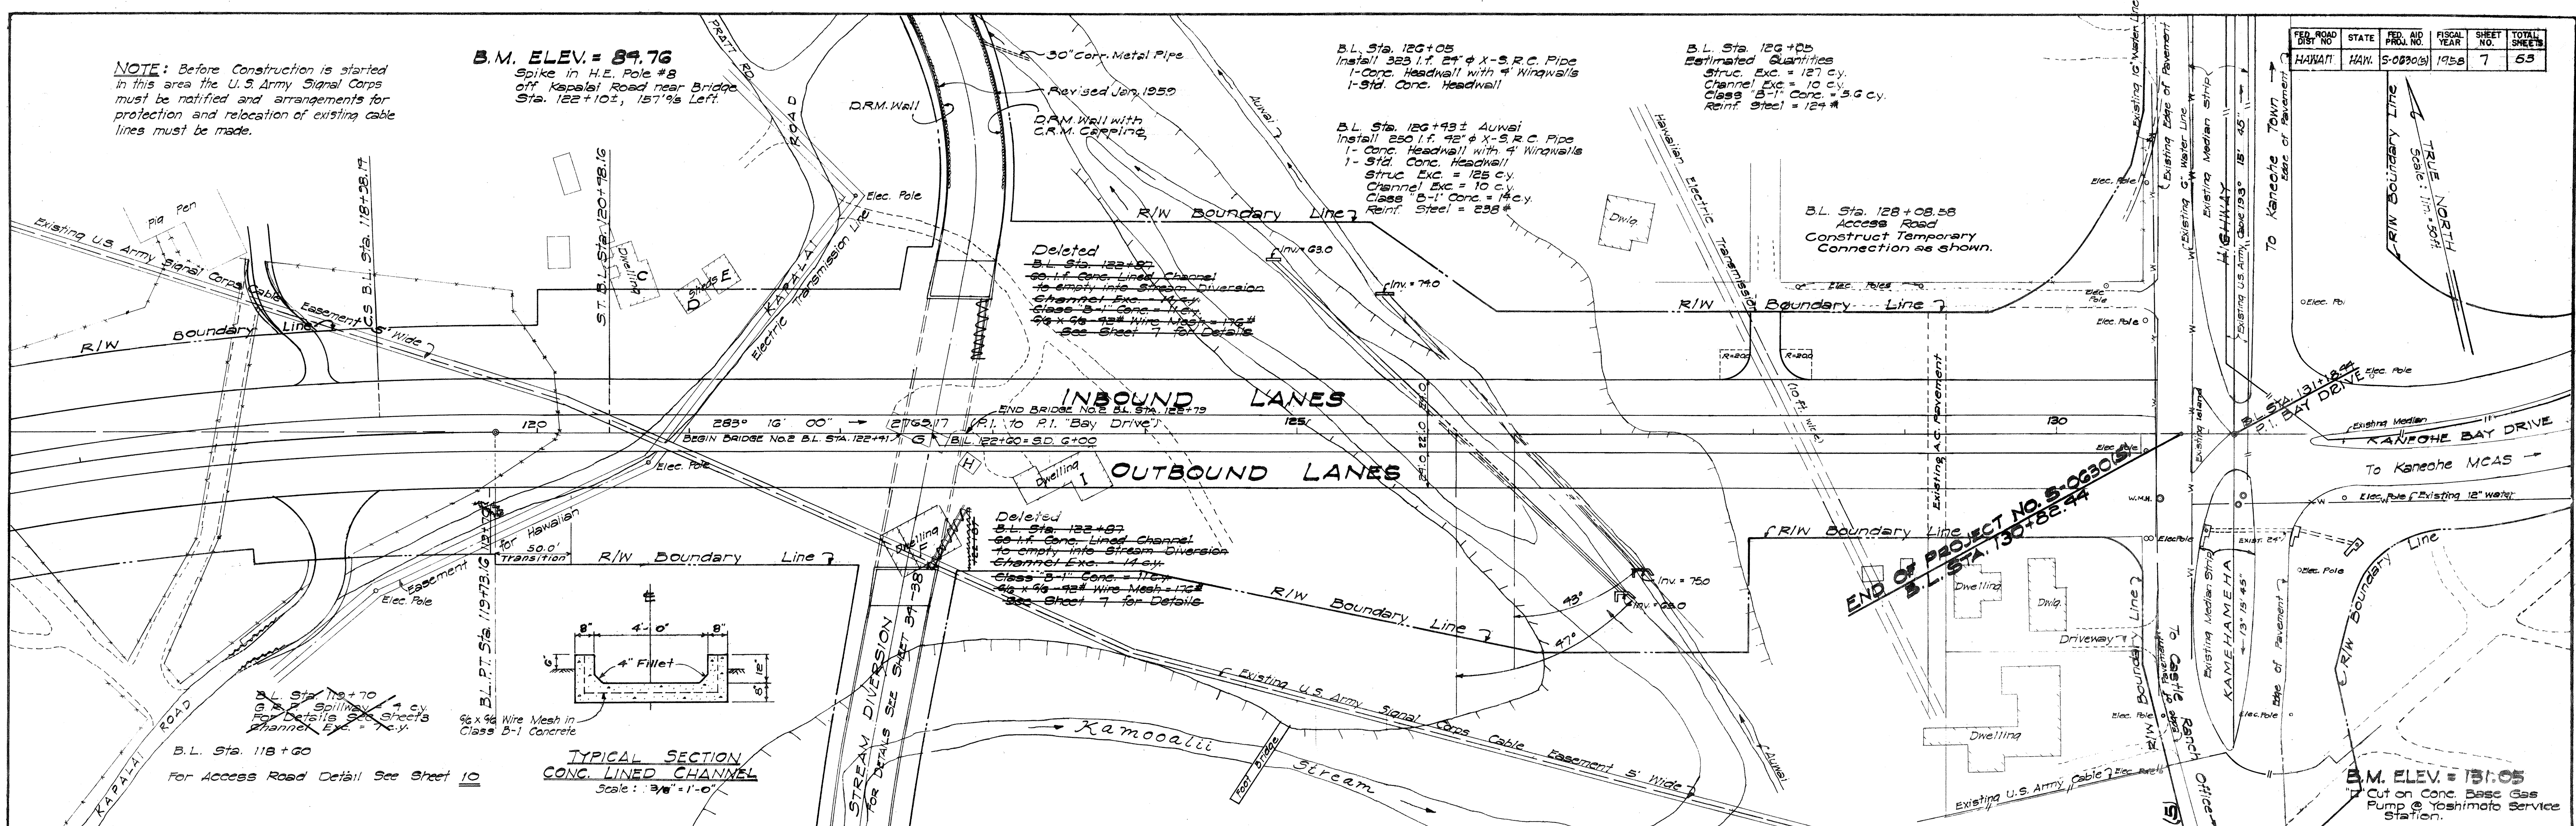

OVER-HAUL SUMMARY PROJECT NO. US-S-0630(S)					
FROM STA.	TO STA.	OVER-HAUL DIST.	CU. YDS.	STA. YDS.	MILE YDS.
81+18	124+50	0.6 Mi.	64,771	—	38,262
87+48	112+18	0.3 Mi.	31,633	—	9,510
59+60	69+75	1,015 Ft.	533	80	—
80+52	108+86	934 Ft.	4,417	41,255	—
36+32	108+44	152 Ft.	5,338	14,166	4,373
TOTALS			110,200	55,441	22,944

