

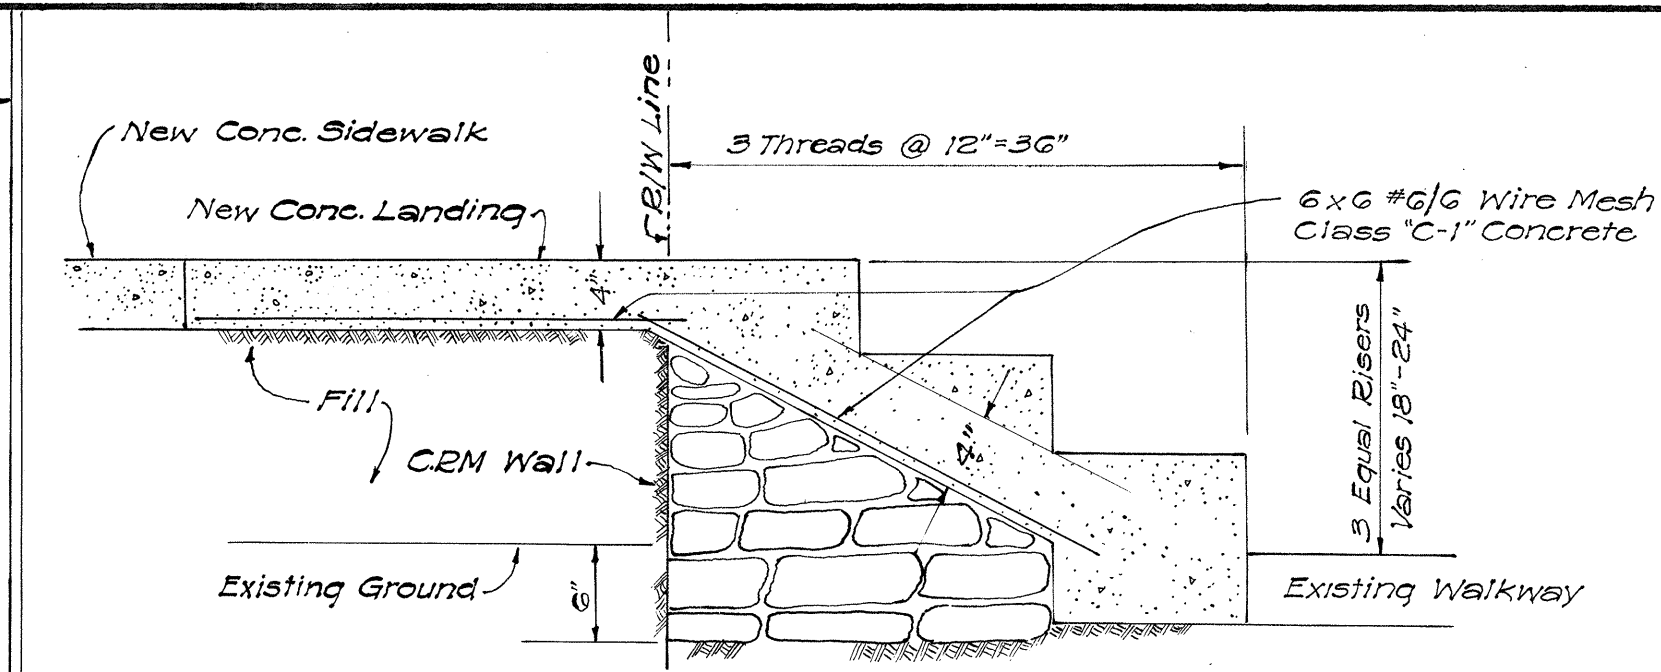
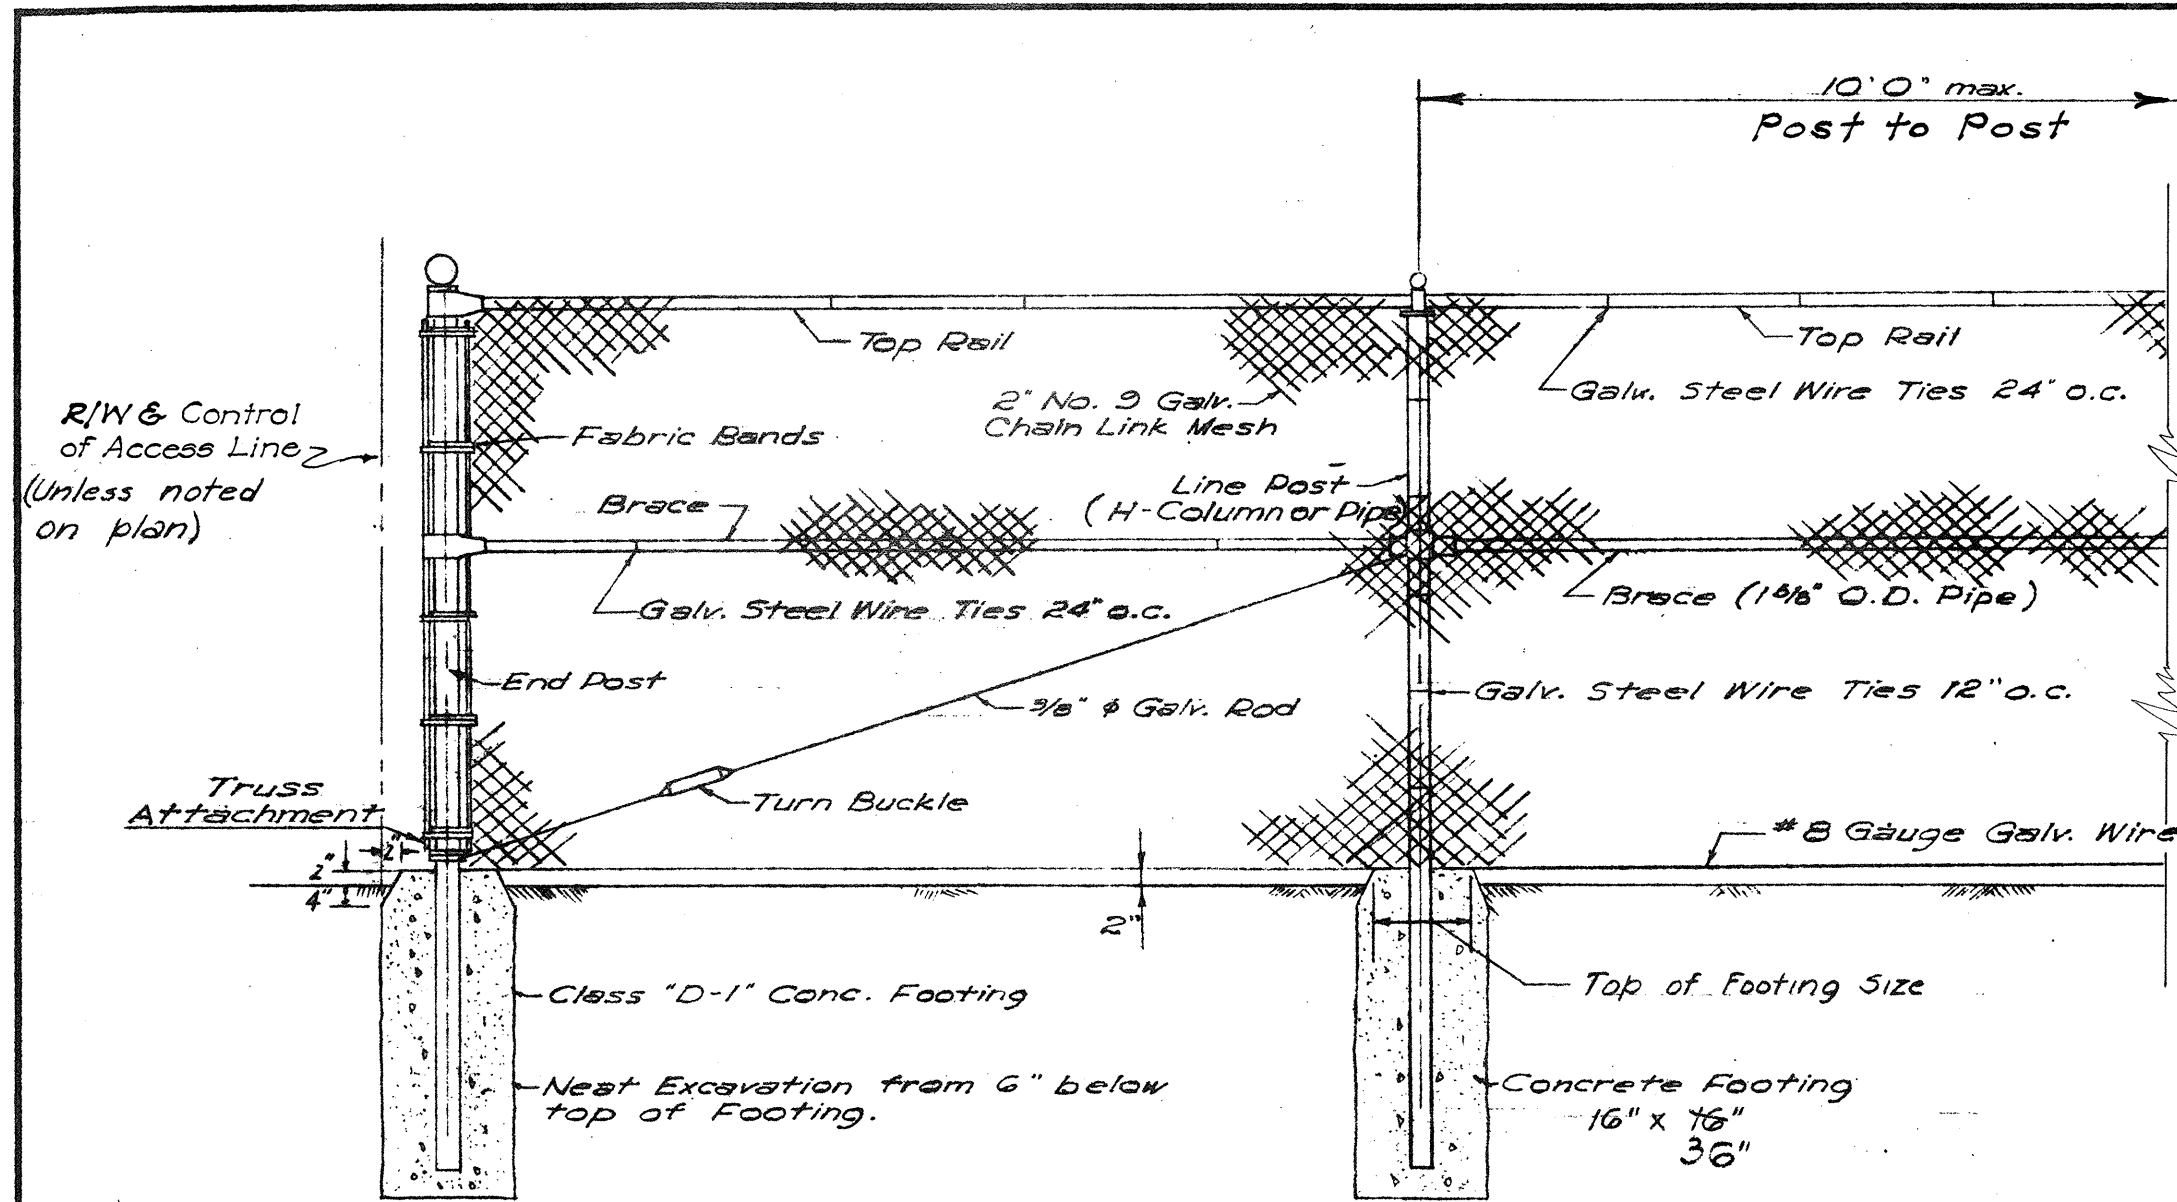
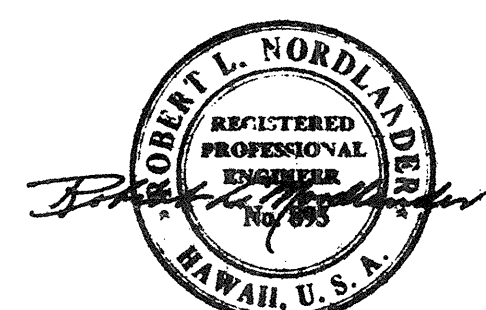
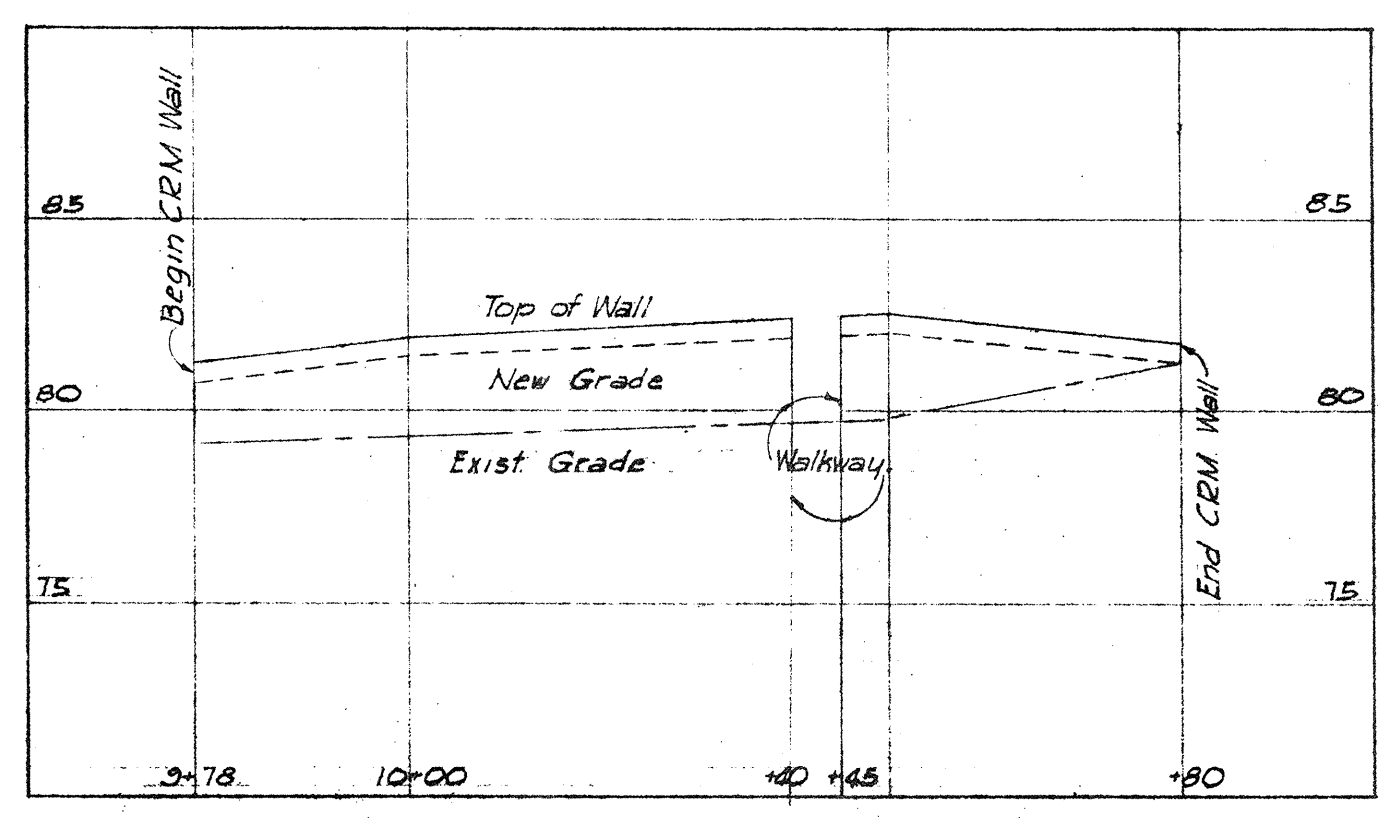
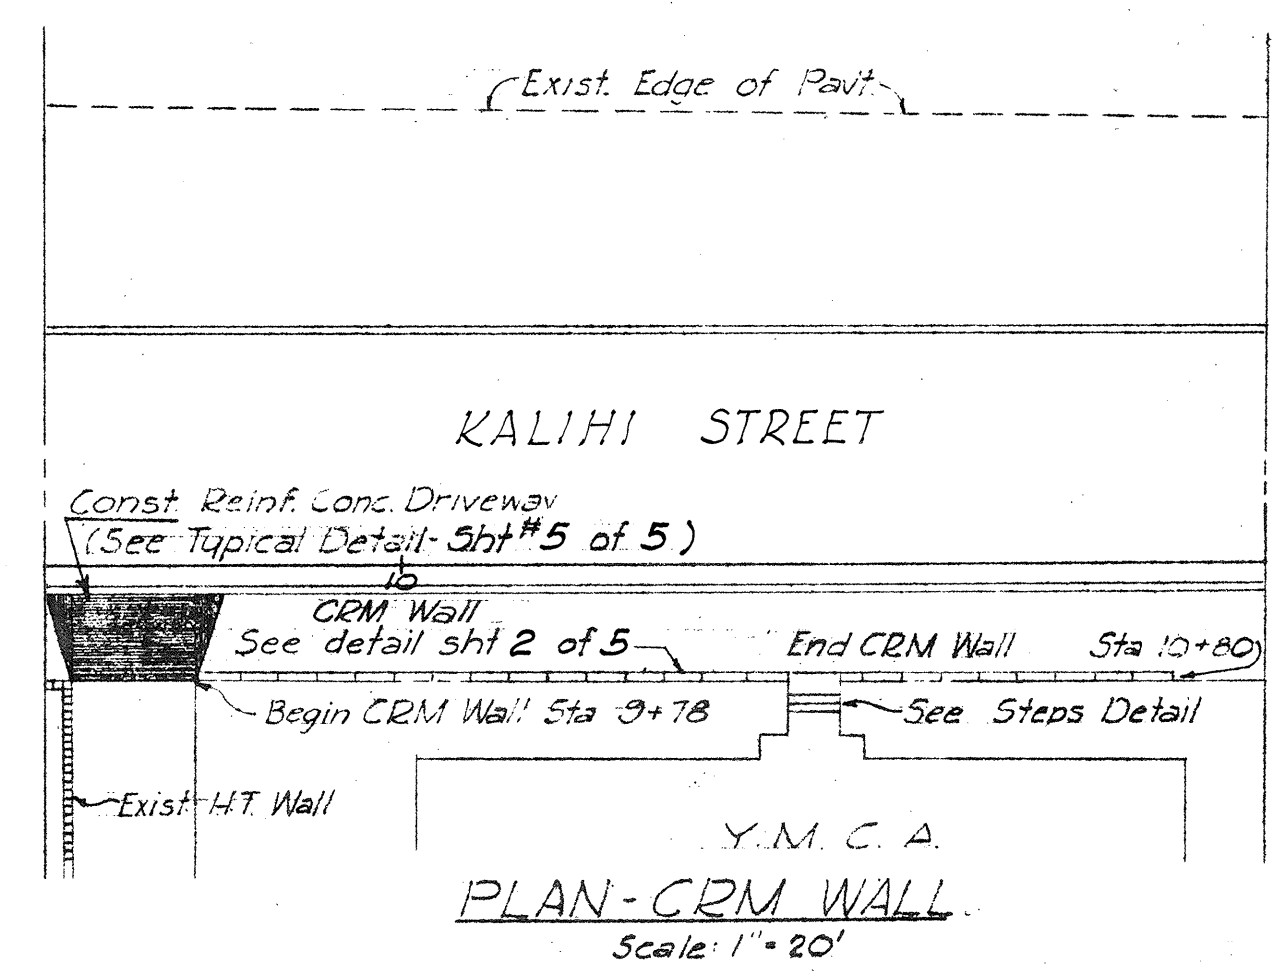
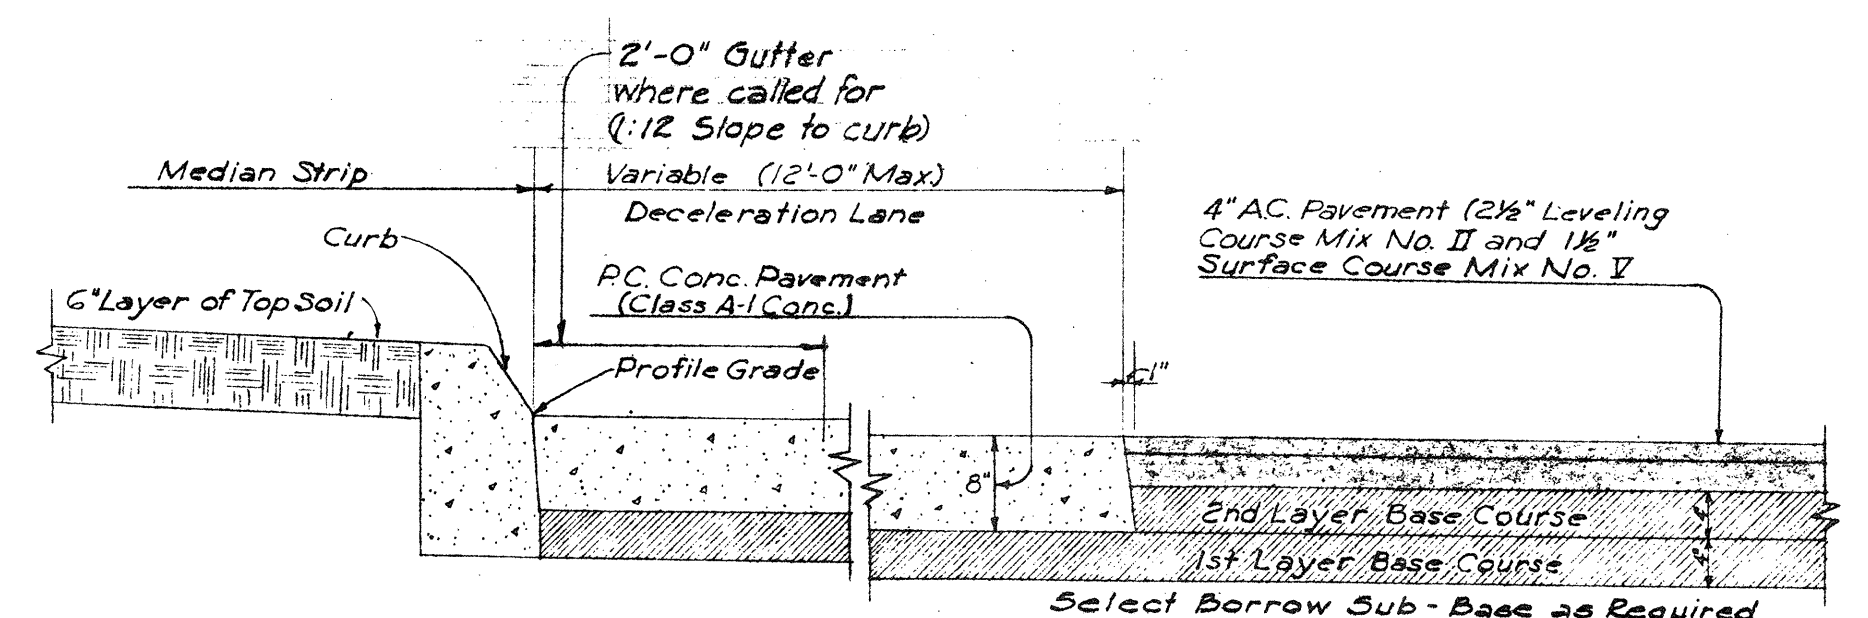
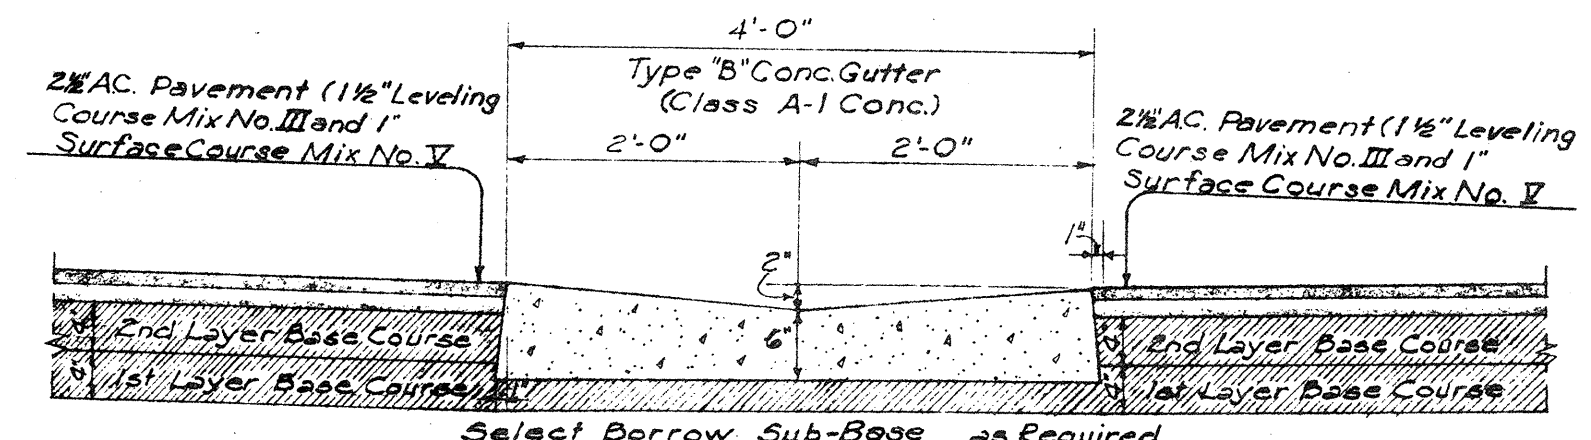
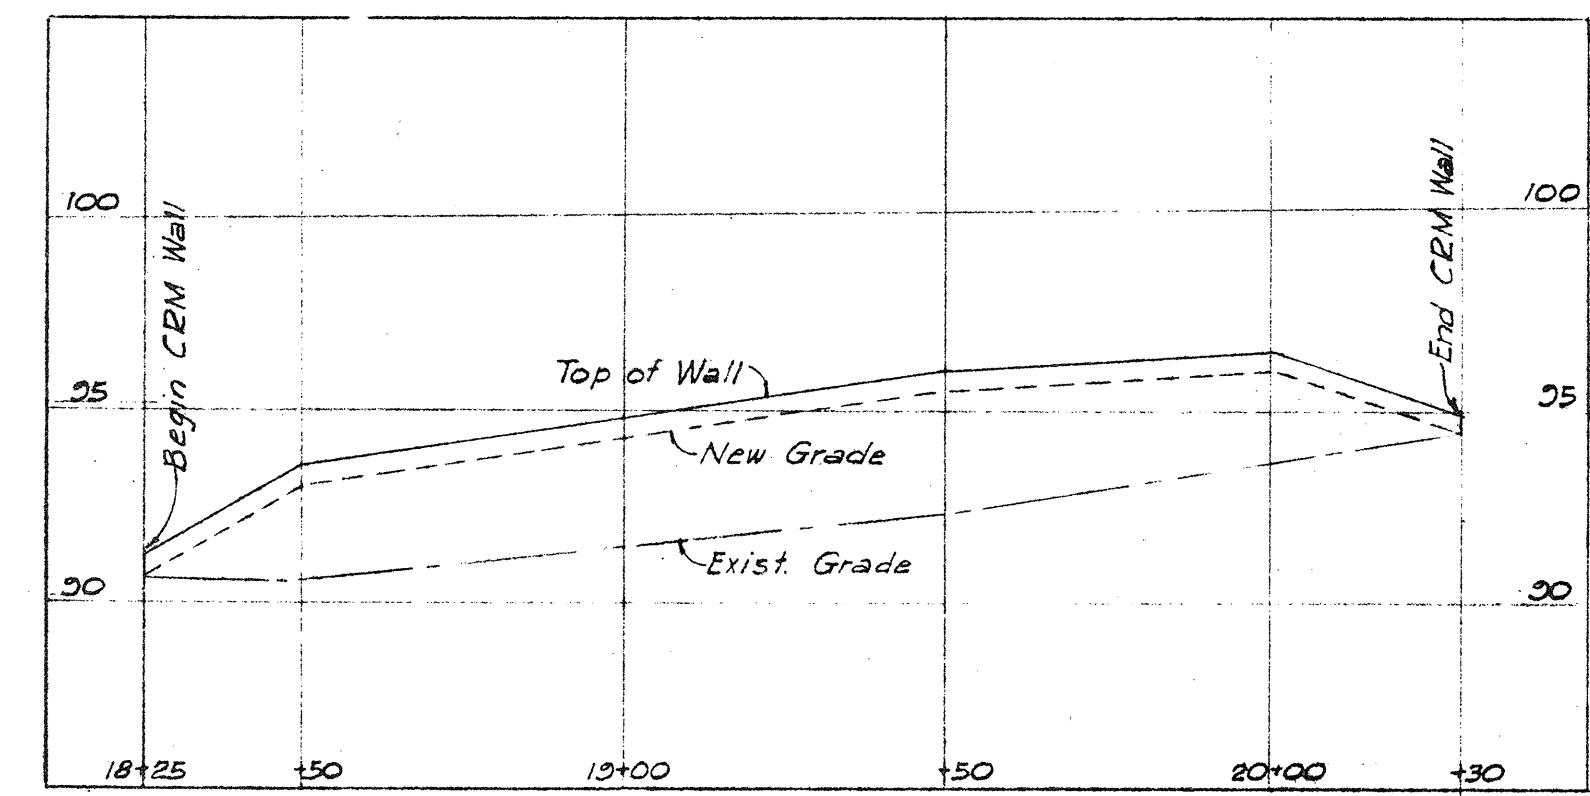
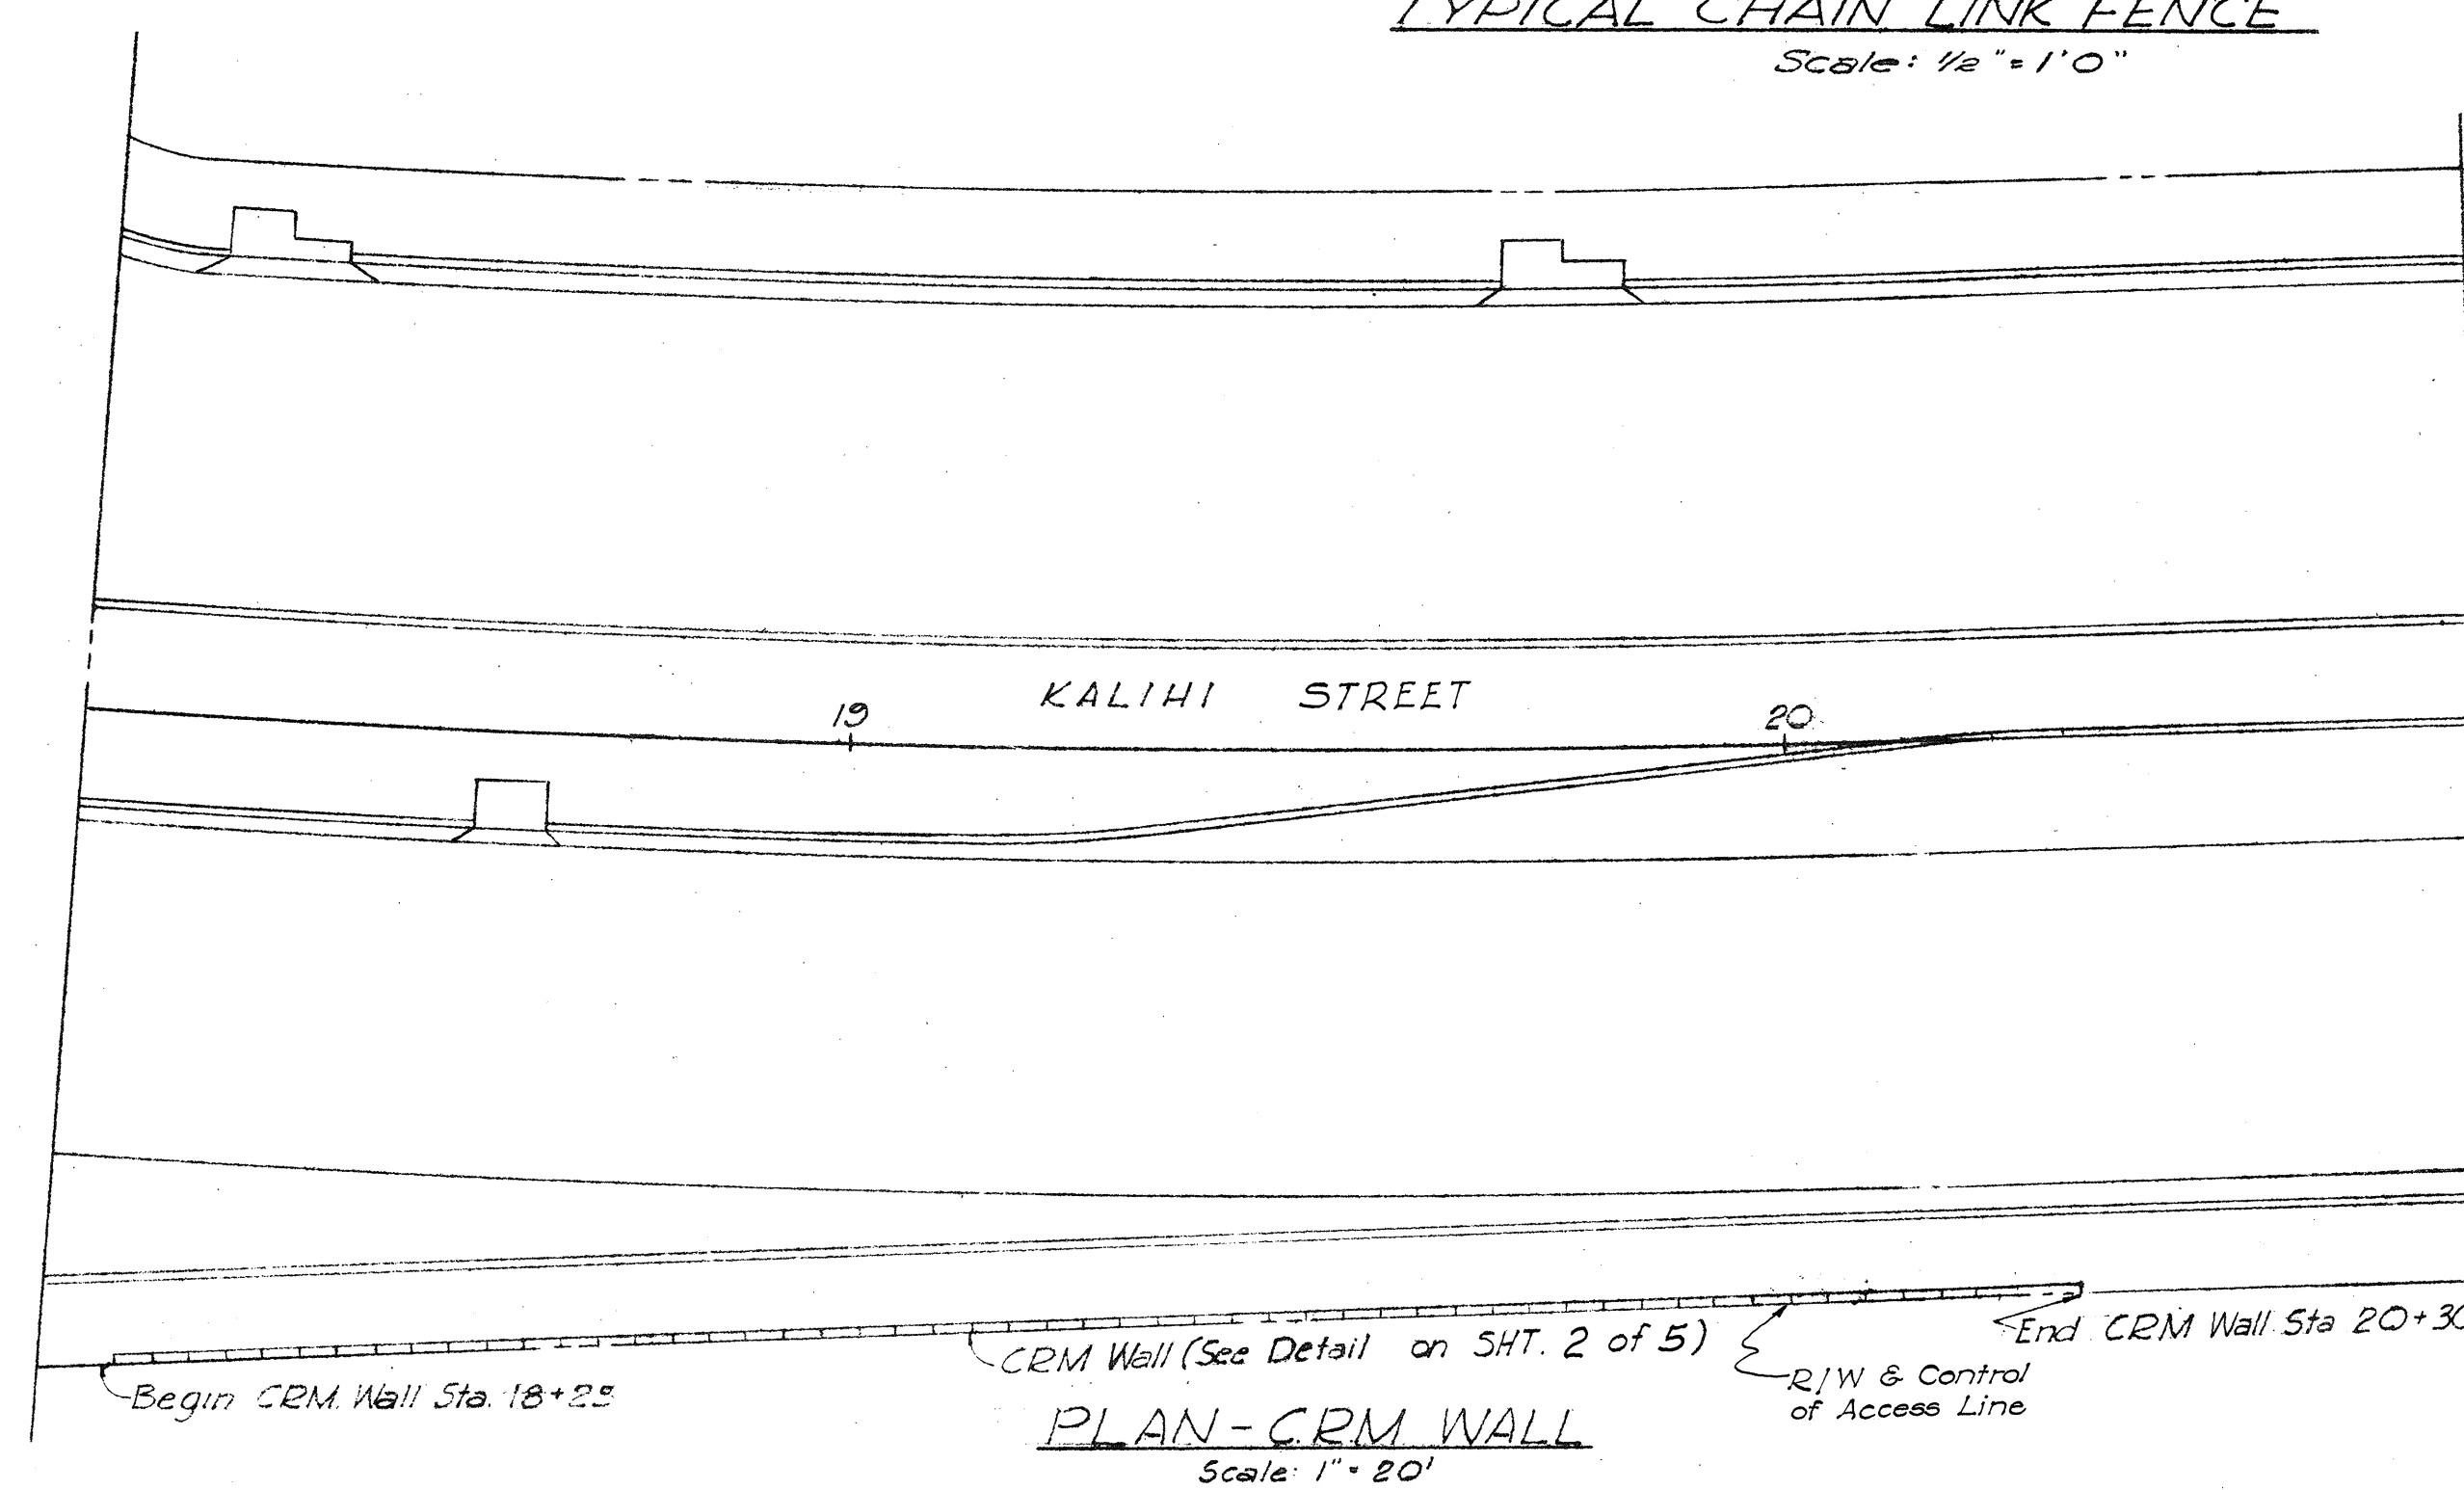


FED. ROAD DIST. No.	STATE	FED. AID PROJ. No.	FISCAL YEAR	SHEET No.	TOTAL SHEETS
HAWAII	HAW.	U-072-1(7) UNIT 3	1958	23	80
		US 0630(2)	1958	28	103

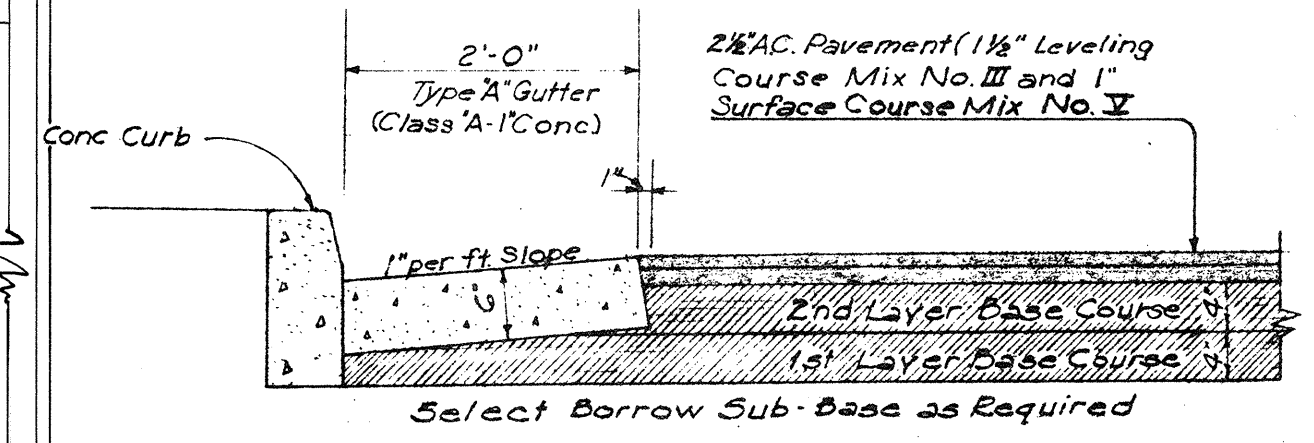

Schedule For Chain Link Fence

Height of Fence	Line Post	End Post	Top Rail	Depth of Footing	Top of Footing Size	Length of Post
6'	4 1/2" / ft	2 1/2" o.d.	3" o.d.	1 3/4" o.d.	36" 36"	16" sq. 9'0" 9'0"

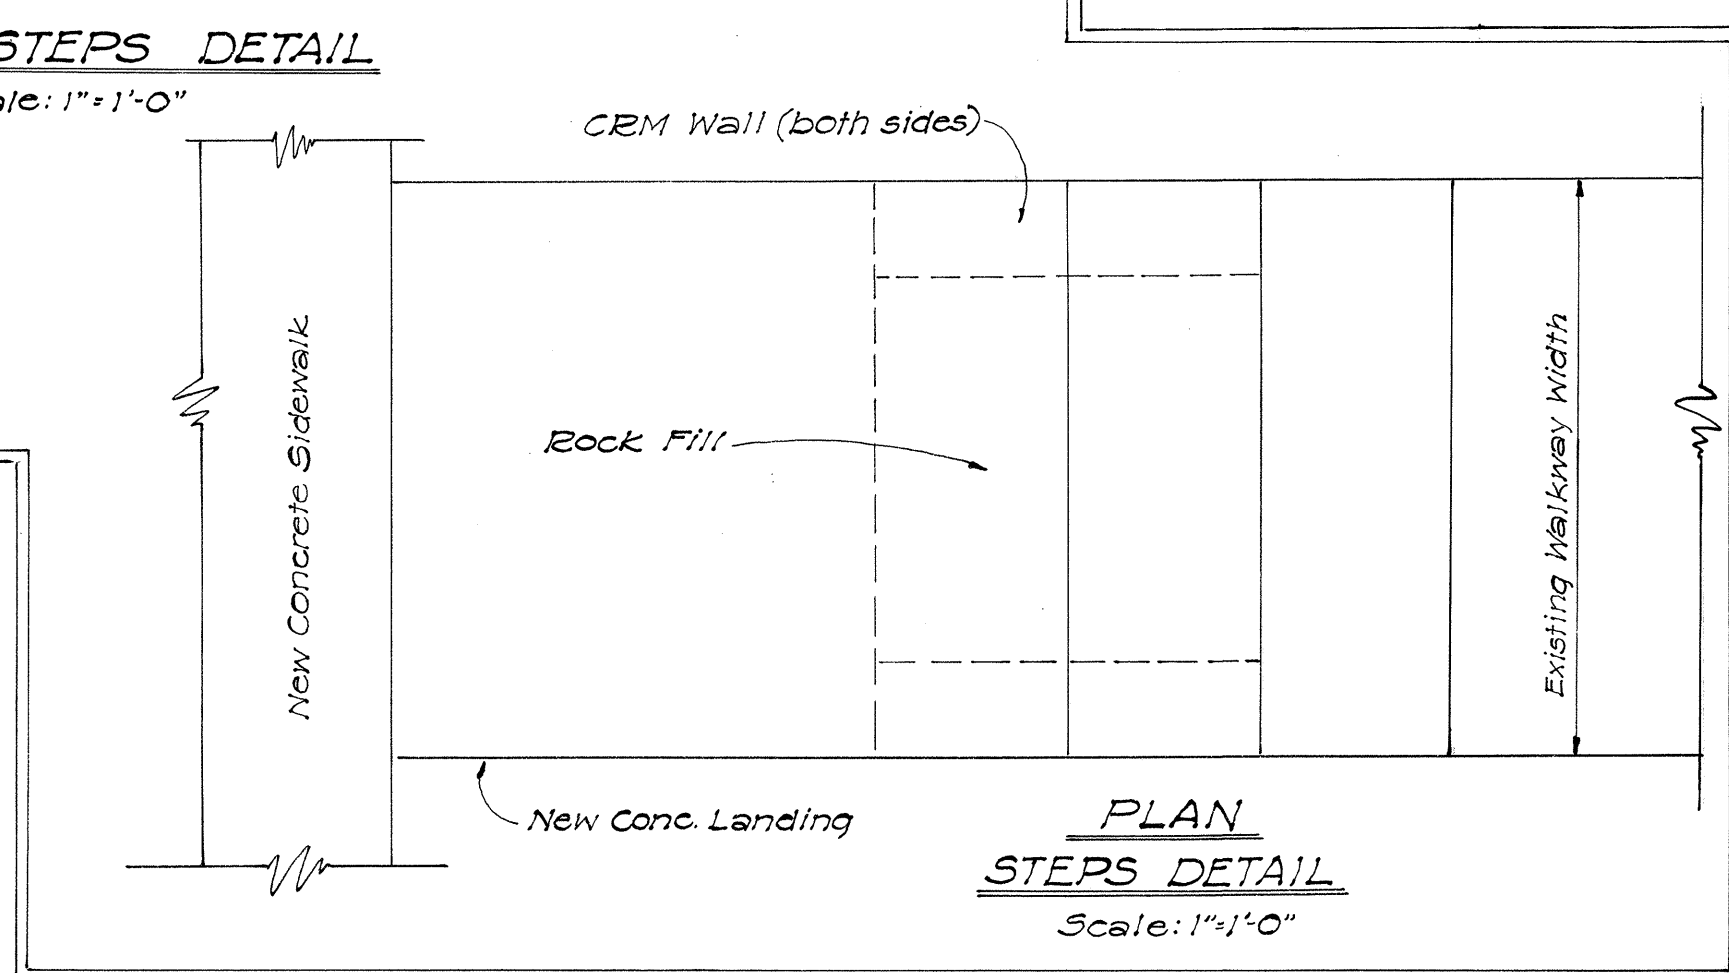

BELT, COLLINS & ASSOC., LTD.
Civil and Structural Engineers

TERRITORIAL HIGHWAY DEPARTMENT
TERRITORY OF HAWAII

MISCELLANEOUS DETAILS

LUNALILO FREEWAY U-072-1(7) UNIT 3
KALIHI STREET US 0630(2)

SHEET NO. 1 OF 5 SHEETS

5983.23 5984.28

DATE	12-50
SURVEY PLOTTED BY	W.S.
PLAN	12-50
TRACED BY	W.S.
QUANTITIES CHECKED BY	W.S.
NOTE BOOK	
No.	

ORIGINAL	SURVEY PLotted BY	DATE
PLAN	DESIGNED BY	
	DRAWN BY	
	RECORD BY	
NOTED WORK	QUANTITIES BY	
	QUANTITIES CHECKED BY	
	CHECKED BY	