



INDEX TO DRAWINGS		
SHEET NO.	DESCRIPTION	COMB. SHEET NO.
1	Title Sheet	2
2 - 6	Typical Sections	3 - 7
7 - 13	Plan & Profile	9 - 15
14	Construction Phases	16
15 - 16	Boring Logs	17 - 18
17 - 24	Detail Plan of Roadway	20 - 23 25 - 28
25 - 27	Grading Plans	29 - 31
28 - 29	Miscellaneous Details	32 - 33
30 - 32	R/W Adjustments	34 - 36
33 - 35	Storm Drain Details	37 - 39
36 - 40	Kalihi St. Overpass No. 1	43 - 47
41 - 42	Kalihi St. Overpass No. 2	48 - 49
43 - 46	Kalihi St. Overpass No. 3	50 - 53
47 - 49	Typical Structural Details	54 - 56
50 - 51	Pedestrian Overcrossing	57 - 58
52 - 55	Retaining Walls	59 - 60 63 - 64
56 - 58	Telephone, Electric And Existing Utilities	67 - 68 71
59 - 62	Hawaiian Tel. M.H. Details	72 - 75
63 - 65	Electric & Tel. Std. Detail	79 - 81
66 - 71	Sewer System	83, 85 - 89
72 - 77	Water System	91, 94 - 98
78 - 83	Sub-Station & Hwy. Lighting	99 - 104
84 - 85	Traffic Sign	105 - 106
86 - 103	Cross Section	109 - 114 116 - 127

TERRITORY OF HAWAII
TERRITORIAL HIGHWAY DEPARTMENT
HONOLULU, OAHU, T. H.
AS BUILT
PLANS OF
KALIHI STREET
BECKLEY STREET TO SCHOOL STREET
FEDERAL AID PROJECT NO. US0630(2)

DISTRICT OF HONOLULU
ISLAND OF OAHU
SCALE
PLAN 1 INCH = 50 FEET
PROFILE HOR. 1 INCH = 50 FEET
VER. 1 INCH = 5 FEET
CROSS SECTION HOR. 1 INCH = 10 FEET
VER. 1 INCH = 5 FEET

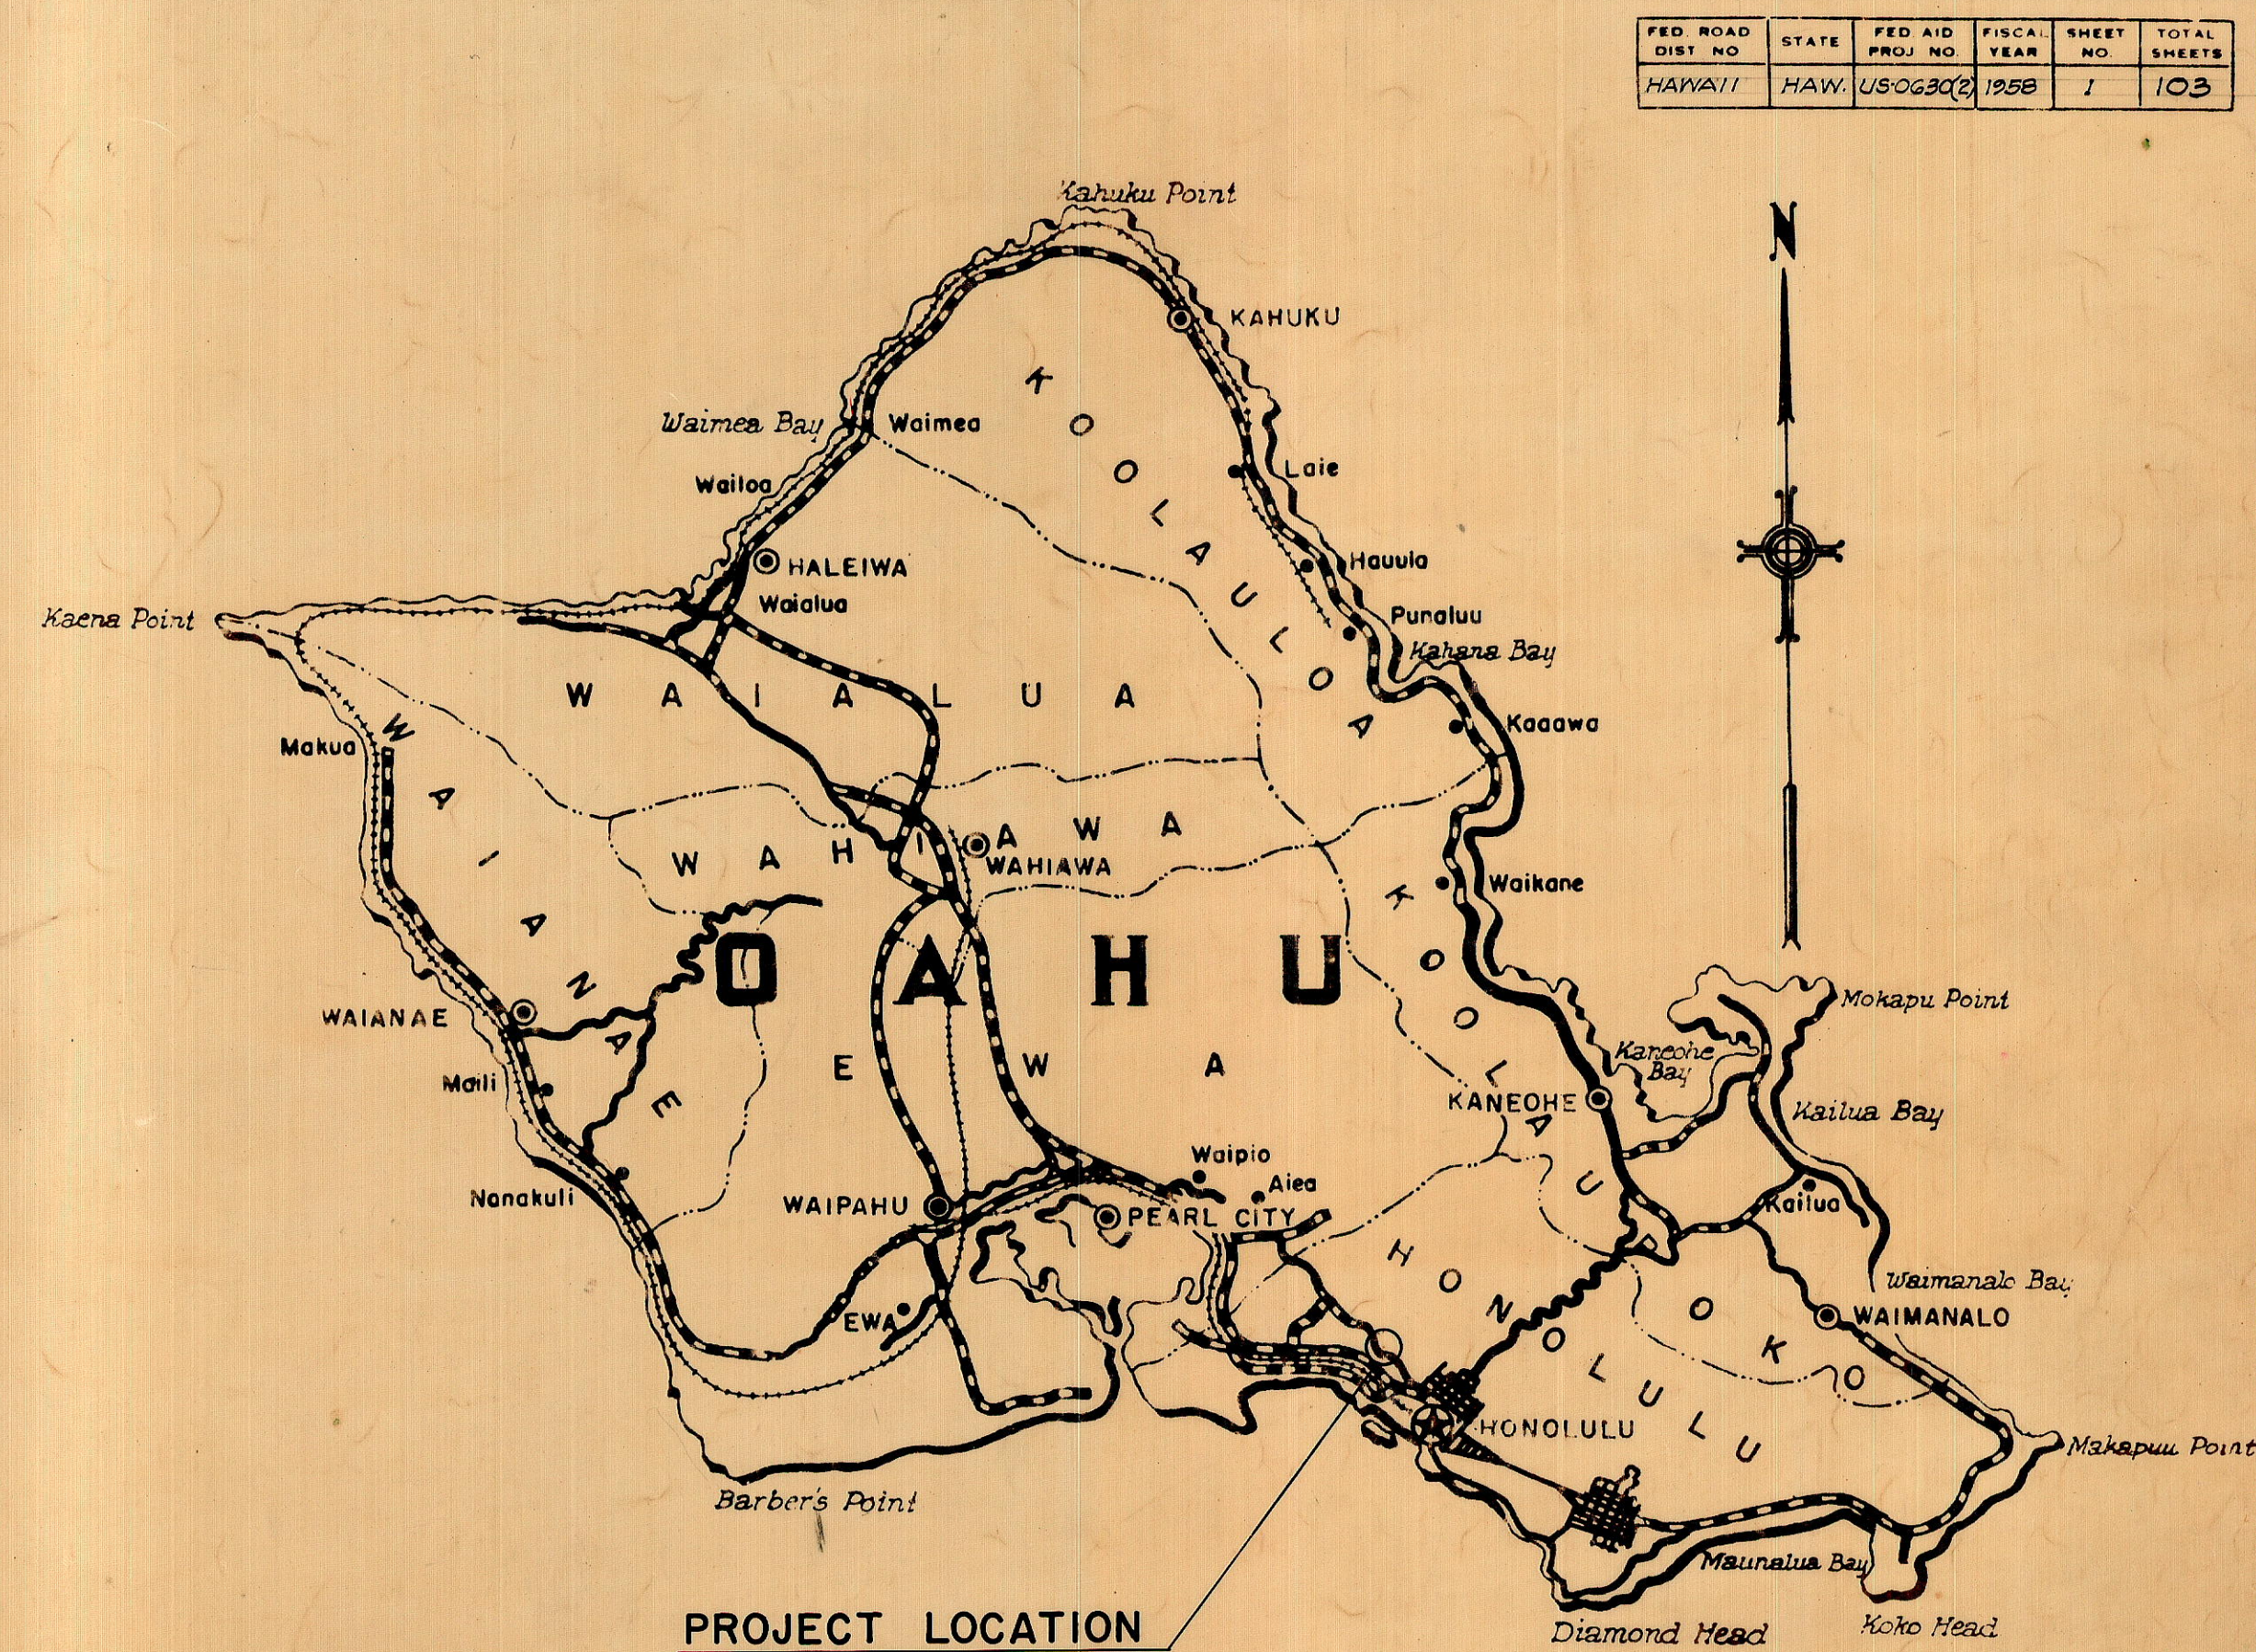

Federal Aid Projects Previously Constructed Or Under Construction

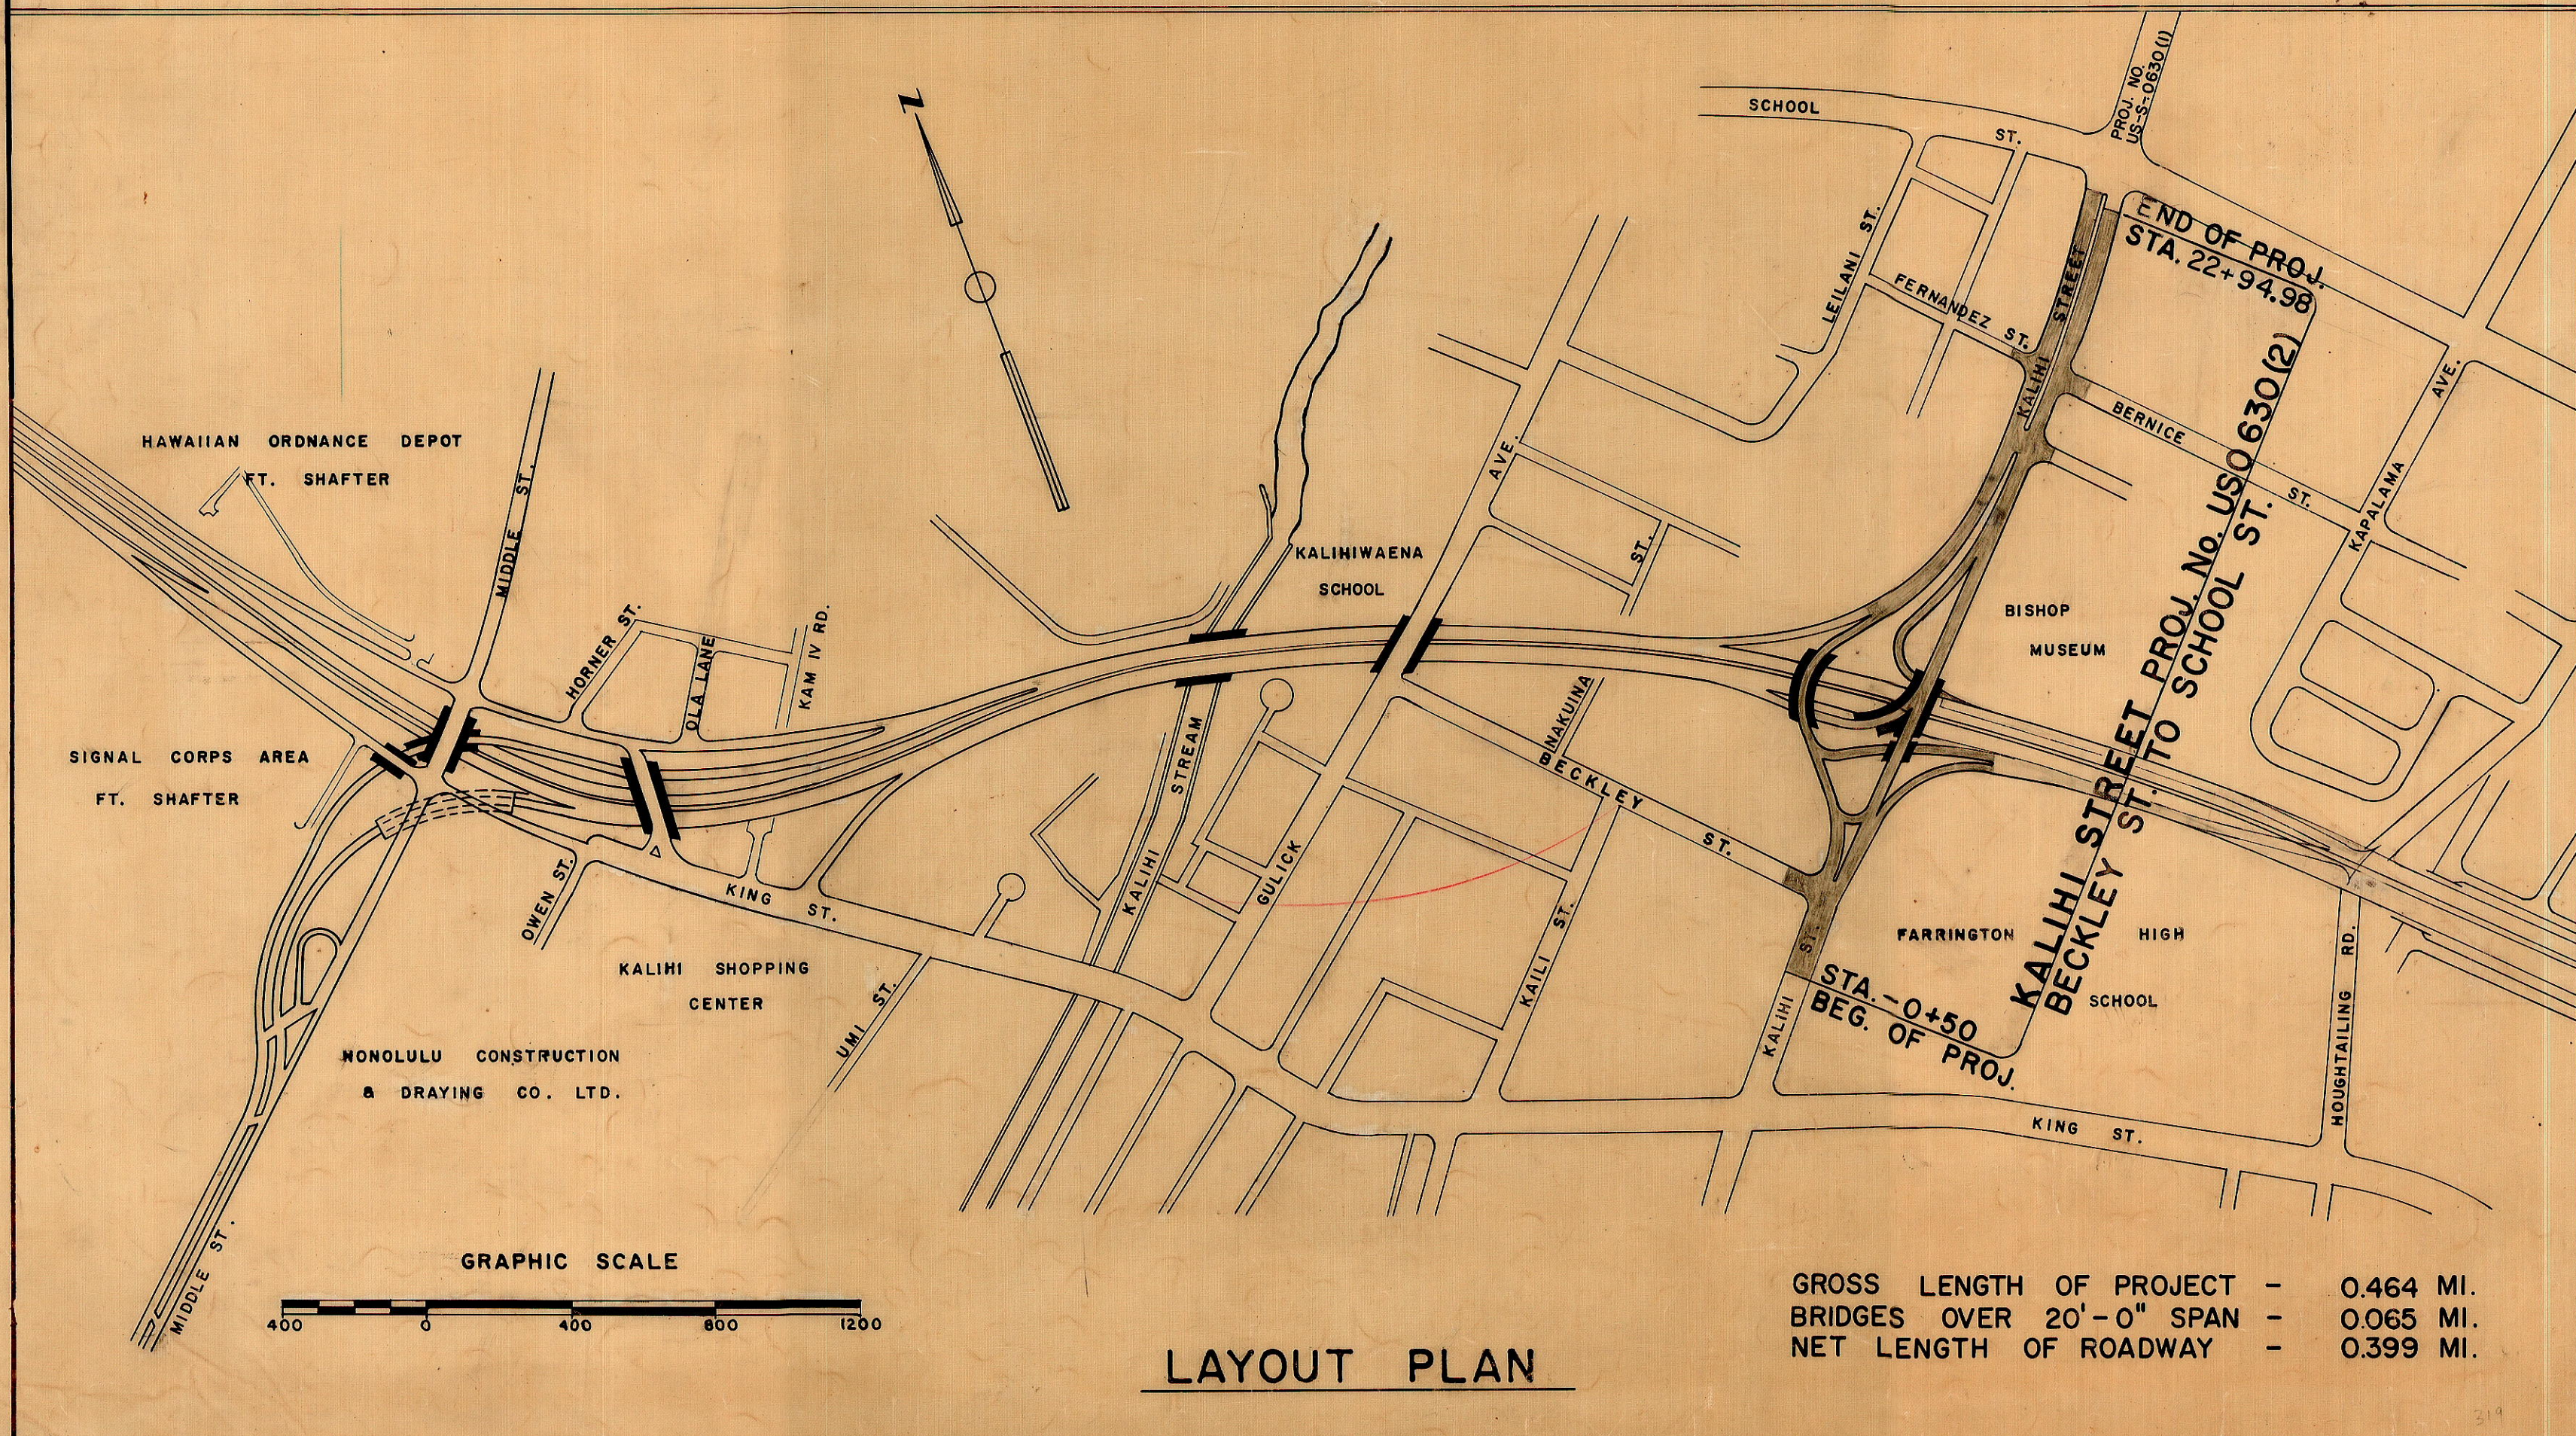

NOTE:
ALL CHANGES MADE DURING
CONSTRUCTION HAVE BEEN NOTED
IN THESE TRACINGS IN RED AND
CHECKED BY

BELT, COLLINS & ASSOCIATES, LTD.
Civil and Structural Engineers
· ASSOCIATES ·
MOFFATT, NICHOL & TAYLOR - Structural Engineers
JAMES B. MANN - Surveyor
PAUL R. WEISSICH - Landscape Architect
WYNN NAKAMURA - Electrical Engineer

RESIDENT ENGINEER
DATE

APPROVED: DATE 7/7/58
TERRITORIAL HIGHWAY ENGINEER

DEPARTMENT OF COMMERCE
BUREAU OF PUBLIC ROADS
APPROVED:
DIVISION ENGINEER DATE

GROSS LENGTH OF PROJECT - 0.464 MI.
BRIDGES OVER 20'-0" SPAN - 0.065 MI.
NET LENGTH OF ROADWAY - 0.399 MI.

LAYOUT PLAN