



DATE	
SURVEY PLOTTED BY	
DESIGNED BY	
DRAWN BY	
CHECKED BY	
QUANTITIES CHECKED BY	
NOTE BOOK	
No.	

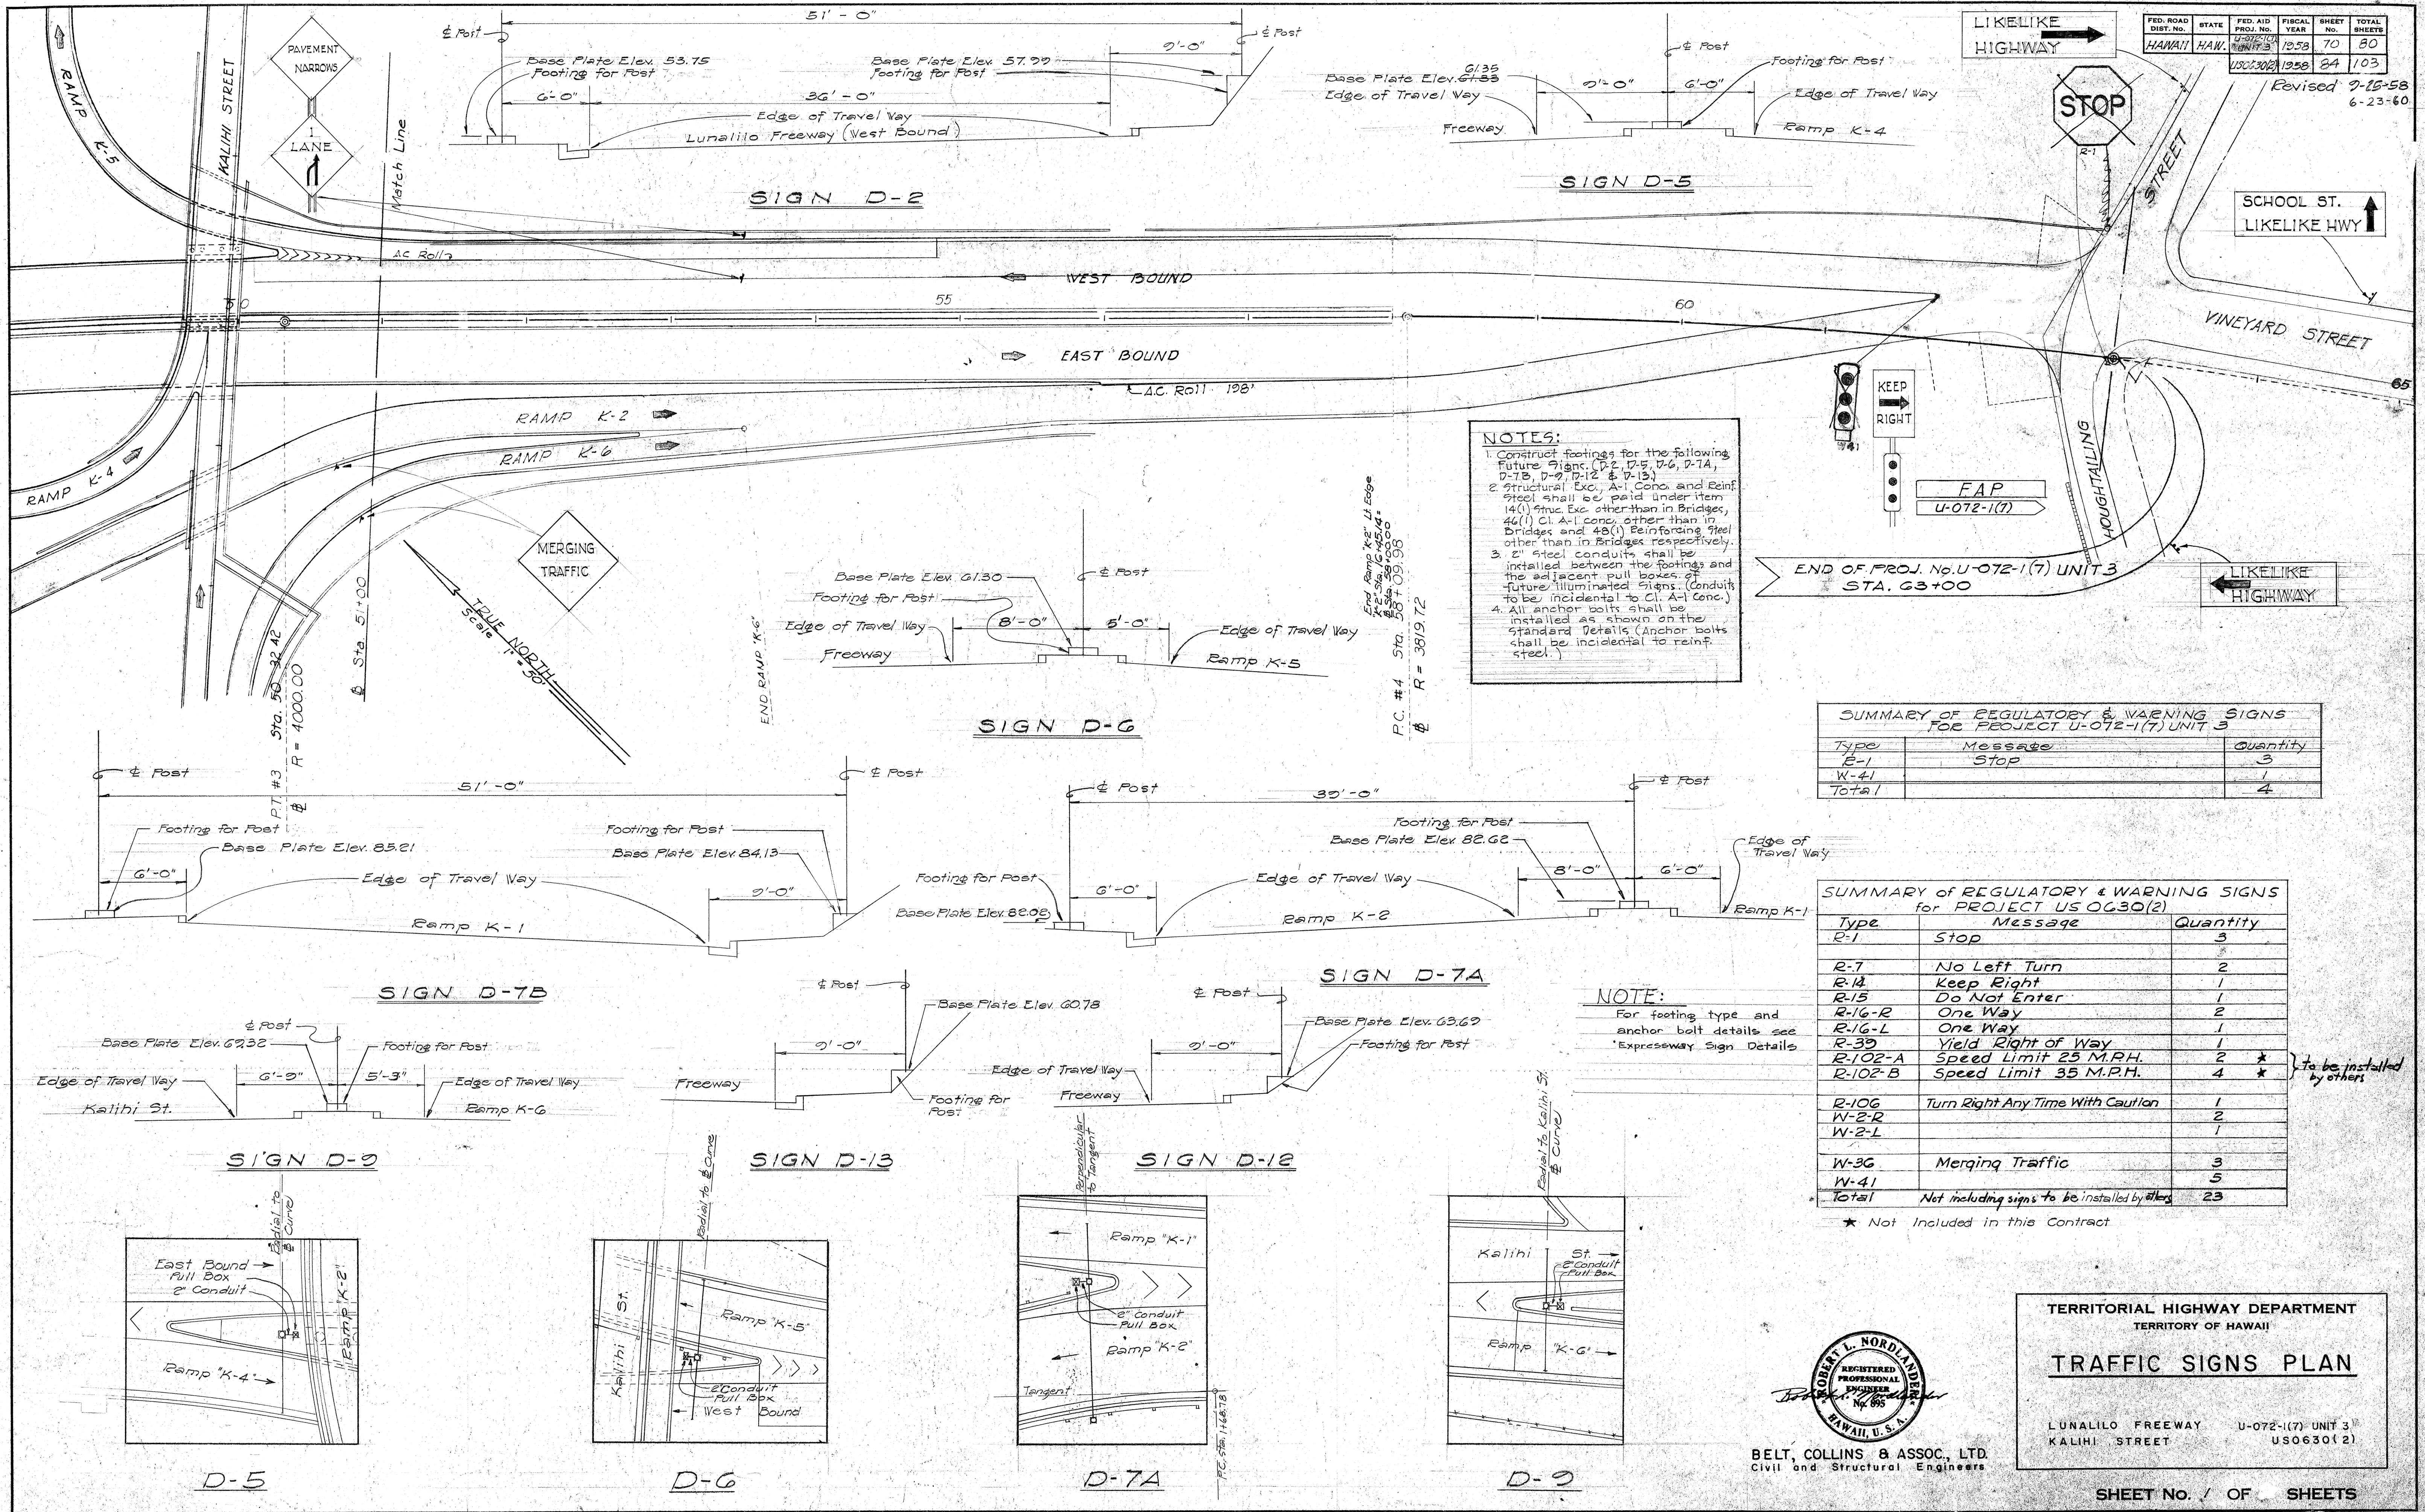

5983.70 5984.84

DESIGNED BY	DATE
DRAWN BY	
CHECKED BY	
QUANTITIES CHECKED BY	
NO.	

ORIGINAL PLAN	
NOTE BOOK	
NO.	

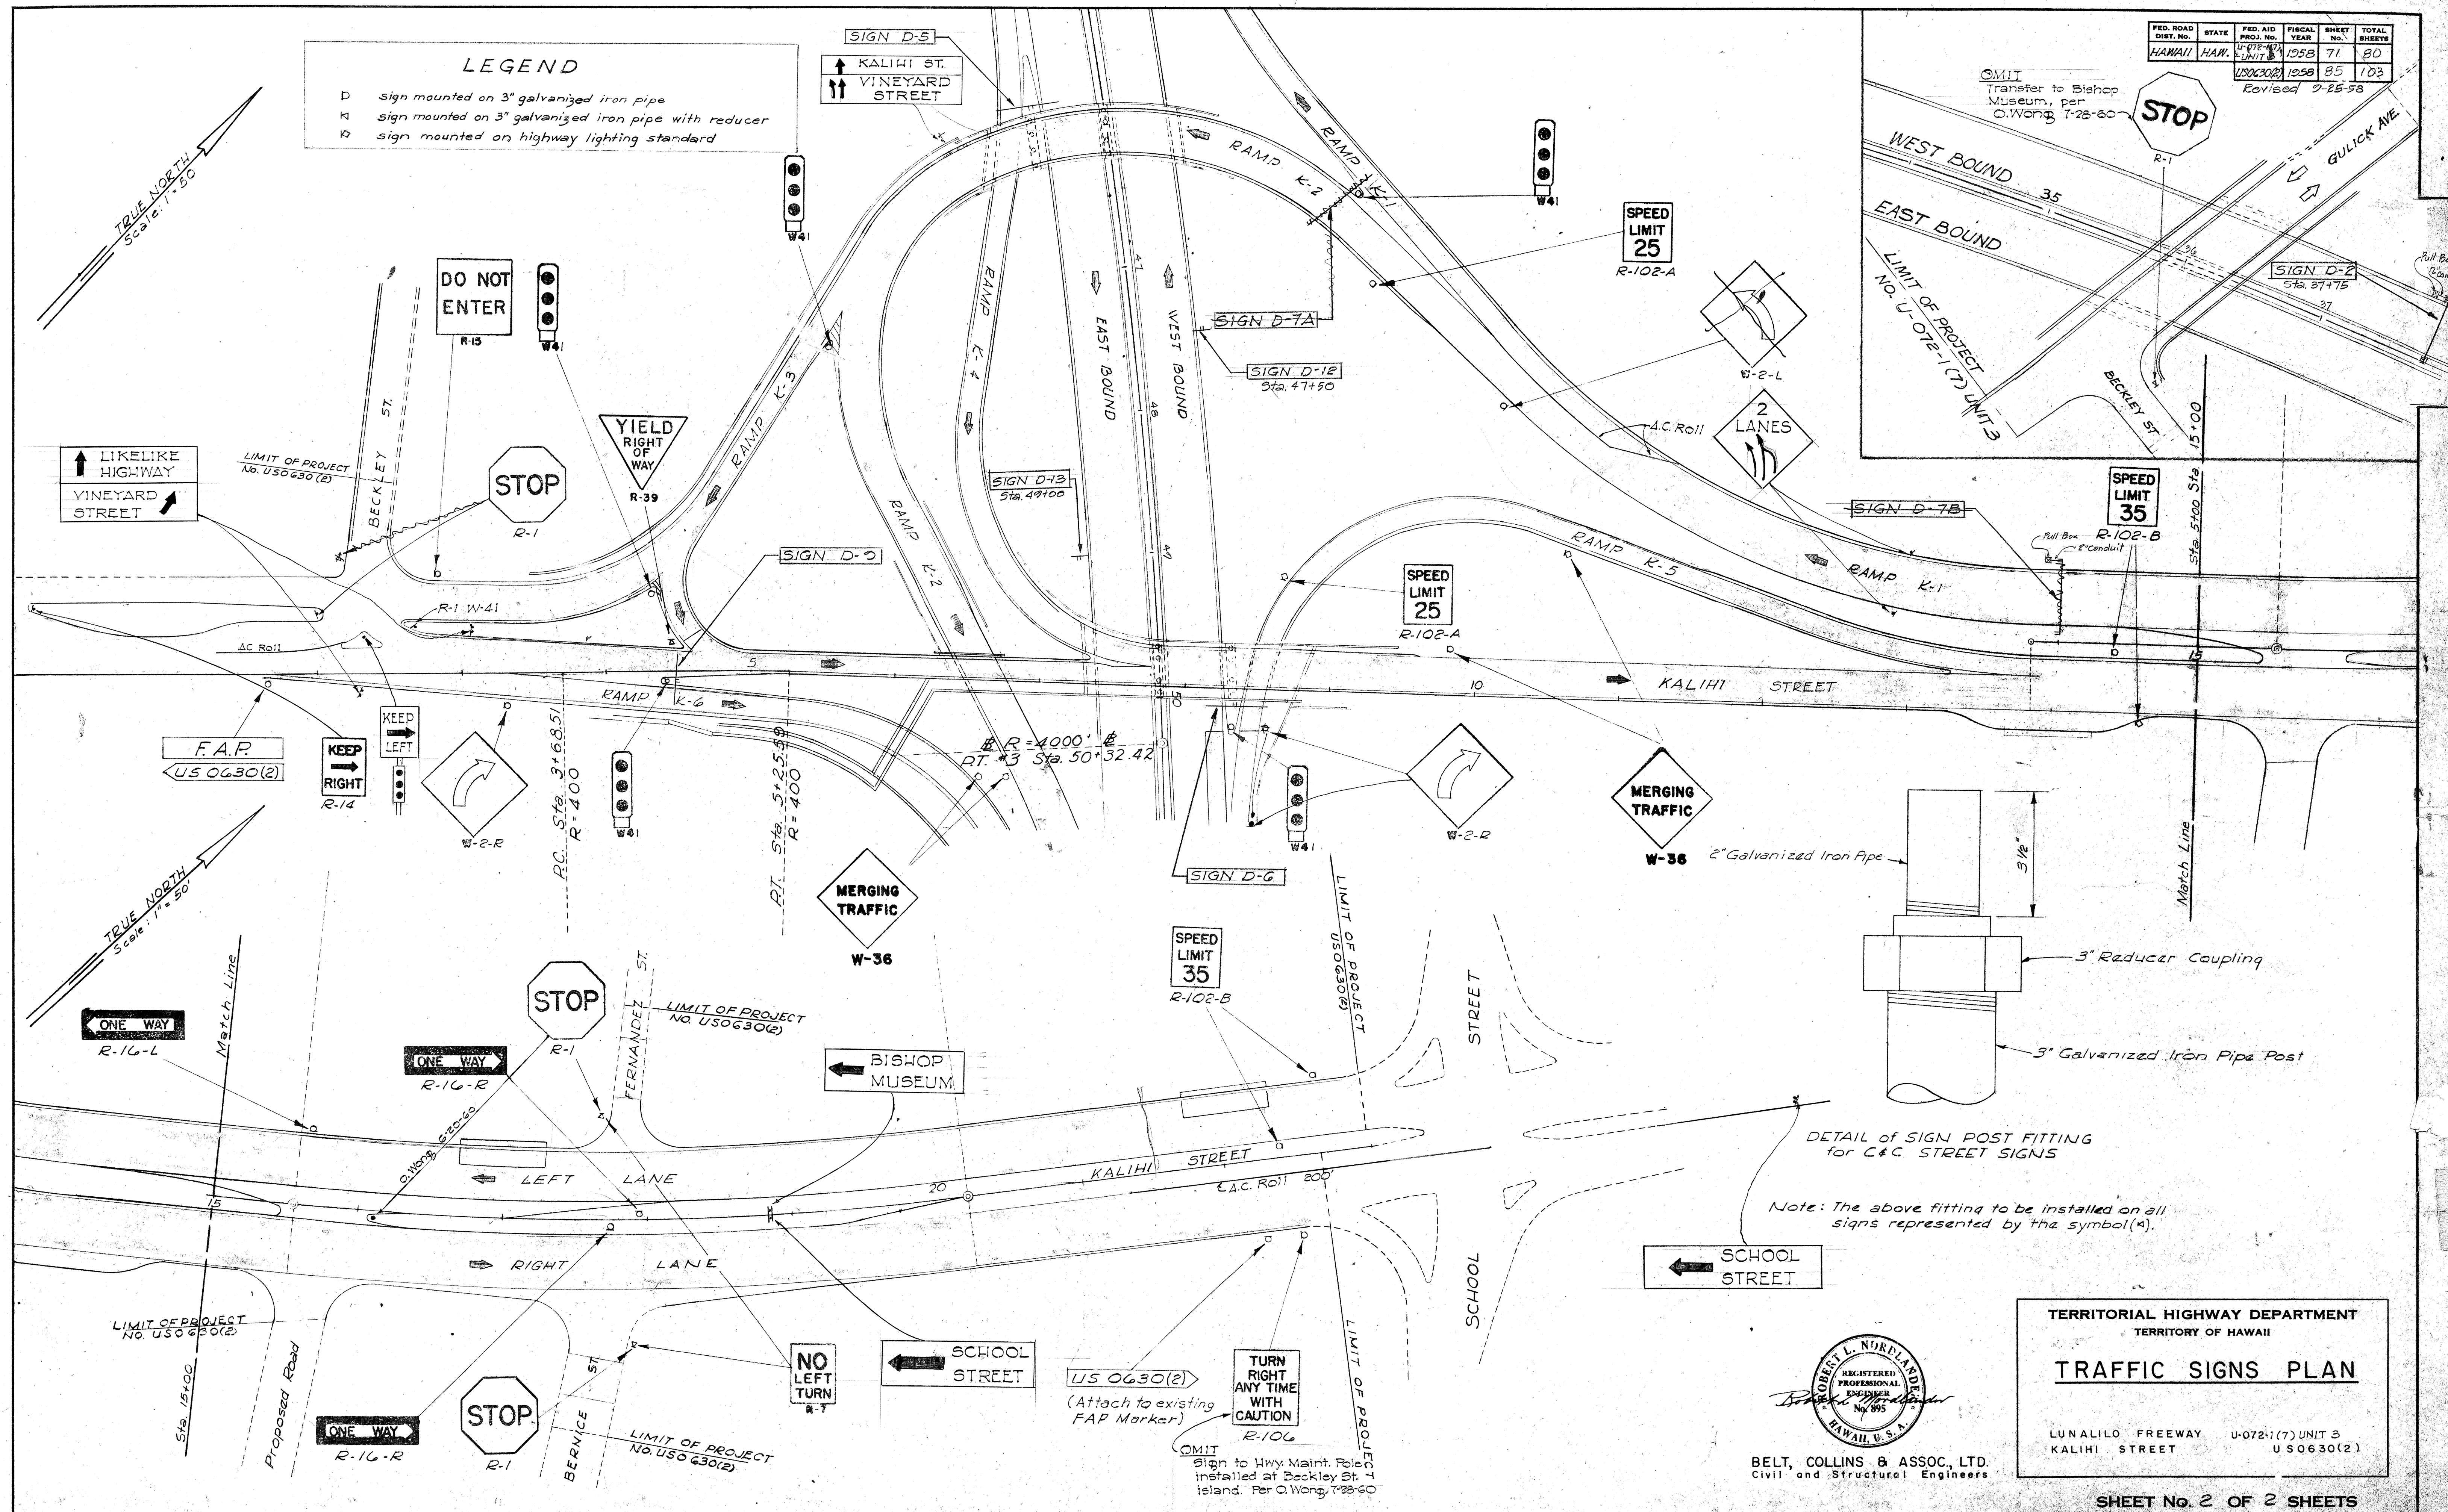

FED. ROAD DIST. NO.	STATE	FED. AID PROJ. NO.	FISCAL YEAR	SHEET NO.	TOTAL SHEETS
HAWAII	HAW.	US 0630(2)	1958	71	80
				85	103

OMIT
Transfer to Bishop
Museum, per
C. Wong, 7-28-60

Revised 7-25-58

STOP

SPEED LIMIT 25

SPEED LIMIT 35

SPEED LIMIT 25

SPEED LIMIT 35

FED. ROAD DIST. NO.	STATE	FED. AID PROJ. NO.	FISCAL YEAR	SHEET NO.	TOTAL SHEETS
HAWAII	HAW.	U-072-1(7)UNIT 3	1960	71 B	80
		US 630(2)	1960	85 B	103

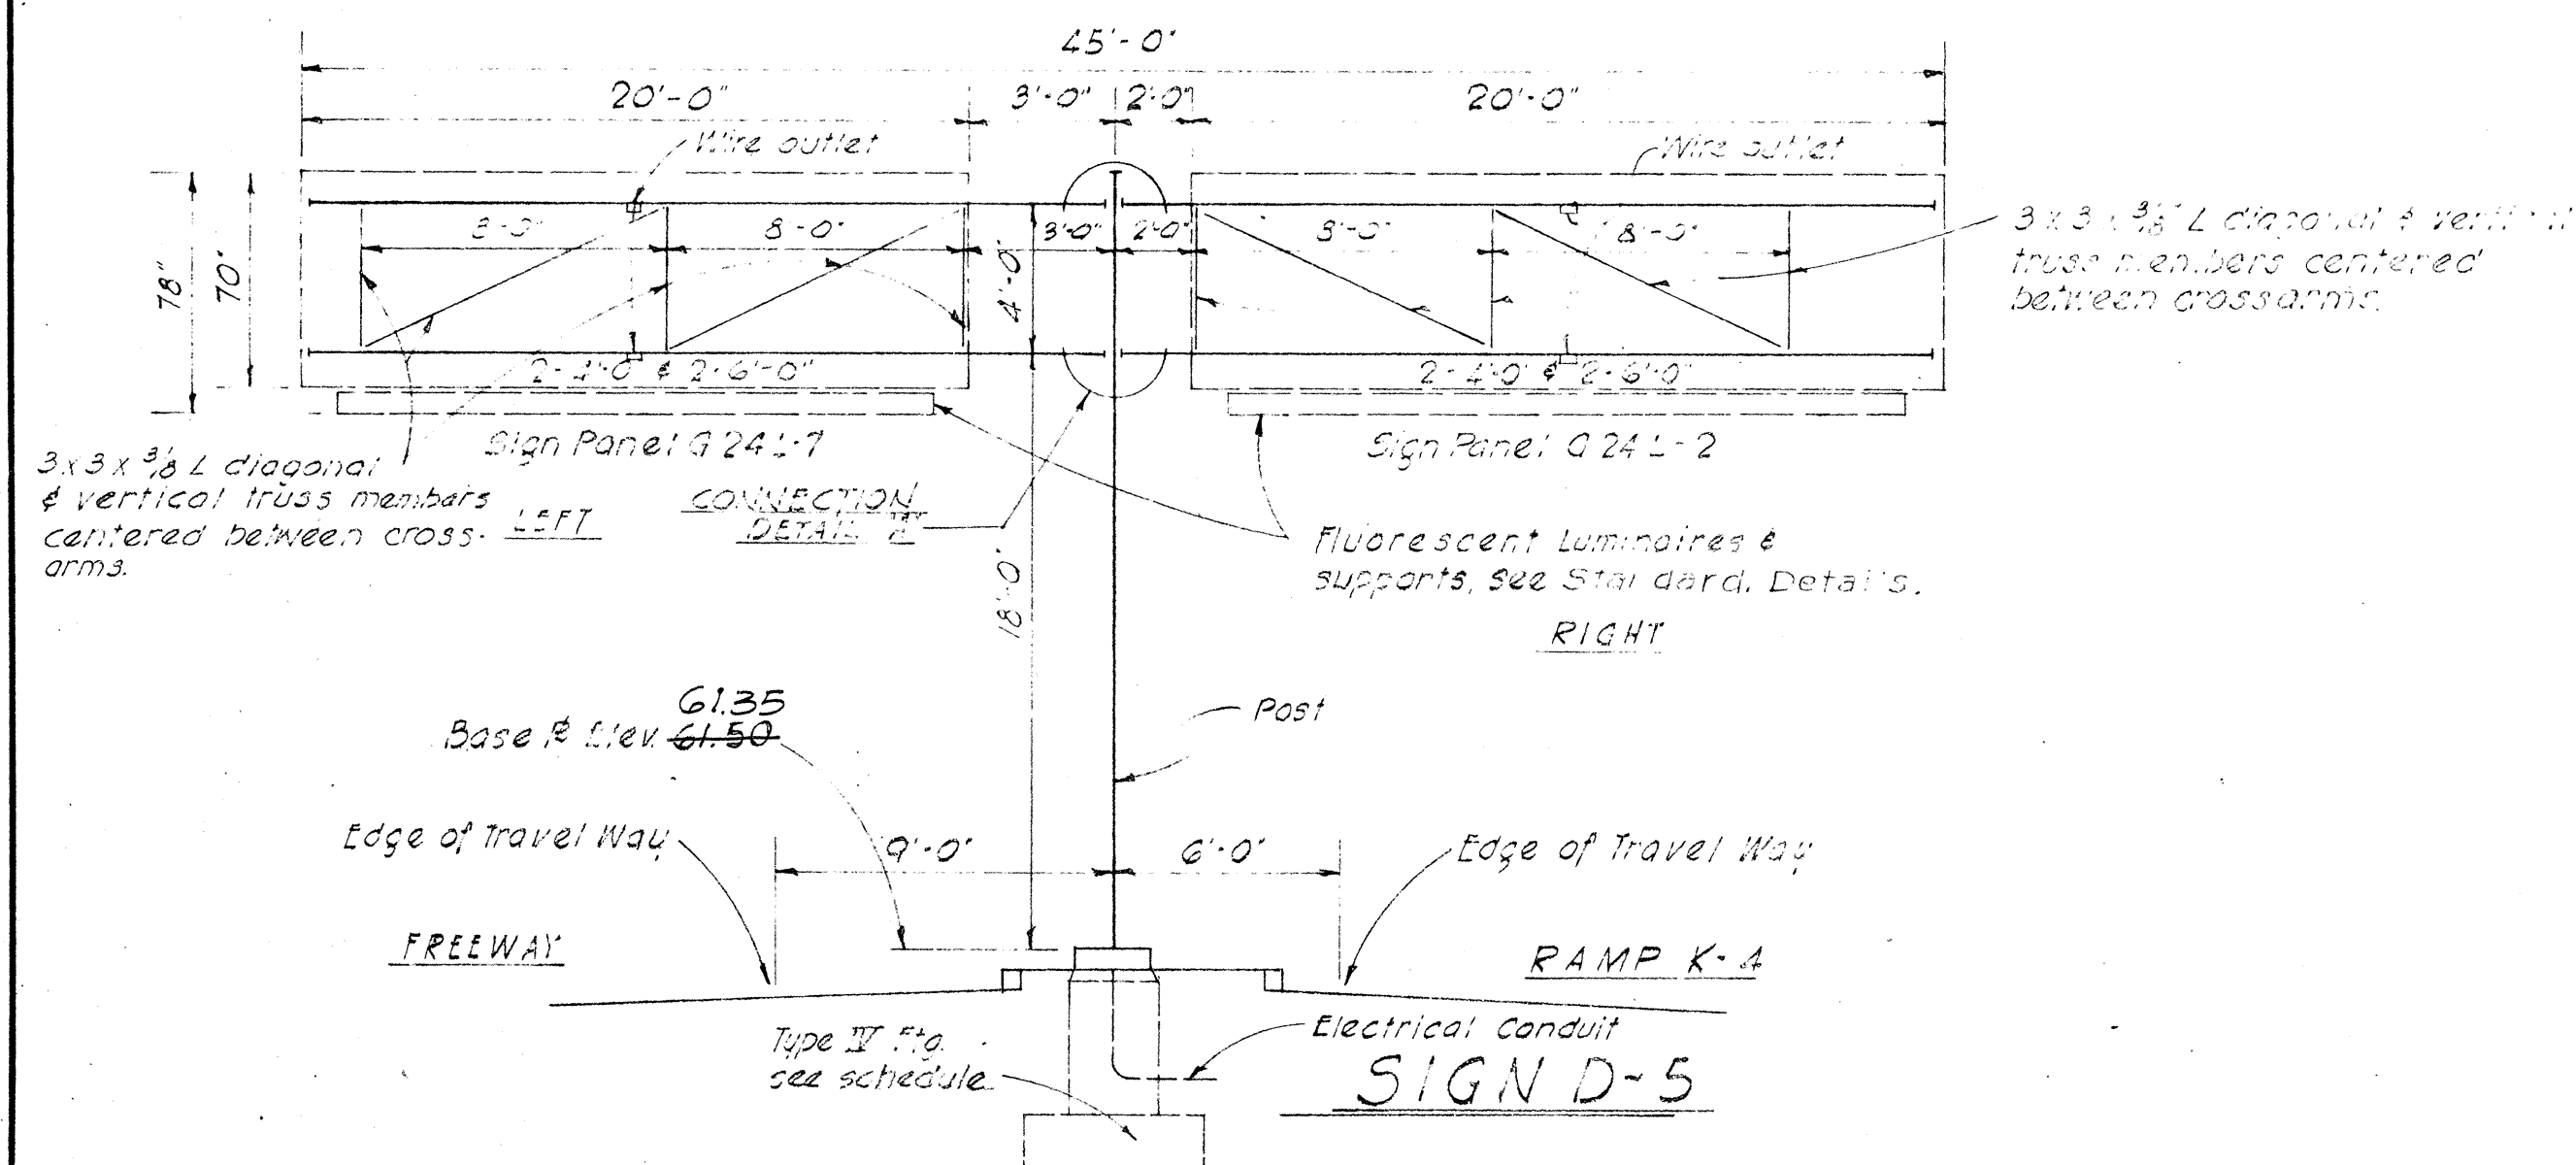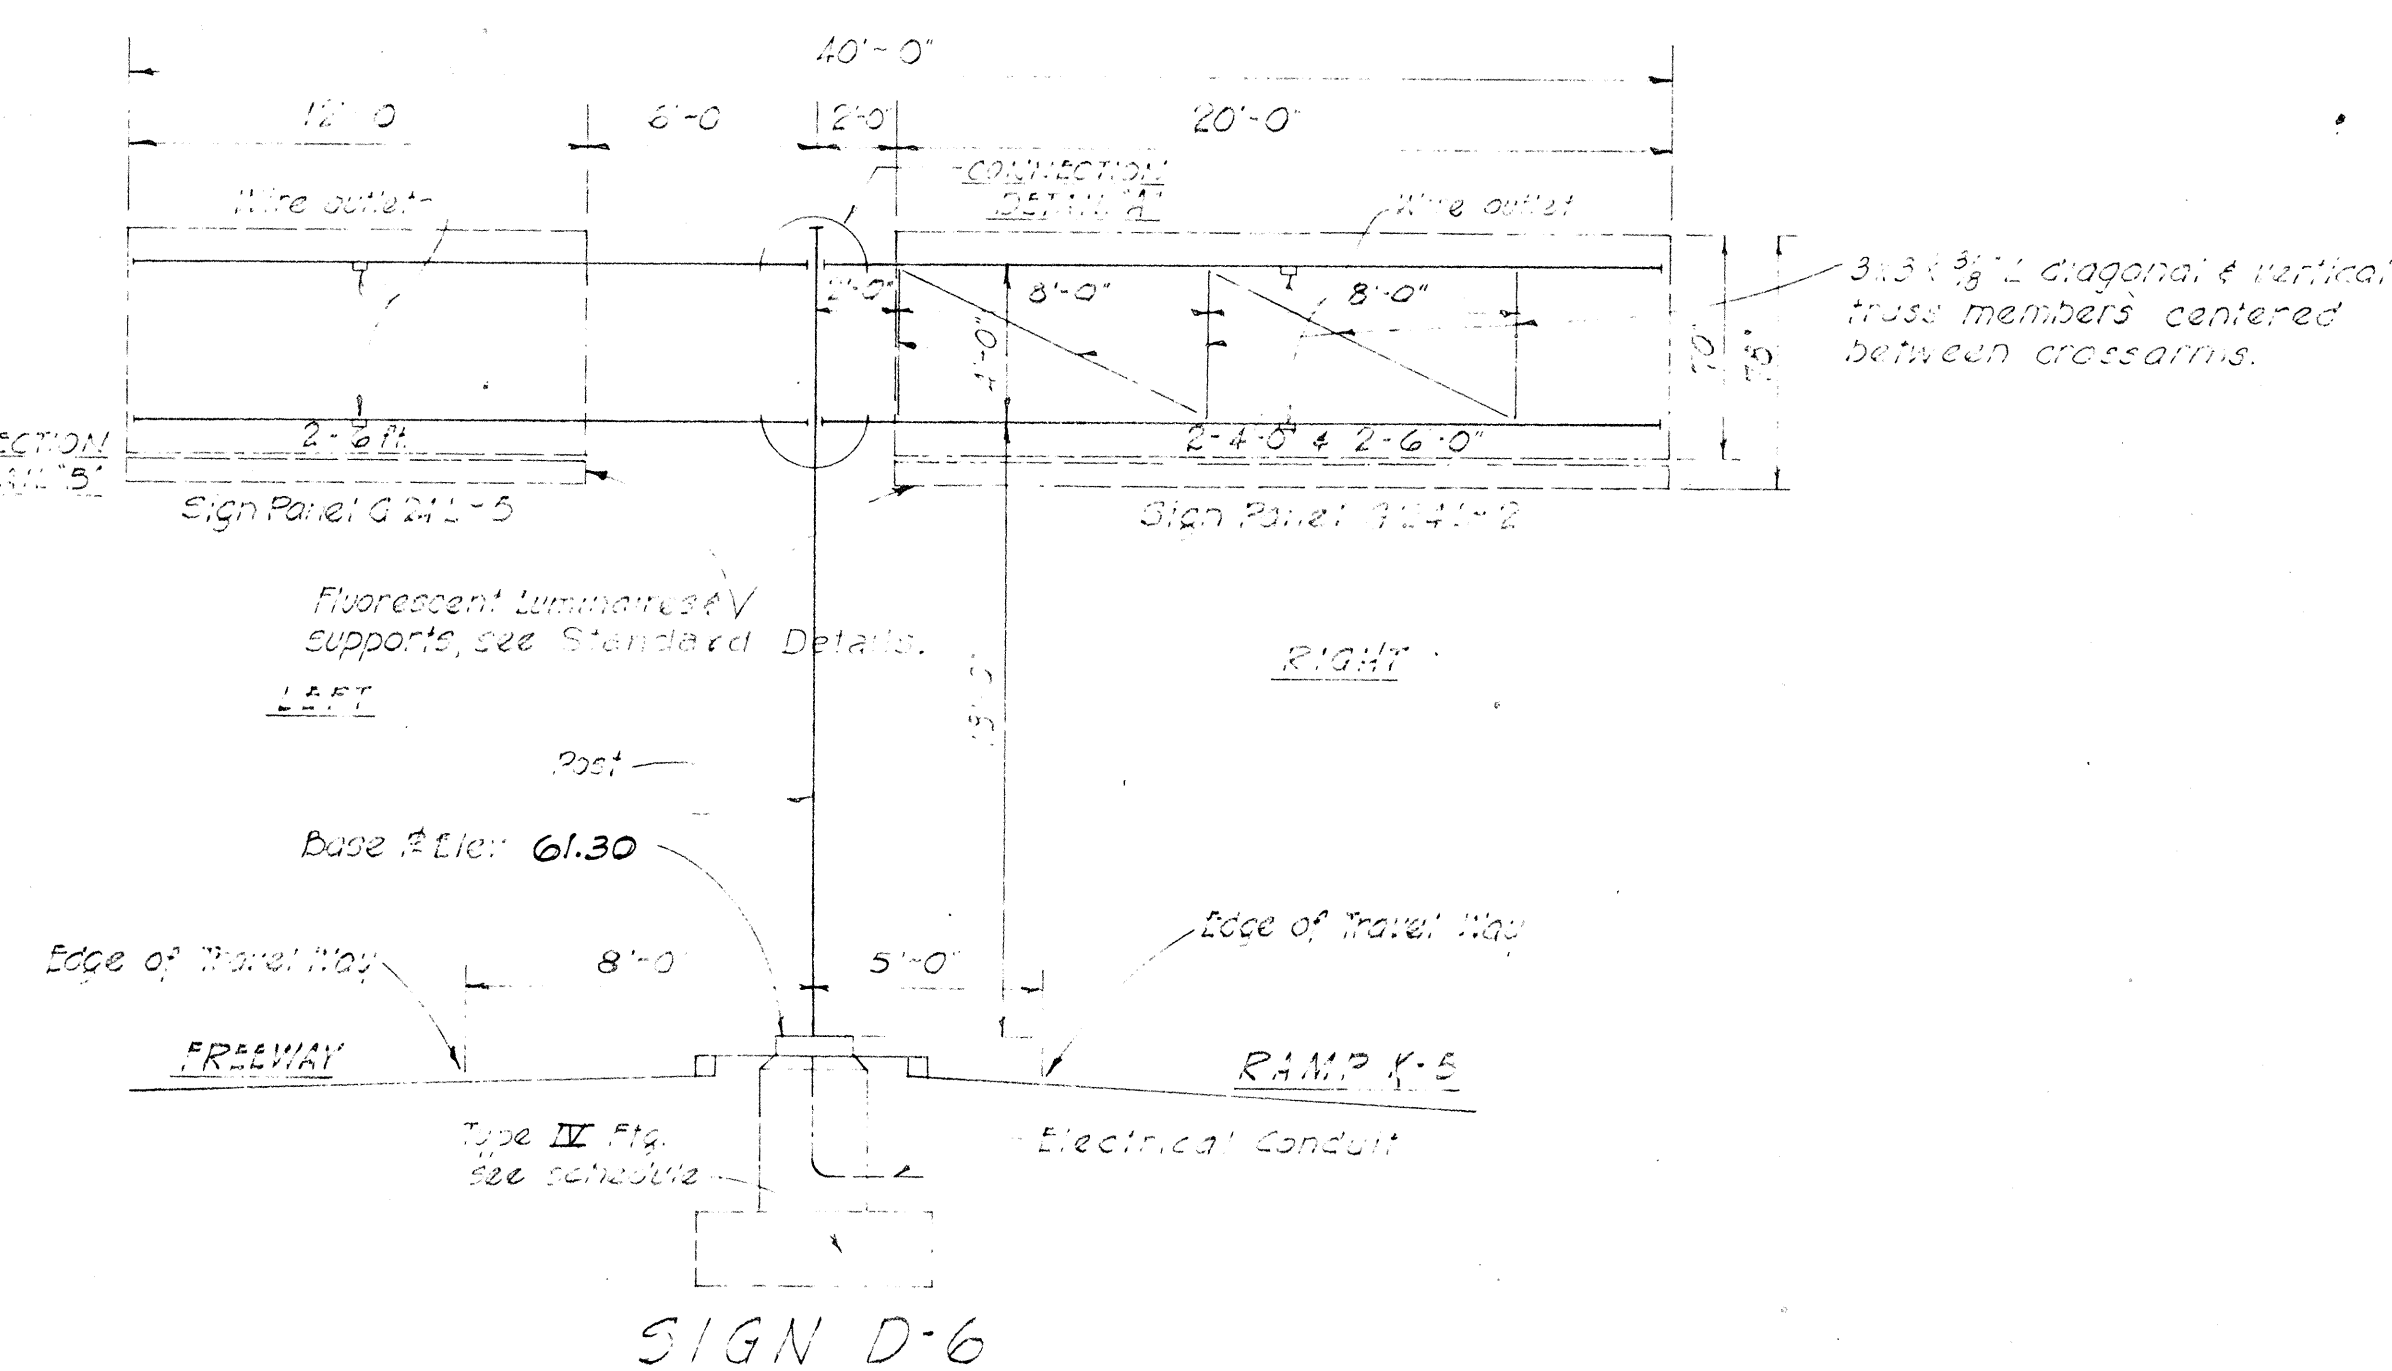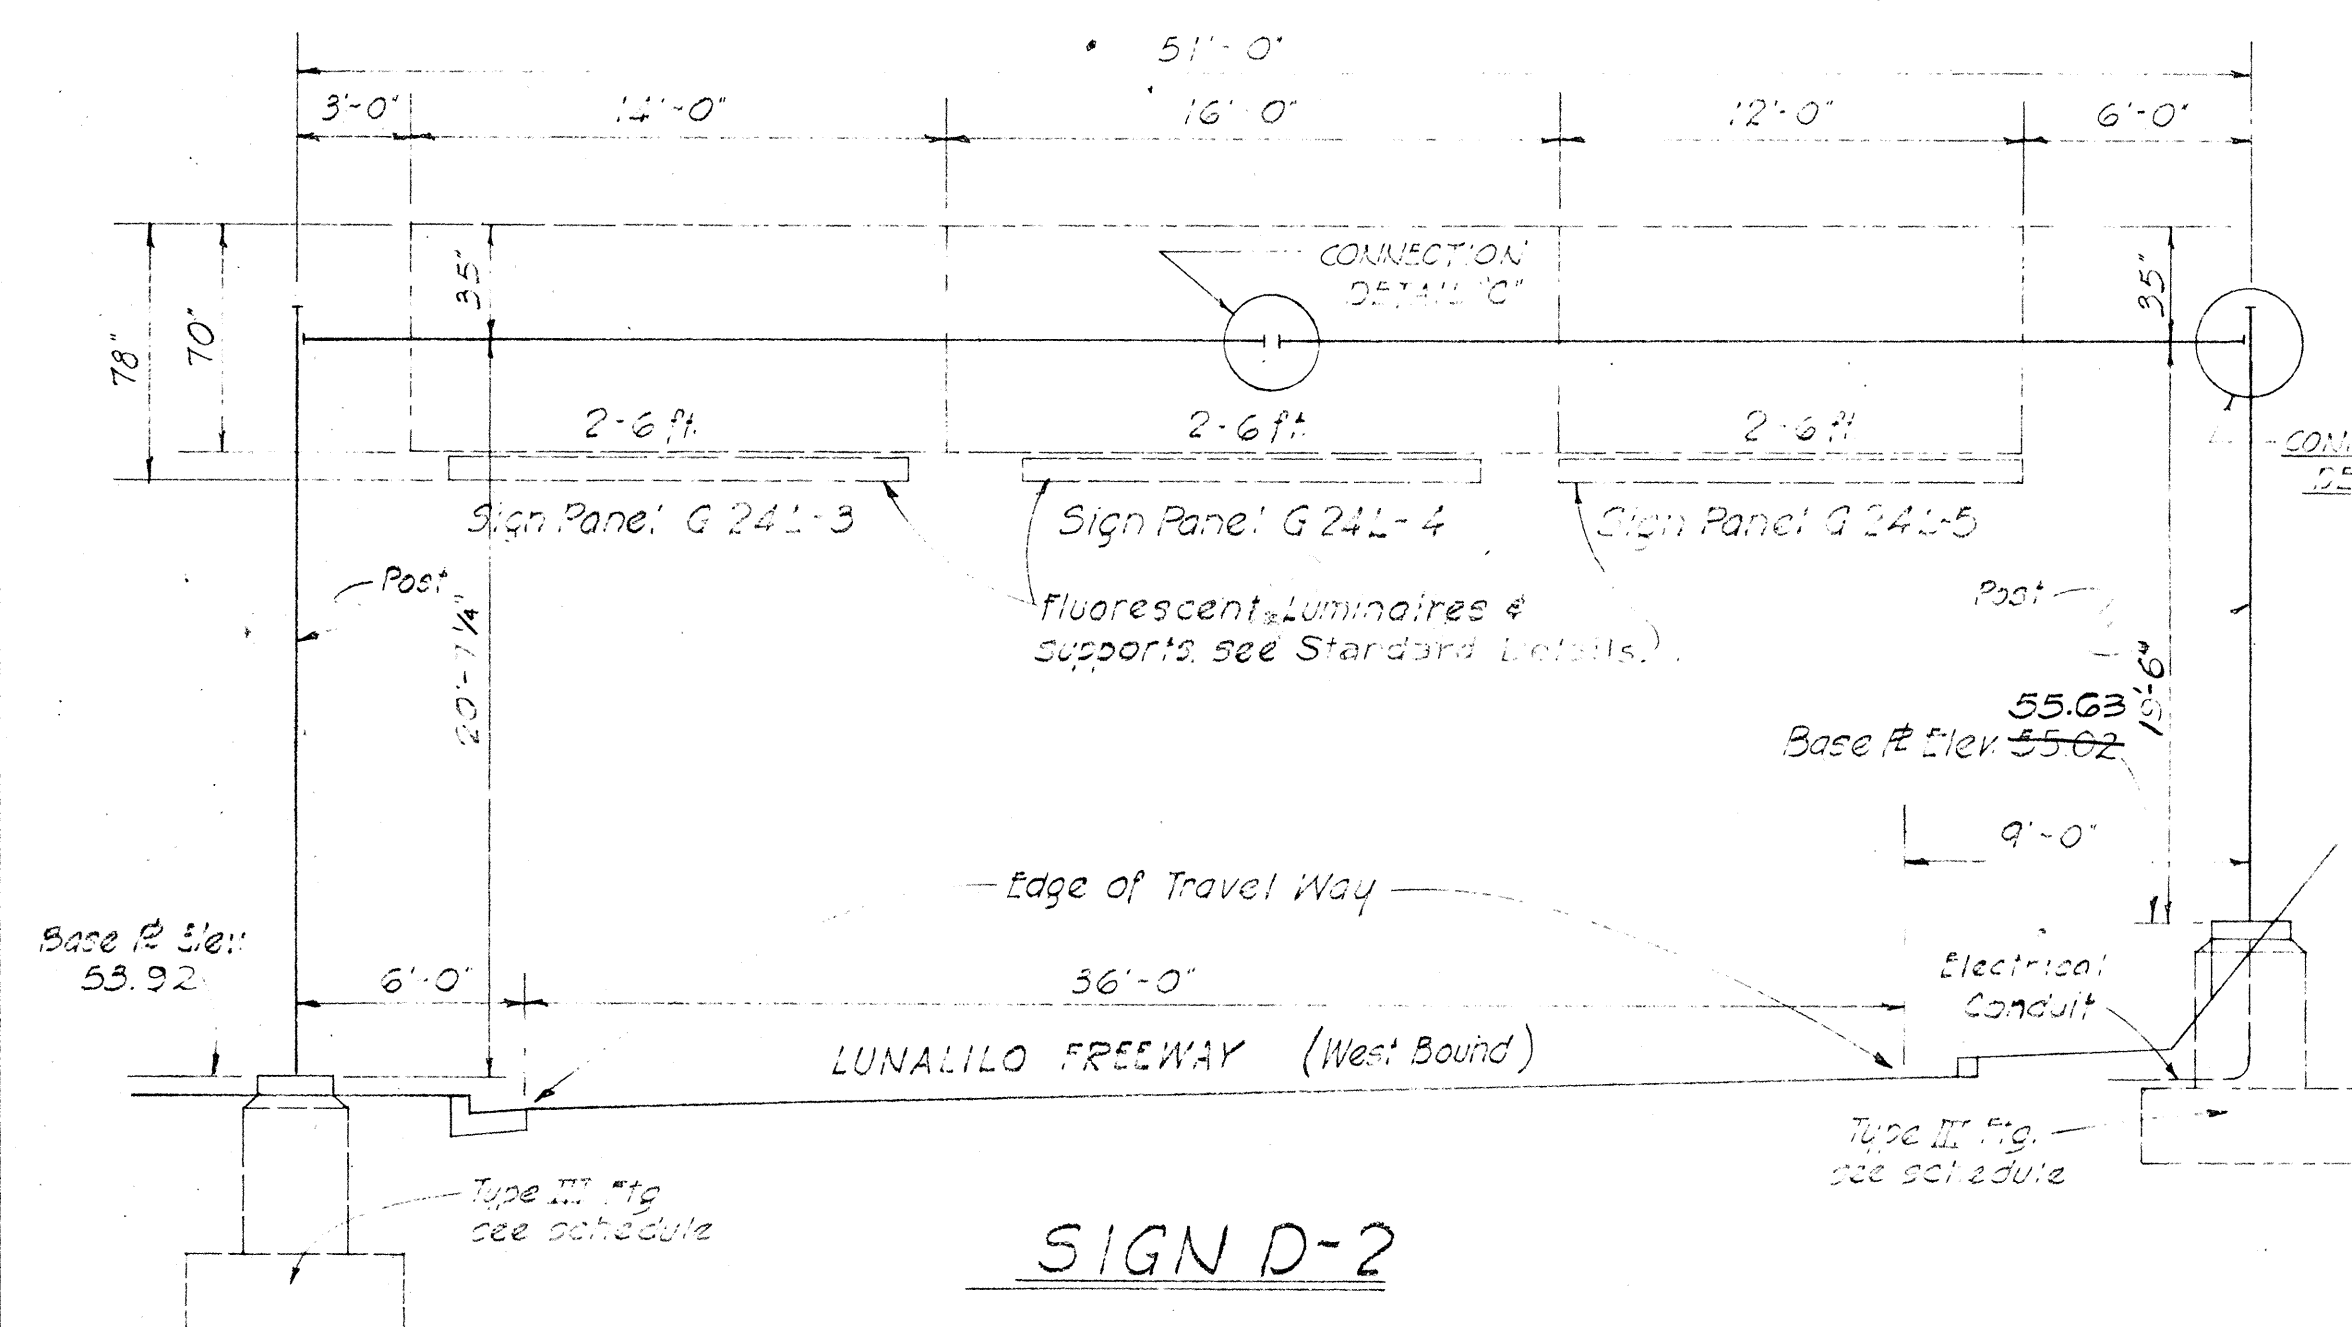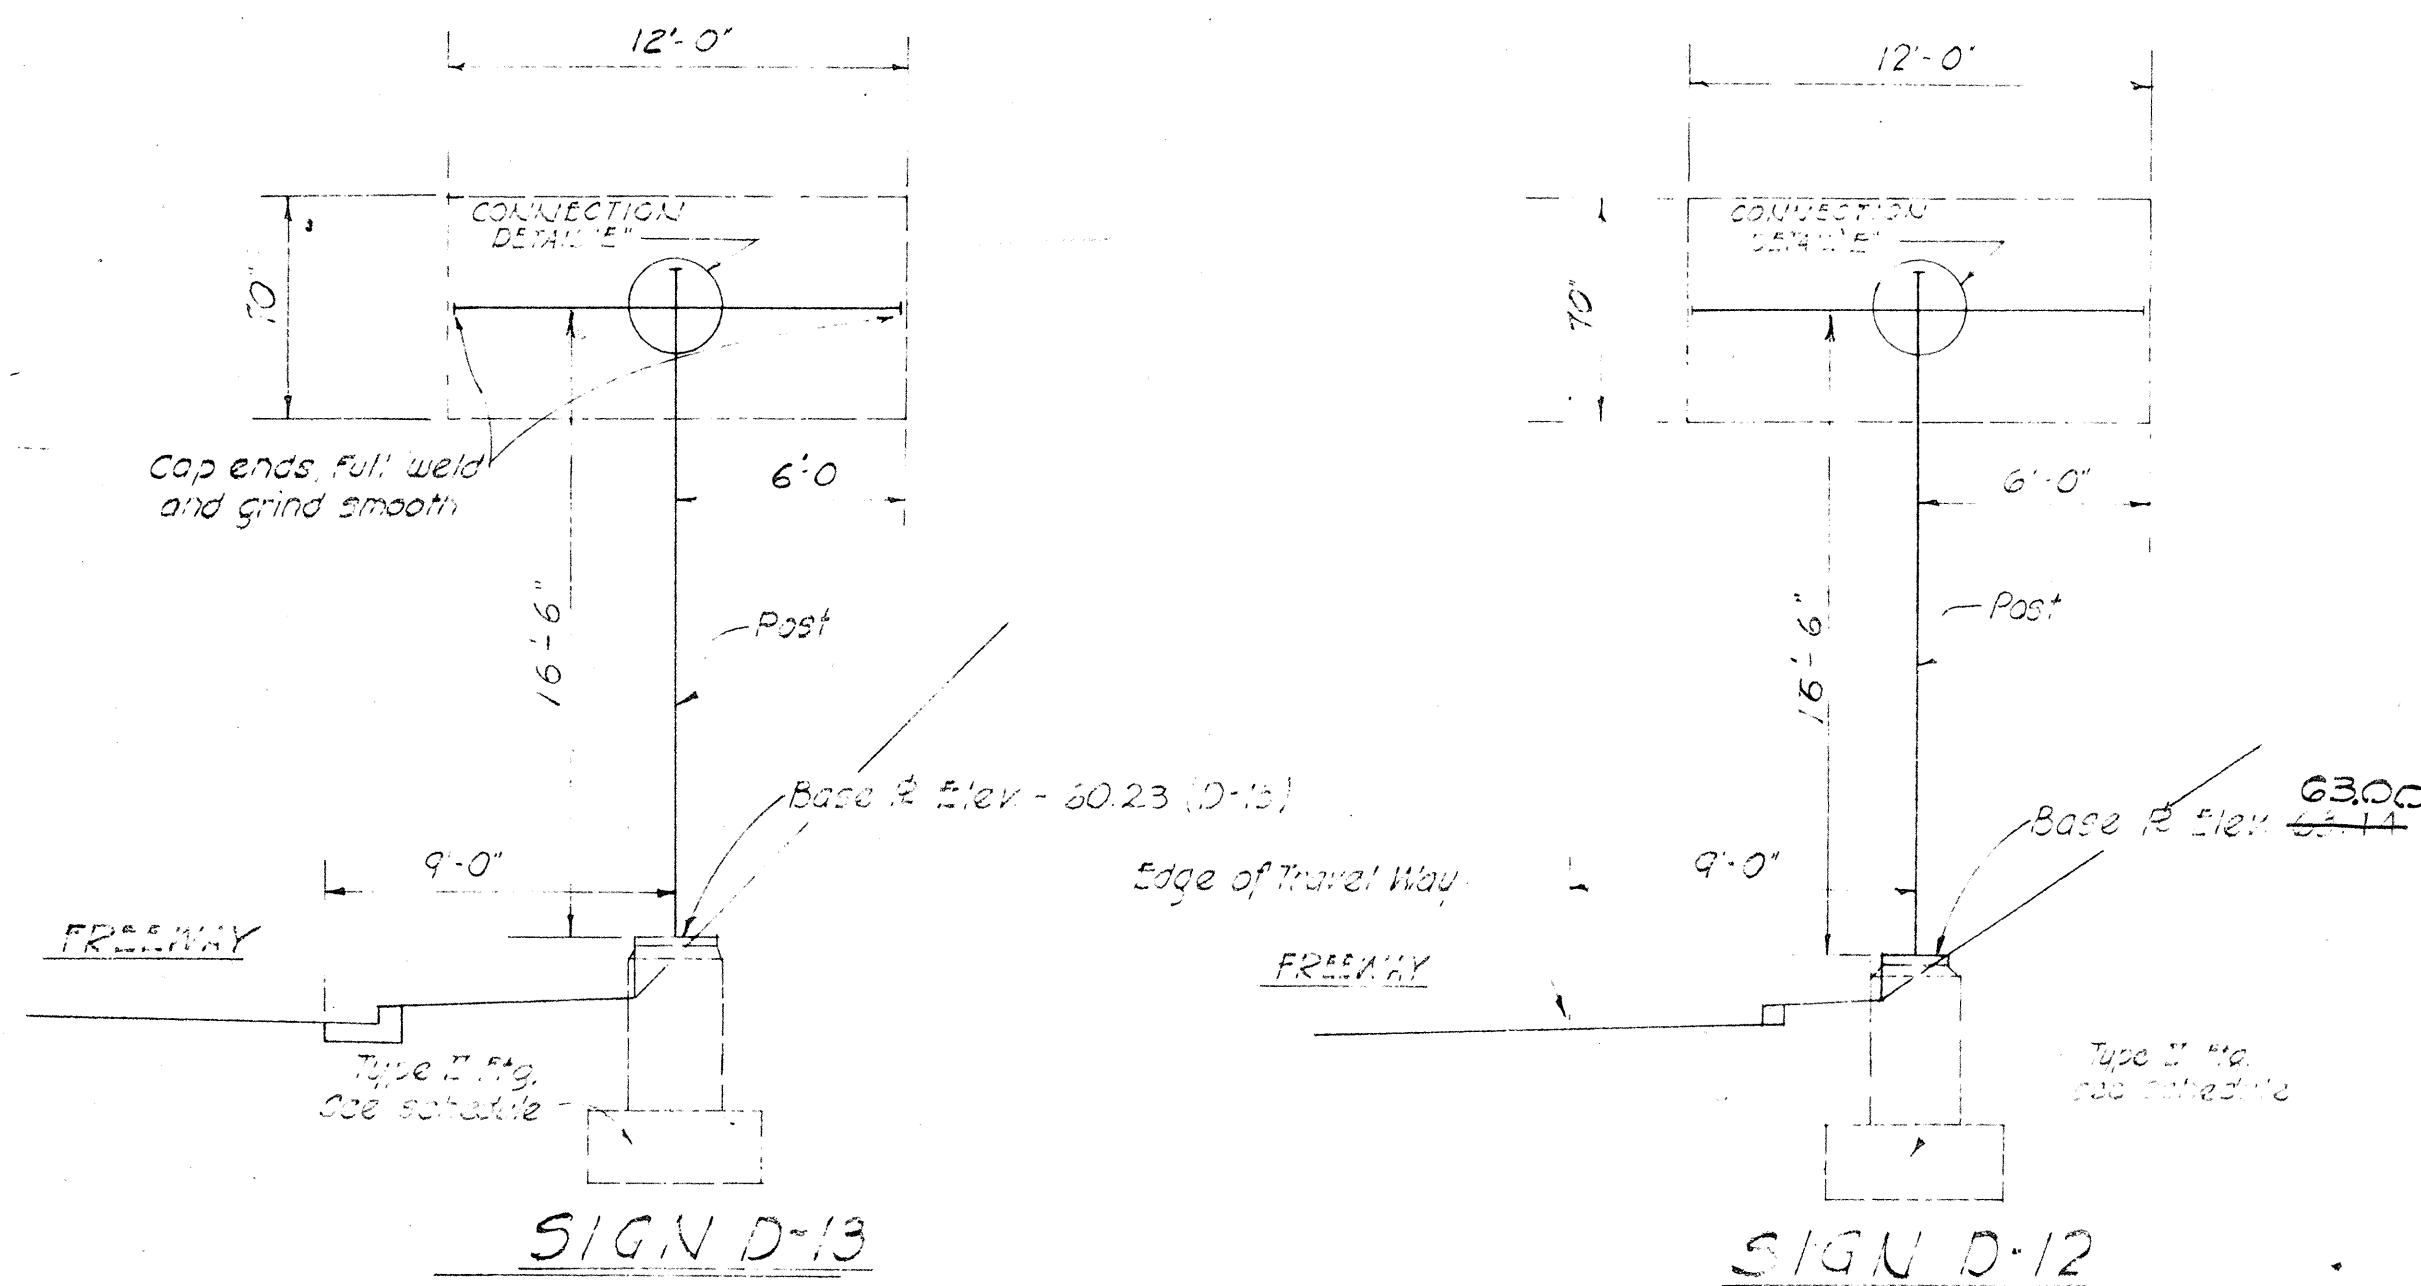

REV. JULY 29, 1960

TERRITORIAL HIGHWAY DEPARTMENT
TERRITORY OF HAWAII

EXPRESSWAY SIGNS
FRAME LAYOUT

LUNALILO FREEWAY U-072-1(7)UNIT 3
KALIHI STREET US 630(2)

SHEET NO. 2 OF 3 SHEETS

5 9 S 3 7 1 B 5 9 S 4 8 5 B

