


FED. ROAD DIST. NO.	STATE	FED. AID PROJ. NO.	FISCAL YEAR	SHEET NO.	TOTAL SHEETS
Hawaii	Haw.	5-06300	1958	28	23

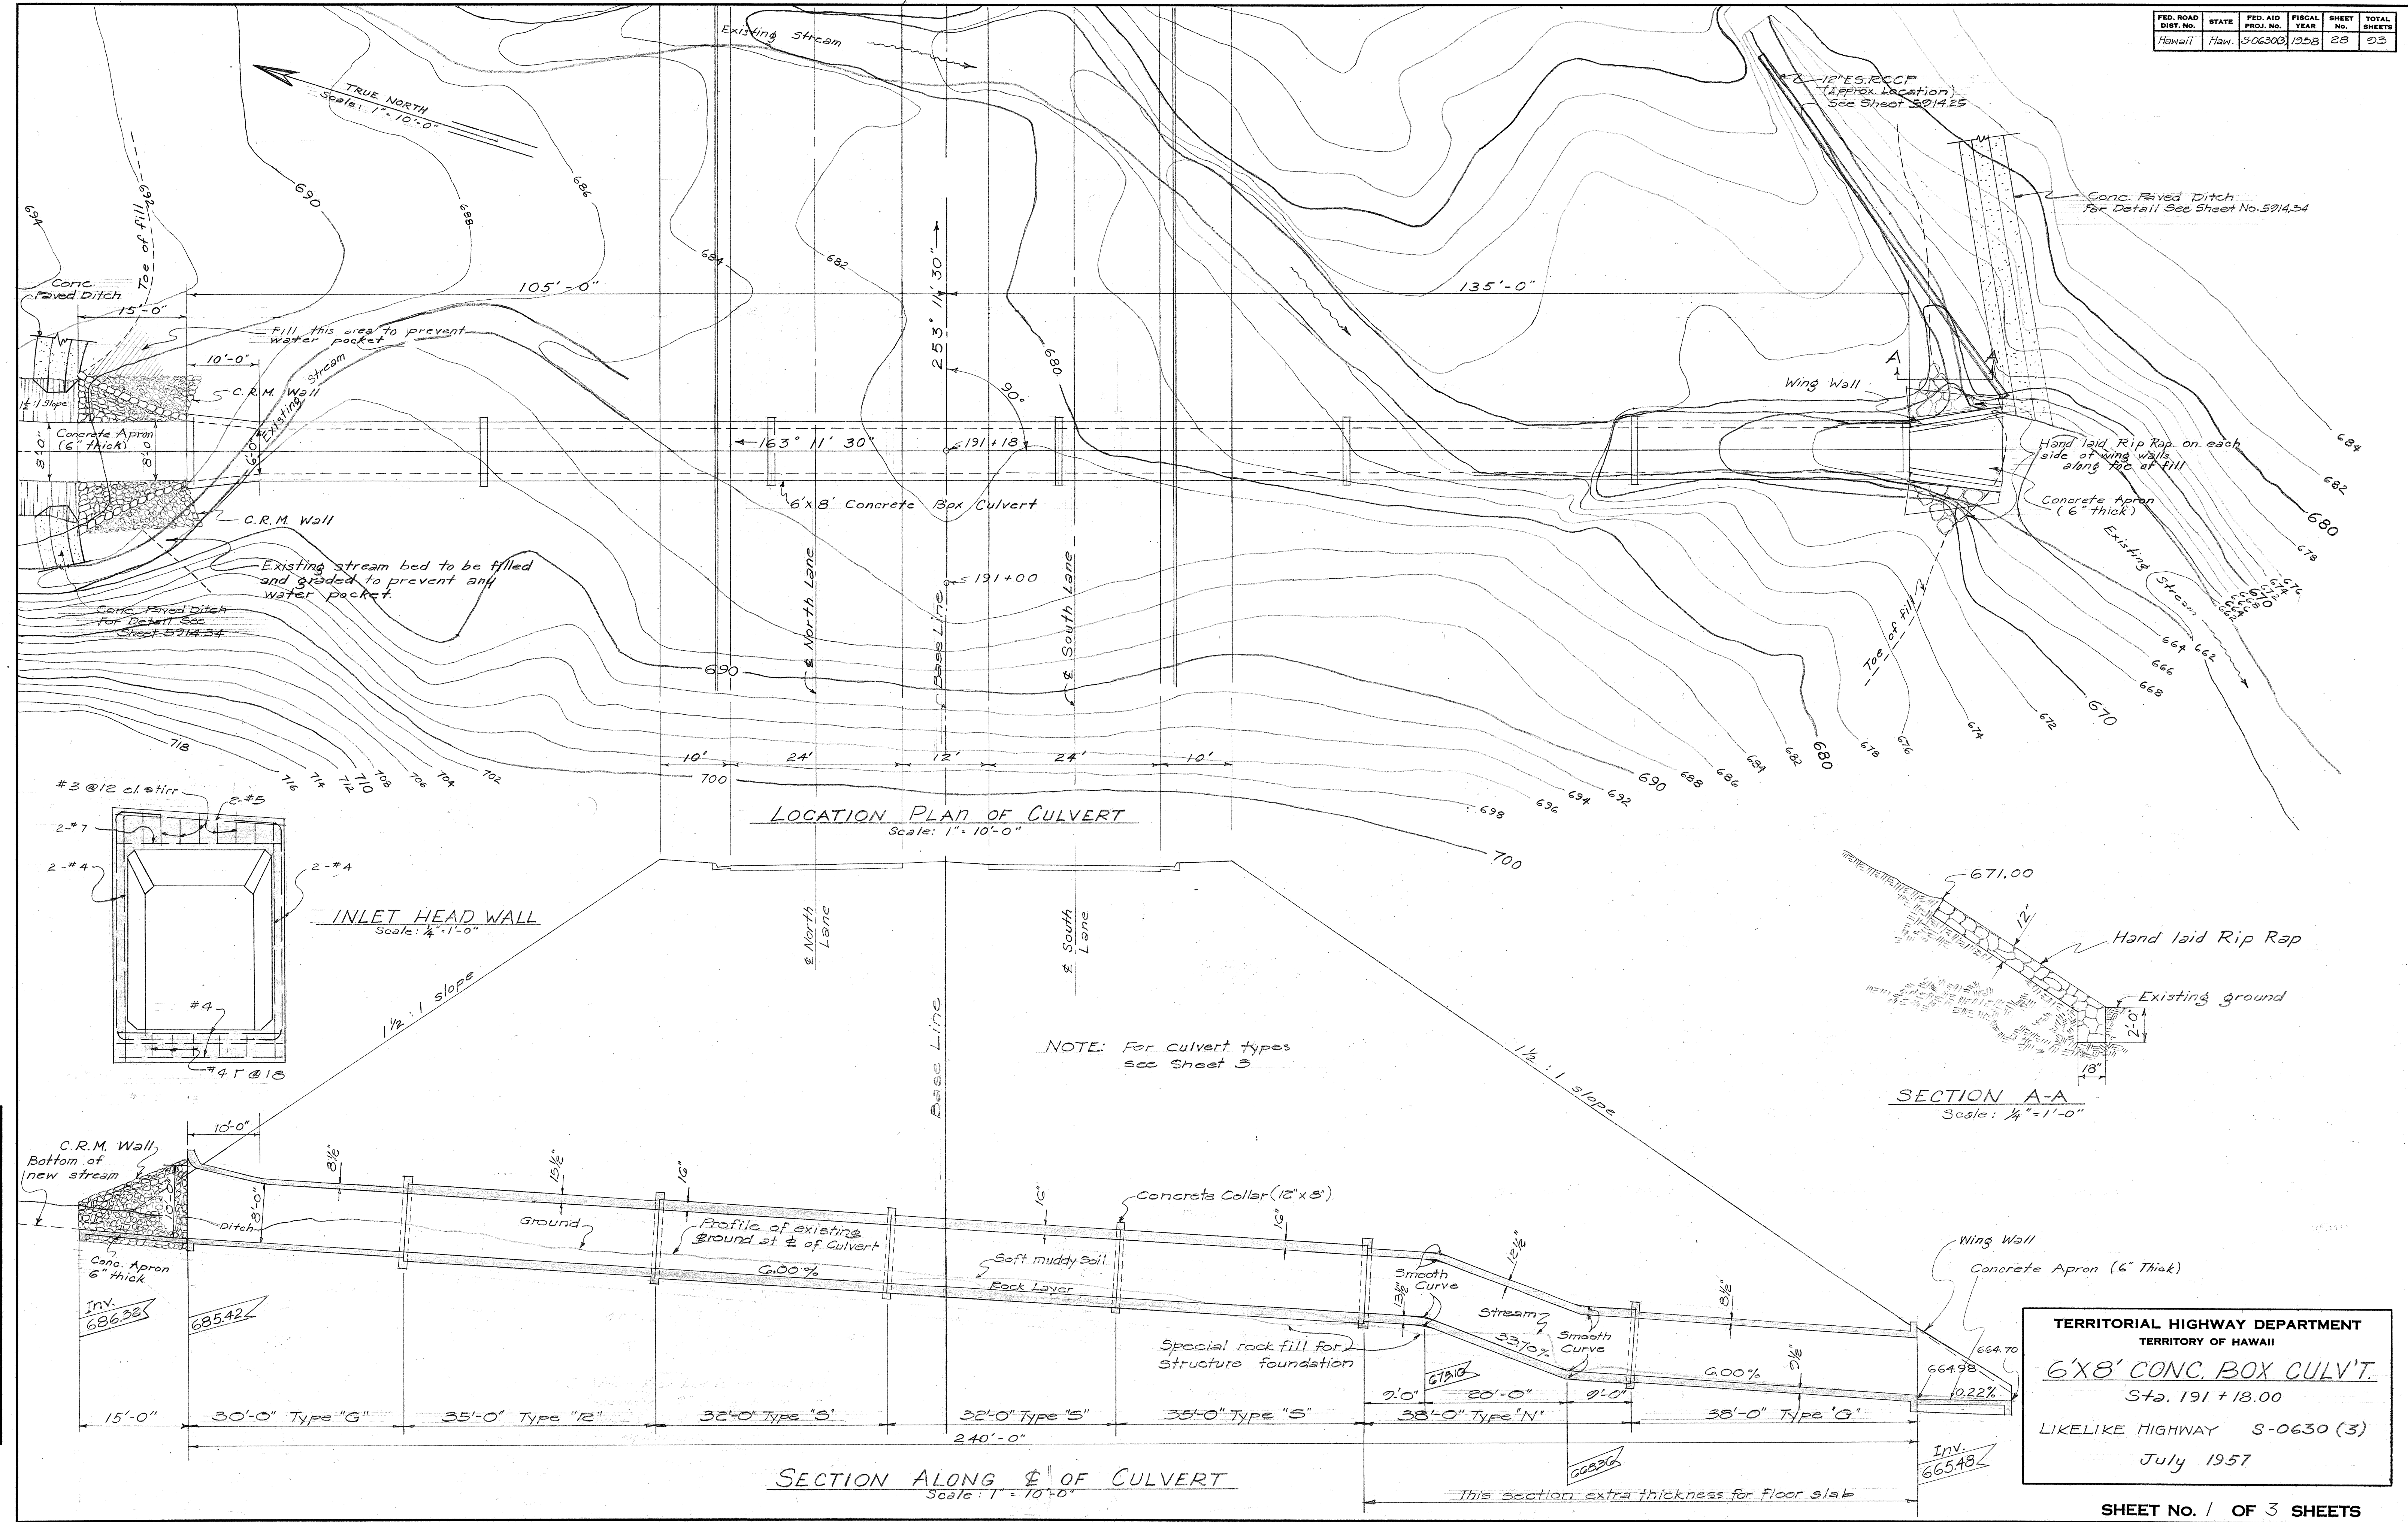


DESIGNED BY	DATE
DRAWN BY	
CHECKED BY	
NOTED BY	
QUANTITIES CHECKED BY	
NO.	

FED. ROAD DIST. NO.	STATE	FED. AID PROJ. NO.	FISCAL YEAR	SHEET NO.	TOTAL SHEETS
Hawaii	Haw	5-06303	1958	23	23

ESTIMATED QUANTITIES
 Class A-1 Conc. --- Lump Sum
 Reinf. Steel --- Lump Sum
 Struct. Exc. --- 320 C.Y.
 Channel Exc. --- 50 C.Y.
 C.R.M. --- 40 C.Y.
 Rip Rap --- 6 C.Y.
 Special Rock Fill --- 15 C.Y.
 for Struct. foundation

1 Layer 55# comp. roofing
 DETAIL "H"
 1/2" = 1'

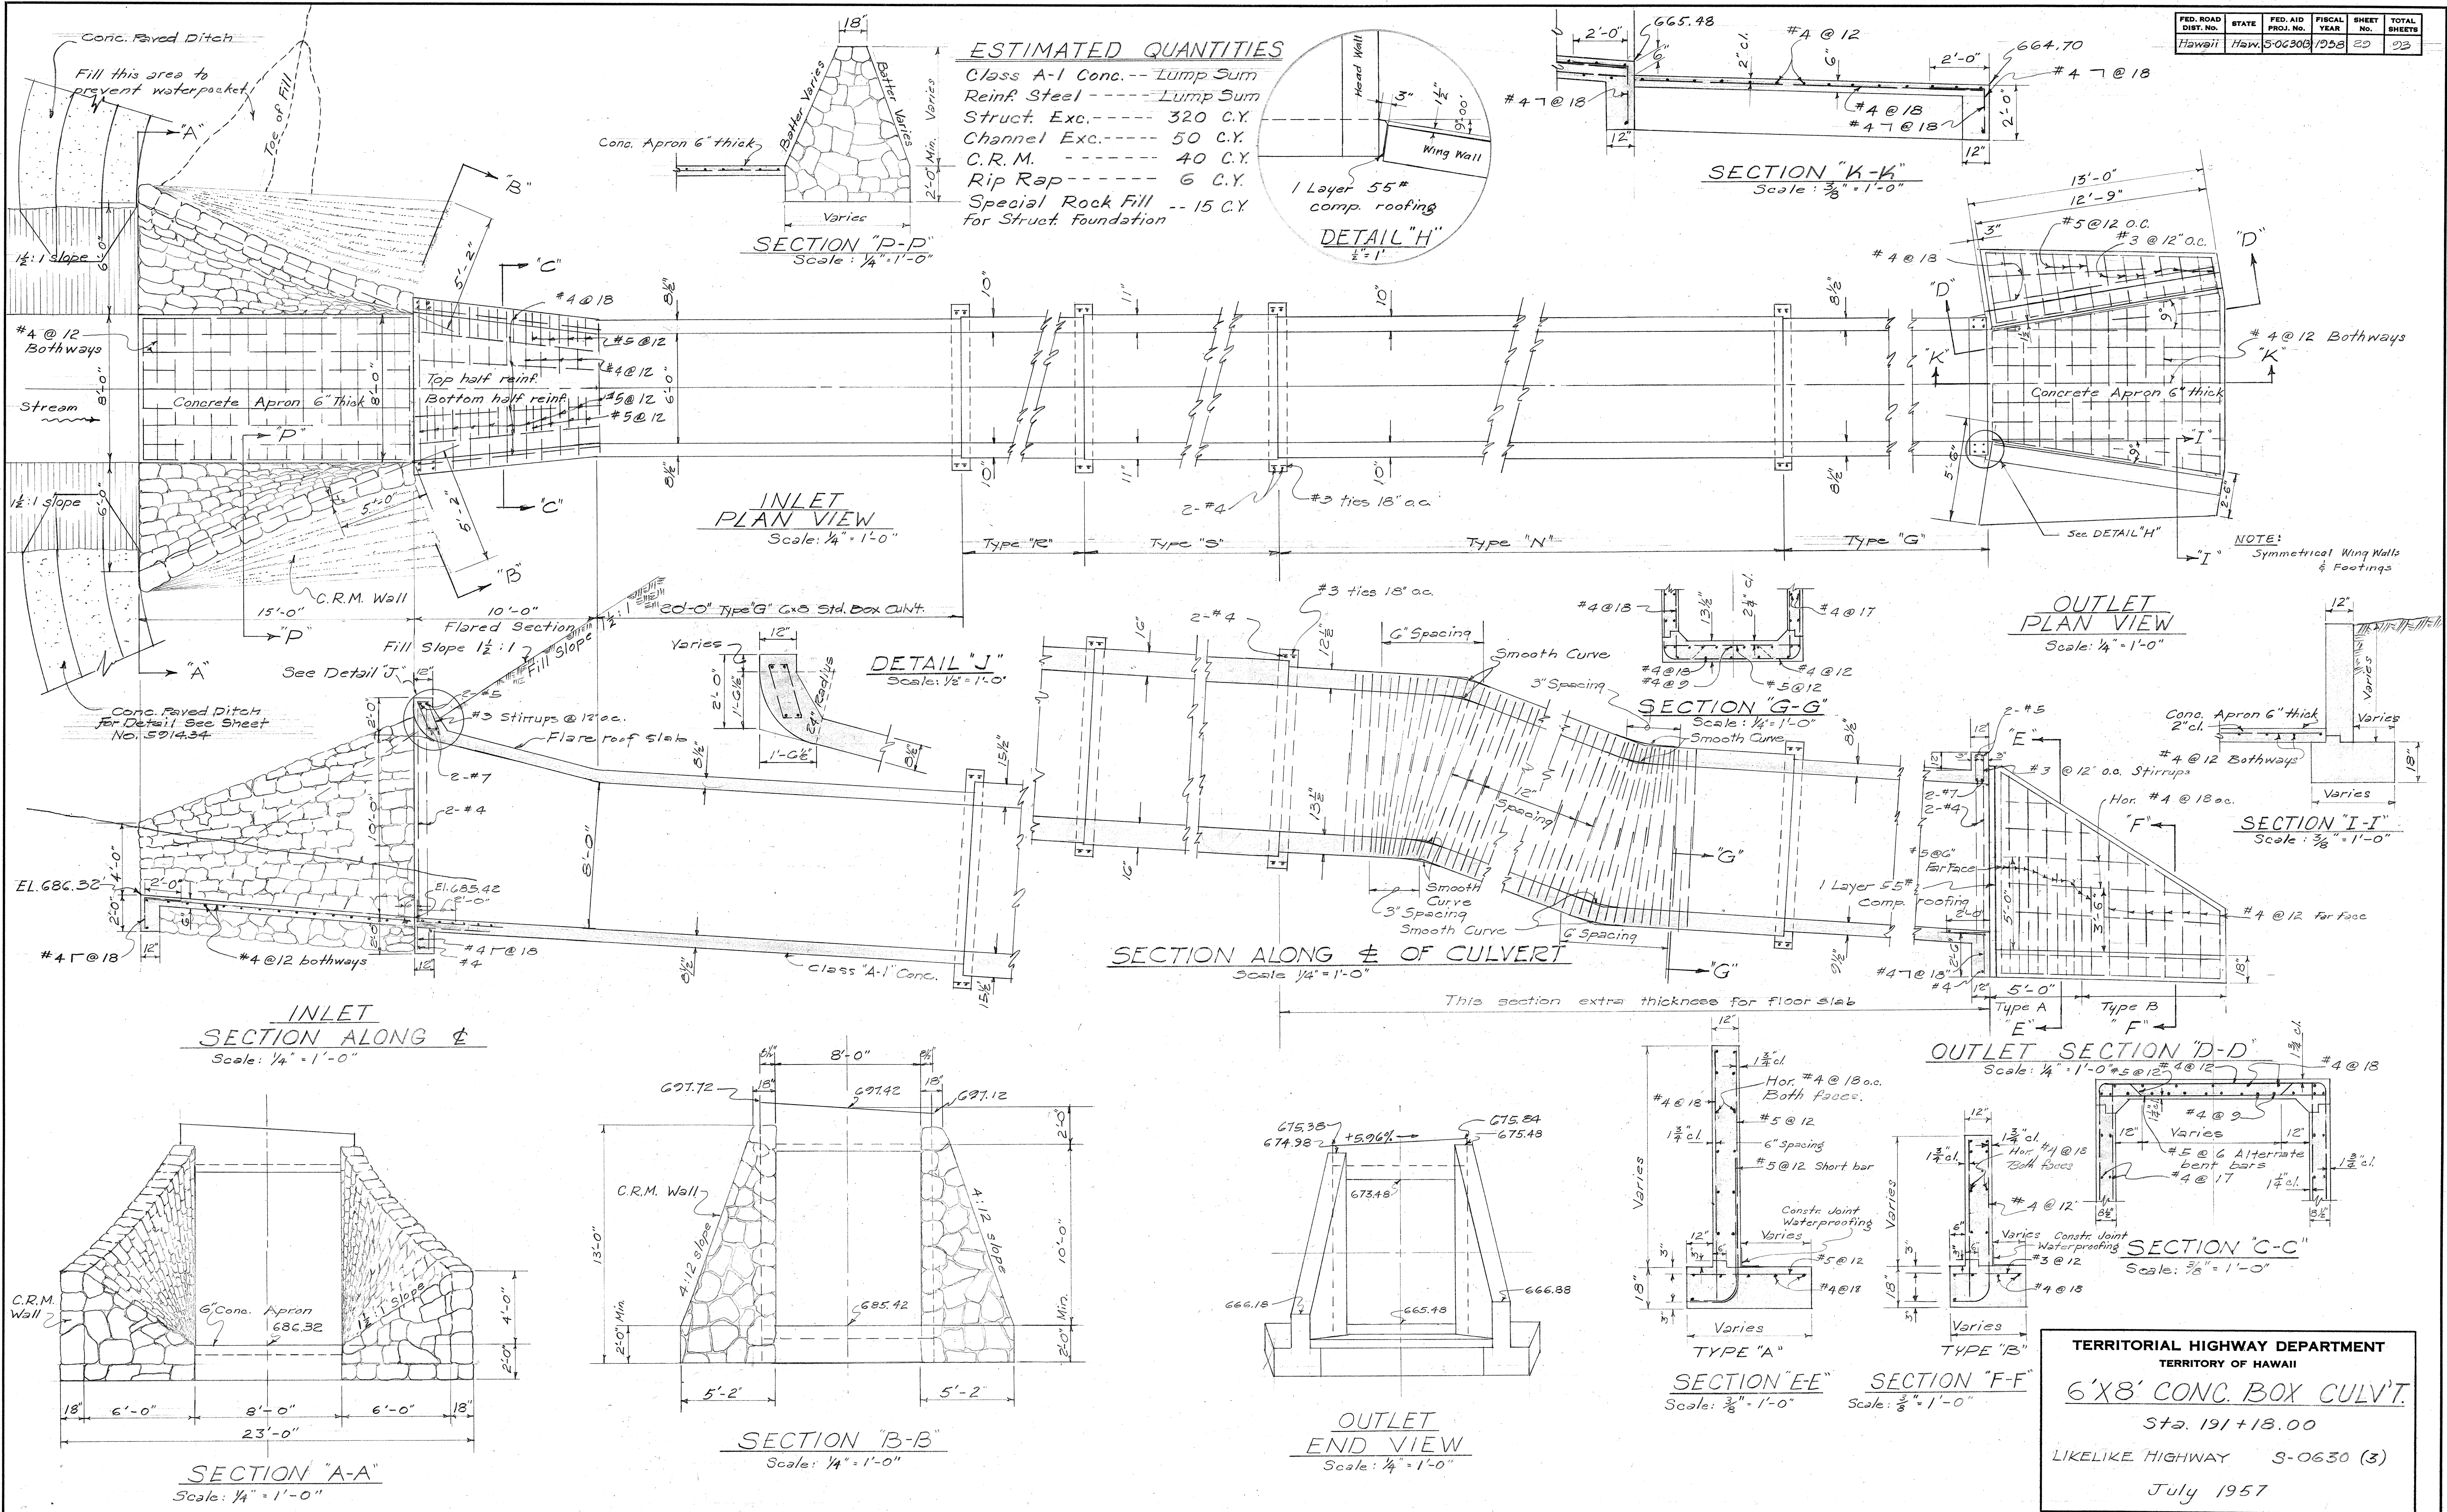

SURVEY PLOTTED BY	DATE
DESIGNED BY	
DRAWN BY	
CHECKED BY	
QUANTITIES CHECKED BY	
NOTE BOOK NO.	

TERRITORIAL HIGHWAY DEPARTMENT
 TERRITORY OF HAWAII
6'X8' CONC. BOX CULV'T.
 Sta. 191+18.00
 LIKELIKE HIGHWAY S-0630 (3)
 July 1957

FED. ROAD DIST. NO.	STATE	FED. AID PROJ. NO.	FISCAL YEAR	SHEET NO.	TOTAL SHEETS
HAWAII	HAW.	50620	1958	30	33

