

INDEX TO DRAWINGS		
SHEET NO.	DESCRIPTION	COMB. NO.
1	TITLE SHEET	128
2 - 3	TYPICAL SECTION	129-130
4 - 9	PLAN AND PROFILE	131-136
10 - 12	SOIL PROFILE	137-139
13	CONNECTION	140
16 - 19	PIPE CULVERT DETAILS	143-146
20 - 22	STREAM REALIGNMENT	147-149
23 - 25	BACKFILLING WATER TUNNEL DETAIL OF SEEPAGE DRAIN	150-152
26 - 27	RELOCATION OF 6" TRANSITE WATER LINE	153-154
28 - 31	CONCRETE BOX CULVERTS	155-158
32	CRM RETAINING WALL	159

INDEX TO DRAWINGS		
SHT. NO.	DESCRIPTION	COMB. NO.
33	DETAIL OF DRAINAGE DITCHES	161
34	MISCELLANEOUS DETAILS	162
35-93	CROSS SECTIONS	169-221
32-A	RELOCATING WATER TANKS AND WATER LINES	160
14 & 15	OVERPASS AT STA. 158 + 89	141-142


TERRITORY OF HAWAII
TERRITORIAL HIGHWAY DEPARTMENT
HONOLULU, OAHU, T. H.
AS BUILT
PLANS OF

LIKELIKE HIGHWAY
FEDERAL AID SECONDARY PROJECT NO. S-0630(3)
DISTRICT OF HONOLULU
ISLAND OF OAHU

SCALE
PLAN 1 INCH = 50 FEET
PROFILE HOR. 1 INCH = 50 FEET
VER. 1 INCH = 10 FEET
CROSS SECTION HOR. 1 INCH = 10 FEET
VER. 1 INCH = 10 FEET

CONVENTIONAL SIGNS


Baseline ----- 125 -----
R/W & Control of Access Line -----, or -----
Fences (Named) -----
Existing Roadways -----
Circular Culverts -----
Box Culvert -----
Concrete Drop Intake ----- C.D.I. -----
Standard Catch Basin ----- M.H.S. -----
Standard Manhole -----
Wood Guard Rail With Conc. Posts -----

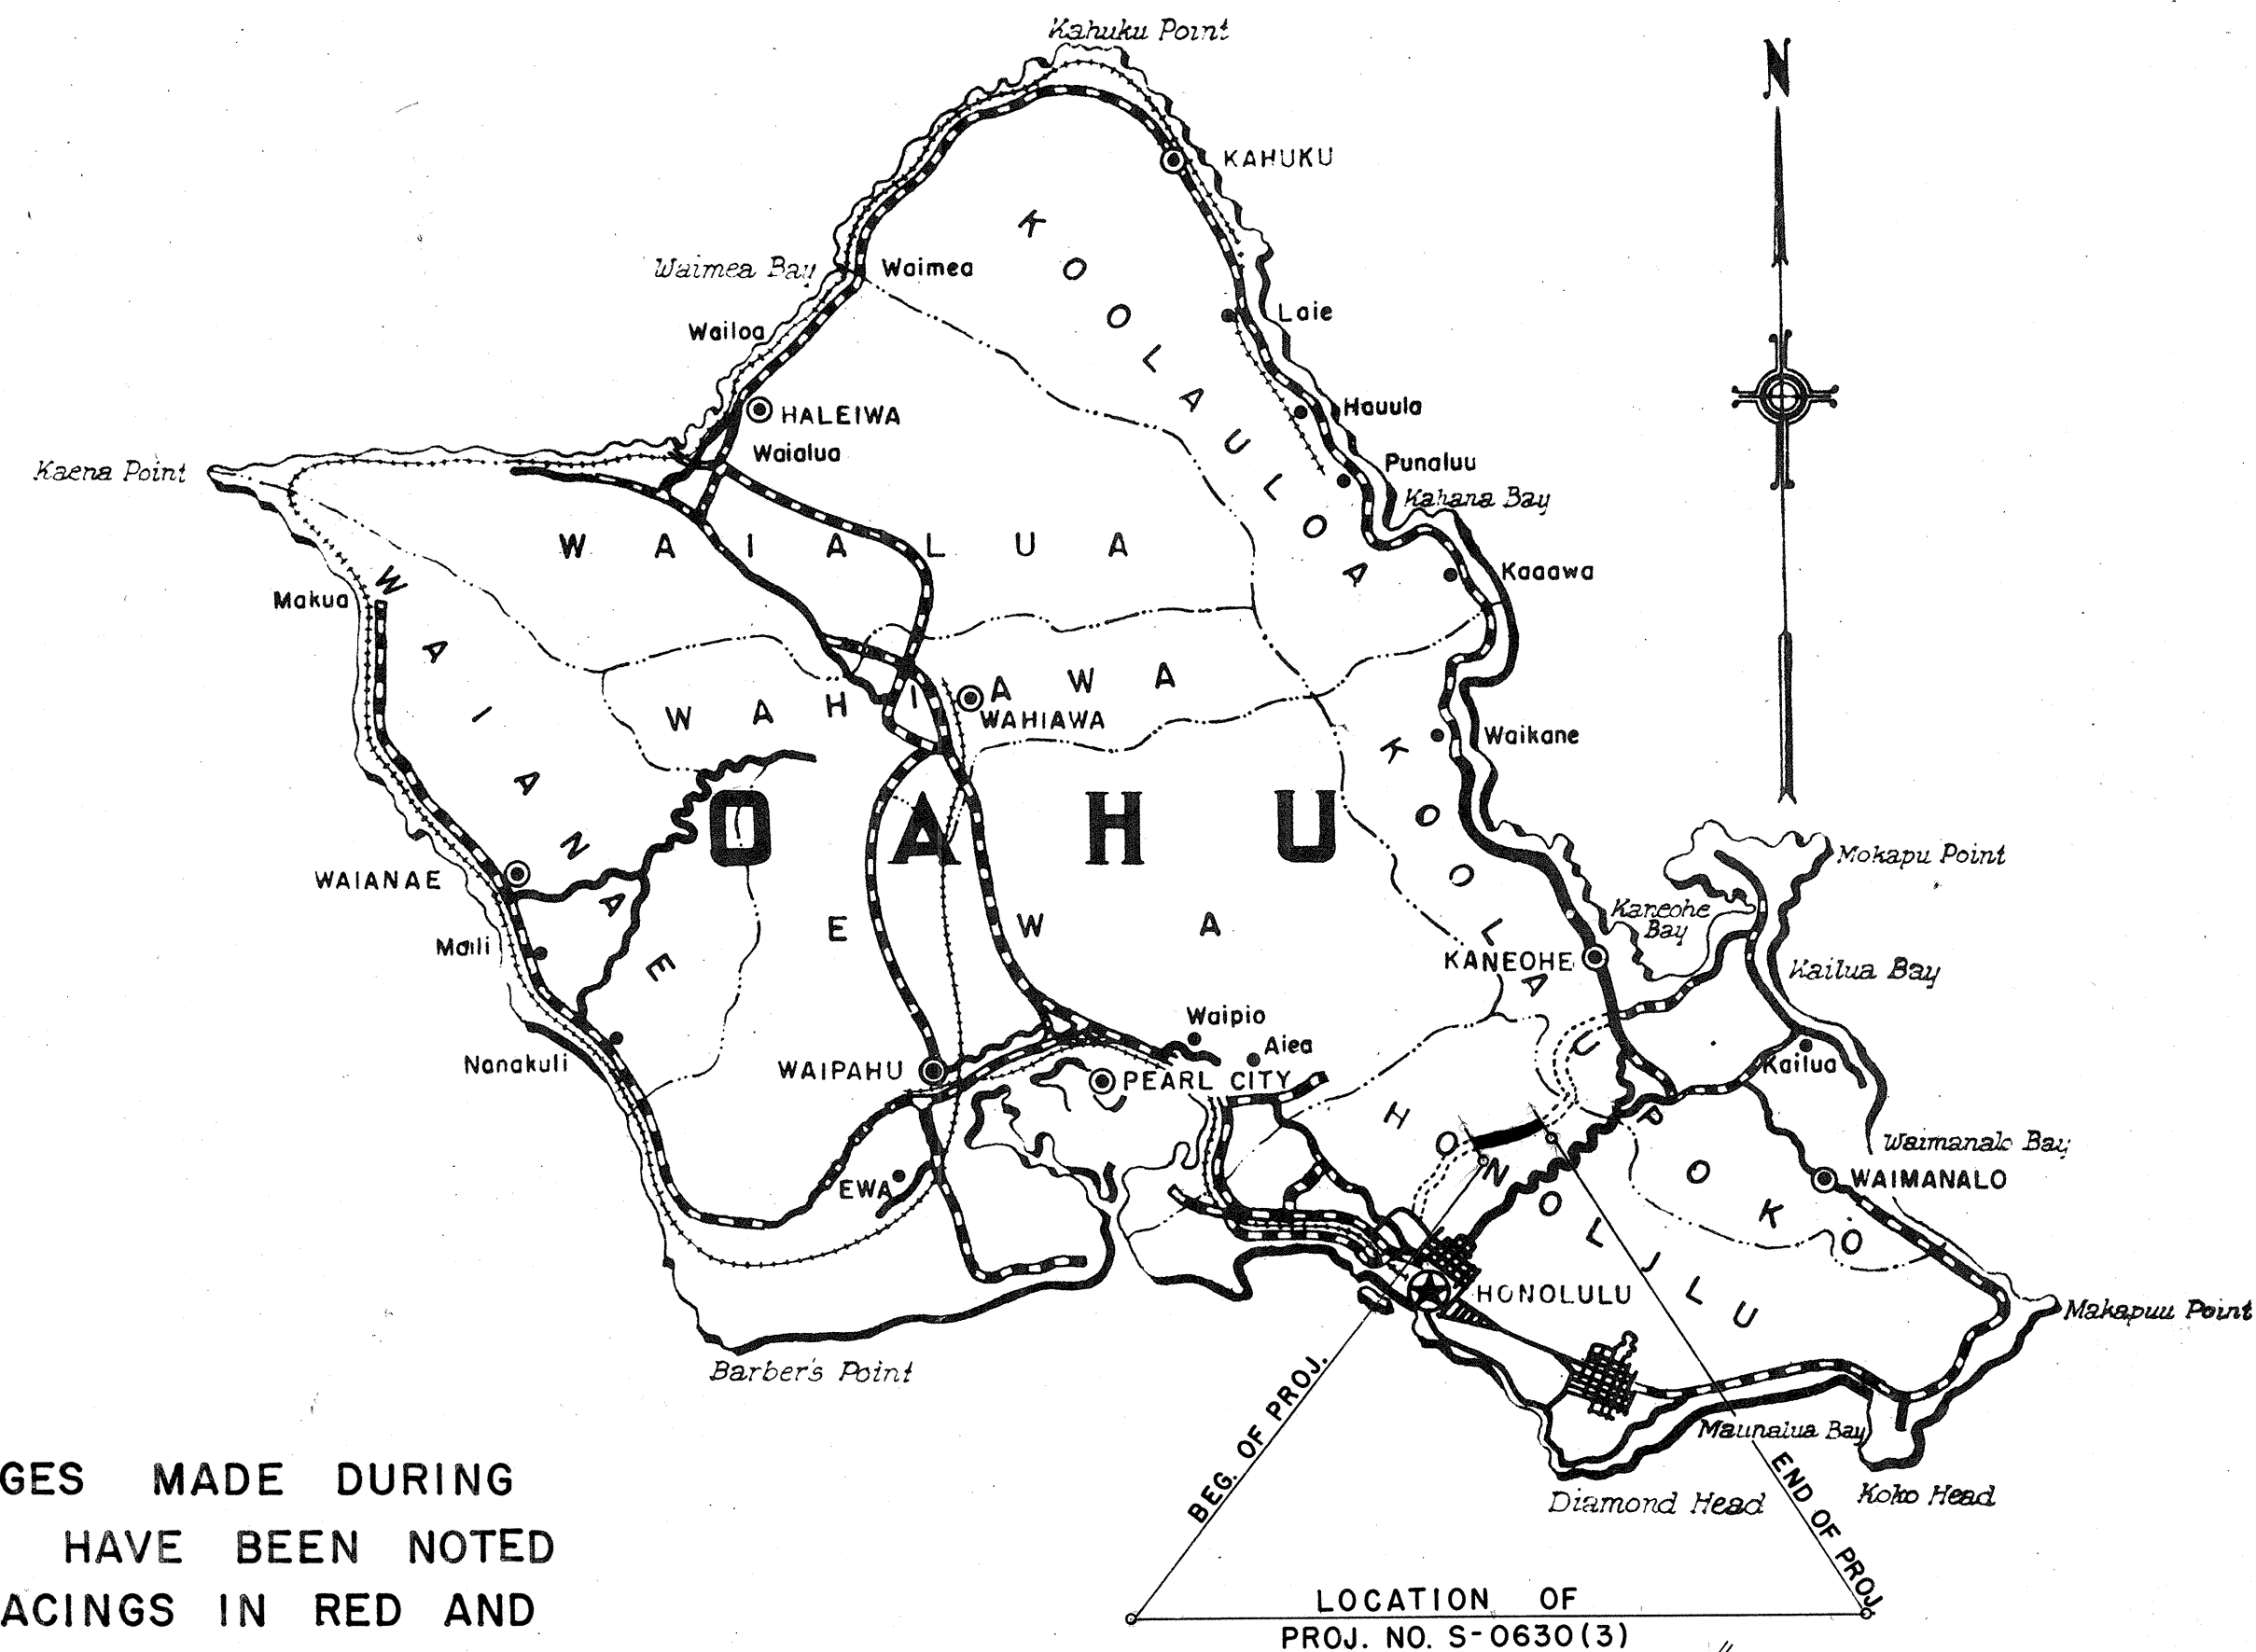

NOTE:
ALL CHANGES MADE DURING
CONSTRUCTION HAVE BEEN NOTED
IN THESE TRACINGS IN RED AND
CHECKED BY:

RESIDENT ENGINEER

DATE

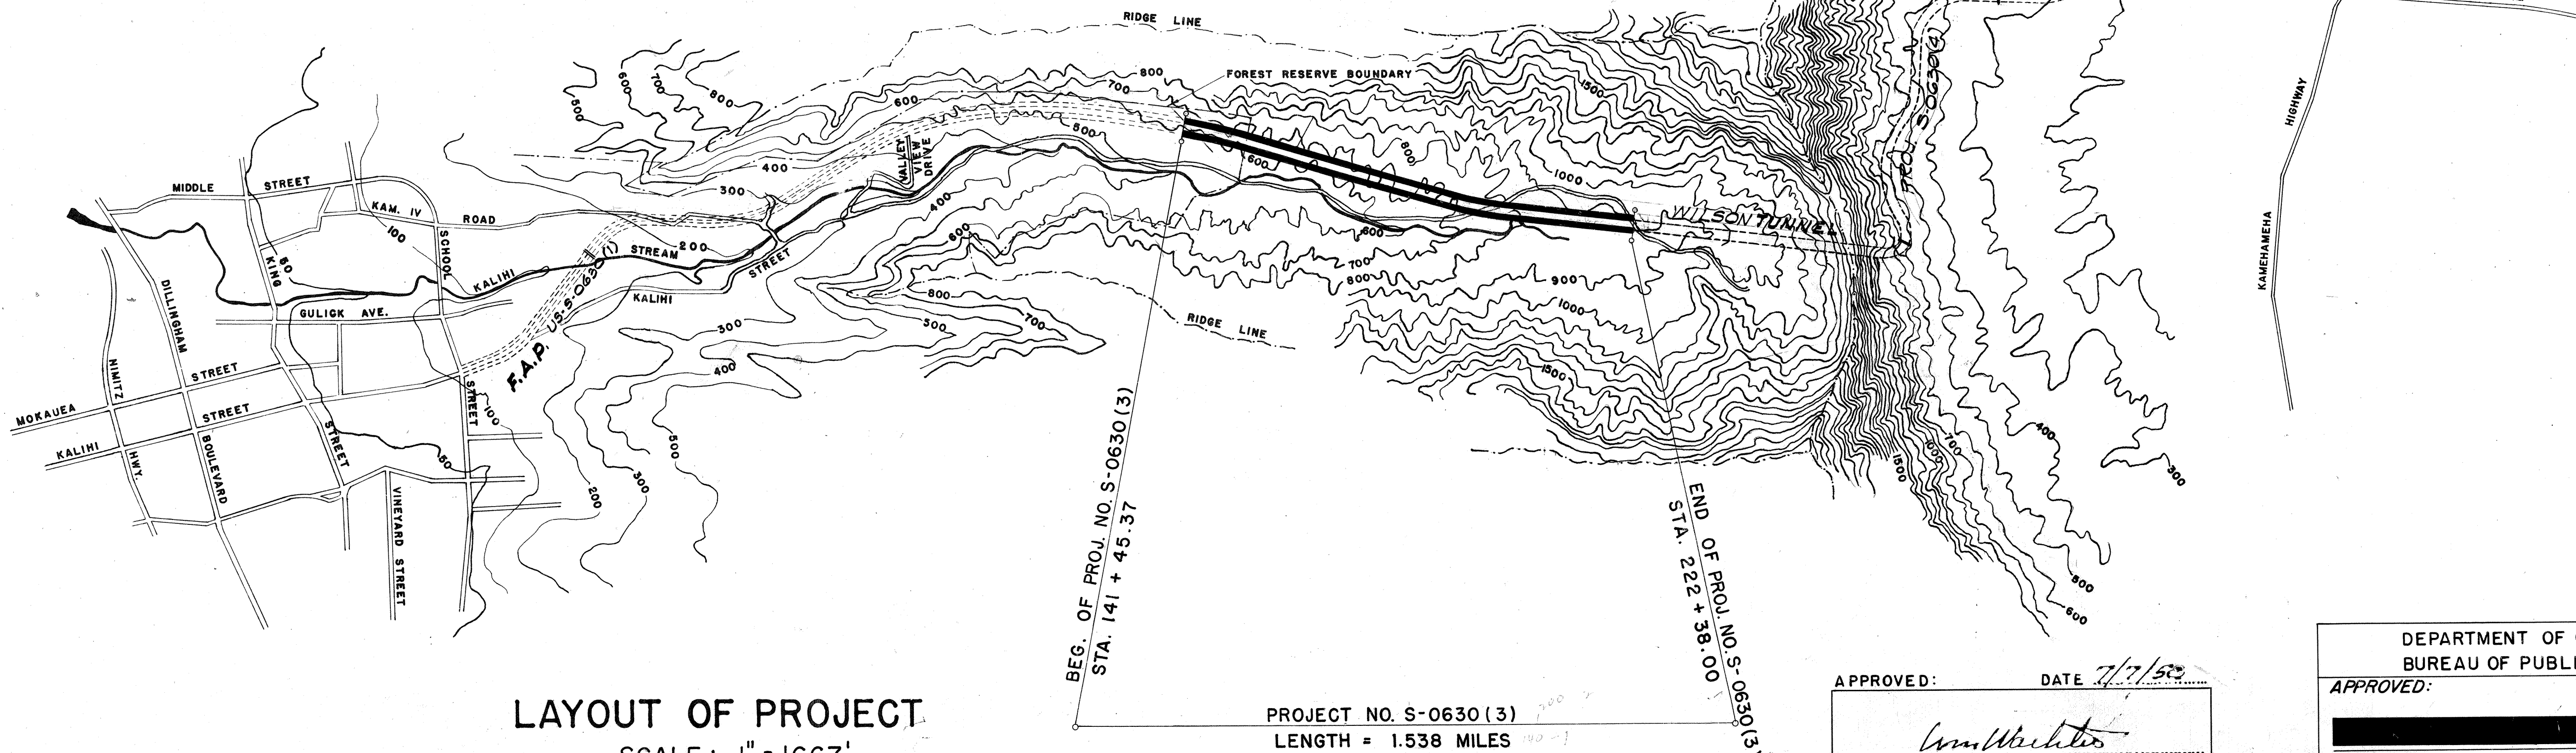

LAYOUT OF PROJECT
SCALE: 1" = 1667'

GROSS AND NET LENGTH OF PROJECT = 1.538 MILES

PROJECT NO. S-0630(3)
LENGTH = 1.538 MILES

APPROVED: *[Signature]* DATE 7/7/50
TERRITORIAL HIGHWAY ENGINEER

DEPARTMENT OF COMMERCE
BUREAU OF PUBLIC ROADS
APPROVED: *[Signature]*
DIVISION ENGINEER DATE

5914.1