

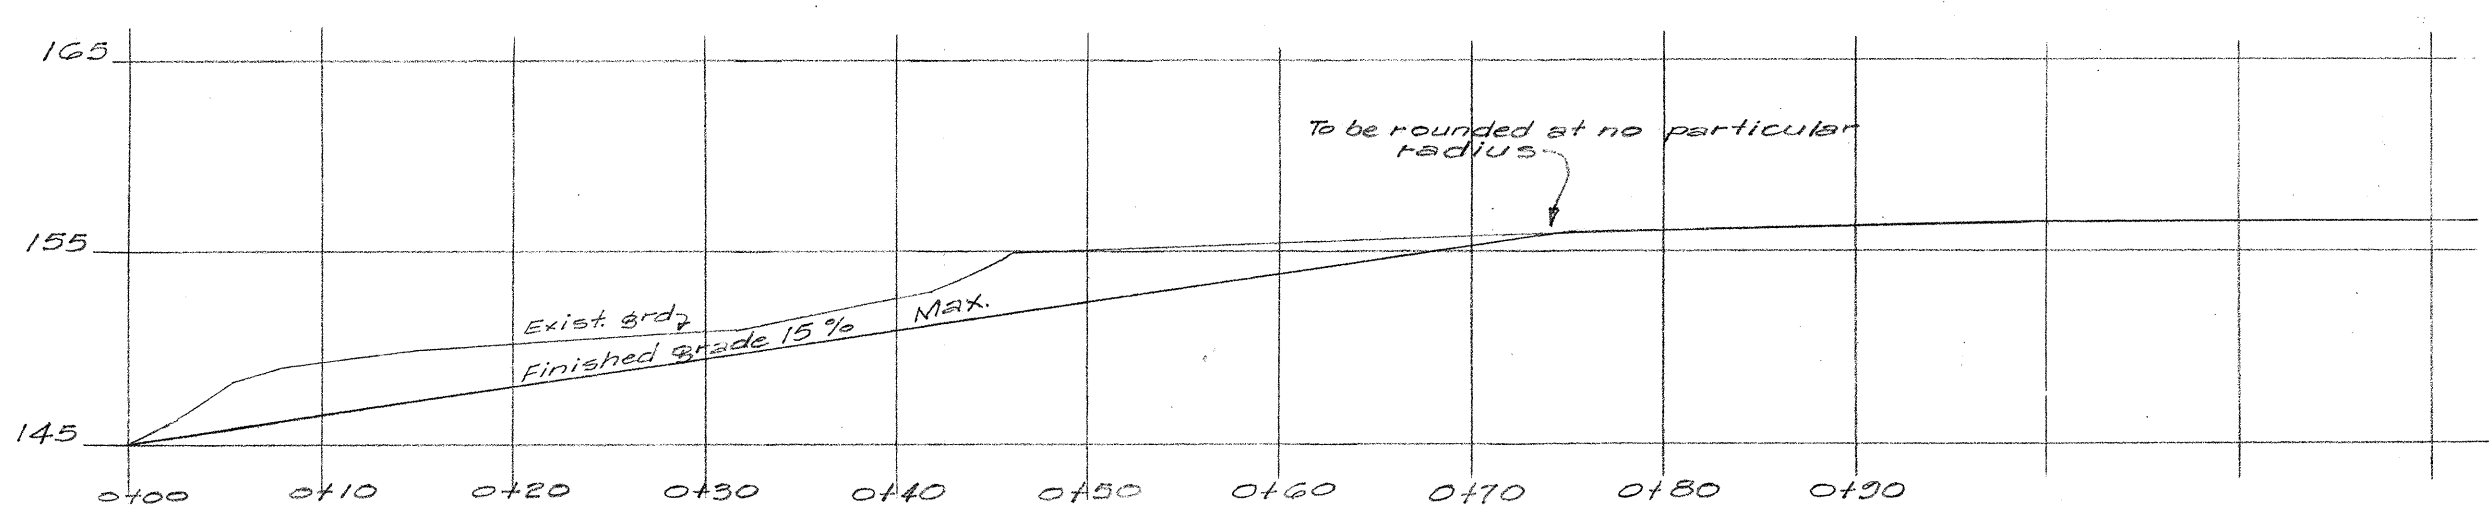


FED. ROAD DIST. NO.	STATE	FED. AID PROJ. NO.	FISCAL YEAR	SHEET NO.	TOTAL SHEETS
HAWAII	HAWAII	5-0630(9)	1959	2	10

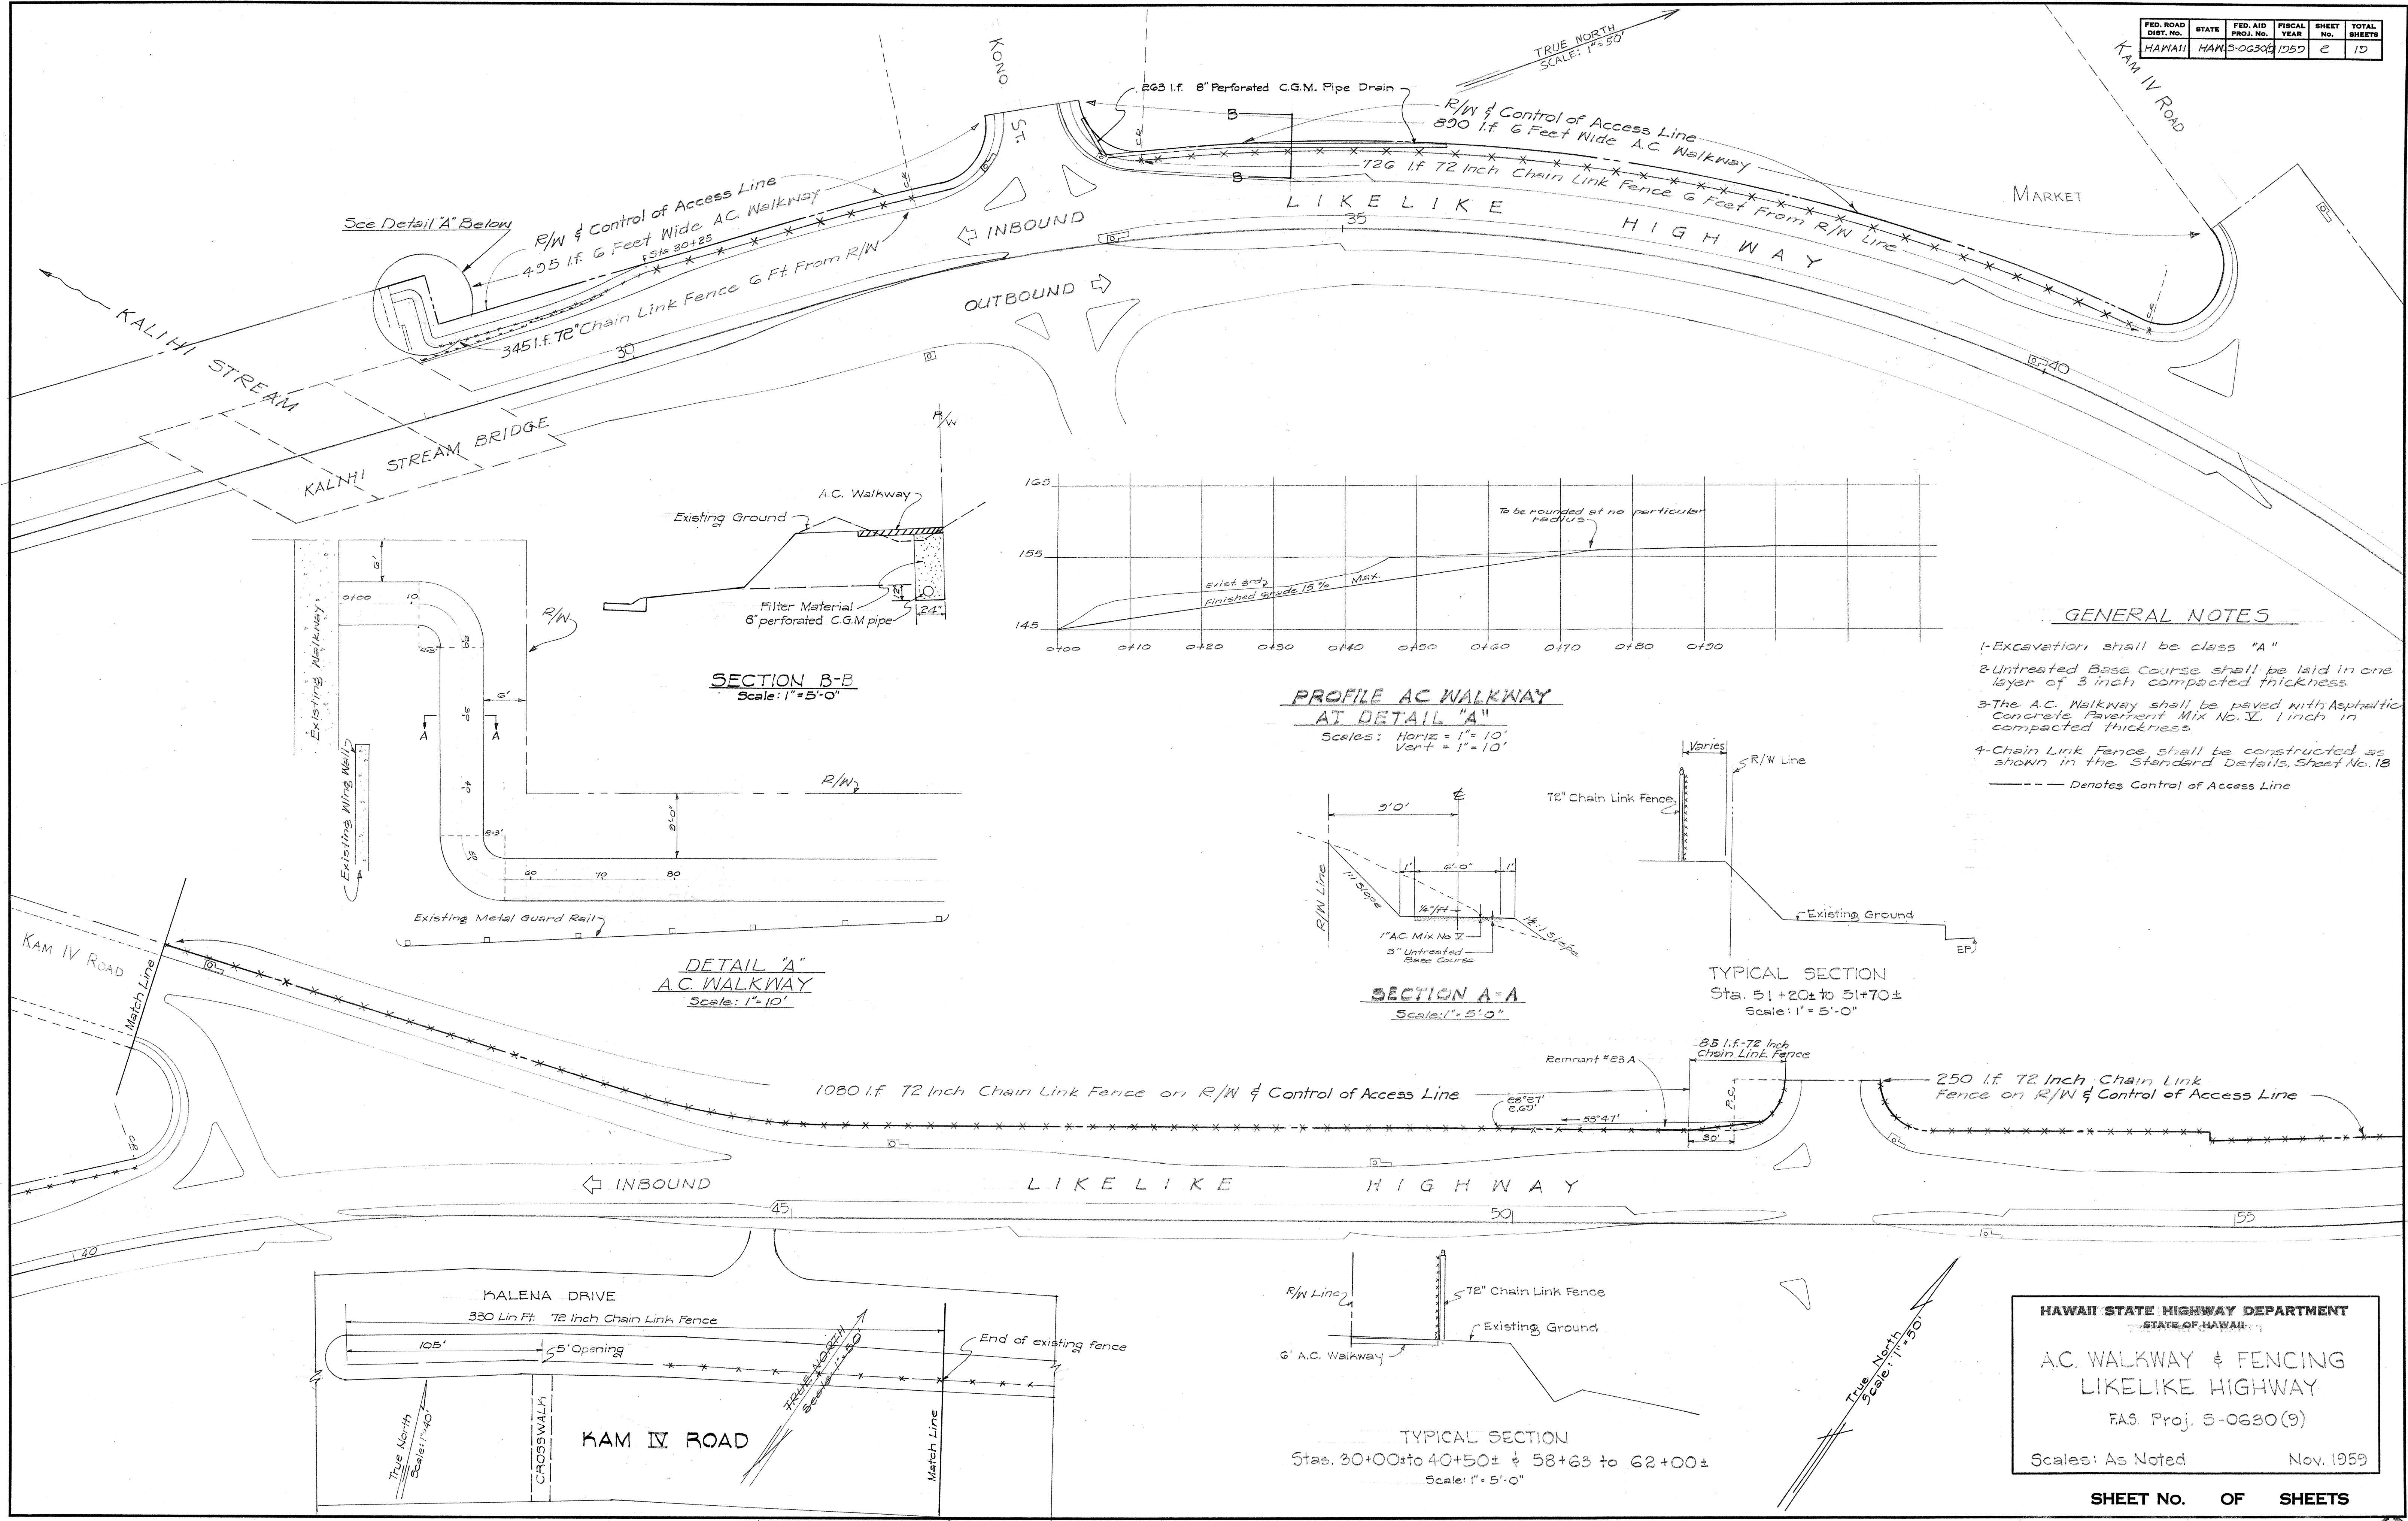


**PROFILE AC WALKWAY
AT DETAIL "A"**
Scales: Horiz = 1" = 10'
Vert = 1" = 10'


- GENERAL NOTES**
- 1-Excavation shall be class "A"
 - 2-Untreated Base Course shall be laid in one layer of 3 inch compacted thickness
 - 3-The A.C. Walkway shall be paved with Asphaltic Concrete Pavement Mix No. V, 1 inch in compacted thickness.
 - 4-Chain Link Fence shall be constructed as shown in the Standard Details, Sheet No. 18
- Denotes Control of Access Line

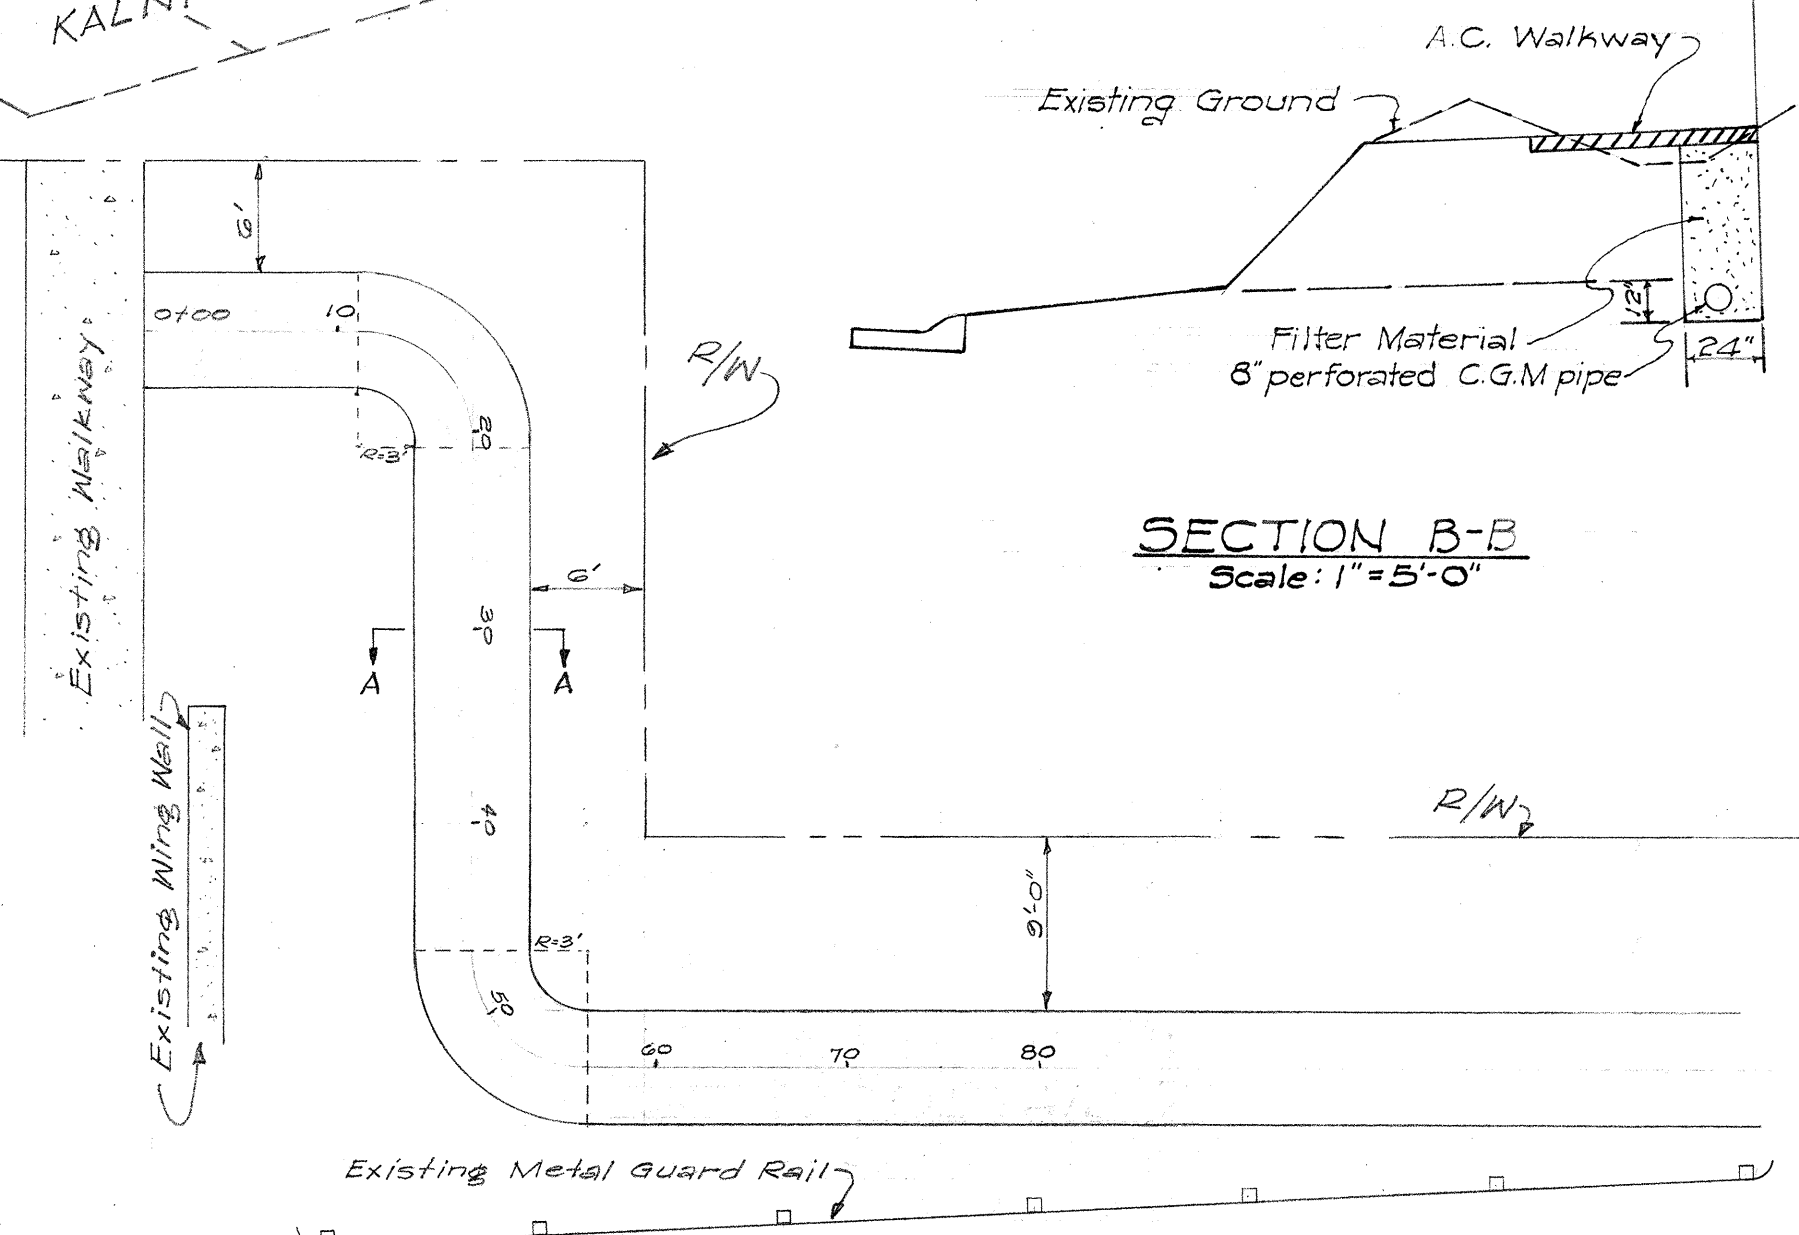



SECTION B-B
Scale: 1" = 5'-0"

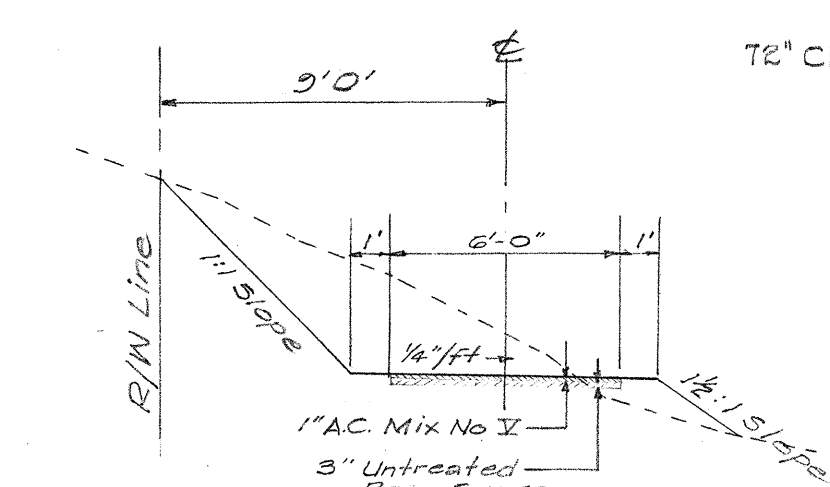

SECTION A-A
Scale: 1" = 5'-0"

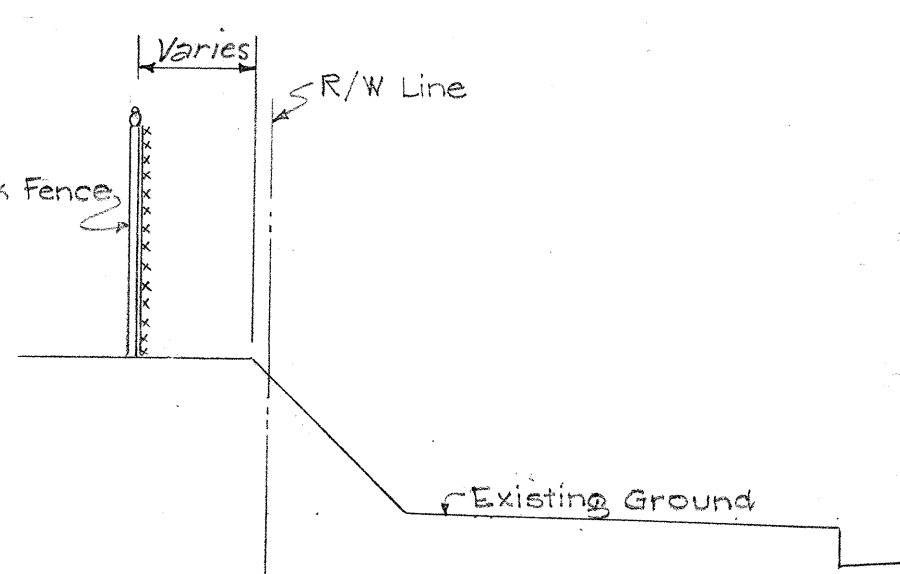

TYPICAL SECTION
Sta. 51+20± to 51+70±
Scale: 1" = 5'-0"

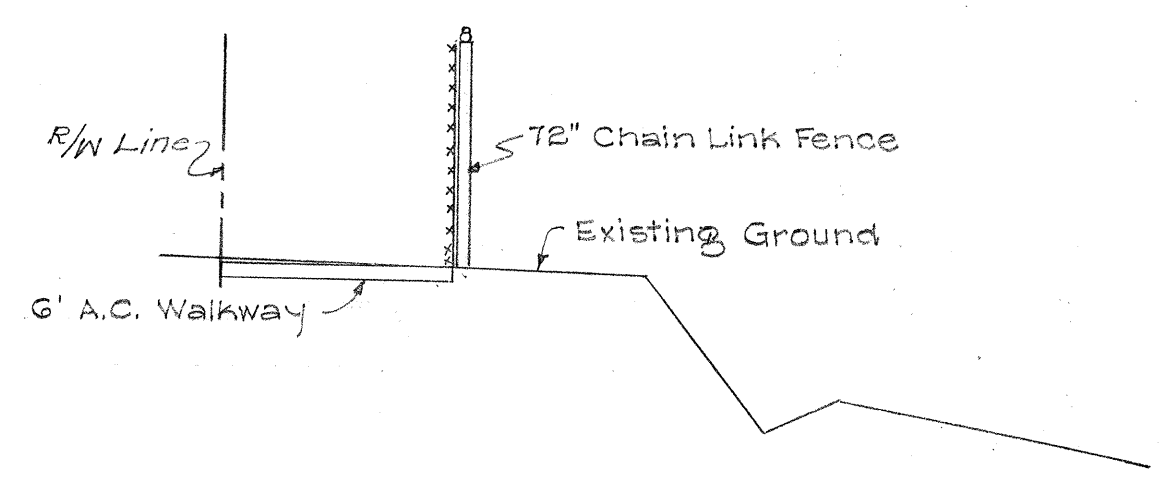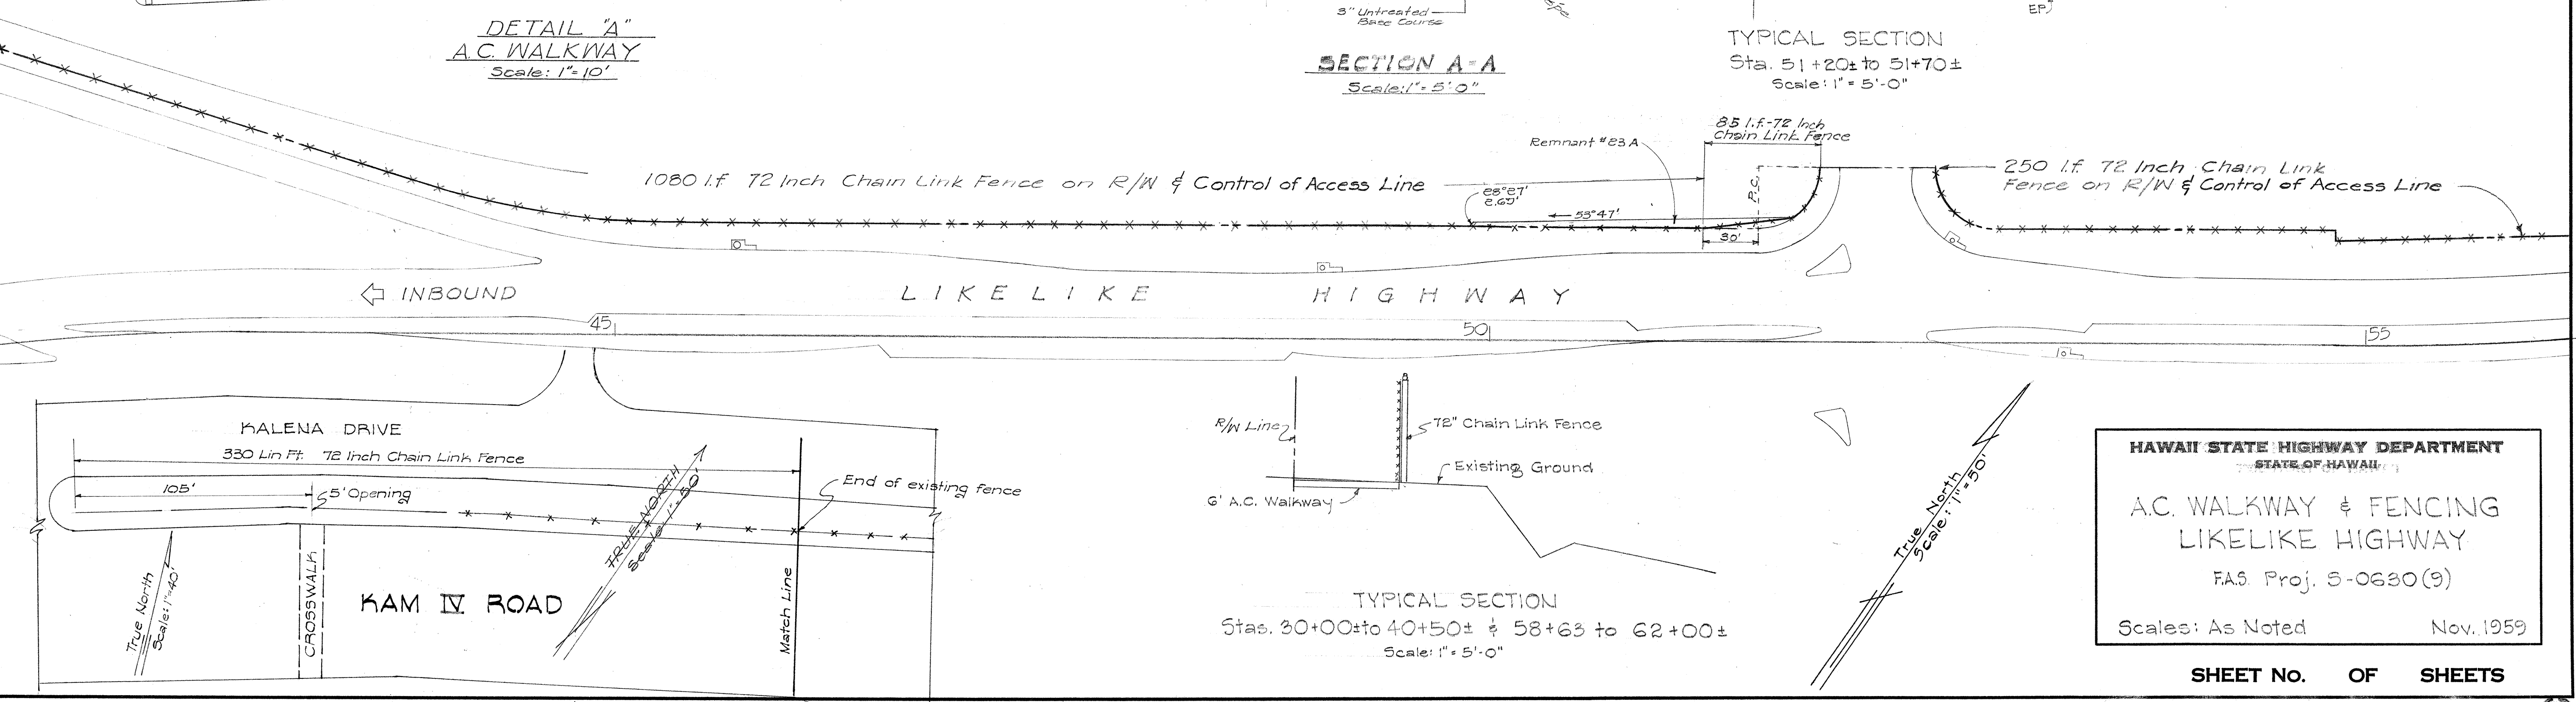

TYPICAL SECTION
Stas. 30+00± to 40+50± & 58+63 to 62+00±
Scale: 1" = 5'-0"

HAWAII STATE HIGHWAY DEPARTMENT
STATE OF HAWAII

**A.C. WALKWAY & FENCING
LIKELIKE HIGHWAY**


FAS Proj. 5-0630(9)

Scales: As Noted Nov. 1959

SHEET No. OF SHEETS

DESIGNED BY	DATE
DRAWN BY	
CHECKED BY	
NOTED BY	
QUANTITIES CHECKED BY	
NO.	

FED. ROAD DIST. No.	STATE	FED. AID PROJ. No.	FISCAL YEAR	SHEET No.	TOTAL SHEETS
HAWAII	HAW	5-0630(9)	1959	3A	10

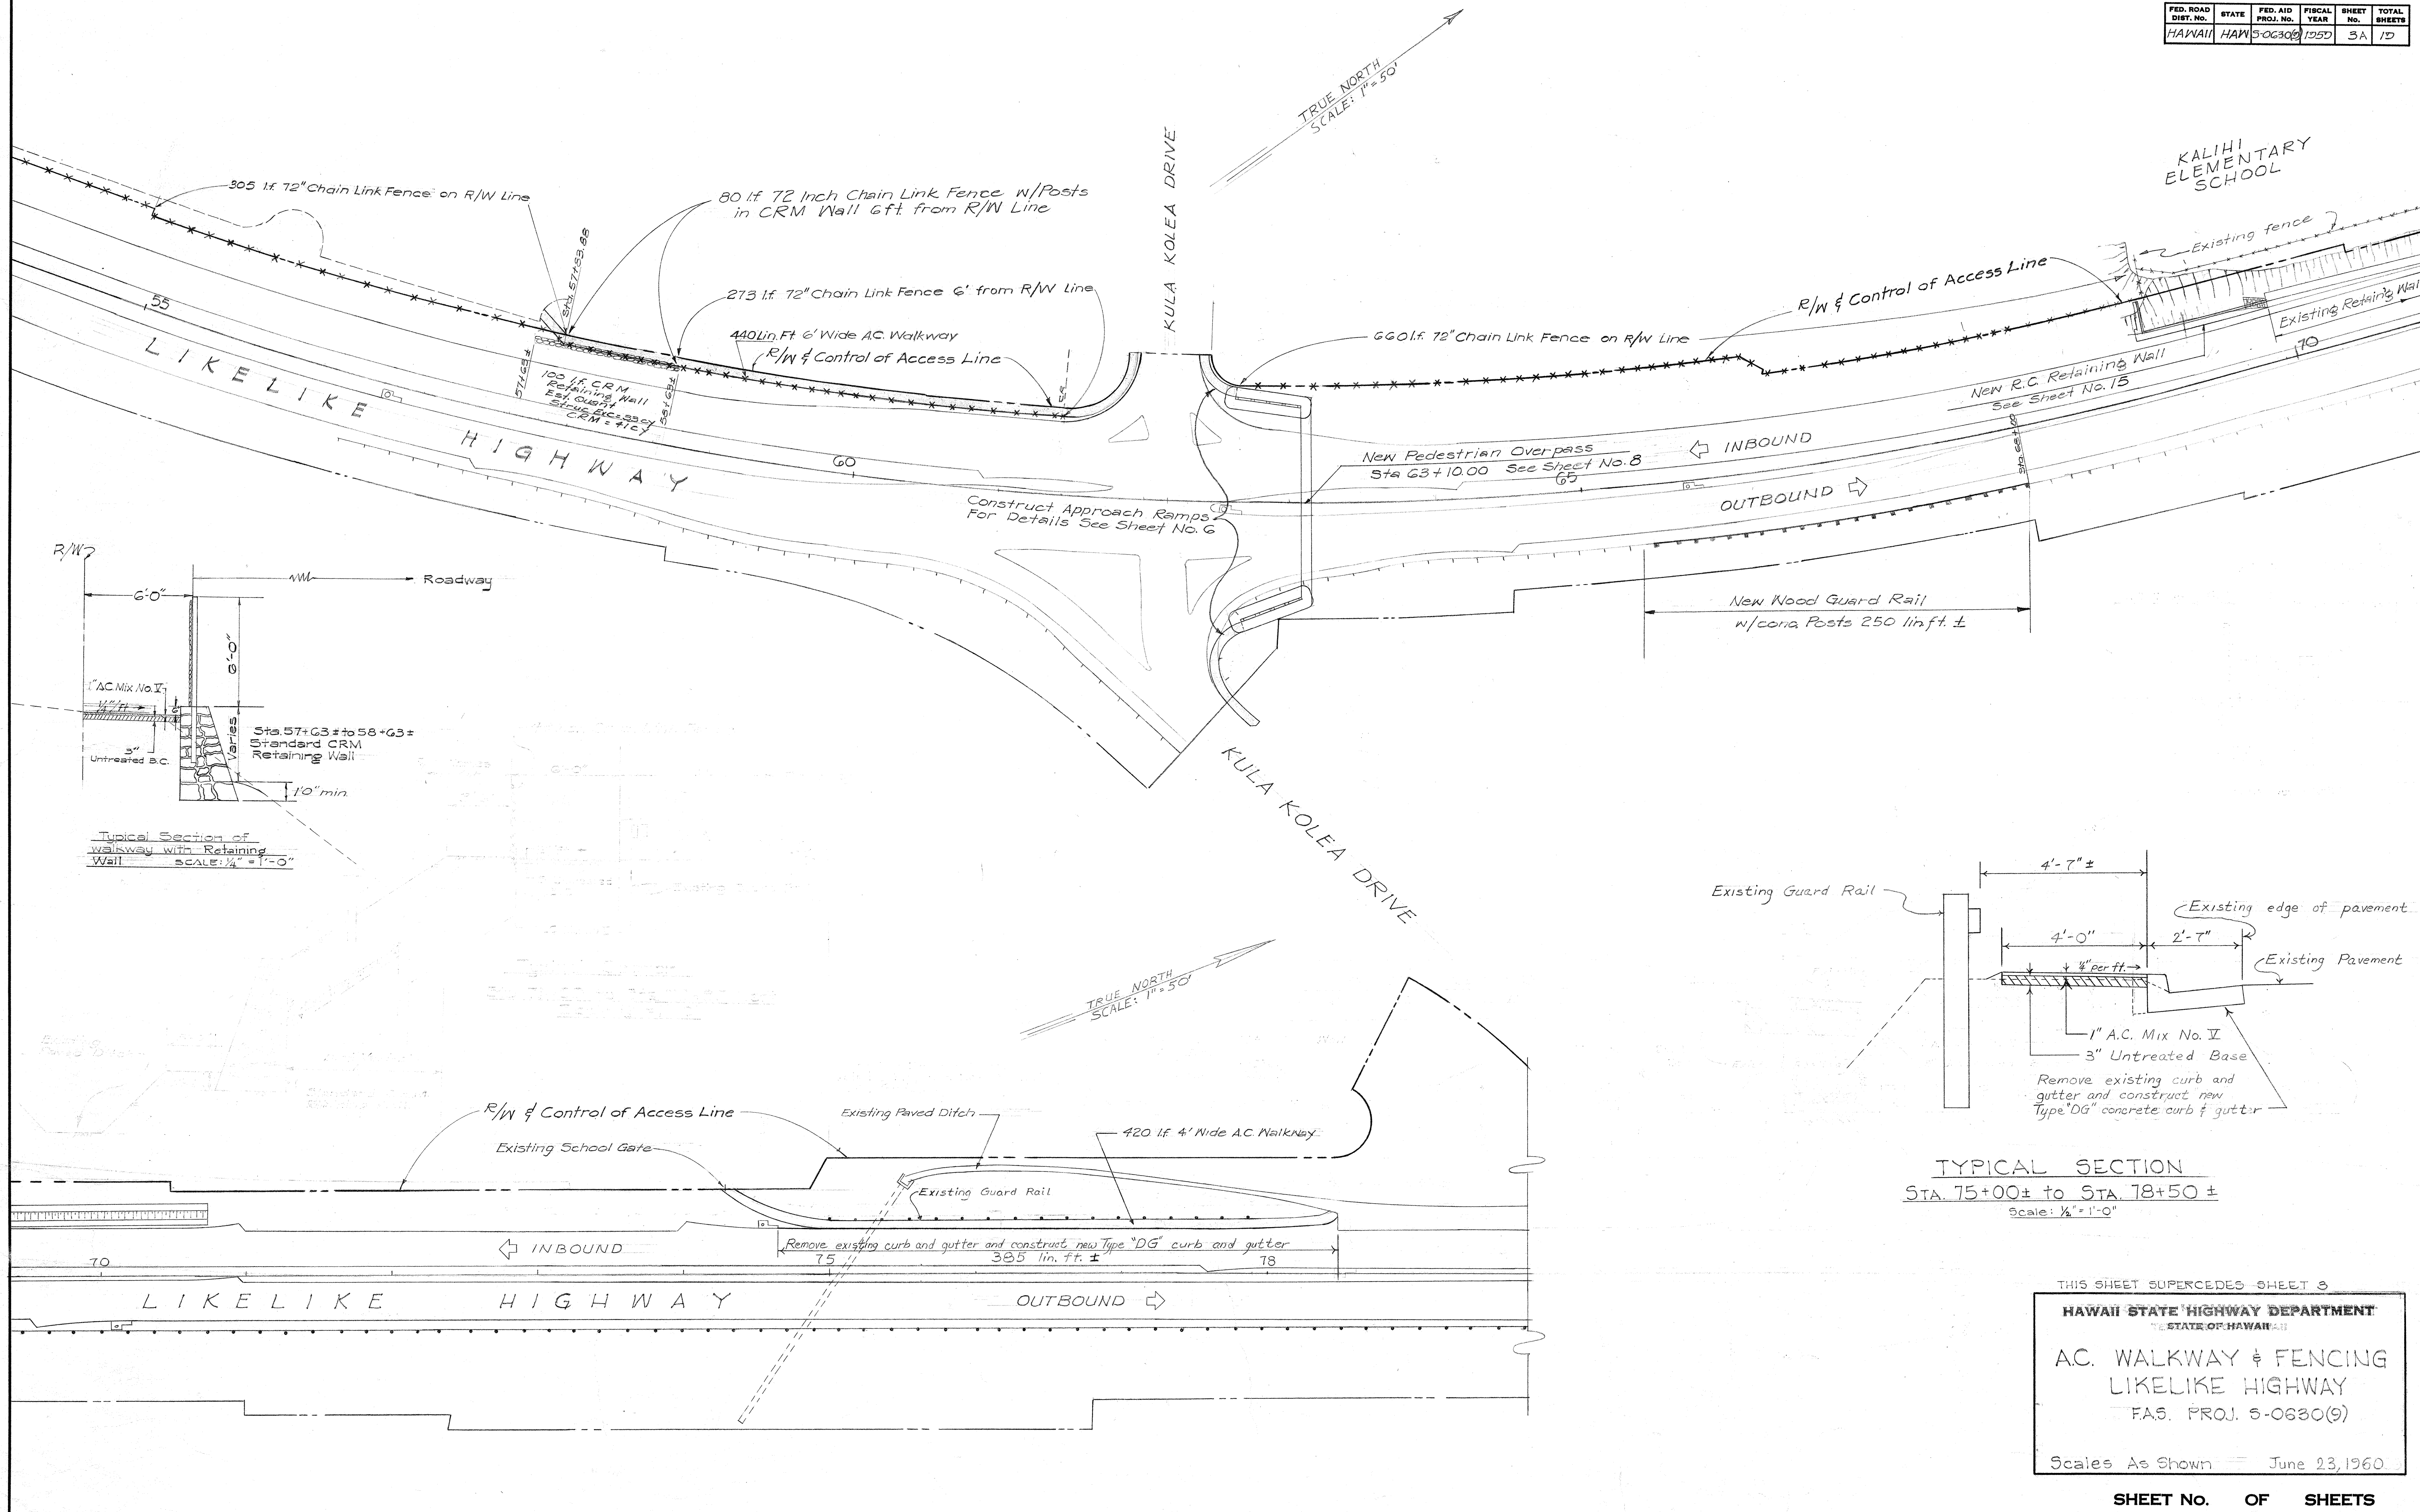

SURVEY PLOTTED BY	DATE
DESIGNED BY	
DRAWN BY	
CHECKED BY	
NOTED BY	
QUANTITIES CHECKED BY	
NO. BOOK	
NO.	

DATE	BY	SURVEYED	NOTED	PLANNED	AREAS	AREAS

DATE	BY	SURVEYED	NOTED	PLANNED	AREAS	AREAS

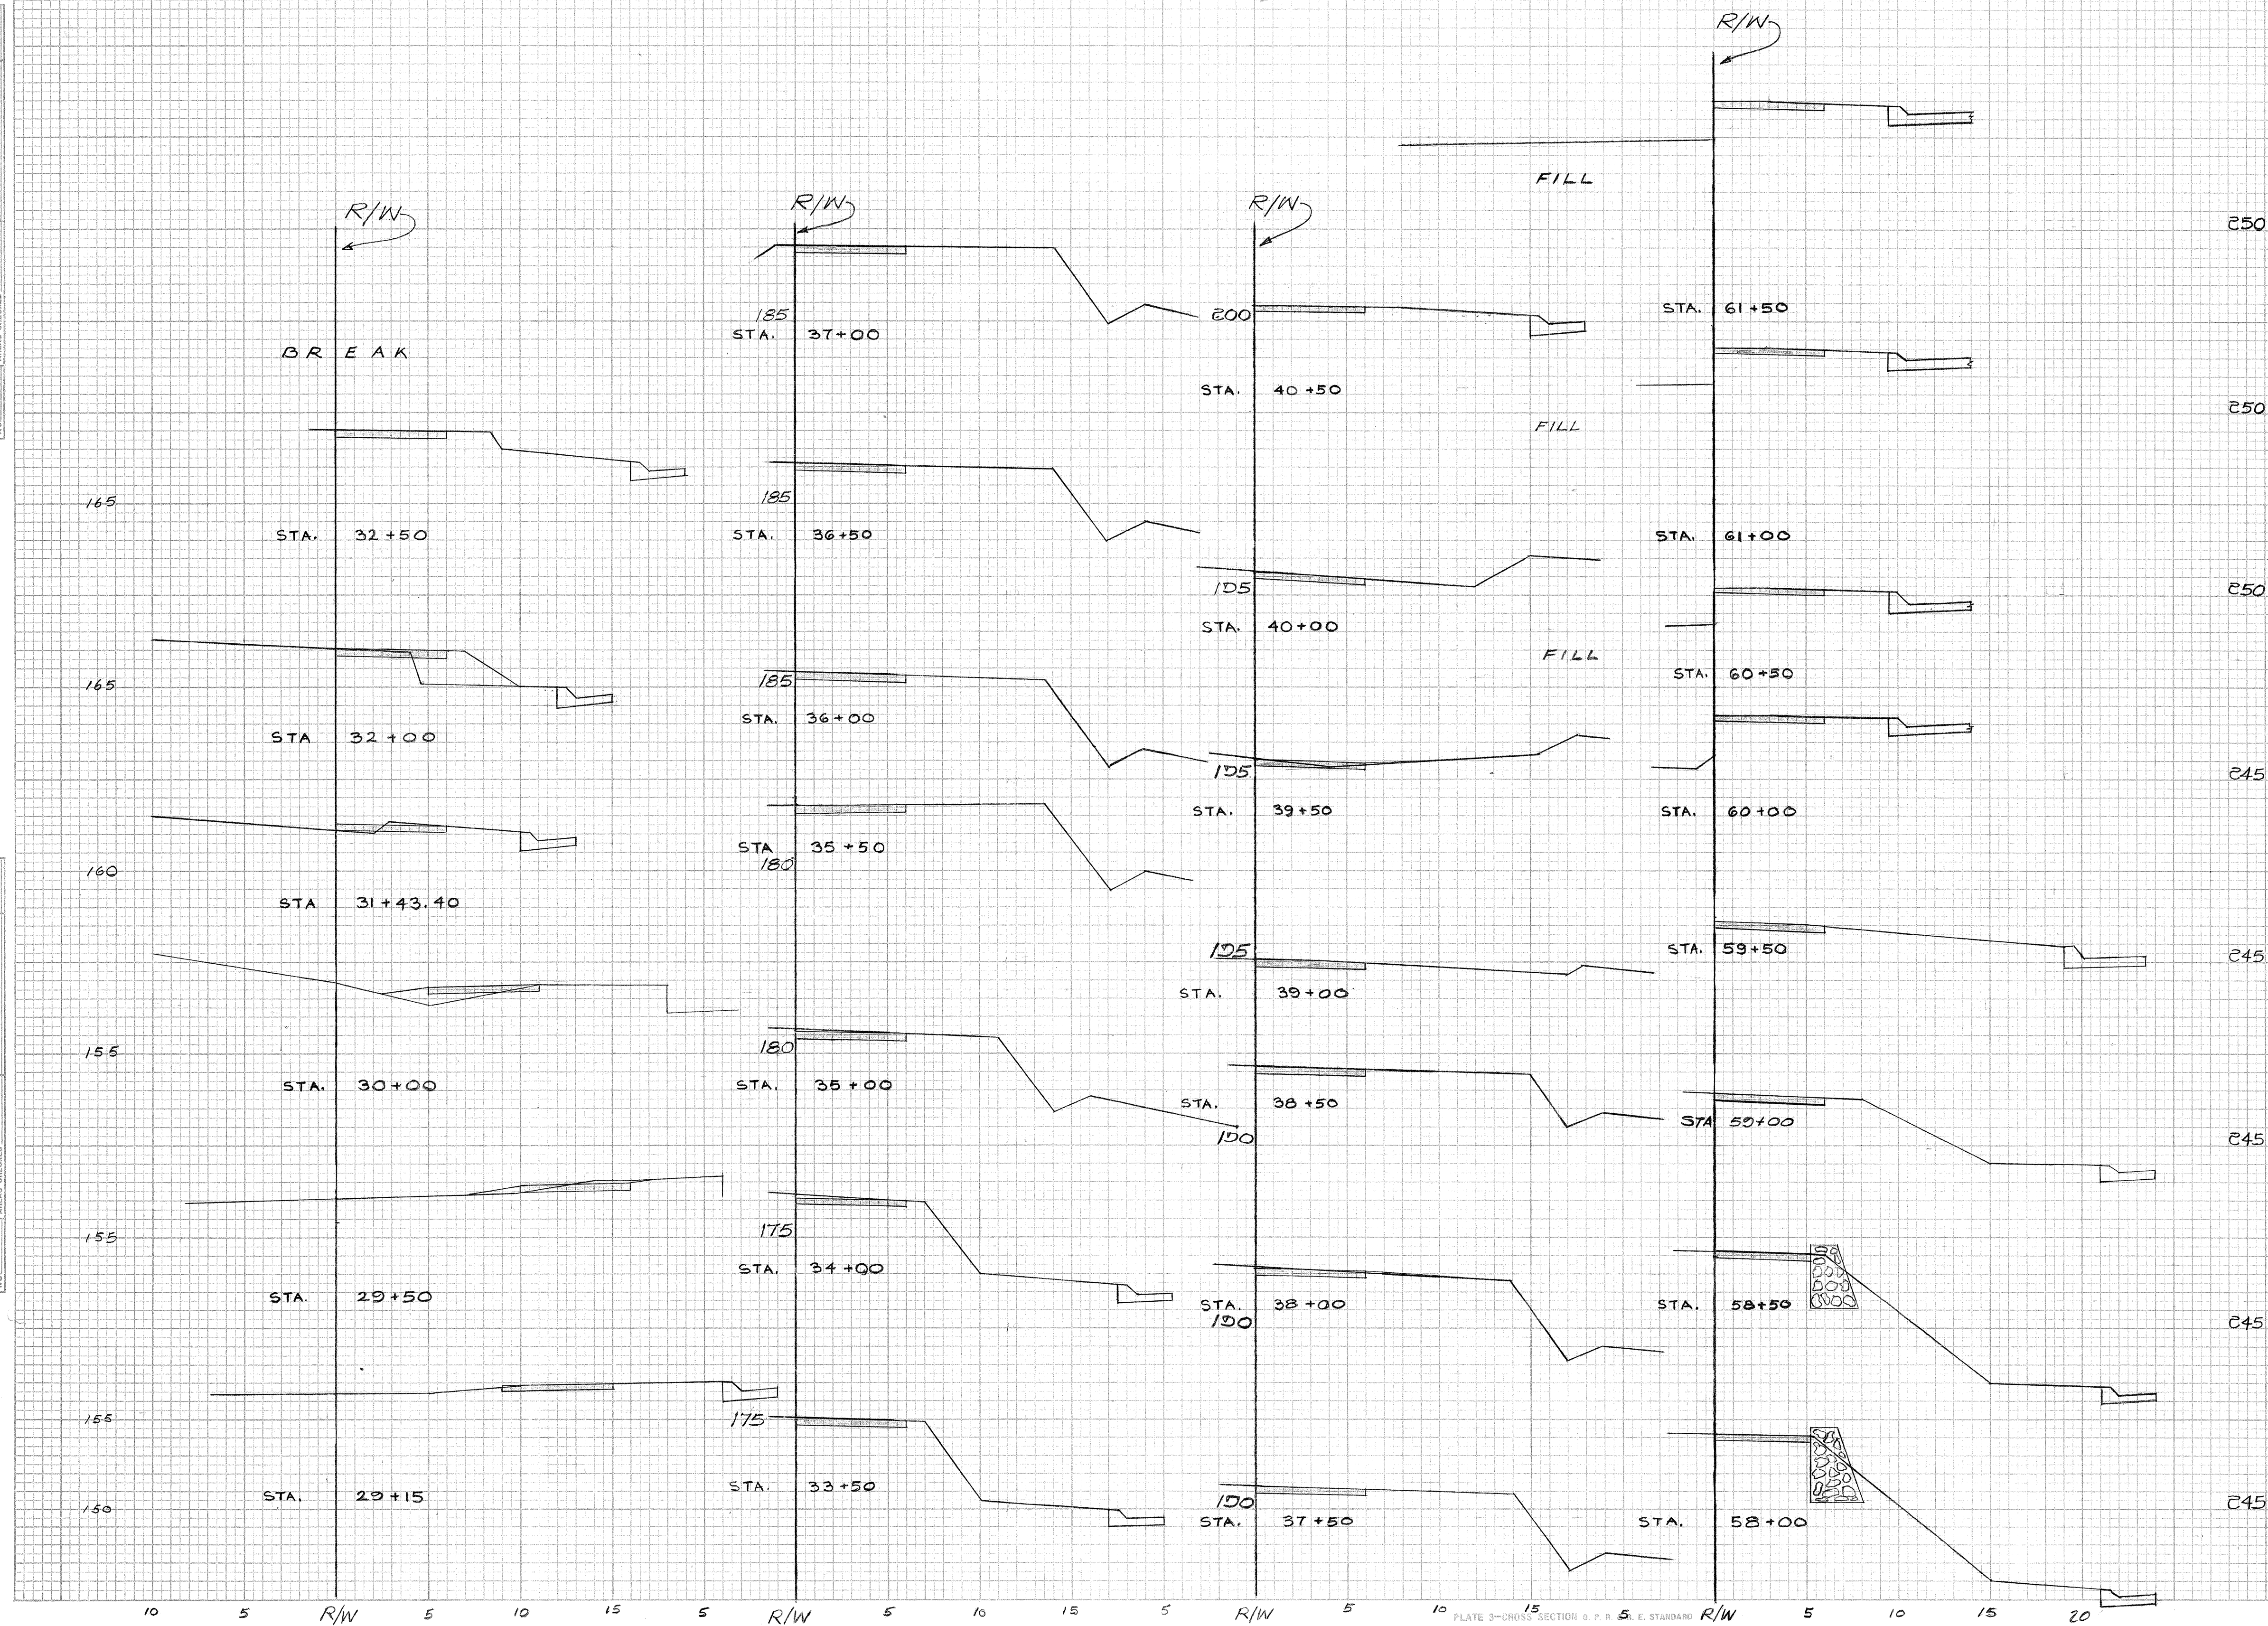


PLATE 3-CROSS SECTION 9. P. R. E. STANDARD
J. H. REIL CO., PHILADELPHIA

A.C. WALKWAY

