

INDEX TO DRAWINGS	
SHEET NO.	DESCRIPTION
1	TITLE SHEET
2-5	A.C. WALKWAY AND FENCING
6-7	APPROACH RAMP
8-14	PEDESTRIAN OVERPASS
15-16	CONCRETE RETAINING WALL
17-19	STANDARD DETAILS

STATE OF HAWAII
HAWAII STATE HIGHWAY DEPARTMENT
HONOLULU, OAHU, HAWAII


**AS BUILT
PLANS OF**

LIKELIKE HIGHWAY

**PEDESTRIAN OVERPASS AND
ROADSIDE IMPROVEMENTS**

FEDERAL AID SECONDARY PROJECT NO. S-0630(9)


DISTRICT OF HONOLULU
ISLAND OF OAHU

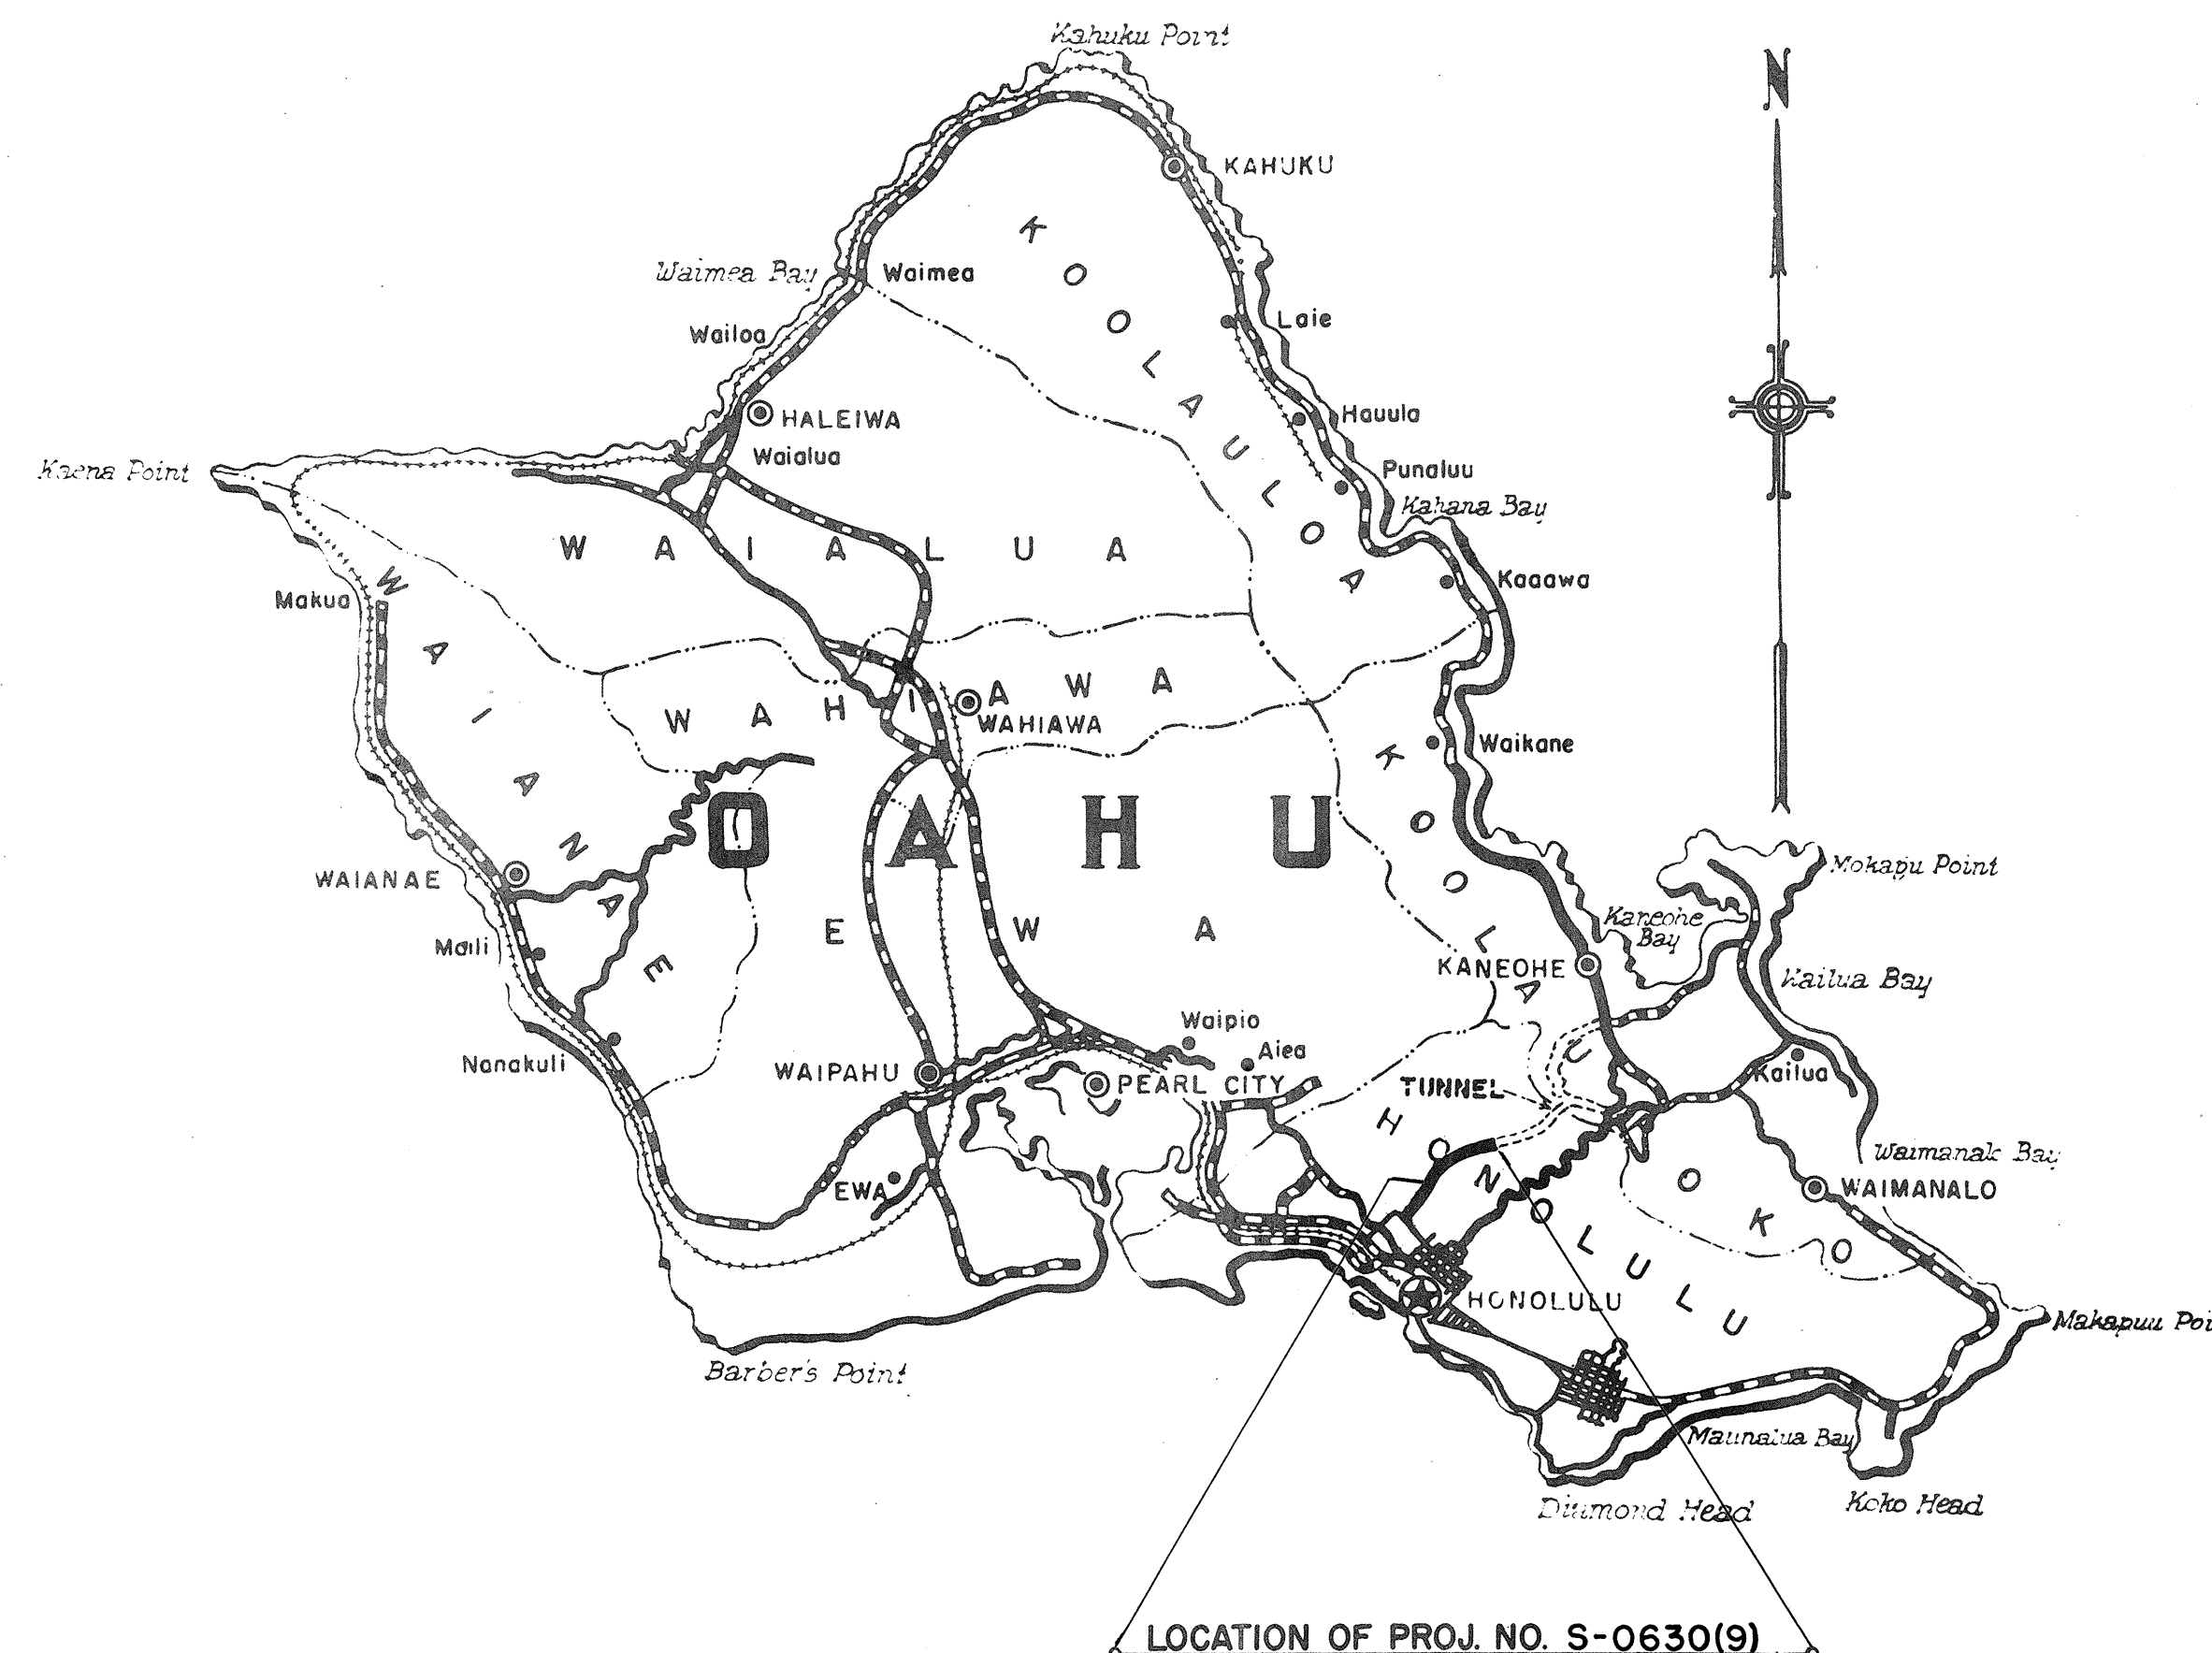

Federal Aid Projects Previously Constructed Or Under Construction

NOTE:
ALL CHANGES MADE DURING CONSTRUCTION
HAVE BEEN NOTED IN RED ON THESE
TRACINGS AND CHECKED BY:

Frederick J. Takakawa
PROJECT ENGINEER
Jun. 31, 1962
DATE

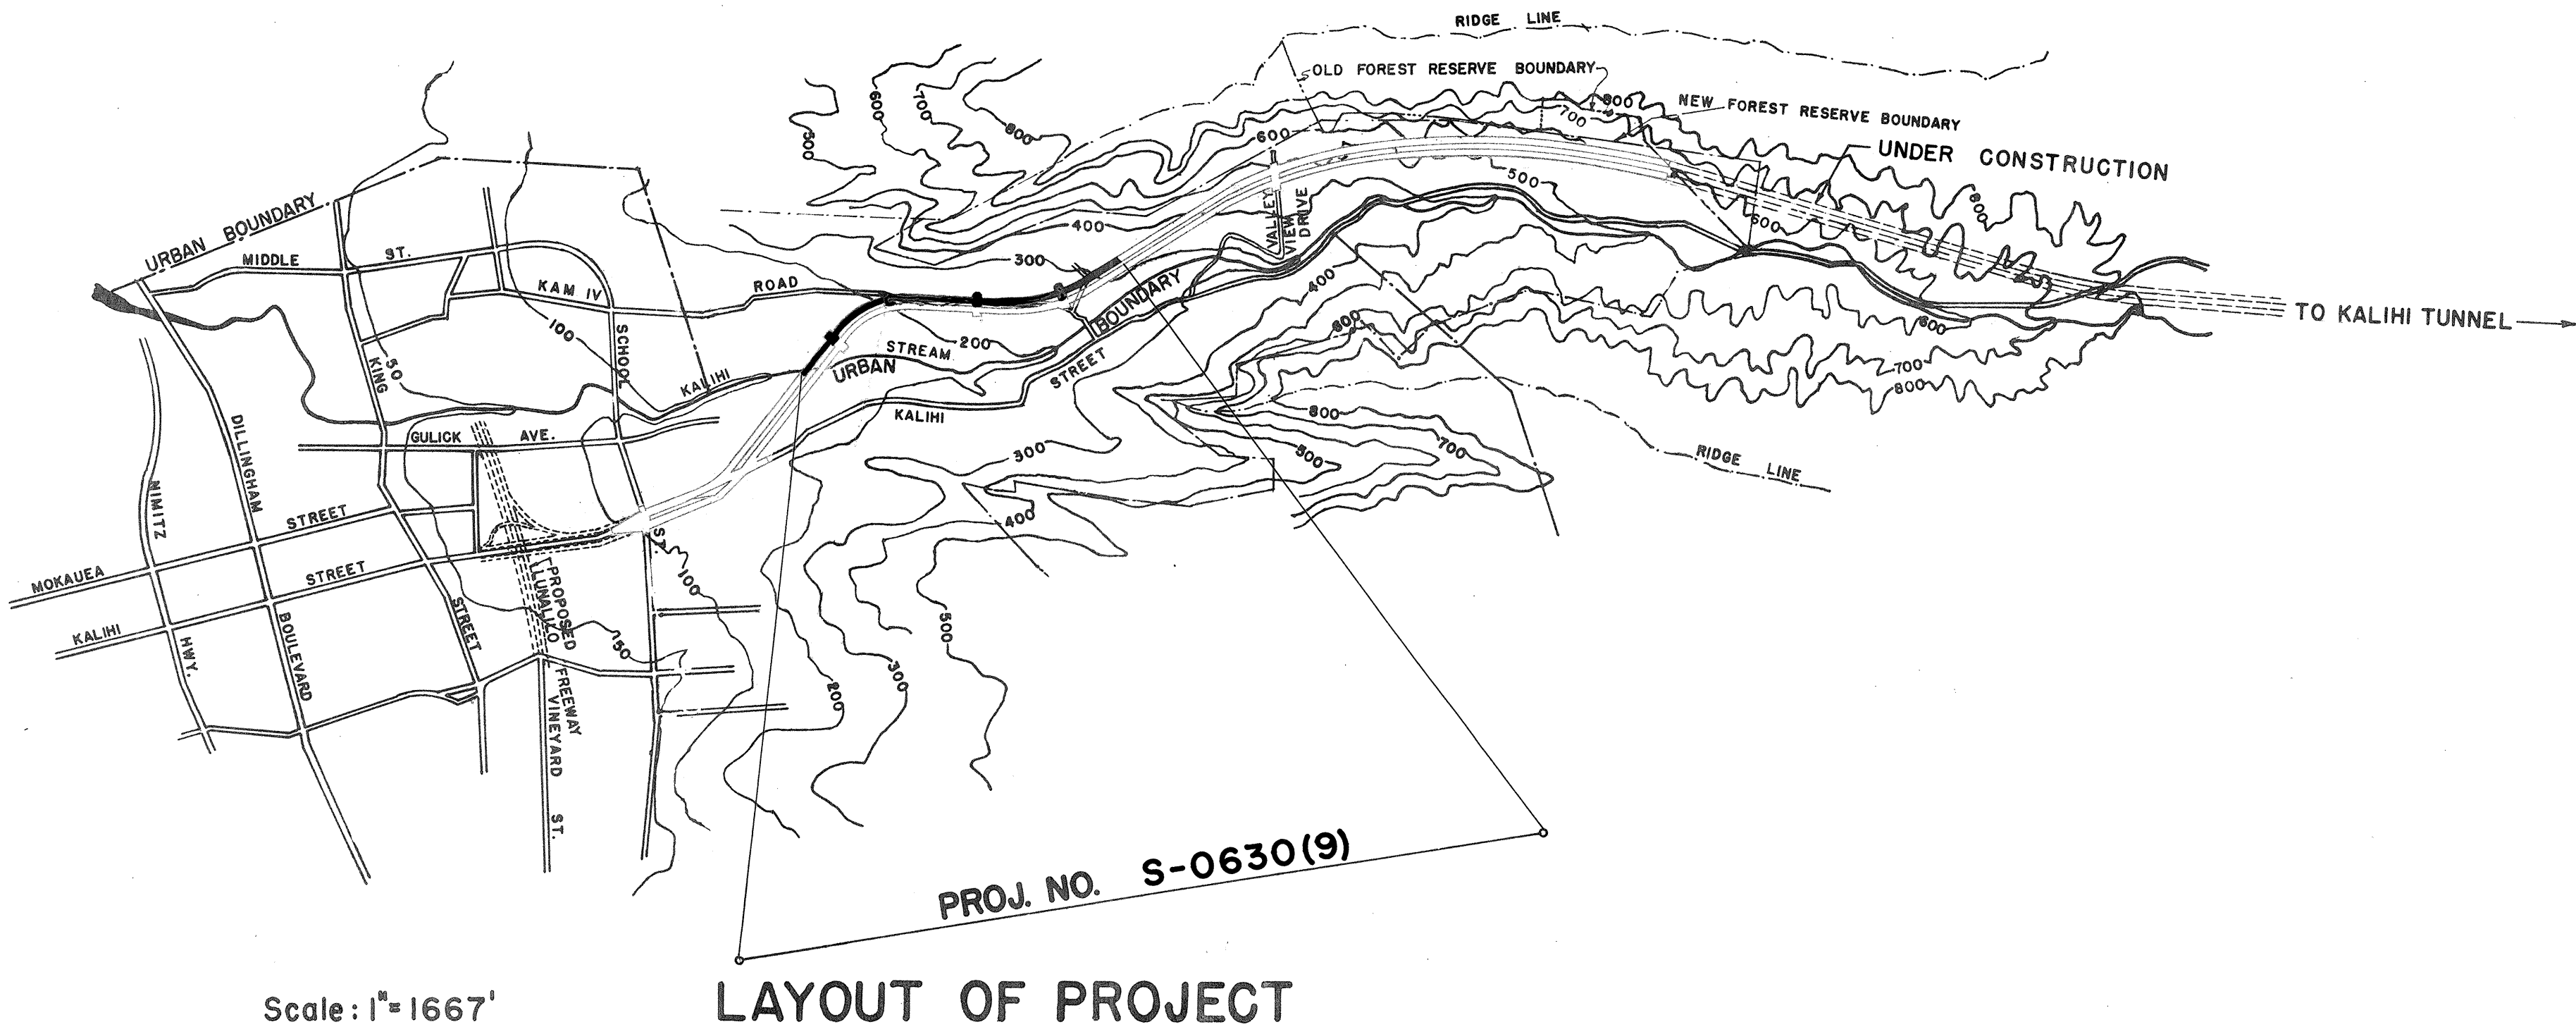

LAYOUT OF PROJECT

APPROVED *Sam O. Hirota* DATE *12-17-59*
STATE HIGHWAY ENGINEER

DEPARTMENT OF COMMERCE
BUREAU OF PUBLIC ROADS

APPROVED: _____
DIVISION ENGINEER DATE

DD-B-8-1

DATE _____
SURVEY PLOTTED BY _____
DESIGNED BY _____
ORIGINAL PLAN _____
NOTED BACK _____
QUANTITIES BY _____
CHECKED BY _____