

GENERAL NOTES:

1. Azimuths are referred to Kailua Δ .
2. B.M. Elevations are referred to mean sea level.
3. Install Φ Monuments along the R/W Baseline as staked by the Engineer.
4. Section "B" shall be from Sta. 3+50 to 59+50.
5. Section "A" shall be from Sta. 59+50 to 130+82.44.
6. See sheets 8132(1).17&18 for spillway inlets and outlets details.
7. Wire Mesh reinforcement for Pavement, Ditch, etc. shall be incidental to the concrete.

C & C B.M. ELEV. = 698.44
SPK. in Type E-1 Gutter at edge of pav't.
INB. LANE Sta. 2+00 110' from Portal

CURVE DATA @ 2ND BORE

Station	Angle	Radius	Chord	Offset
1+00	24° 35' 35"	13' 17' 47.5"	165.43	100.00
1+50	17° 00' 00"	142.47	142.47	276.55

CURVE DATA INBOUND LANES

Station	Angle	Radius	Chord	Offset
1+00	24° 35' 35"	13' 17' 47.5"	165.43	100.00
1+50	17° 00' 00"	142.47	142.47	276.55

CURVE DATA

Station	Angle	Radius	Chord	Offset
1+00	24° 35' 35"	13' 17' 47.5"	165.43	100.00
1+50	17° 00' 00"	142.47	142.47	276.55

CURVE DATA

Station	Angle	Radius	Chord	Offset
1+00	24° 35' 35"	13' 17' 47.5"	165.43	100.00
1+50	17° 00' 00"	142.47	142.47	276.55



FED. ROAD DIST. No.	STATE	FED. AID PROJ. No.	FISCAL YEAR	SHEET No.	TOTAL SHEETS
HAWAII	HAW.	S-06704	1959	4	47

RIGHT-OF-WAY SYMBOLS


- Vehicular Access Permitted
- No Access Permitted

POINTS OF ACCESS Section B Sta. 3+50 to 59+50		
Stations	Left	Right
3+00	44.00	
16+50		44.00
17+22.22	44.02	
27+25	44.03	
29+00.02		44.09
36+00	44.00	
42+50.02		44.12
43+40	44.00	
51+00	44.15	

POINTS OF ACCESS Section A Sta. 59+50 to 130+82.44		
Stations	Left	Right
59+72	44.00	
65+85		175.20
72+00	60.00	60.00
90+00	89.74	
96+15	60.02	60.17
105+50	201.76	
111+50	20.02	
118+60	60.02	60.00
128+08.44	40.00	
130+58.44		16.00

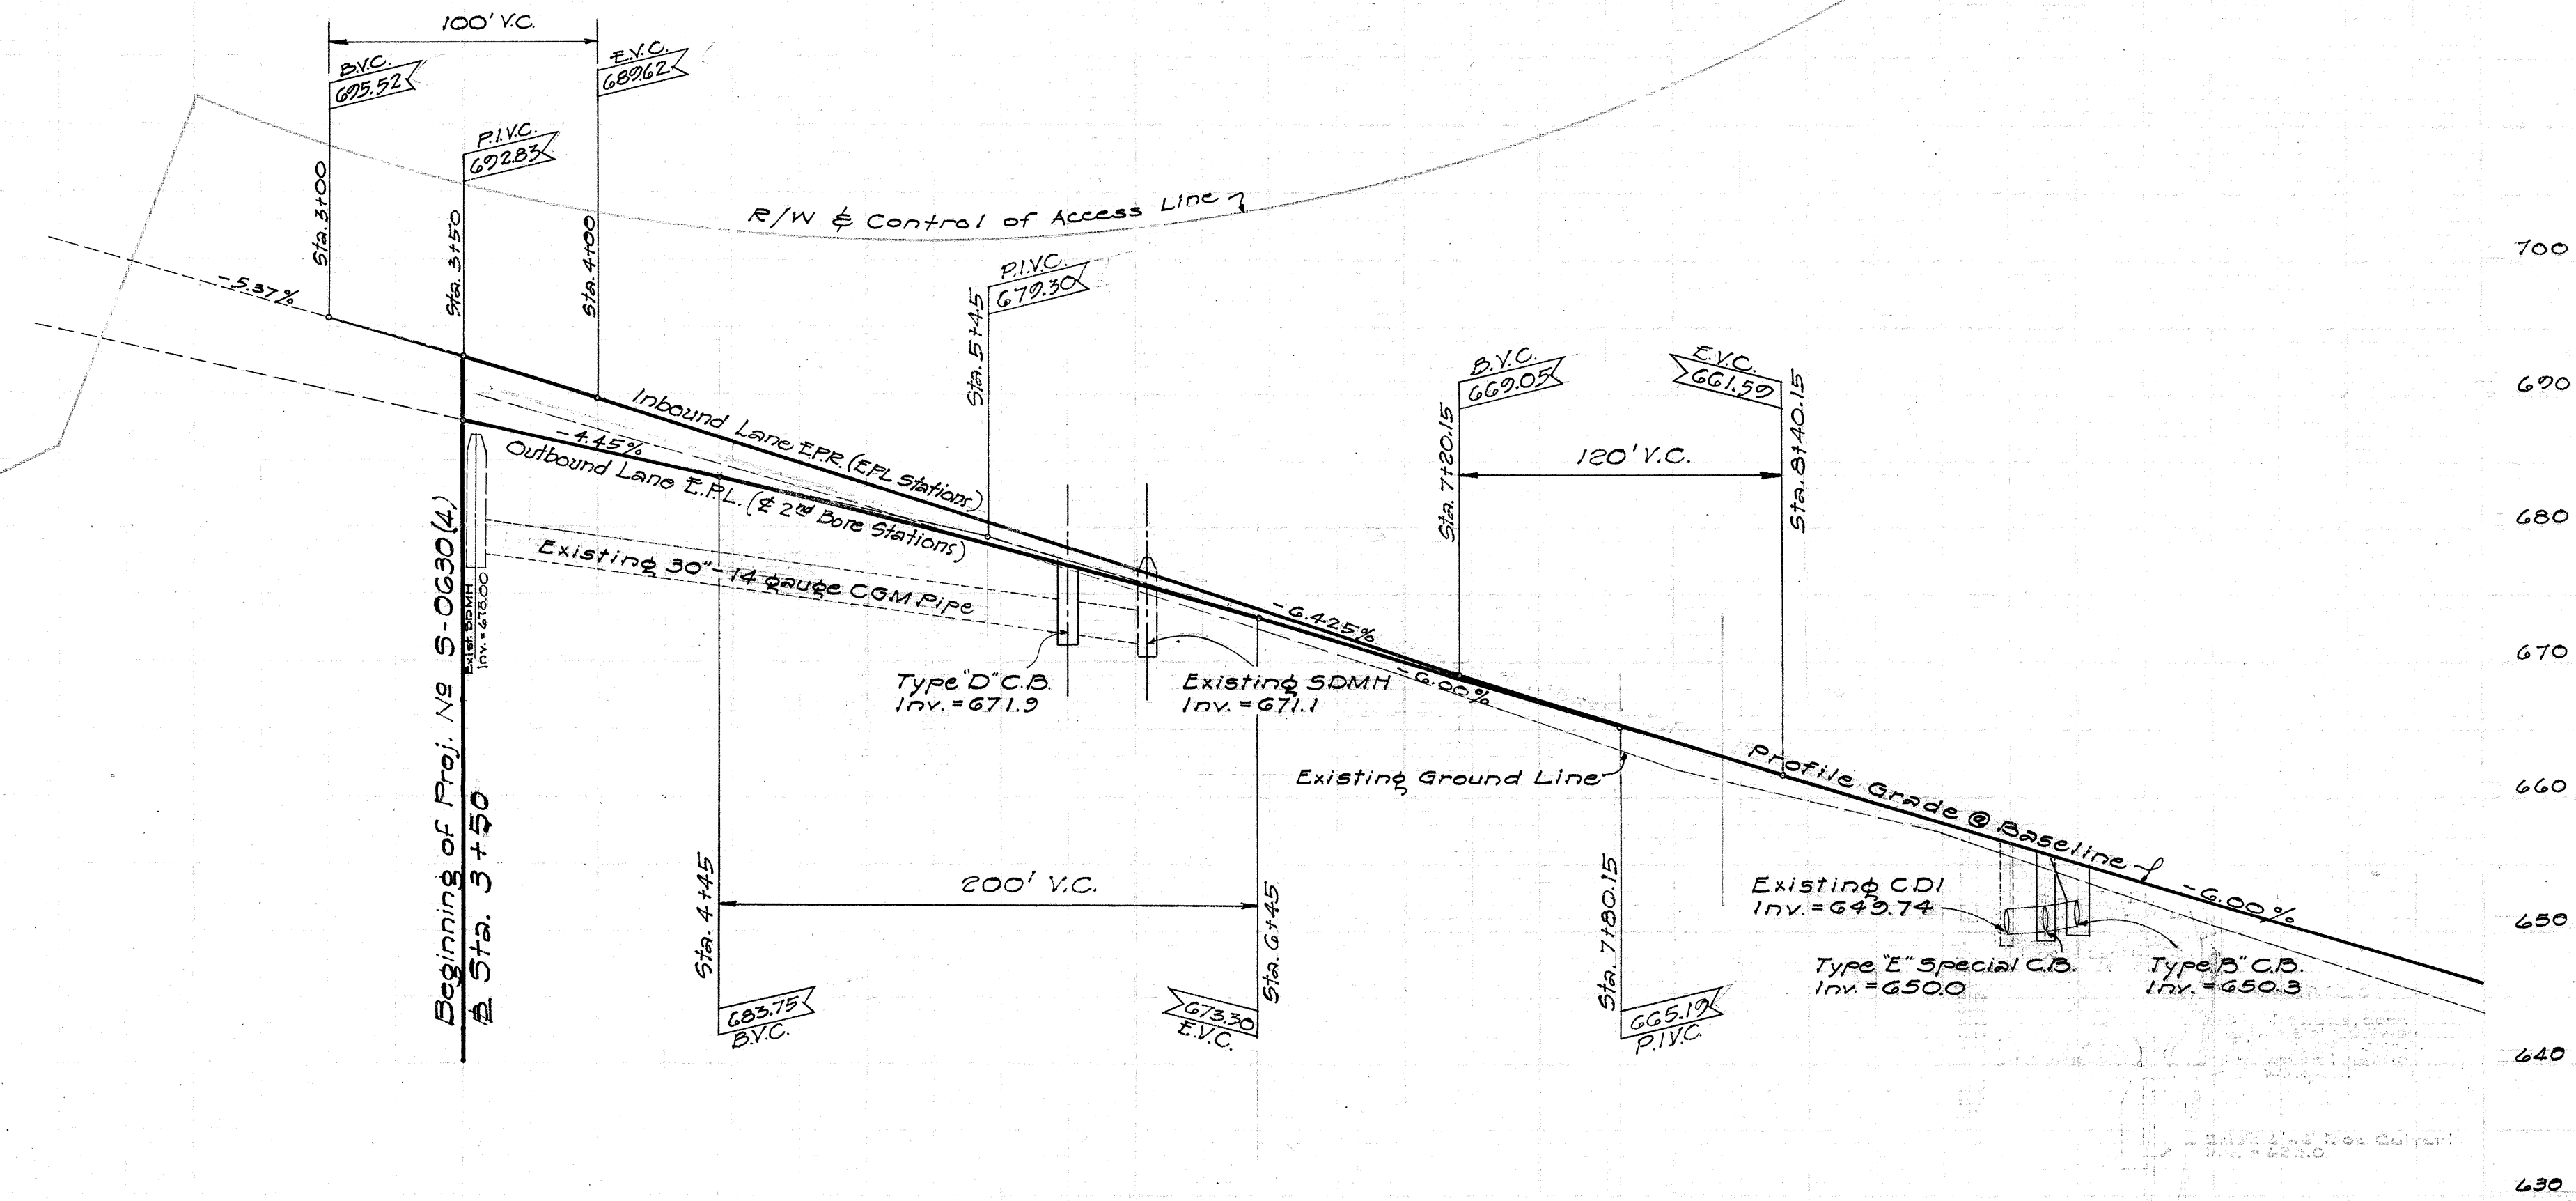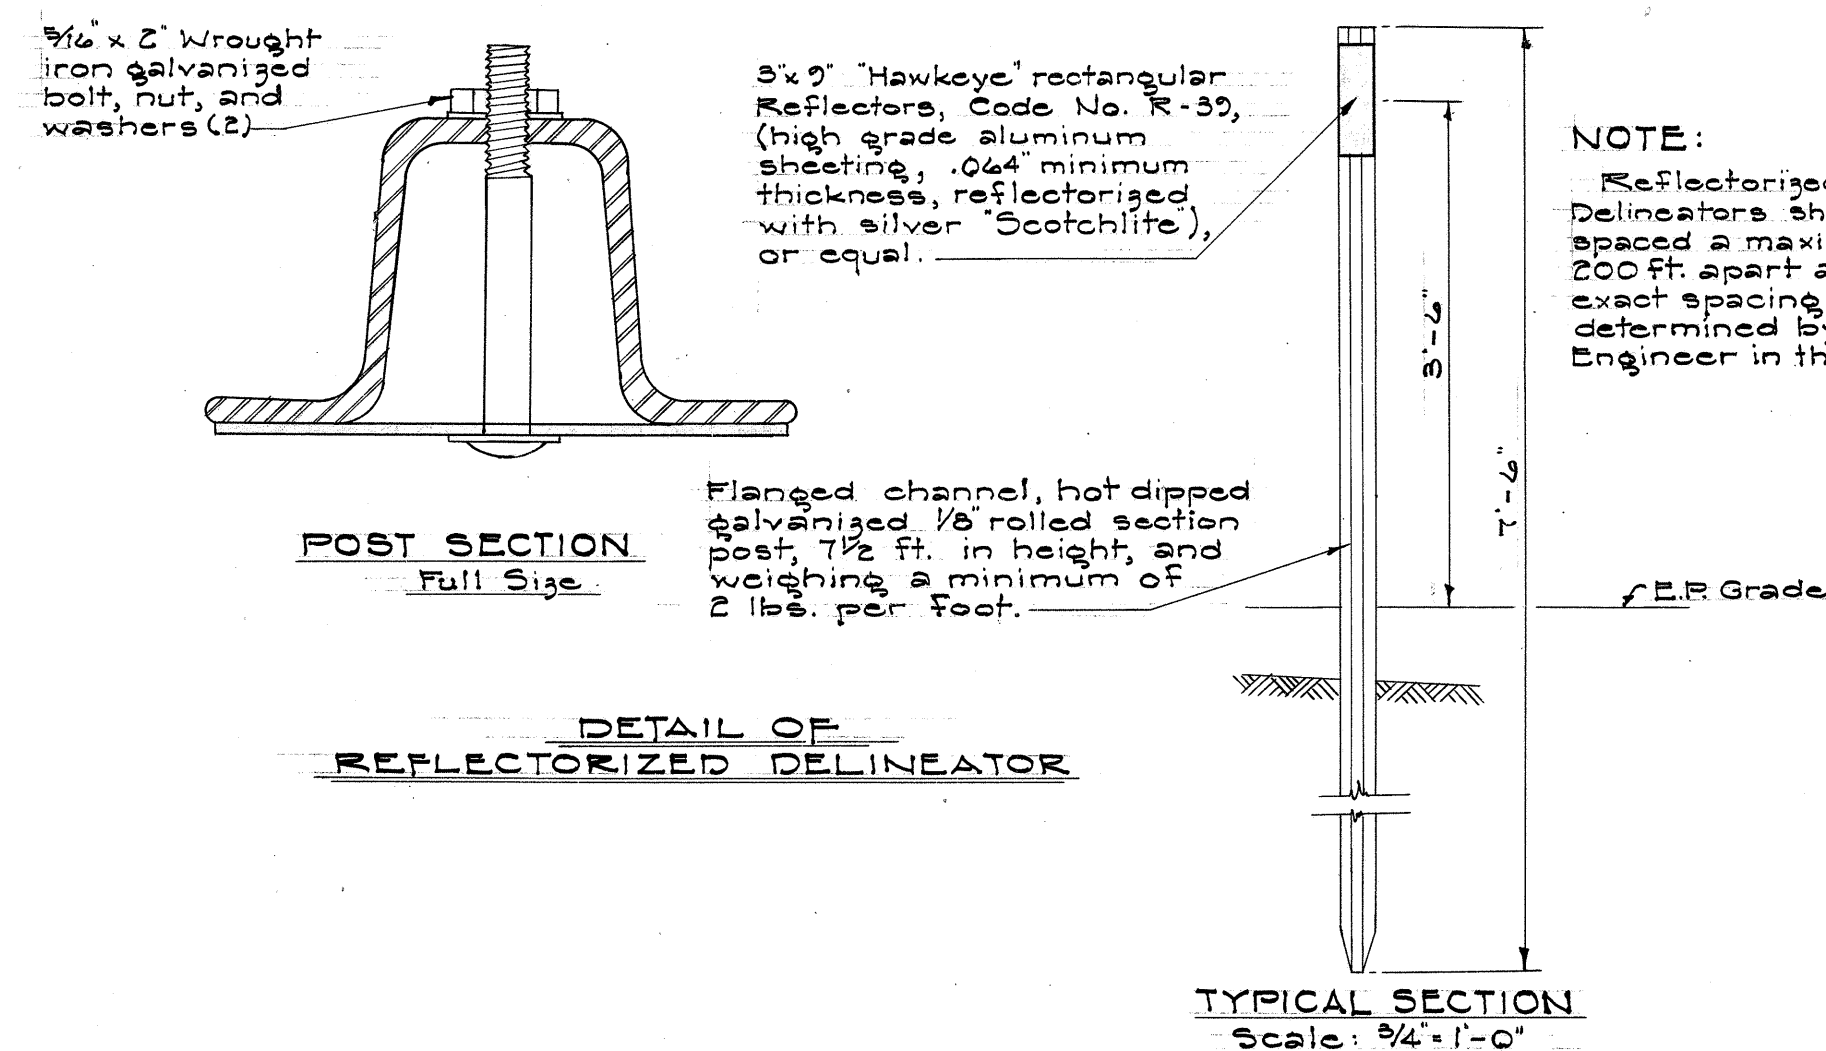


FED. ROAD DIST. No.	STATE	FED. AID PROJ. No.	FISCAL YEAR	SHEET No.	TOTAL SHEETS
HAWAII	HAW.	5-0690(4)	1990	5	47

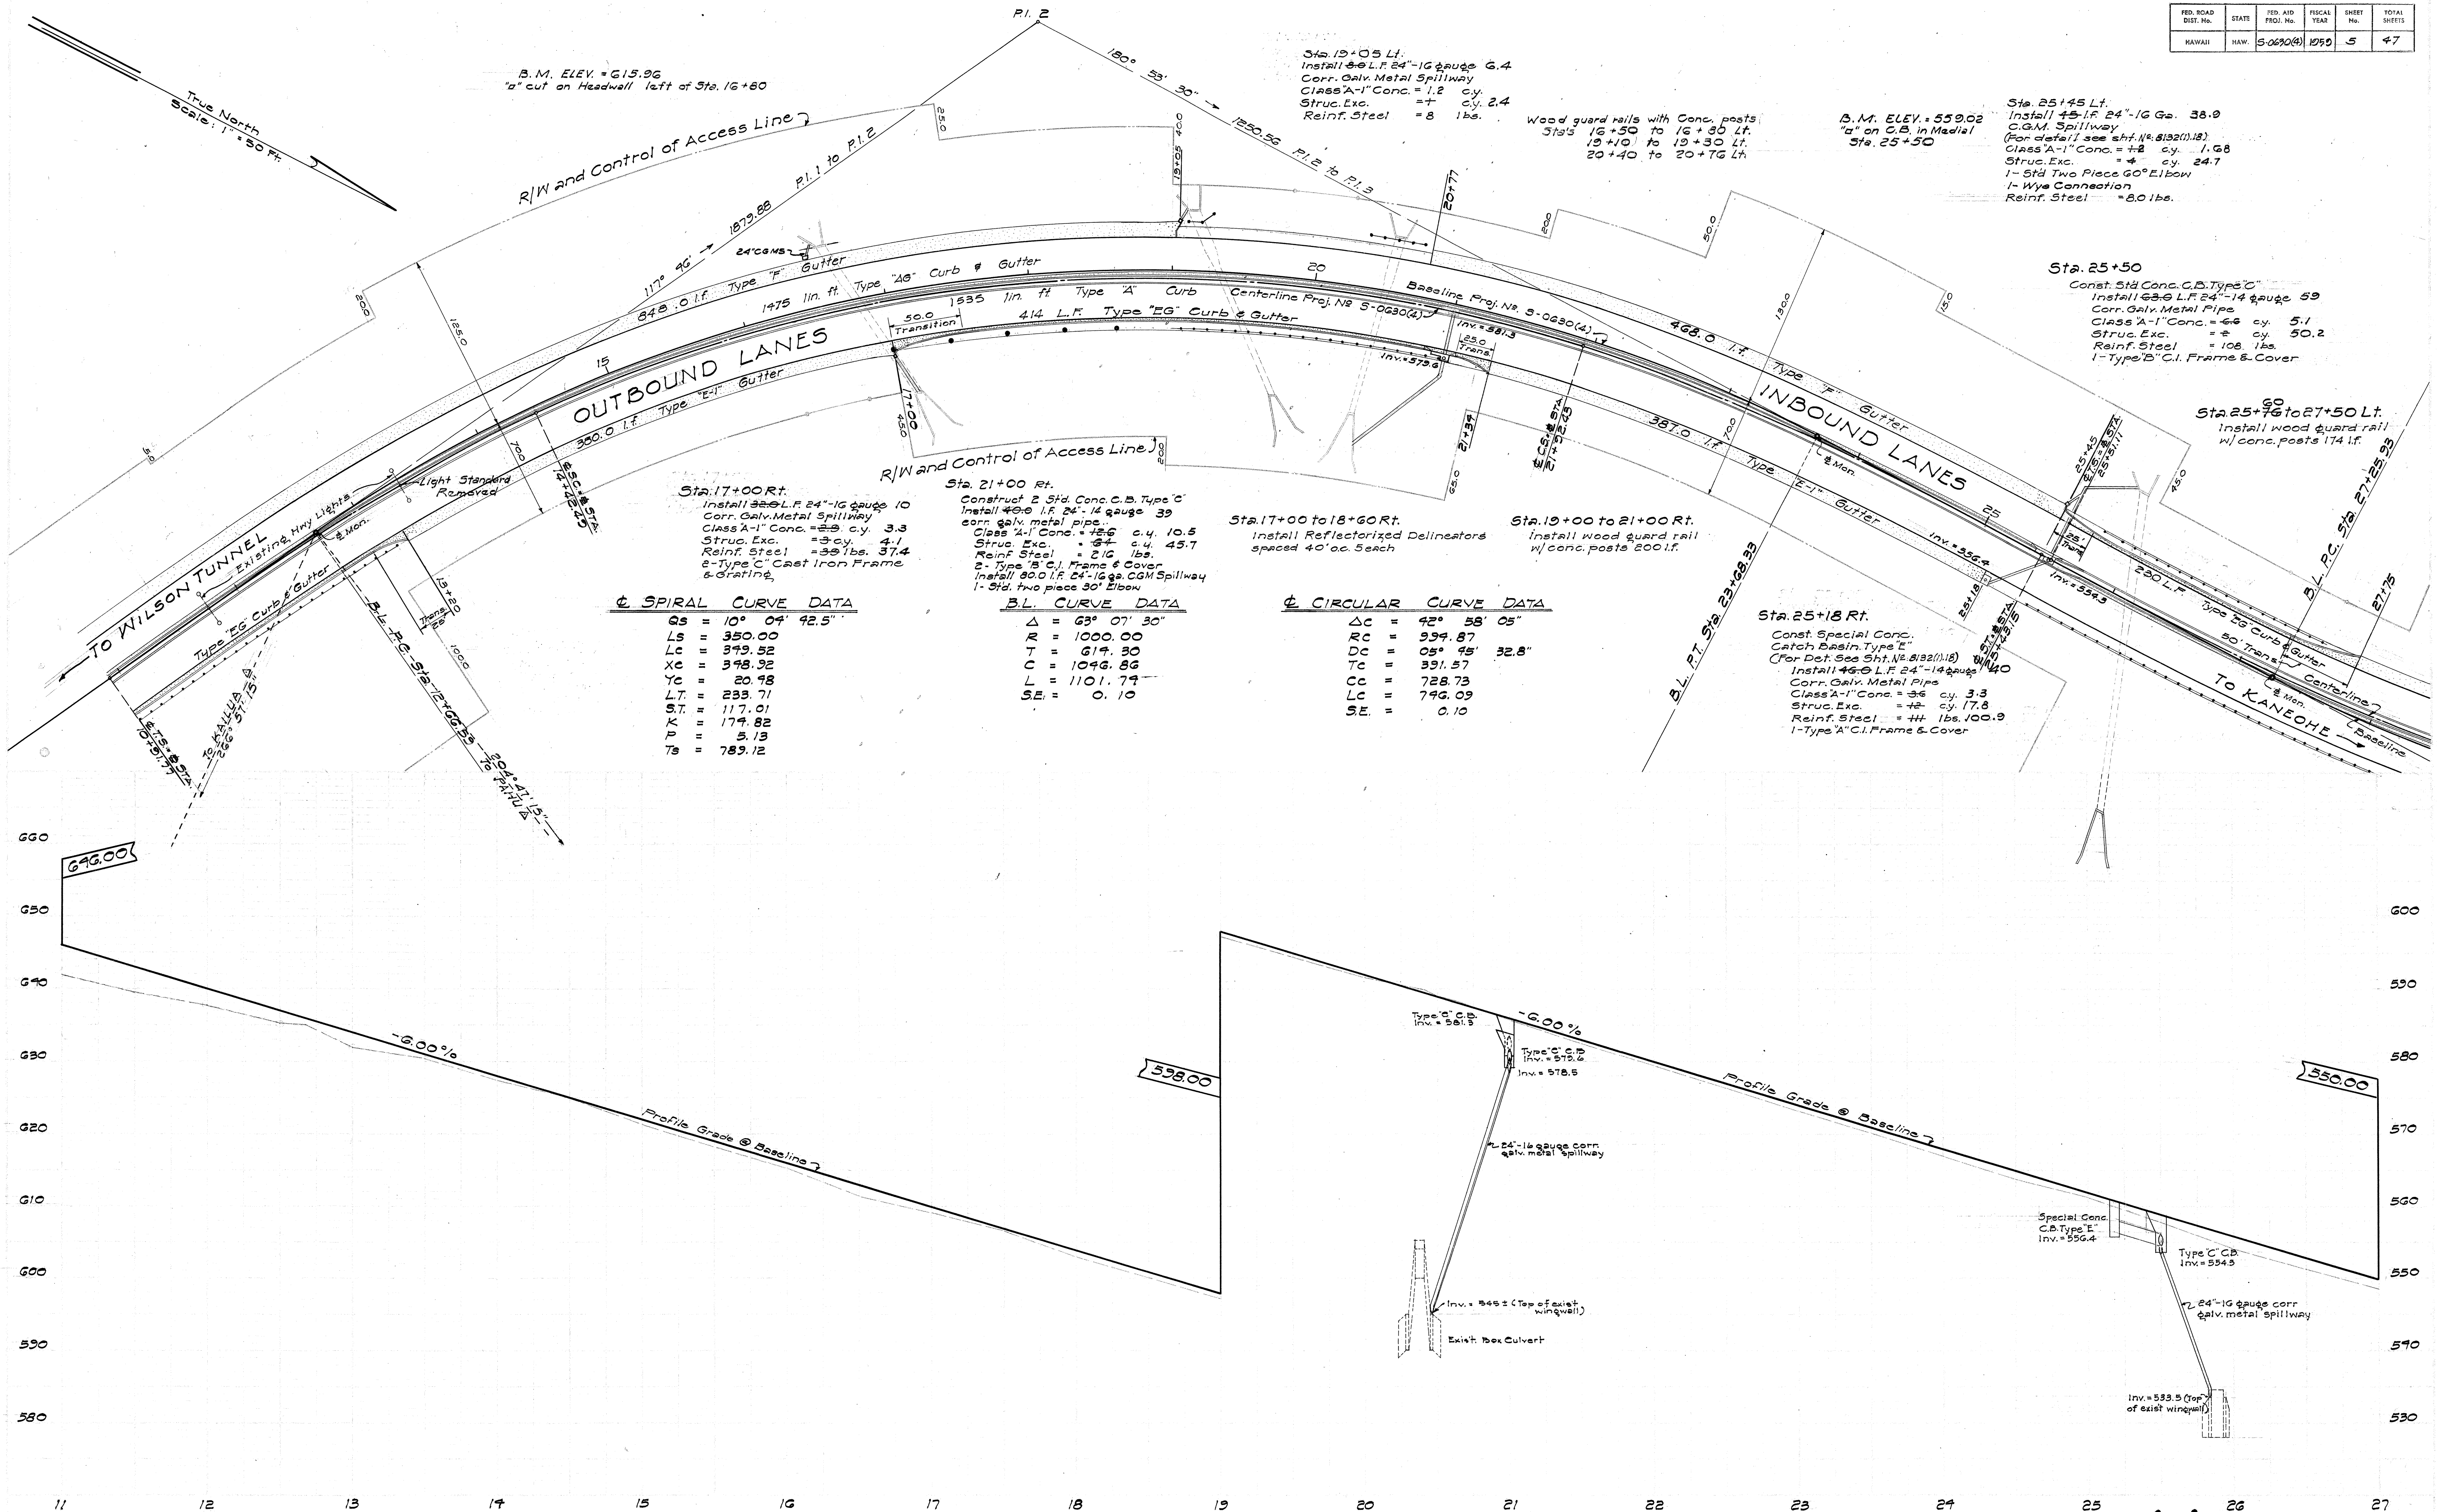


S132 (1).5

FED. ROAD DIST. No.	STATE	FED. AID PROJ. No.	FISCAL YEAR	SHEET No.	TOTAL SHEETS
HAWAII	HAW.	5-0690(4)	1959	6	47

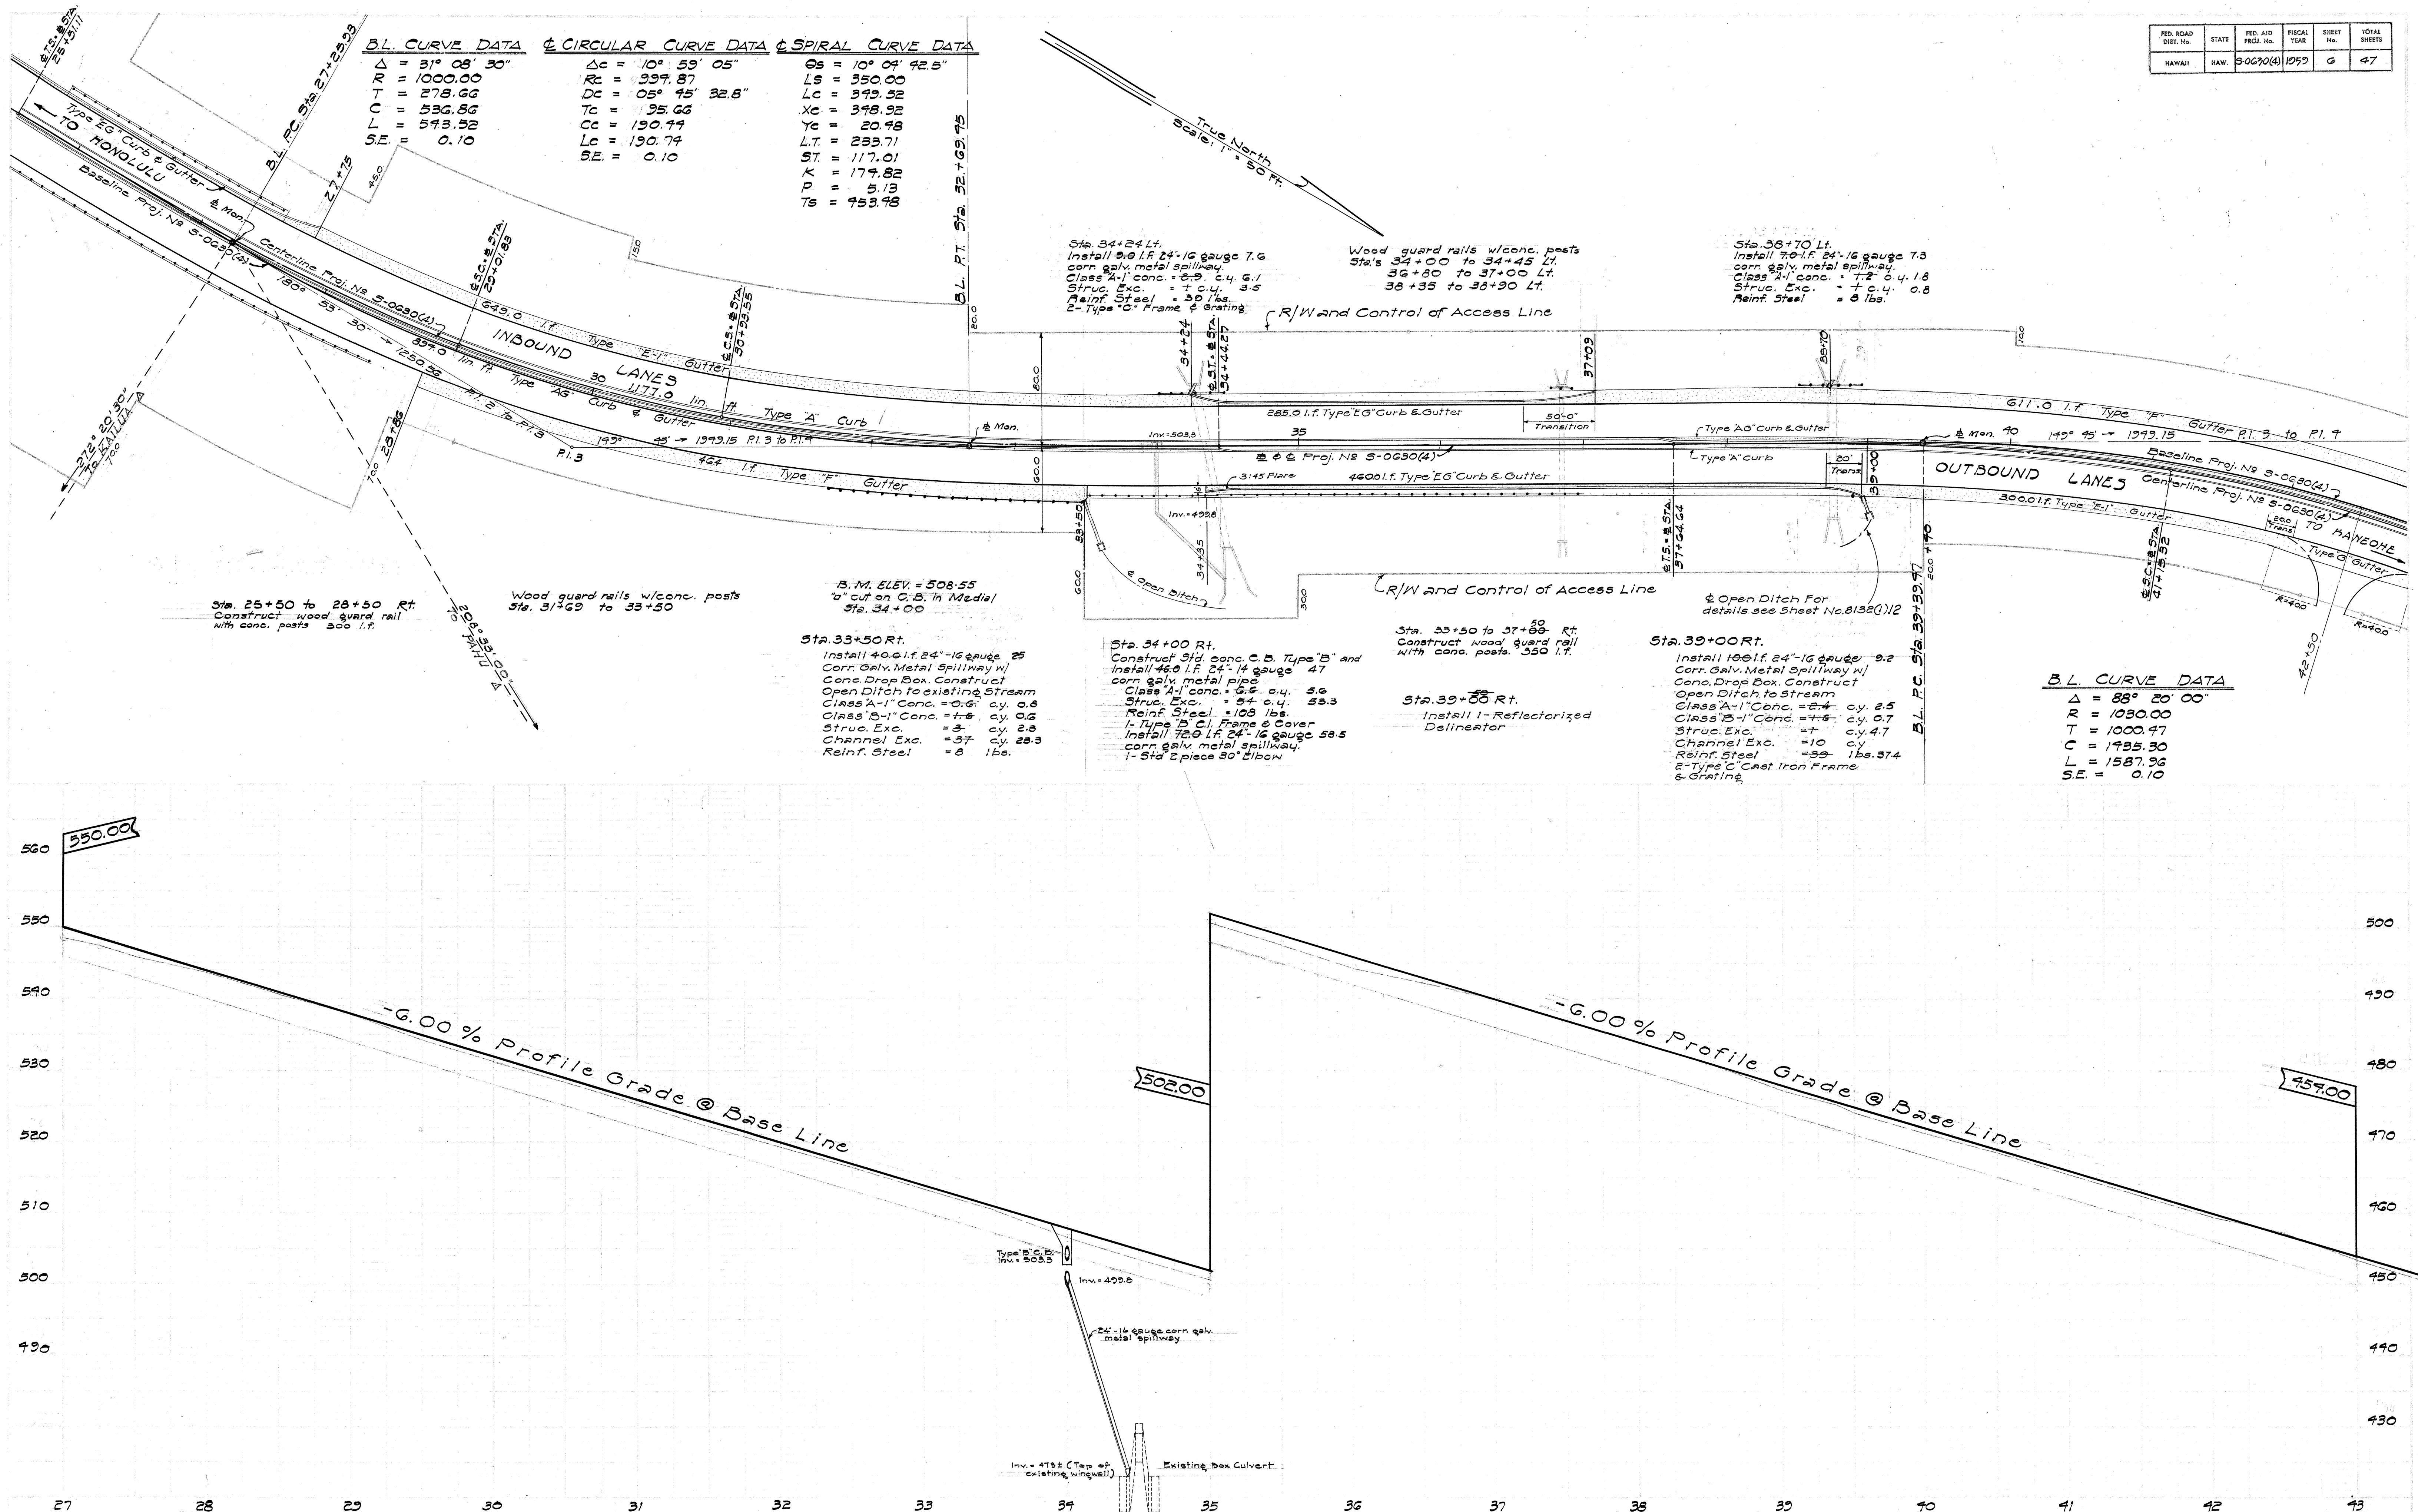



S 132 (1). 6

FED. ROAD DIST. No.	STATE	FED. AID PROJ. No.	FISCAL YEAR	SHEET No.	TOTAL SHEETS
HAWAII	HAW.	S-0630(4)	1959	7	47

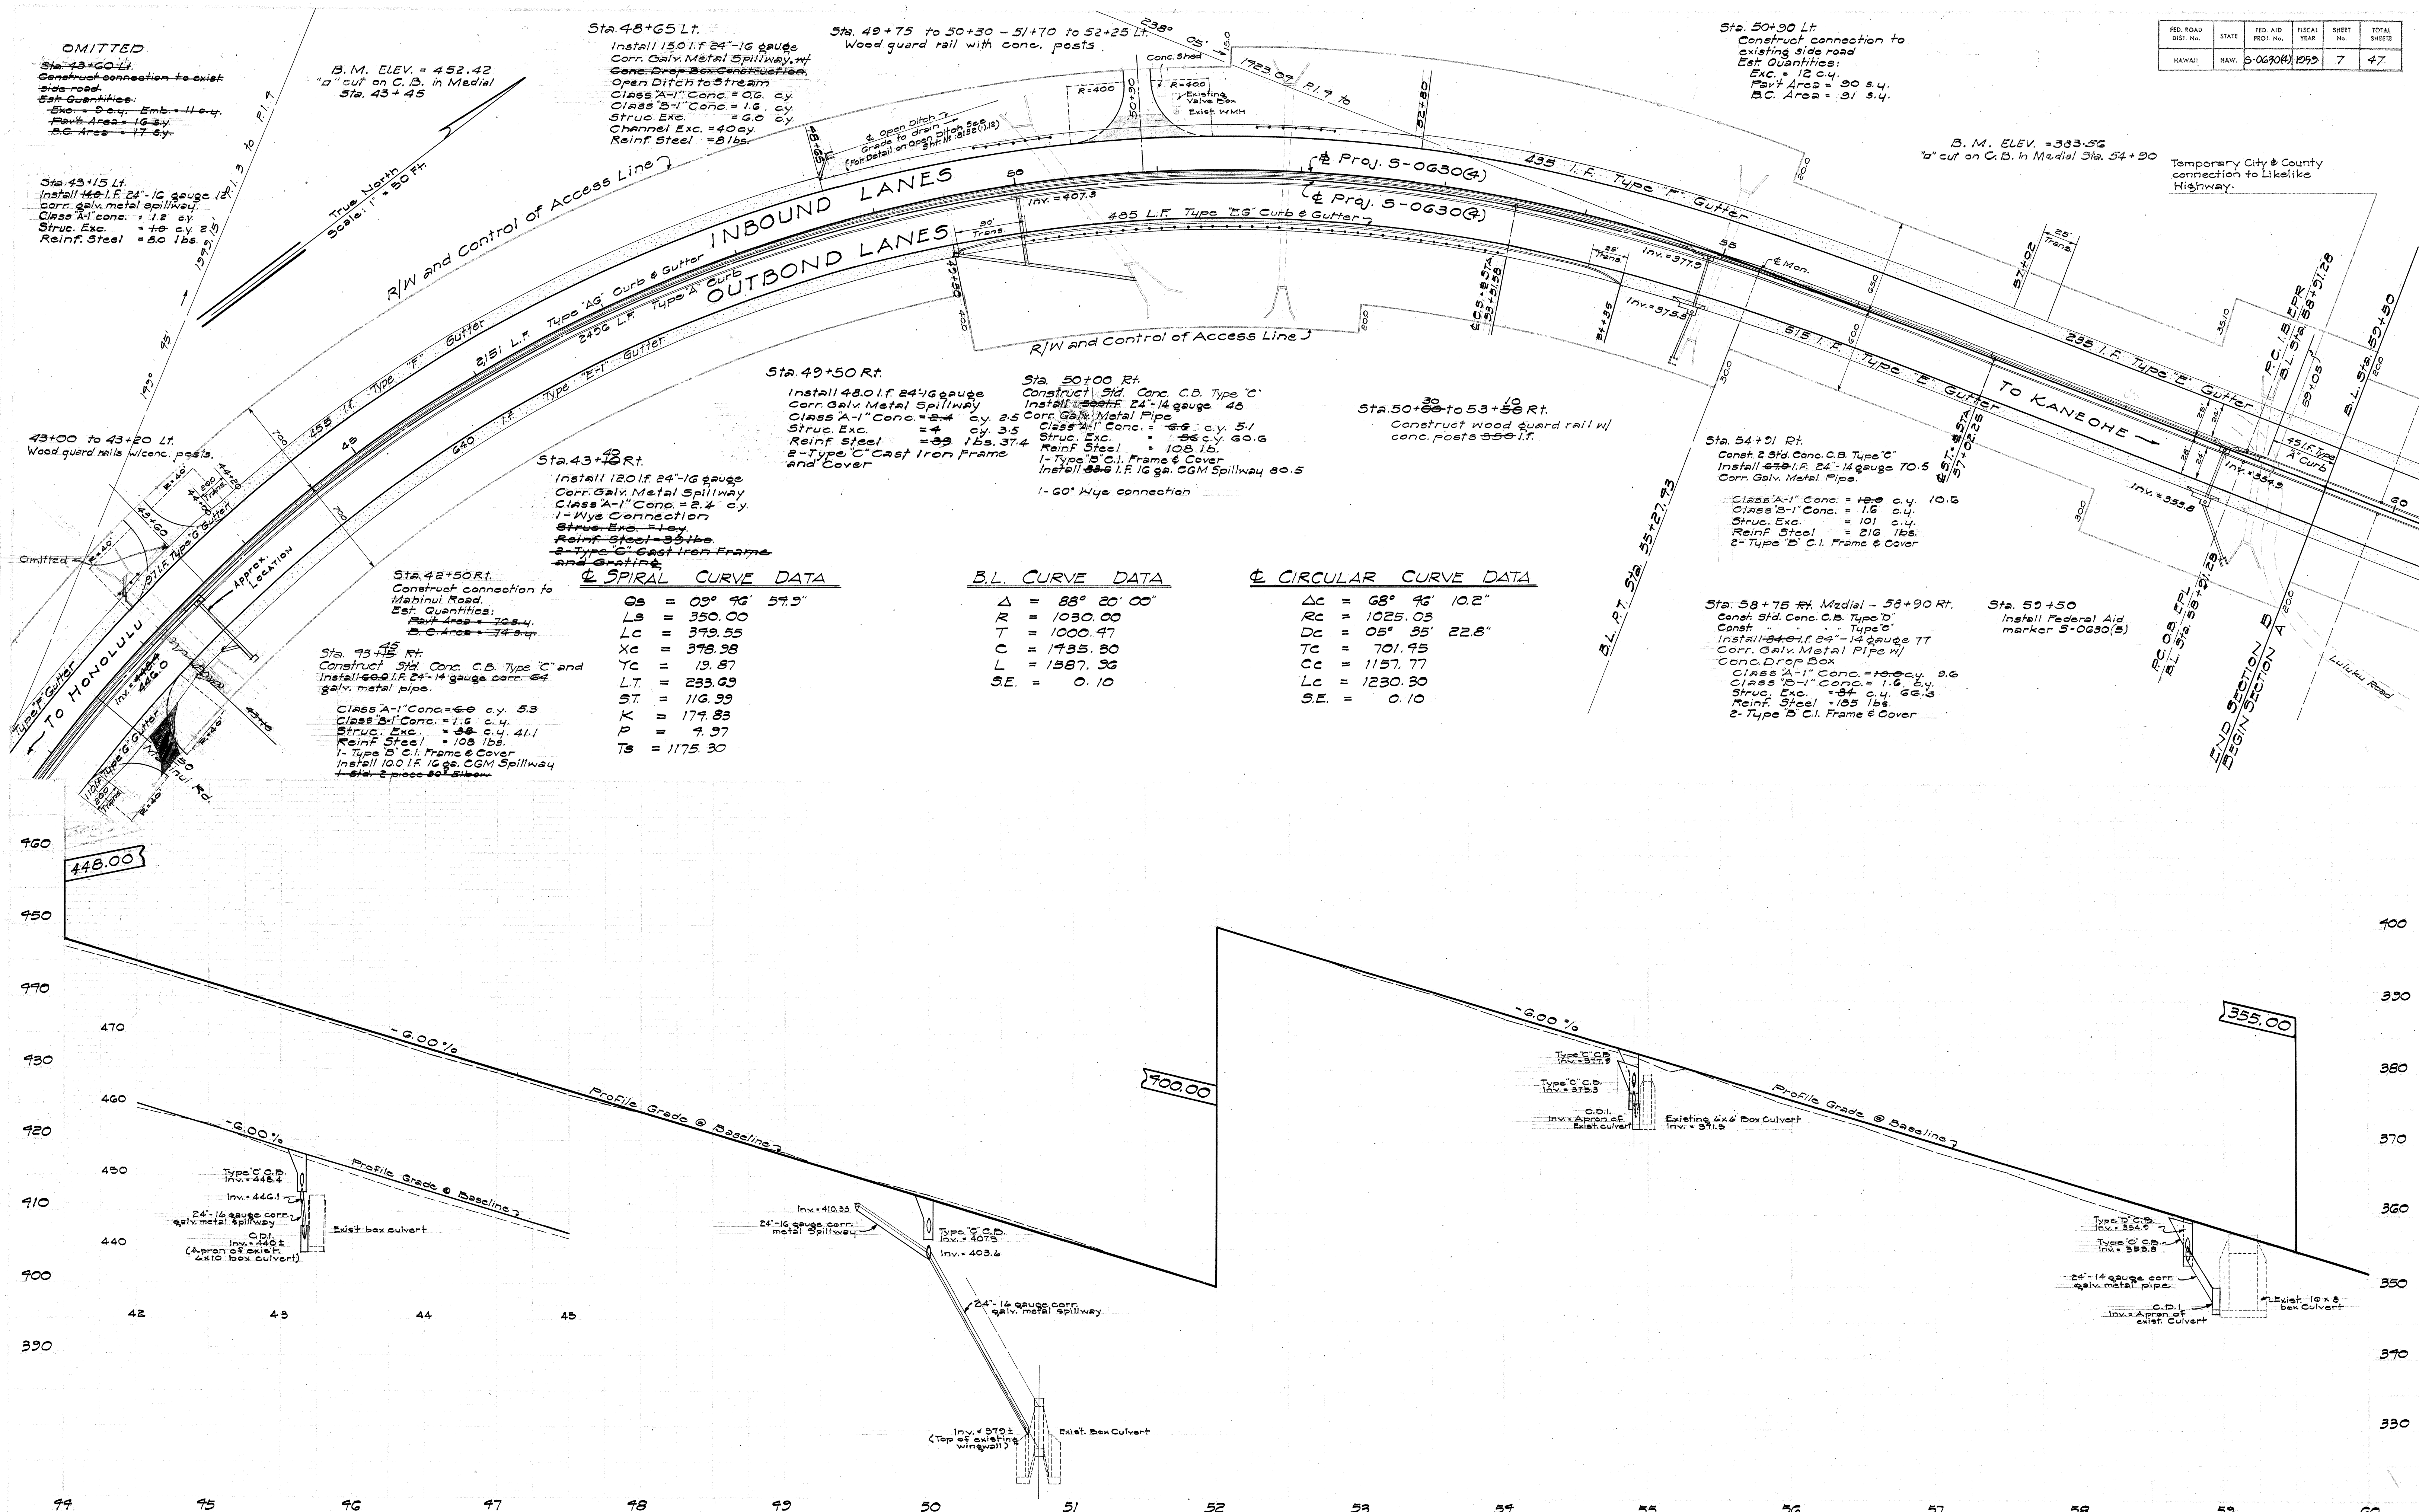

S132 (1).7

FED. ROAD DIST. NO.	STATE	FED. AID PROJ. NO.	FISCAL YEAR	SHEET NO.	TOTAL SHEET
HAWAII	HAW.	5-0630(4)	1959	9	47

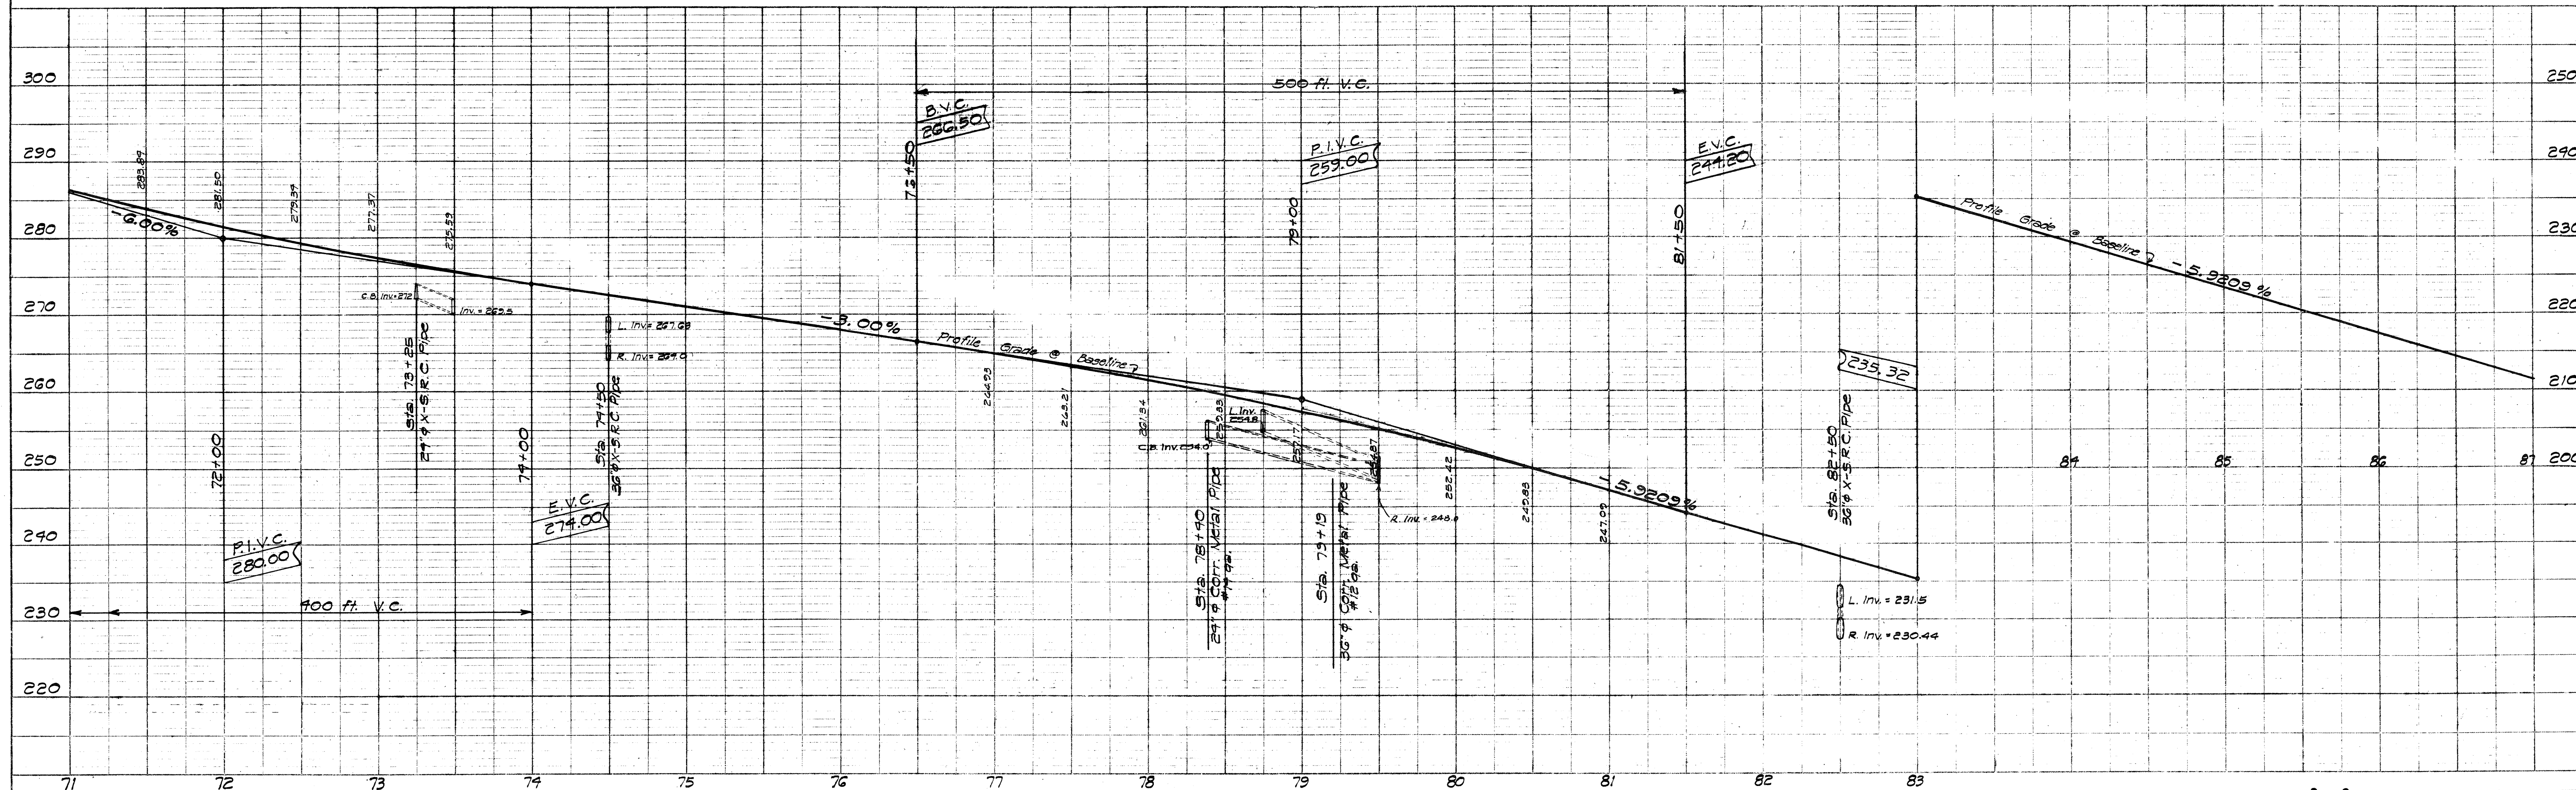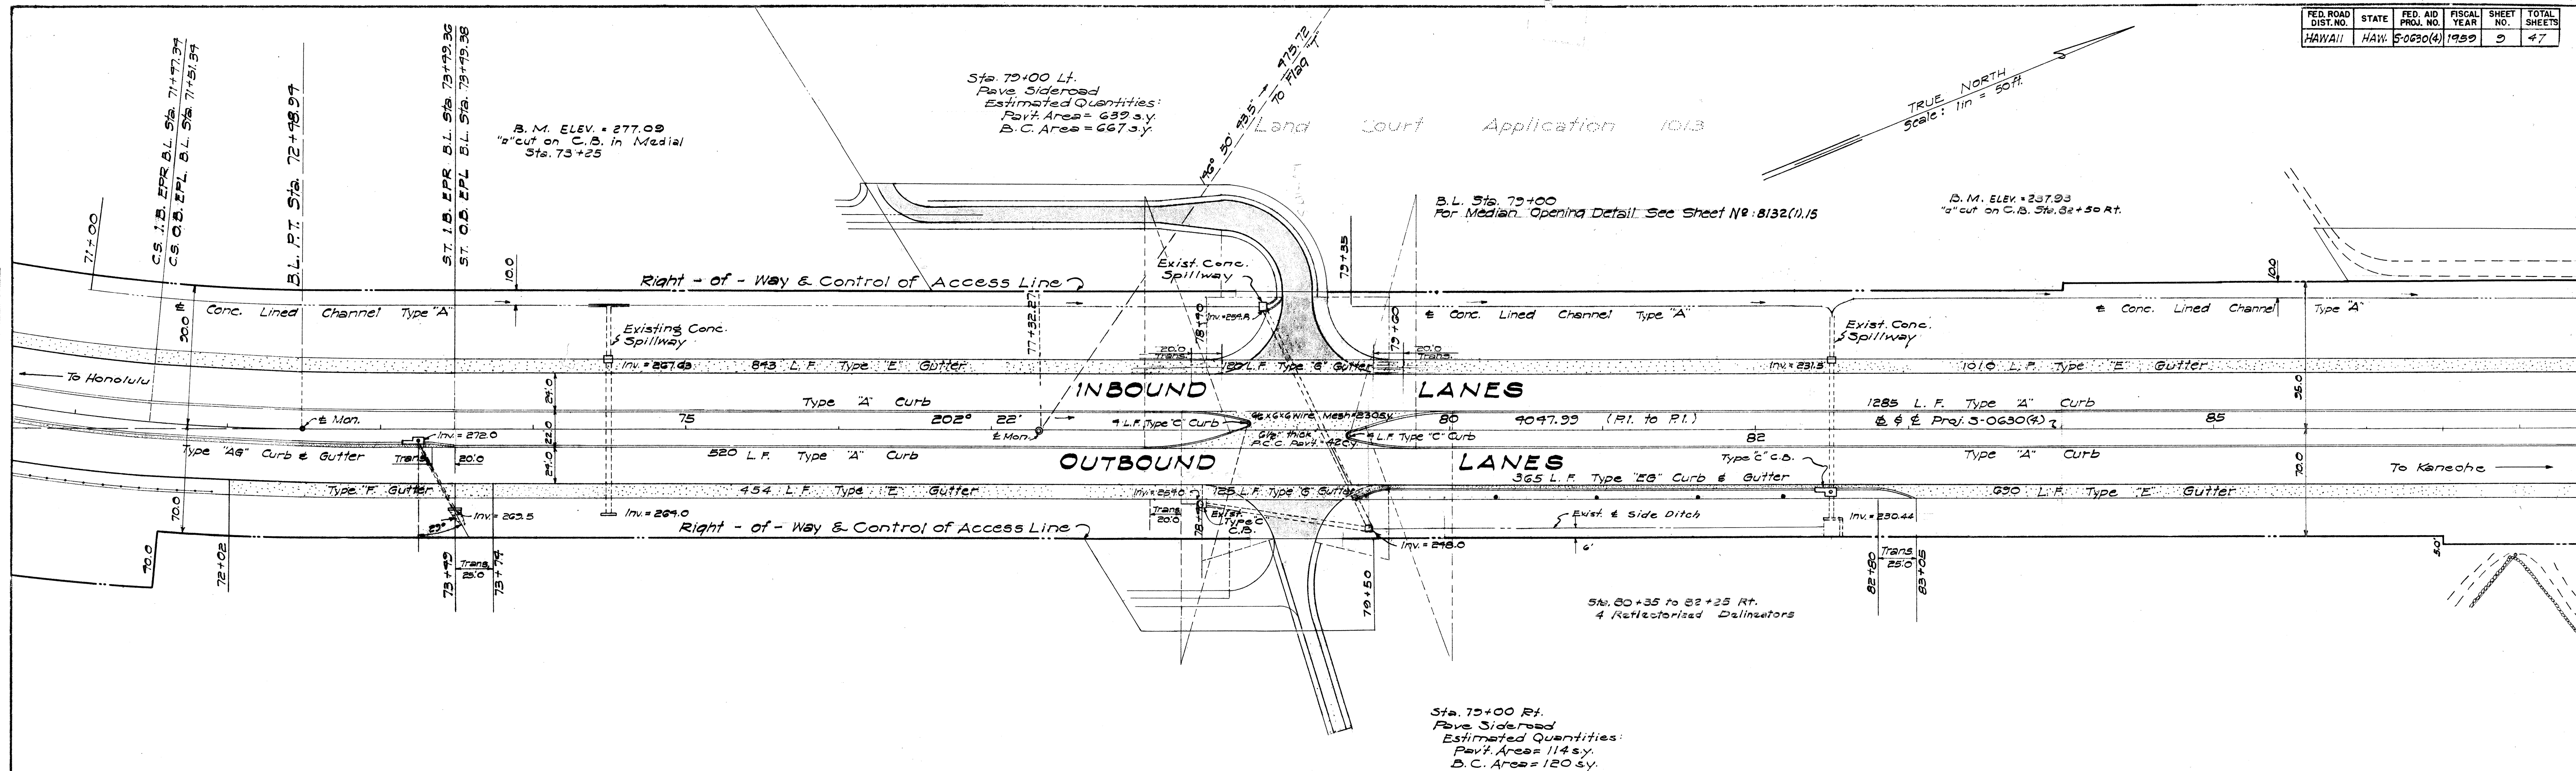

FED. ROAD DIST. NO.	STATE	FED. AID PROJ. NO.	FISCAL YEAR	SHEET NO.	TOTAL SHEETS
HAWAII	HAW.	S-0690(4)	1959	11	47

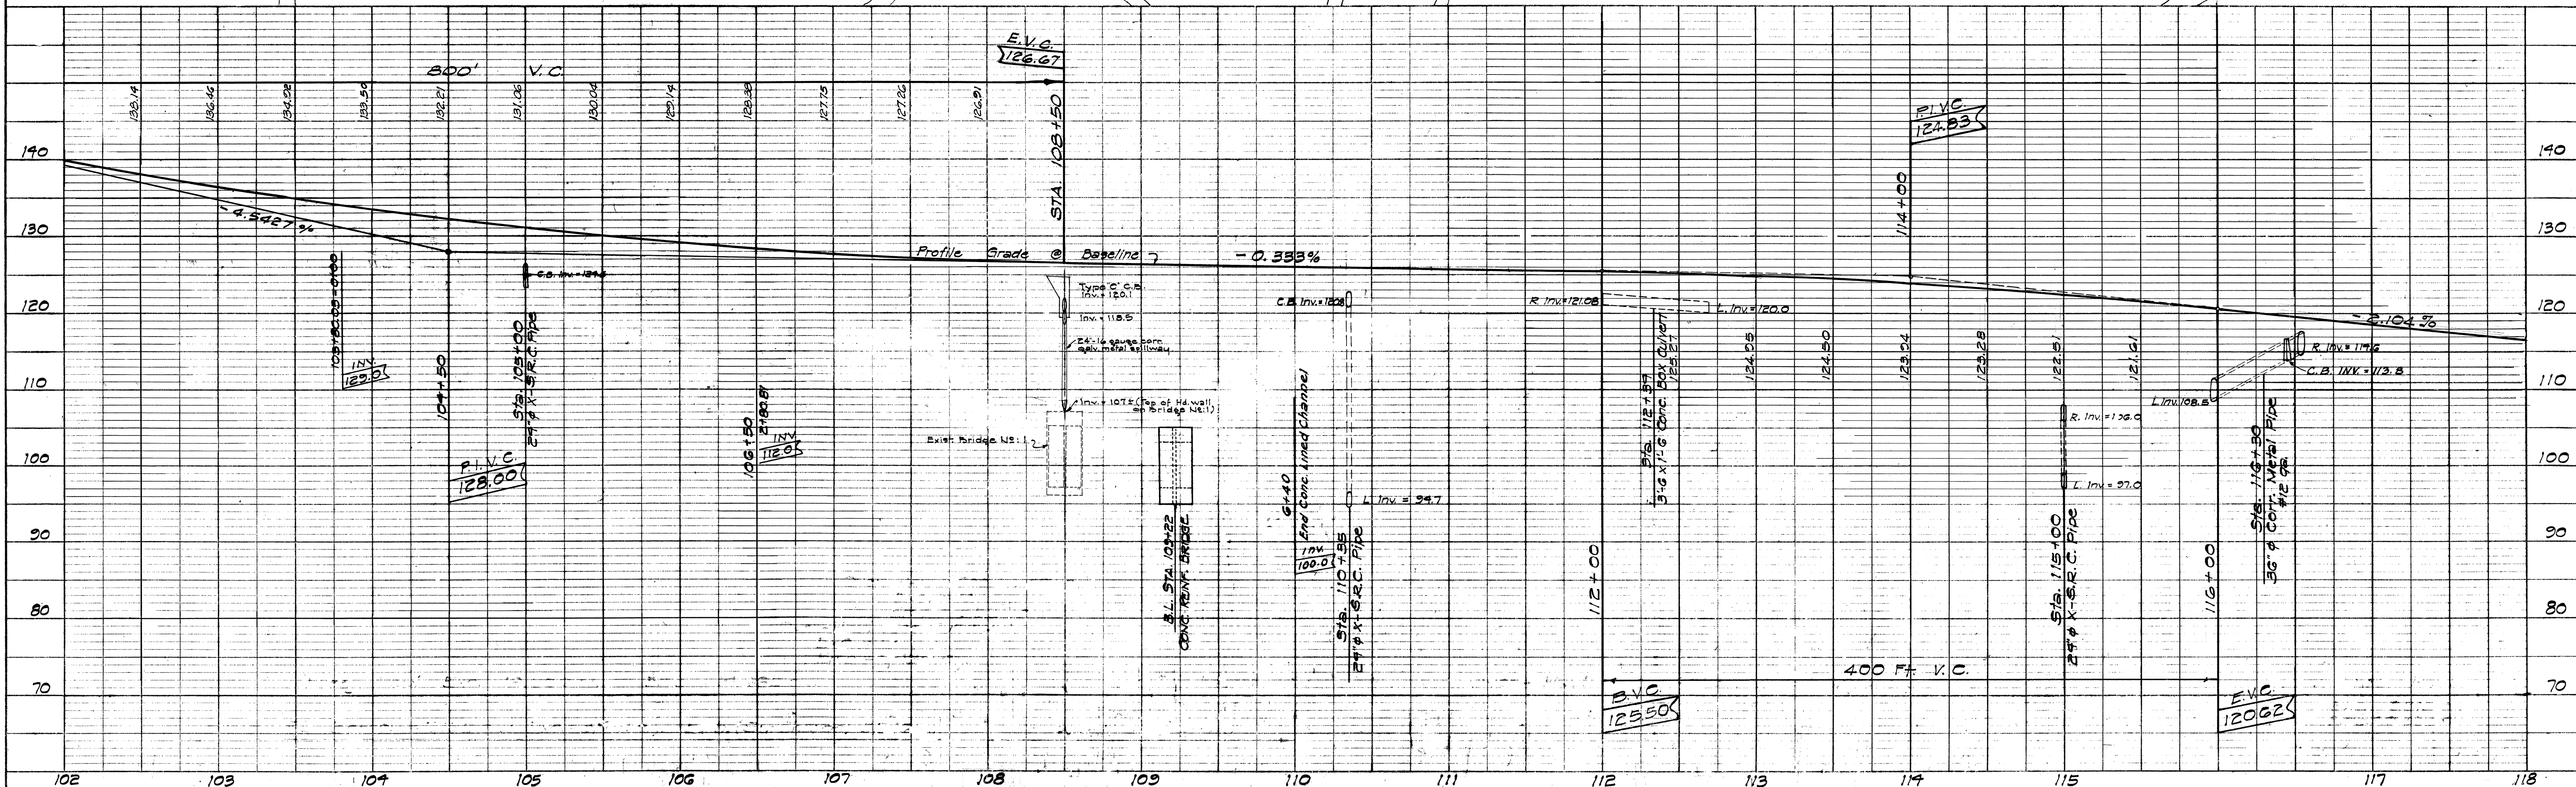
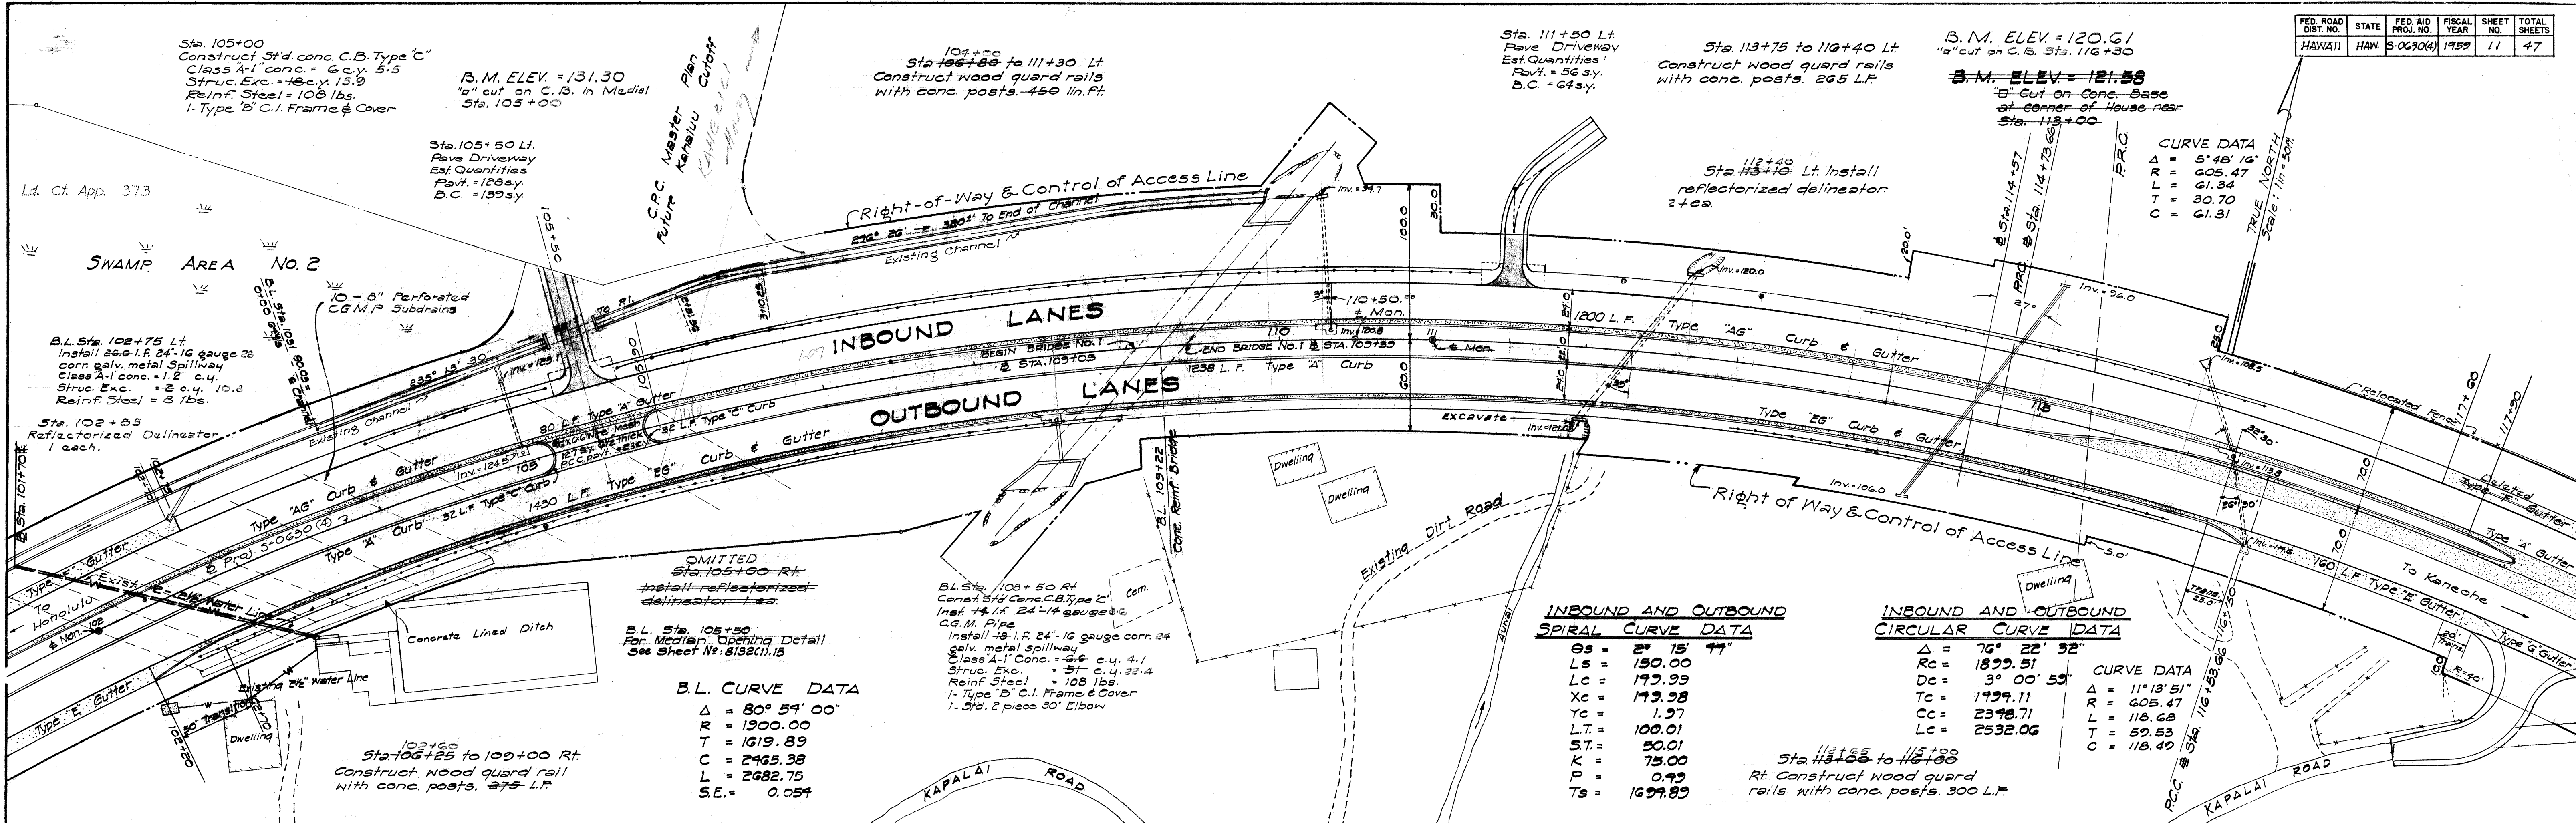


PLATE 1-PLAN-PROFILE D.P.R. & R.E. STANDARD
KEUFFEL & ESSER CO., NEW YORK
K & E Co. No. 346-9C
COPYRIGHT 1959

S 132 (1).11

PLAN	DATE
BY	
CHECKED	
NO.	

PROFILE	DATE
BY	
CHECKED	
NO.	

P-5

