


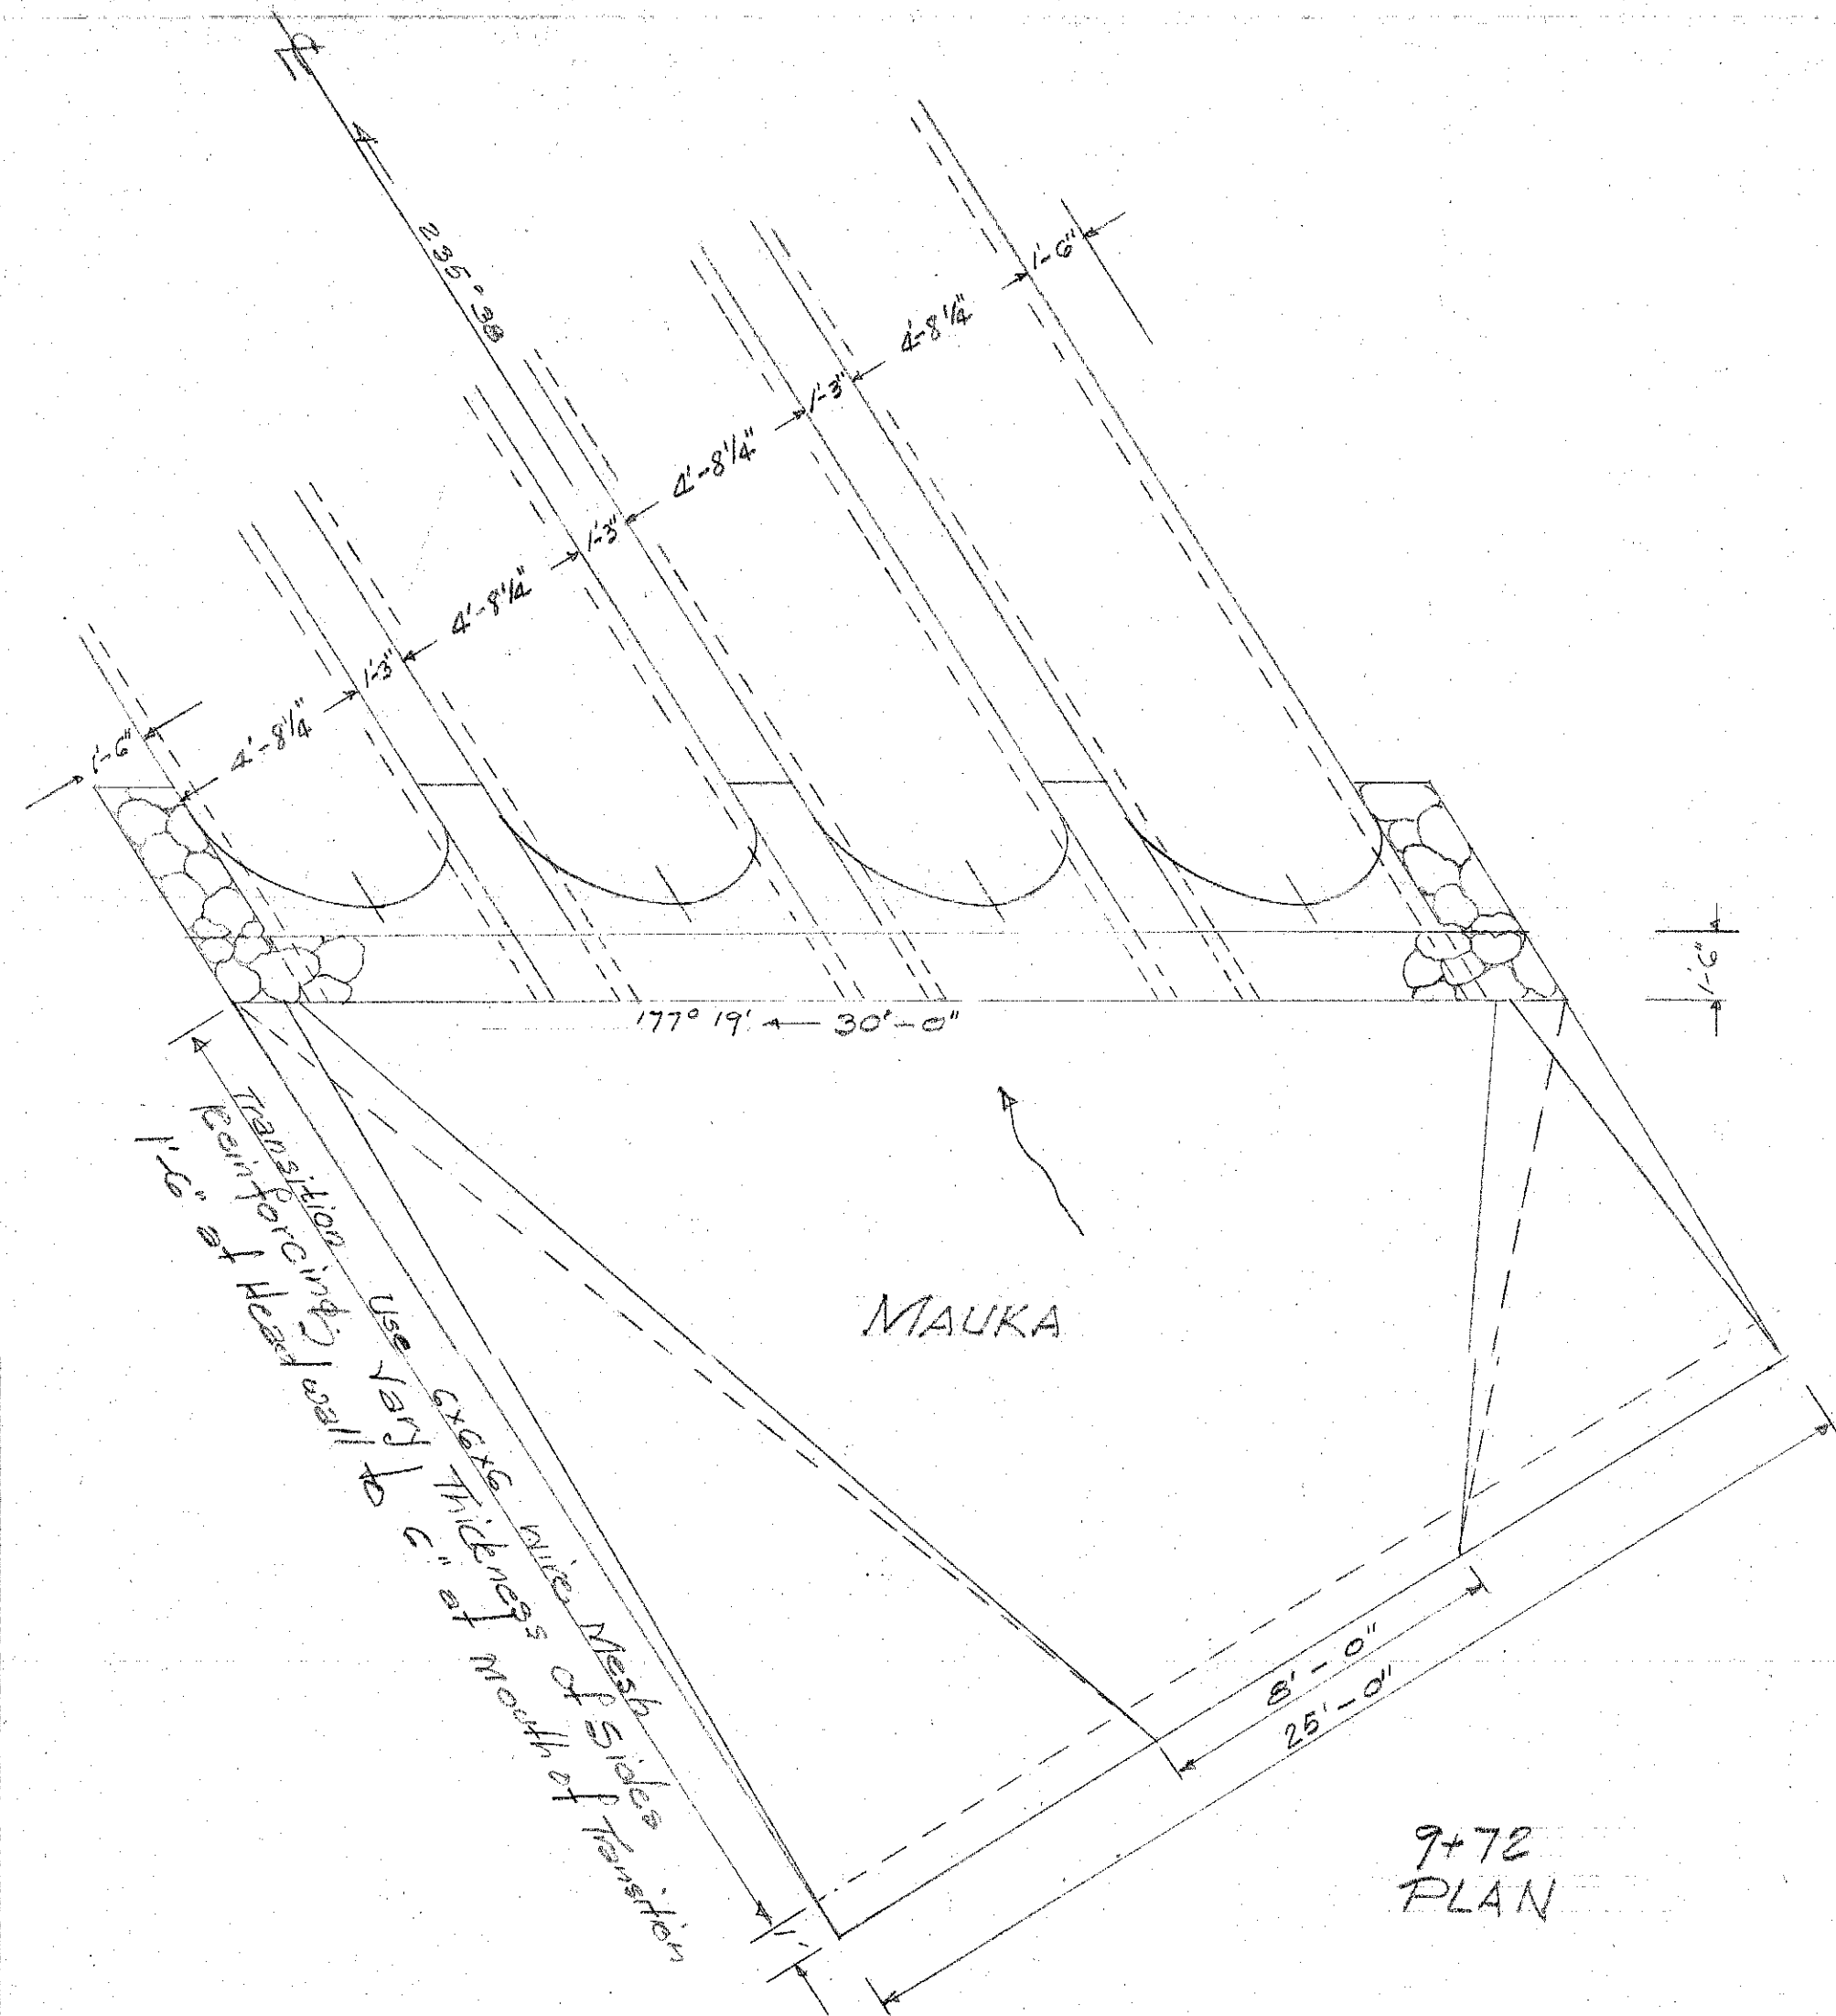


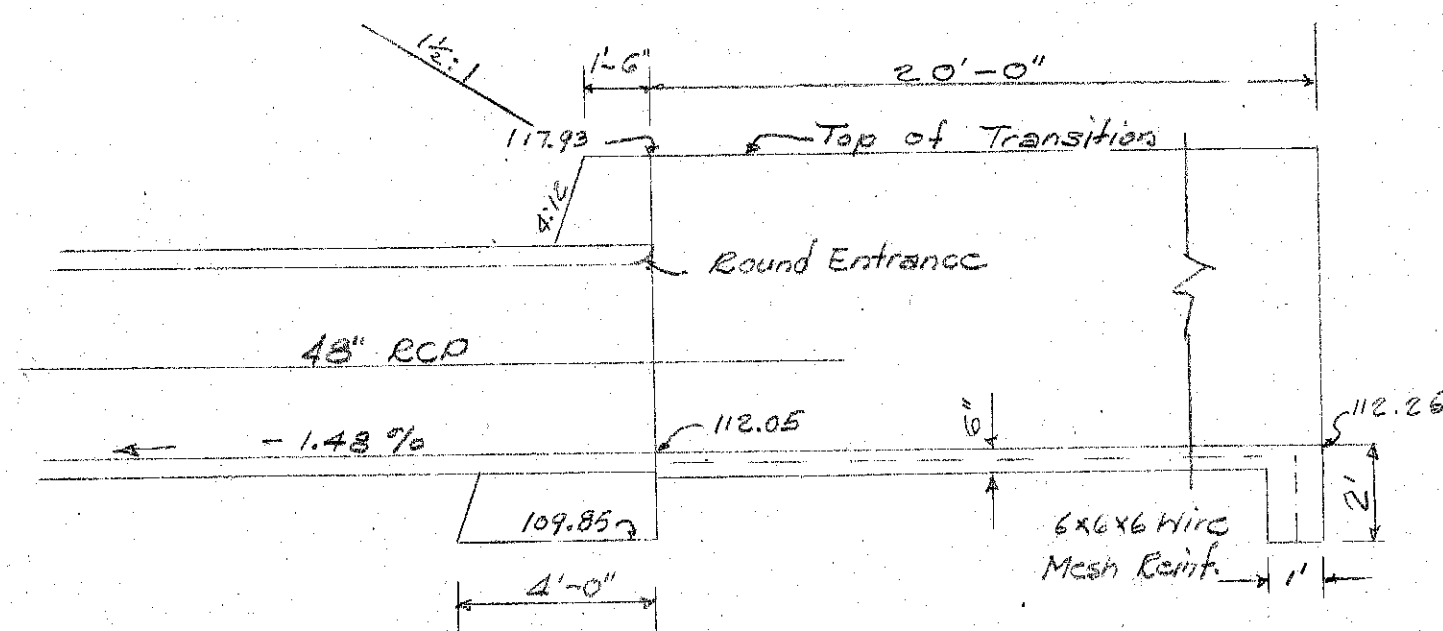


9+72
PLAN

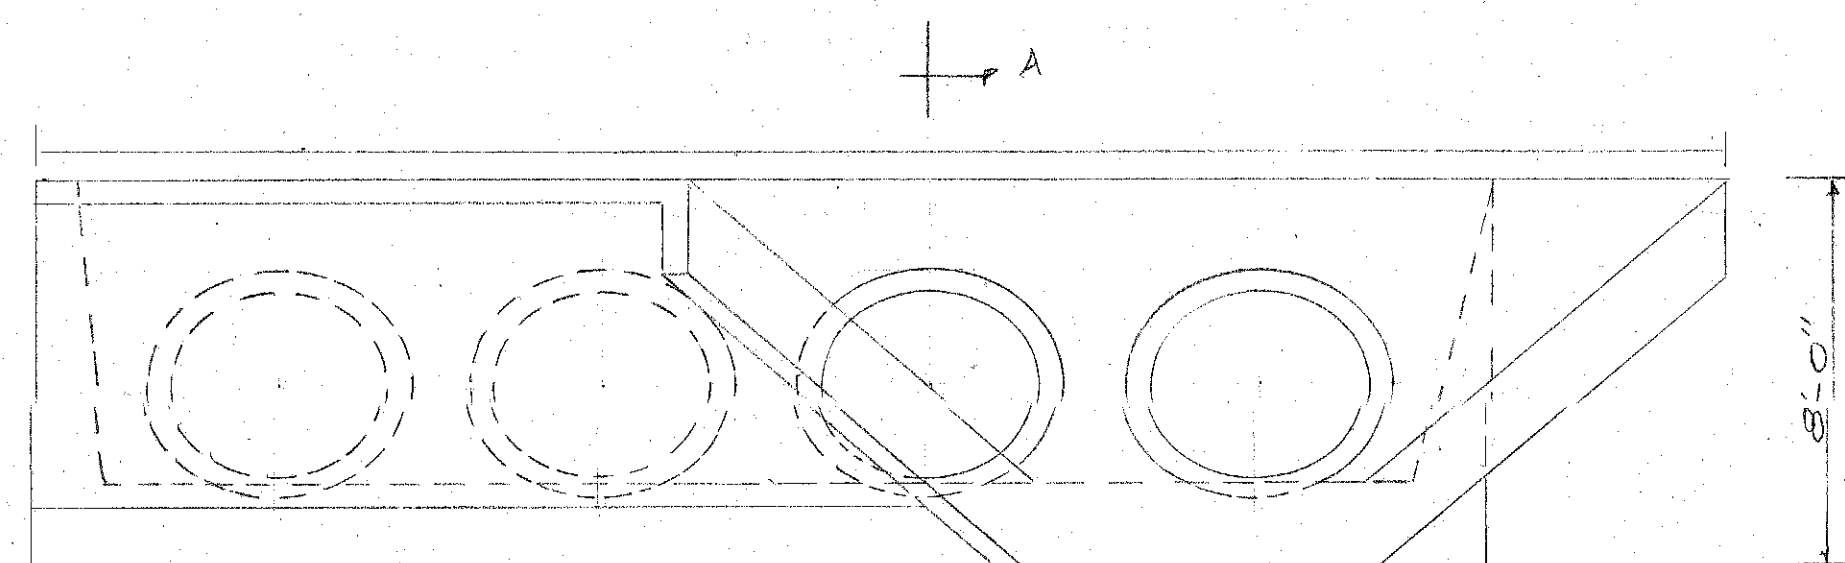


SECTION AA

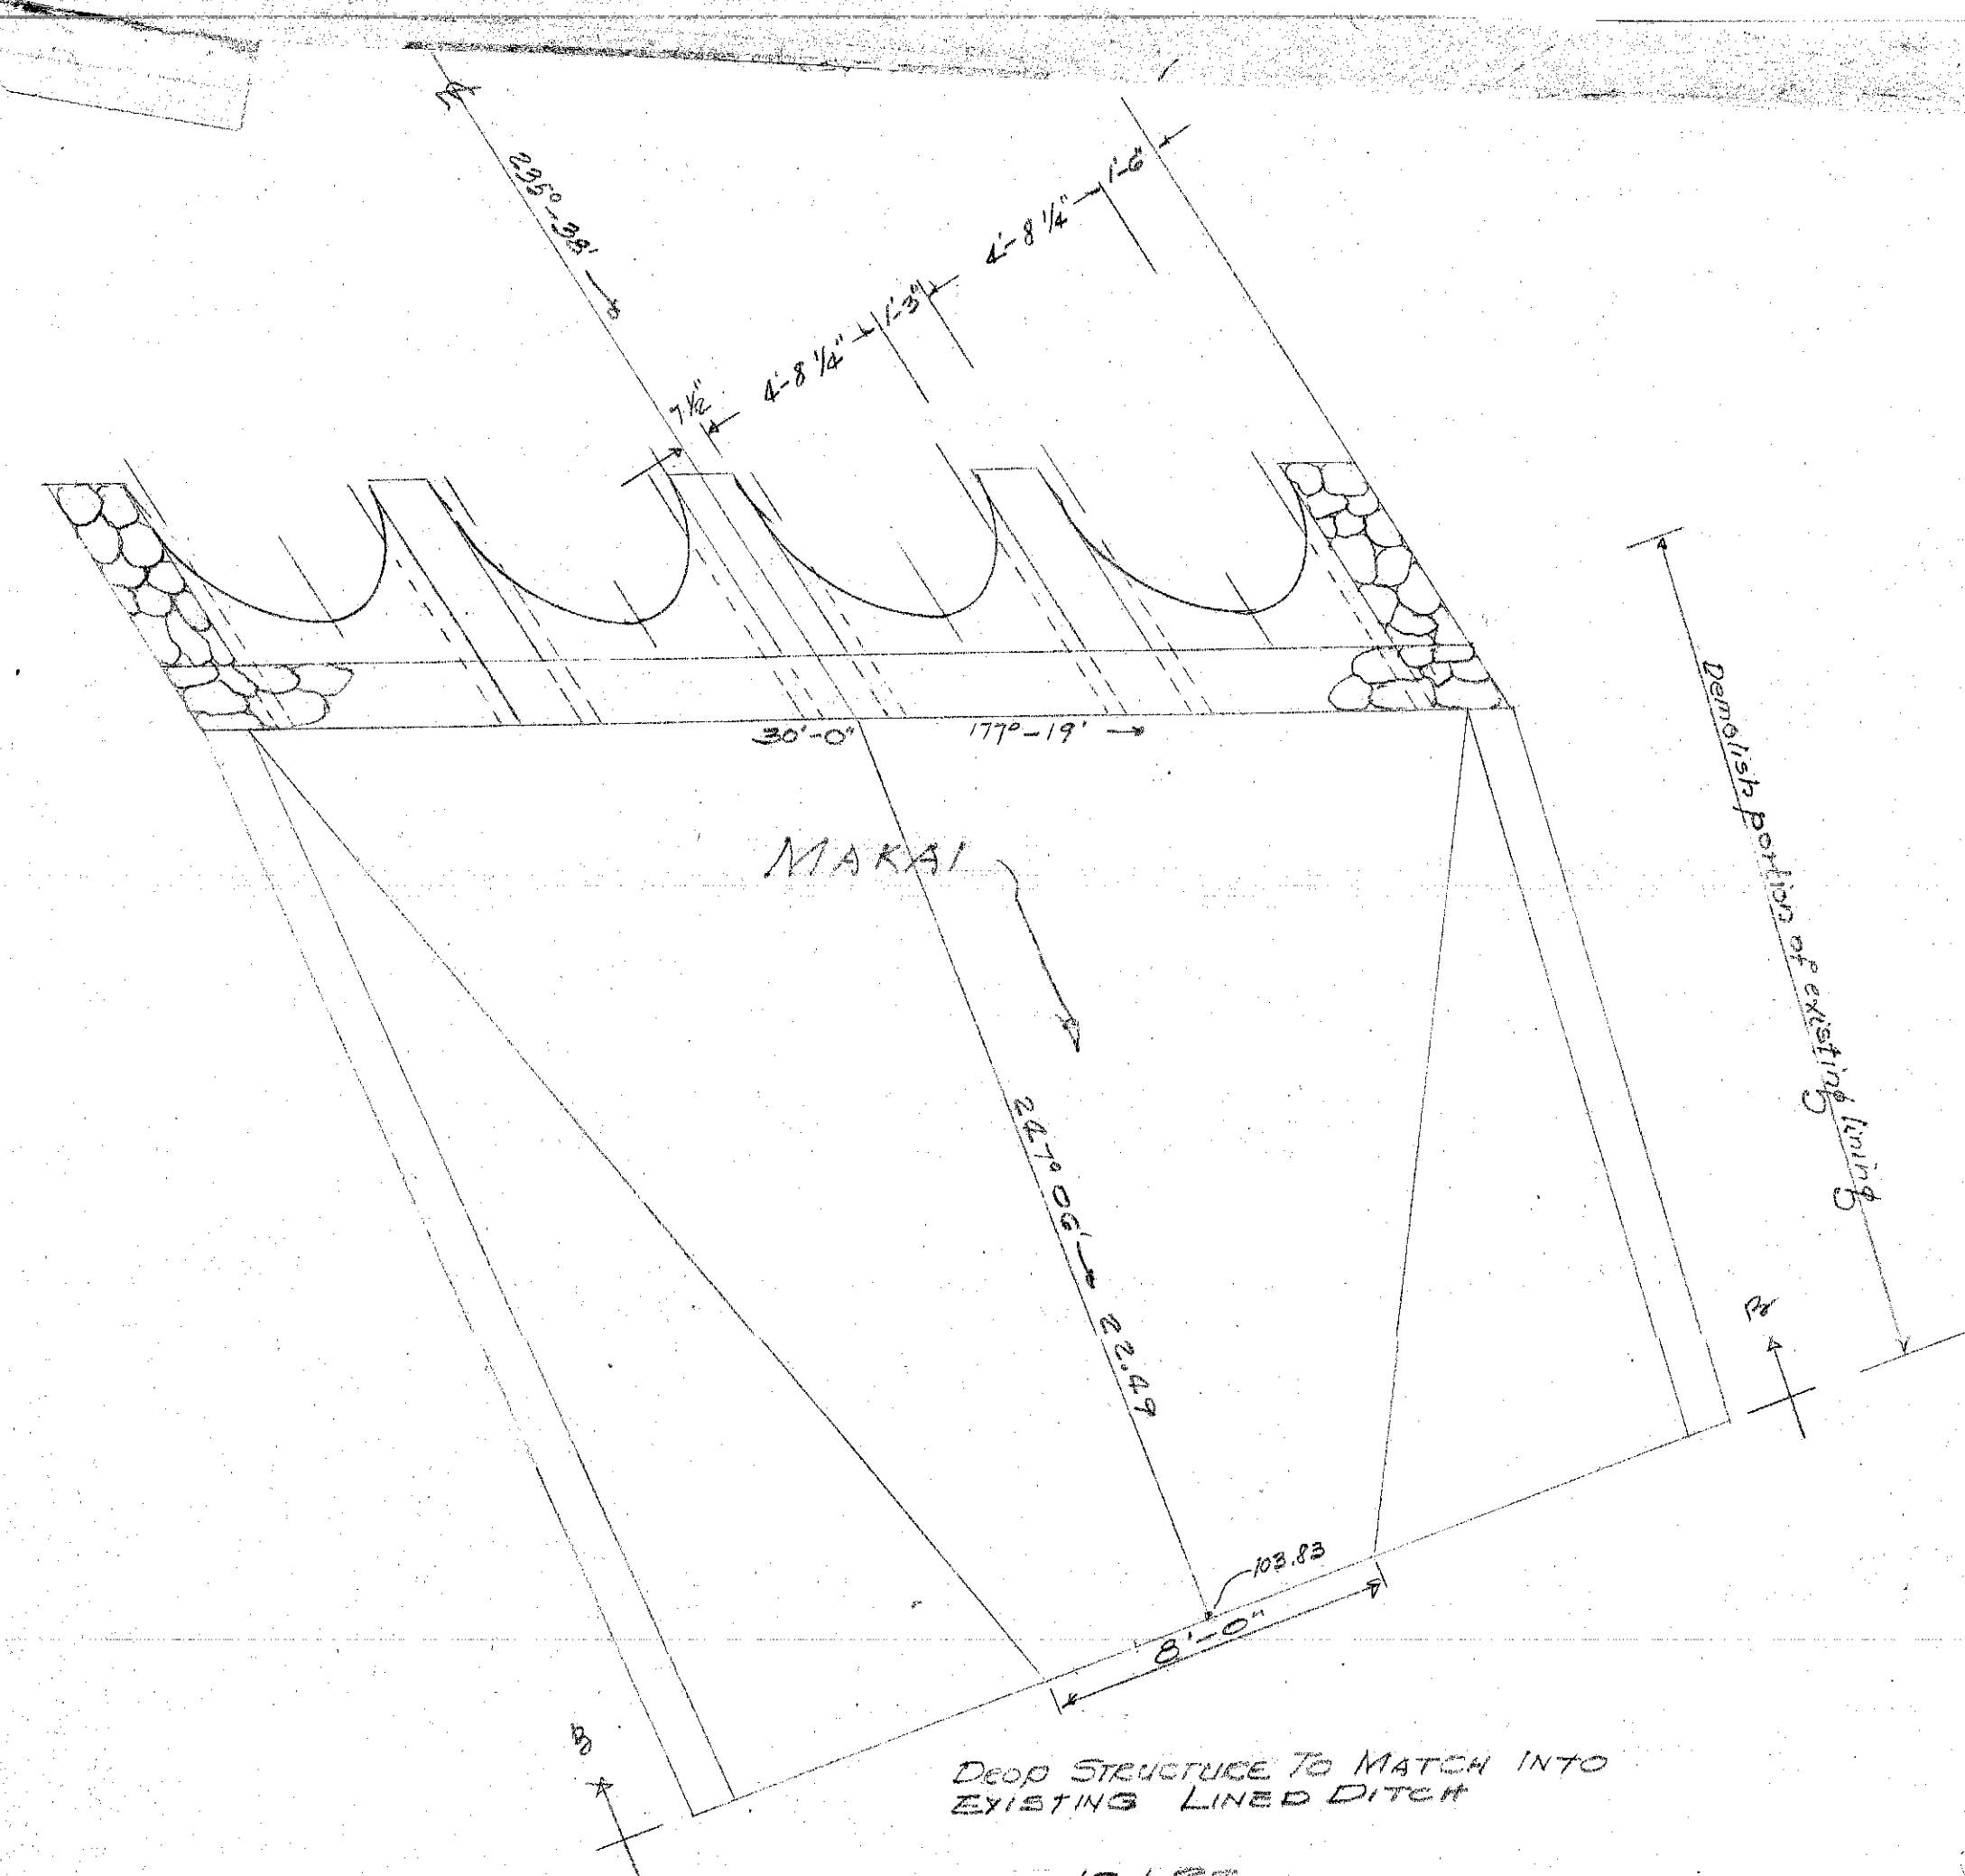

10+20
PLAN

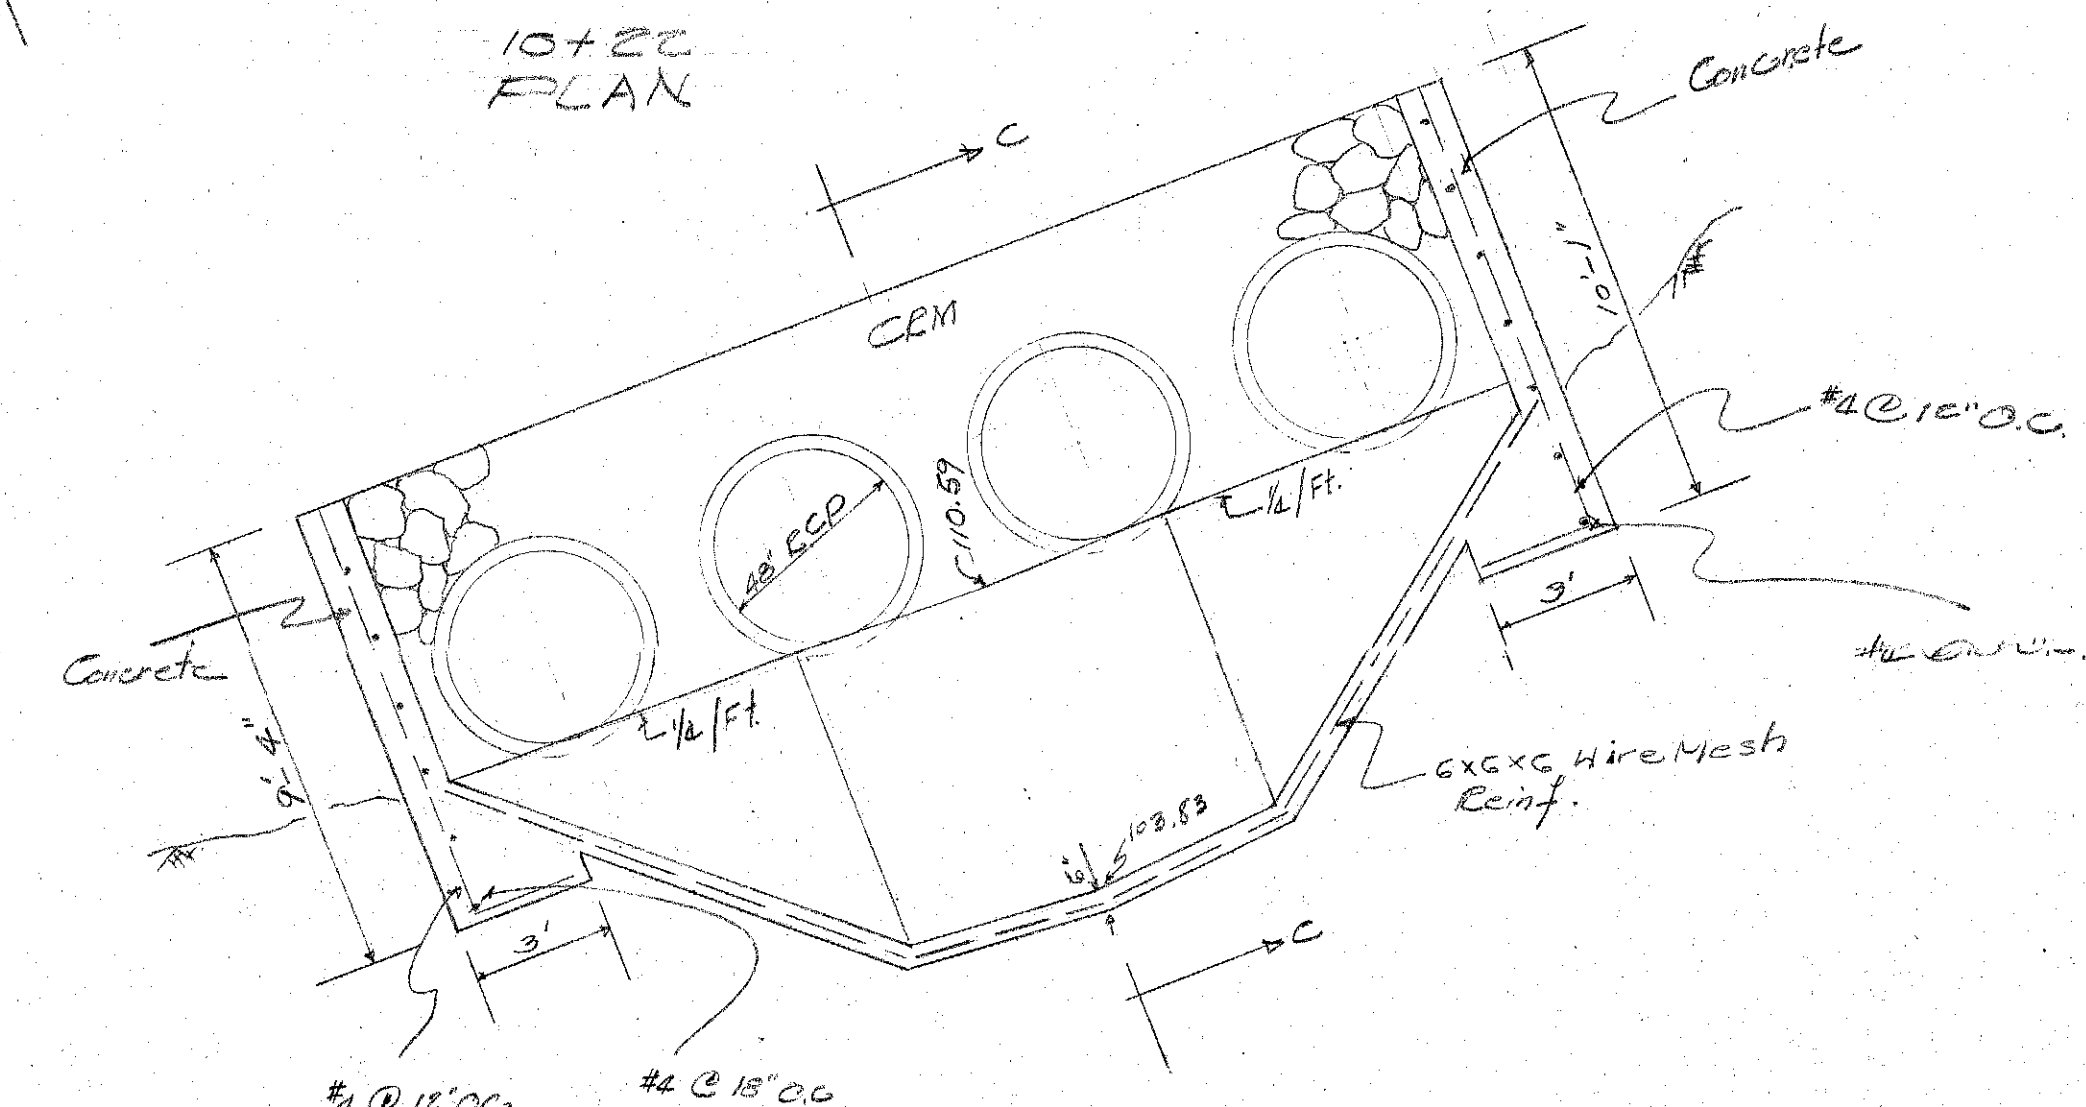

SECTION BB

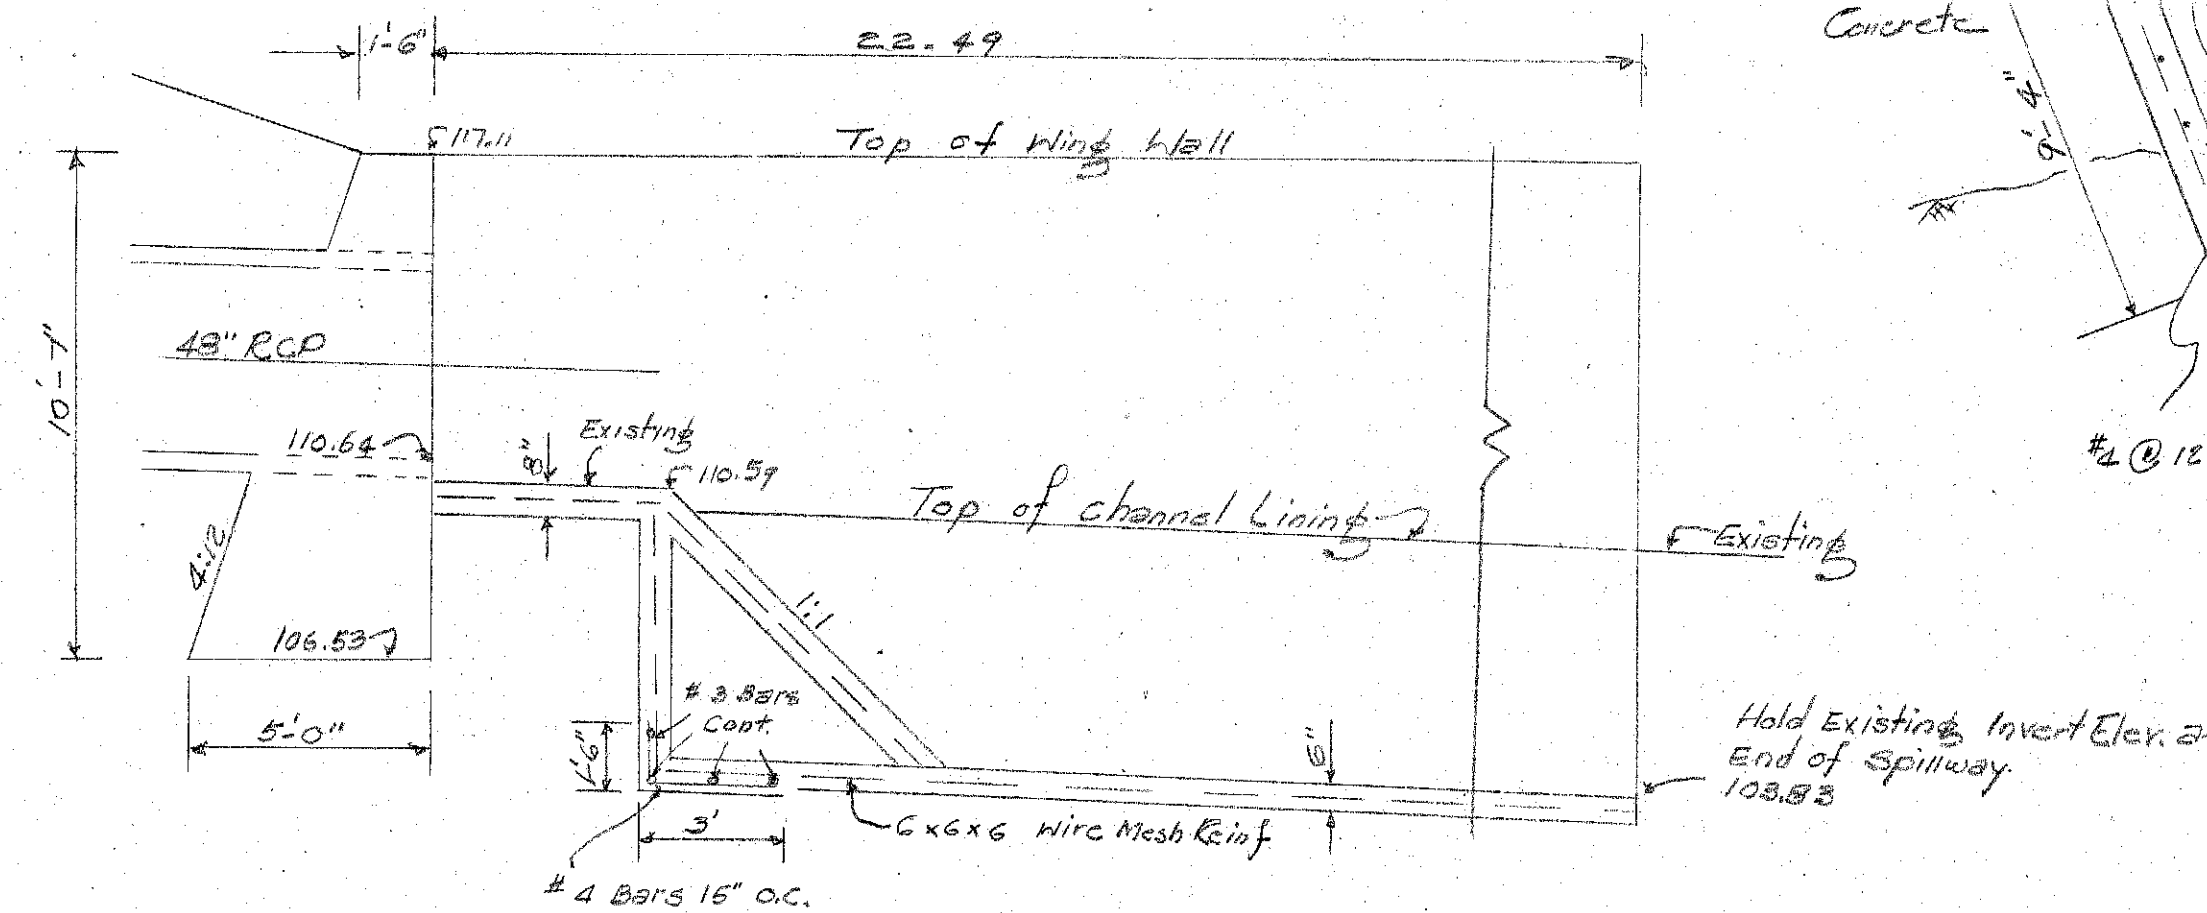

SECTION CC

DEPARTMENT OF PUBLIC WORKS
DIVISION OF ENGINEERING
IMPROVEMENT DISTRICT NO. 162

KAHALU CUTOFF ROAD
CULVERT CROSSING AT
Base line Sta. 0+187
Scale: 1/4" = 1'-0"
August 28, 1964
E.Y. DEPTOMARK
M.L. BRUNDEL