




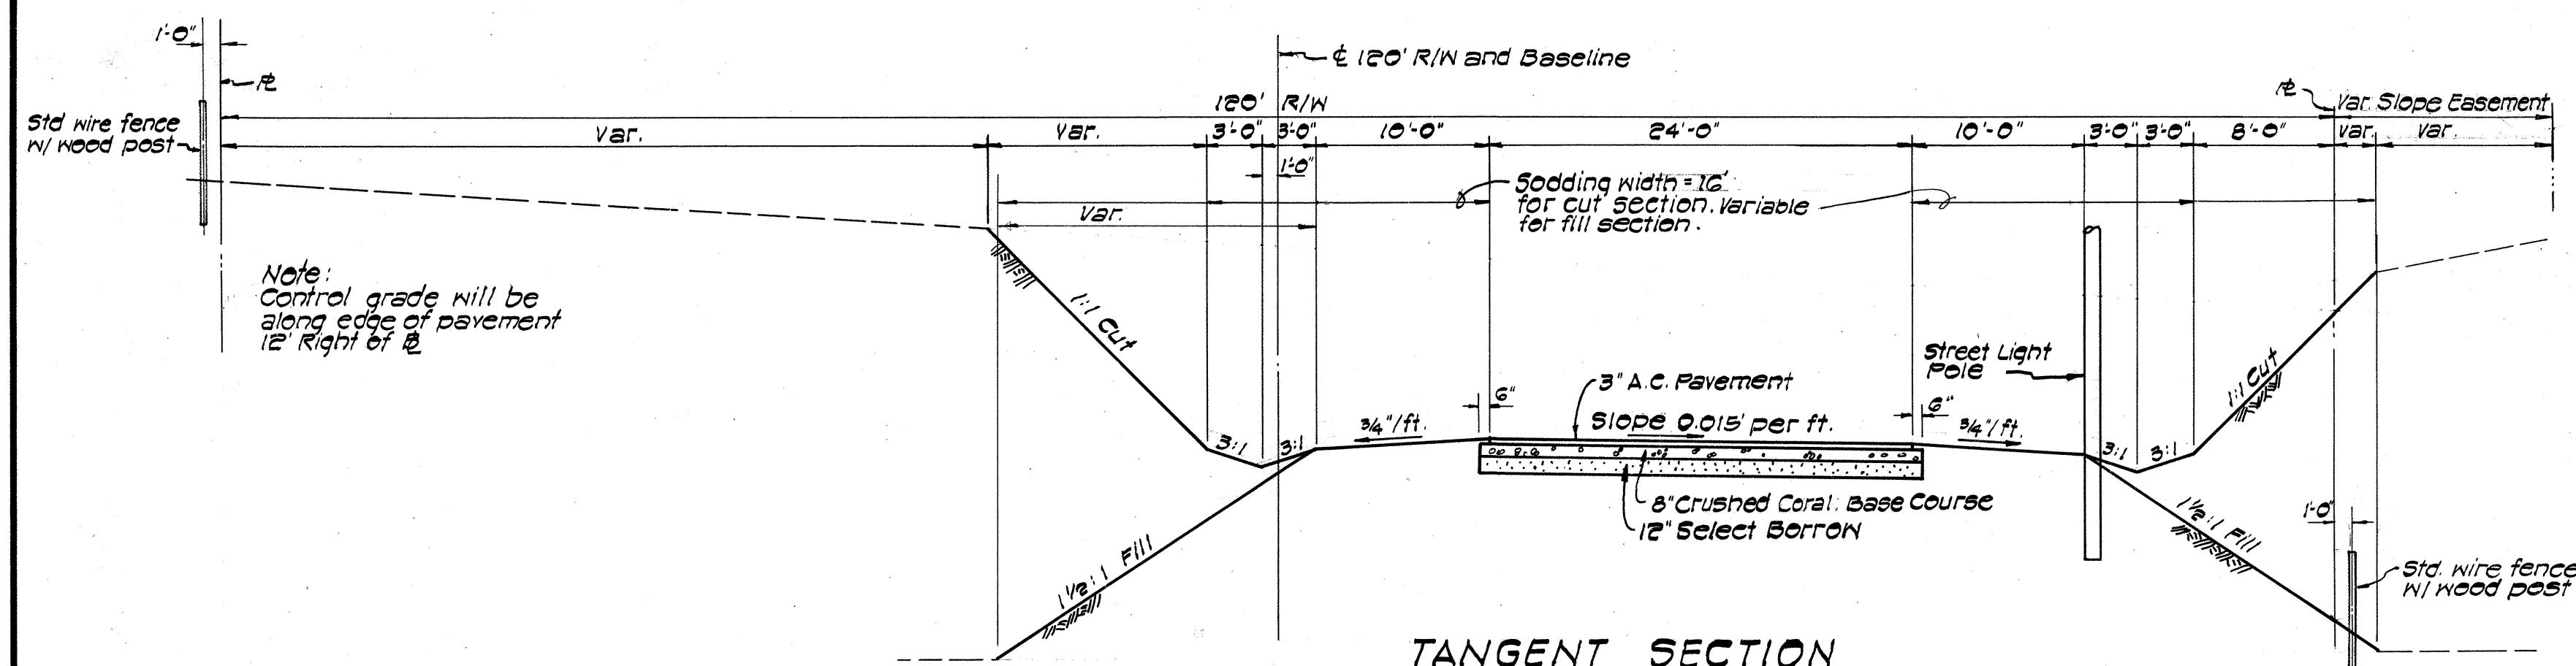


TANGENT SECTION
STA. 6+05 ± TO STA. 10+00 ±
E. STA. 27+10 ± TO STA. 103+50
STA. 125+50 TO STA. 186+60
Scale: 1/8" = 1'-0"

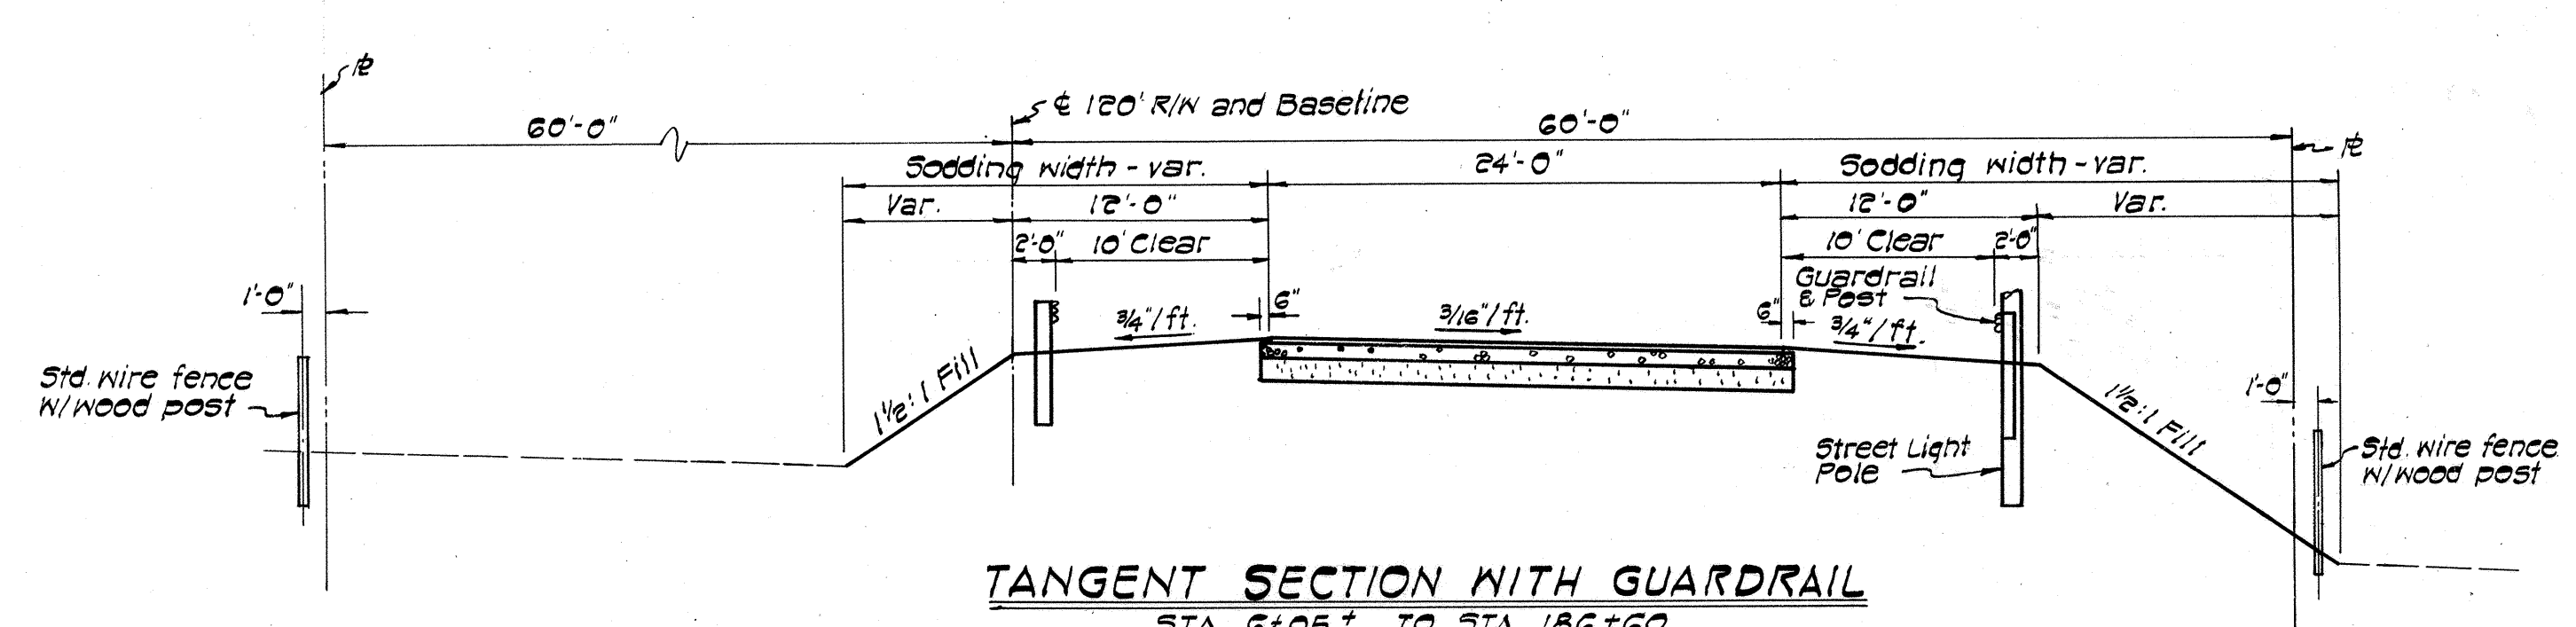

TANGENT SECTION WITH GUARDRAIL
STA. 6+05 ± TO STA. 186+60
Scale: 1/8" = 1'-0"

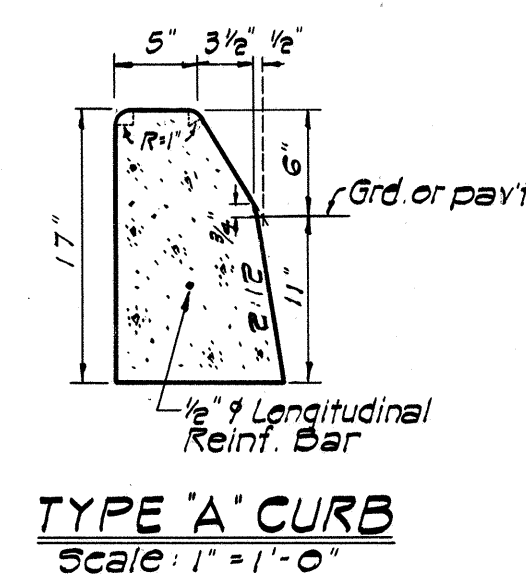


TYPE 'A' CURB
Scale: 1" = 1'-0"

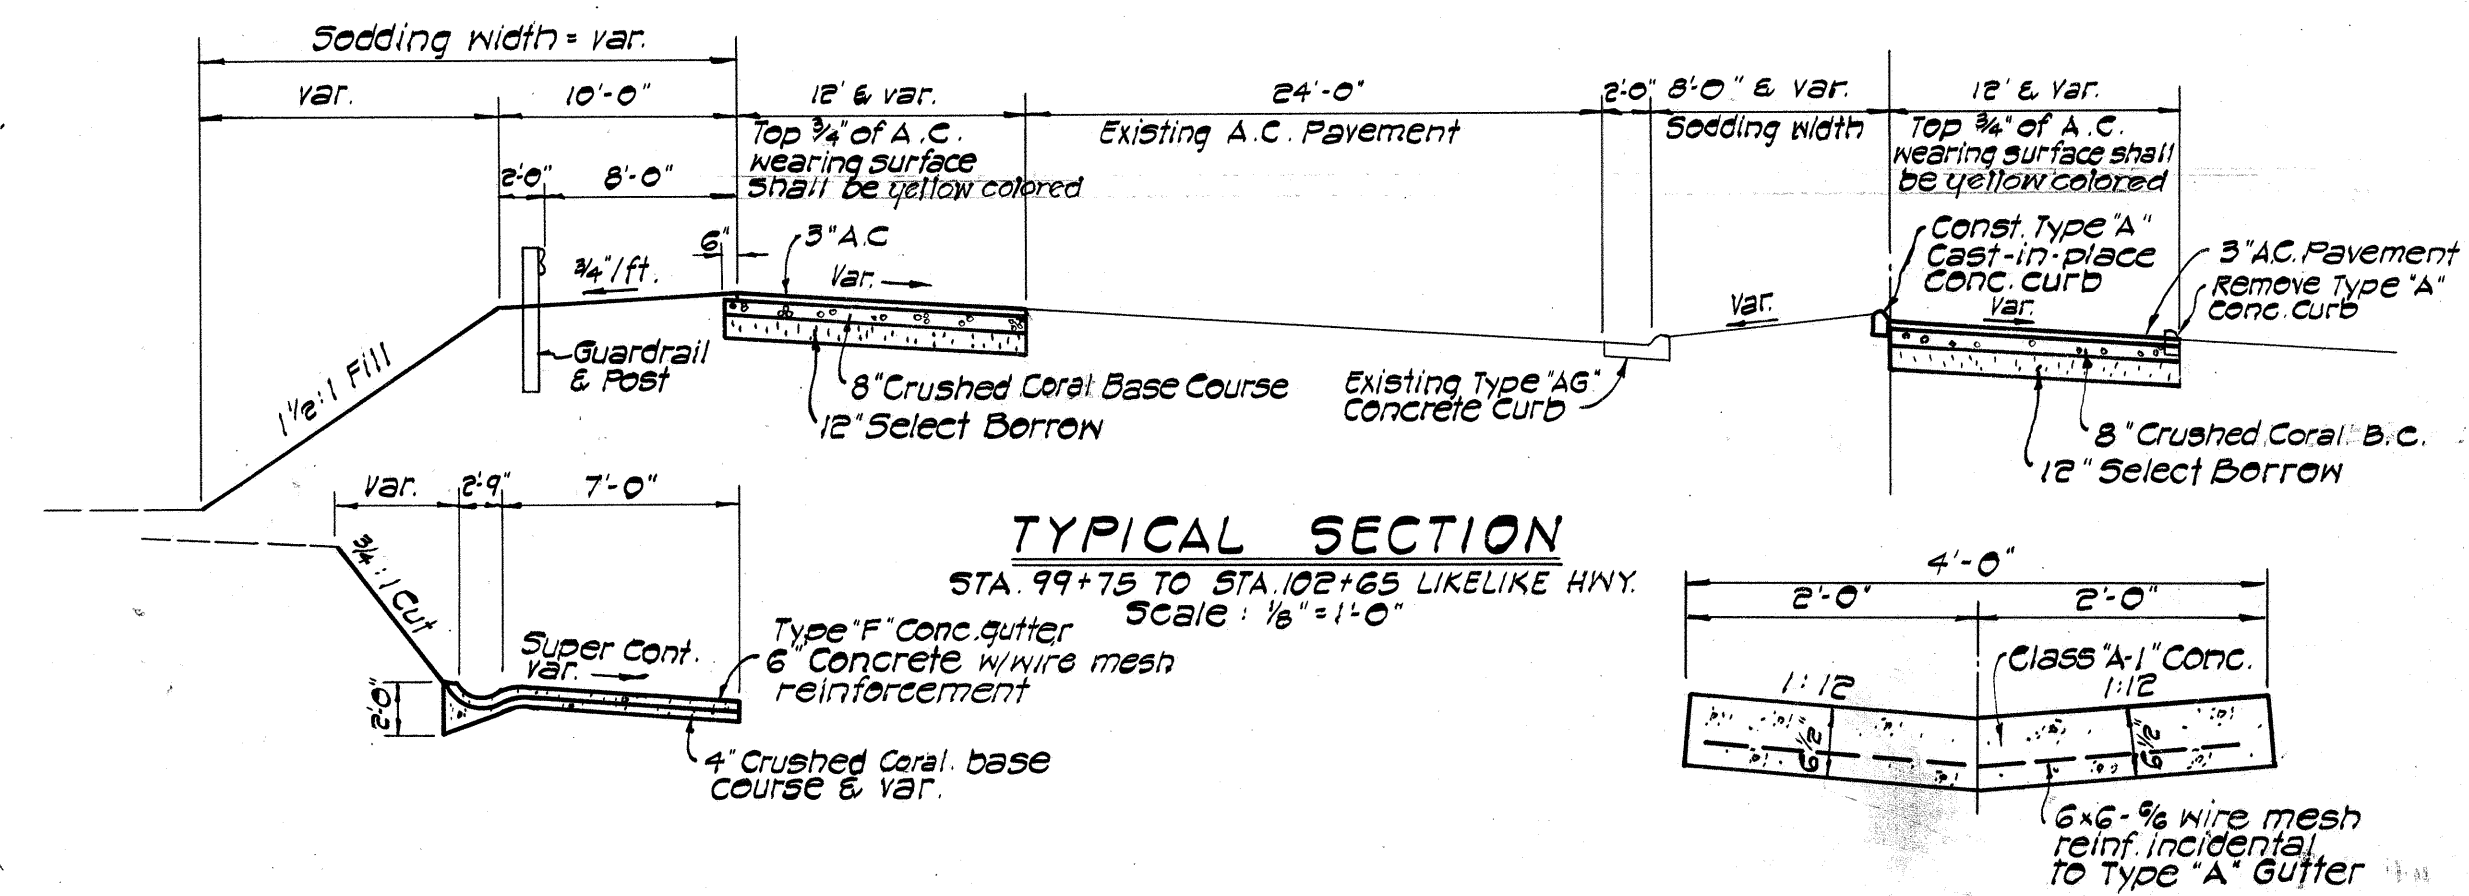


TYPICAL SECTION
STA. 99+75 TO STA. 102+65 LIKE H.W.
Scale: 1/8" = 1'-0"

DETAIL OF CAST-IN-PLACE TYPE 'A' GUTTER
Scale: 3/4" = 1'-0"


TYPICAL CROSS SECTION
STA. 10+00 ± TO STA. 16+50 ±
STA. 18+00 ± TO STA. 23+50 ±
Scale: 1/8" = 1'-0"

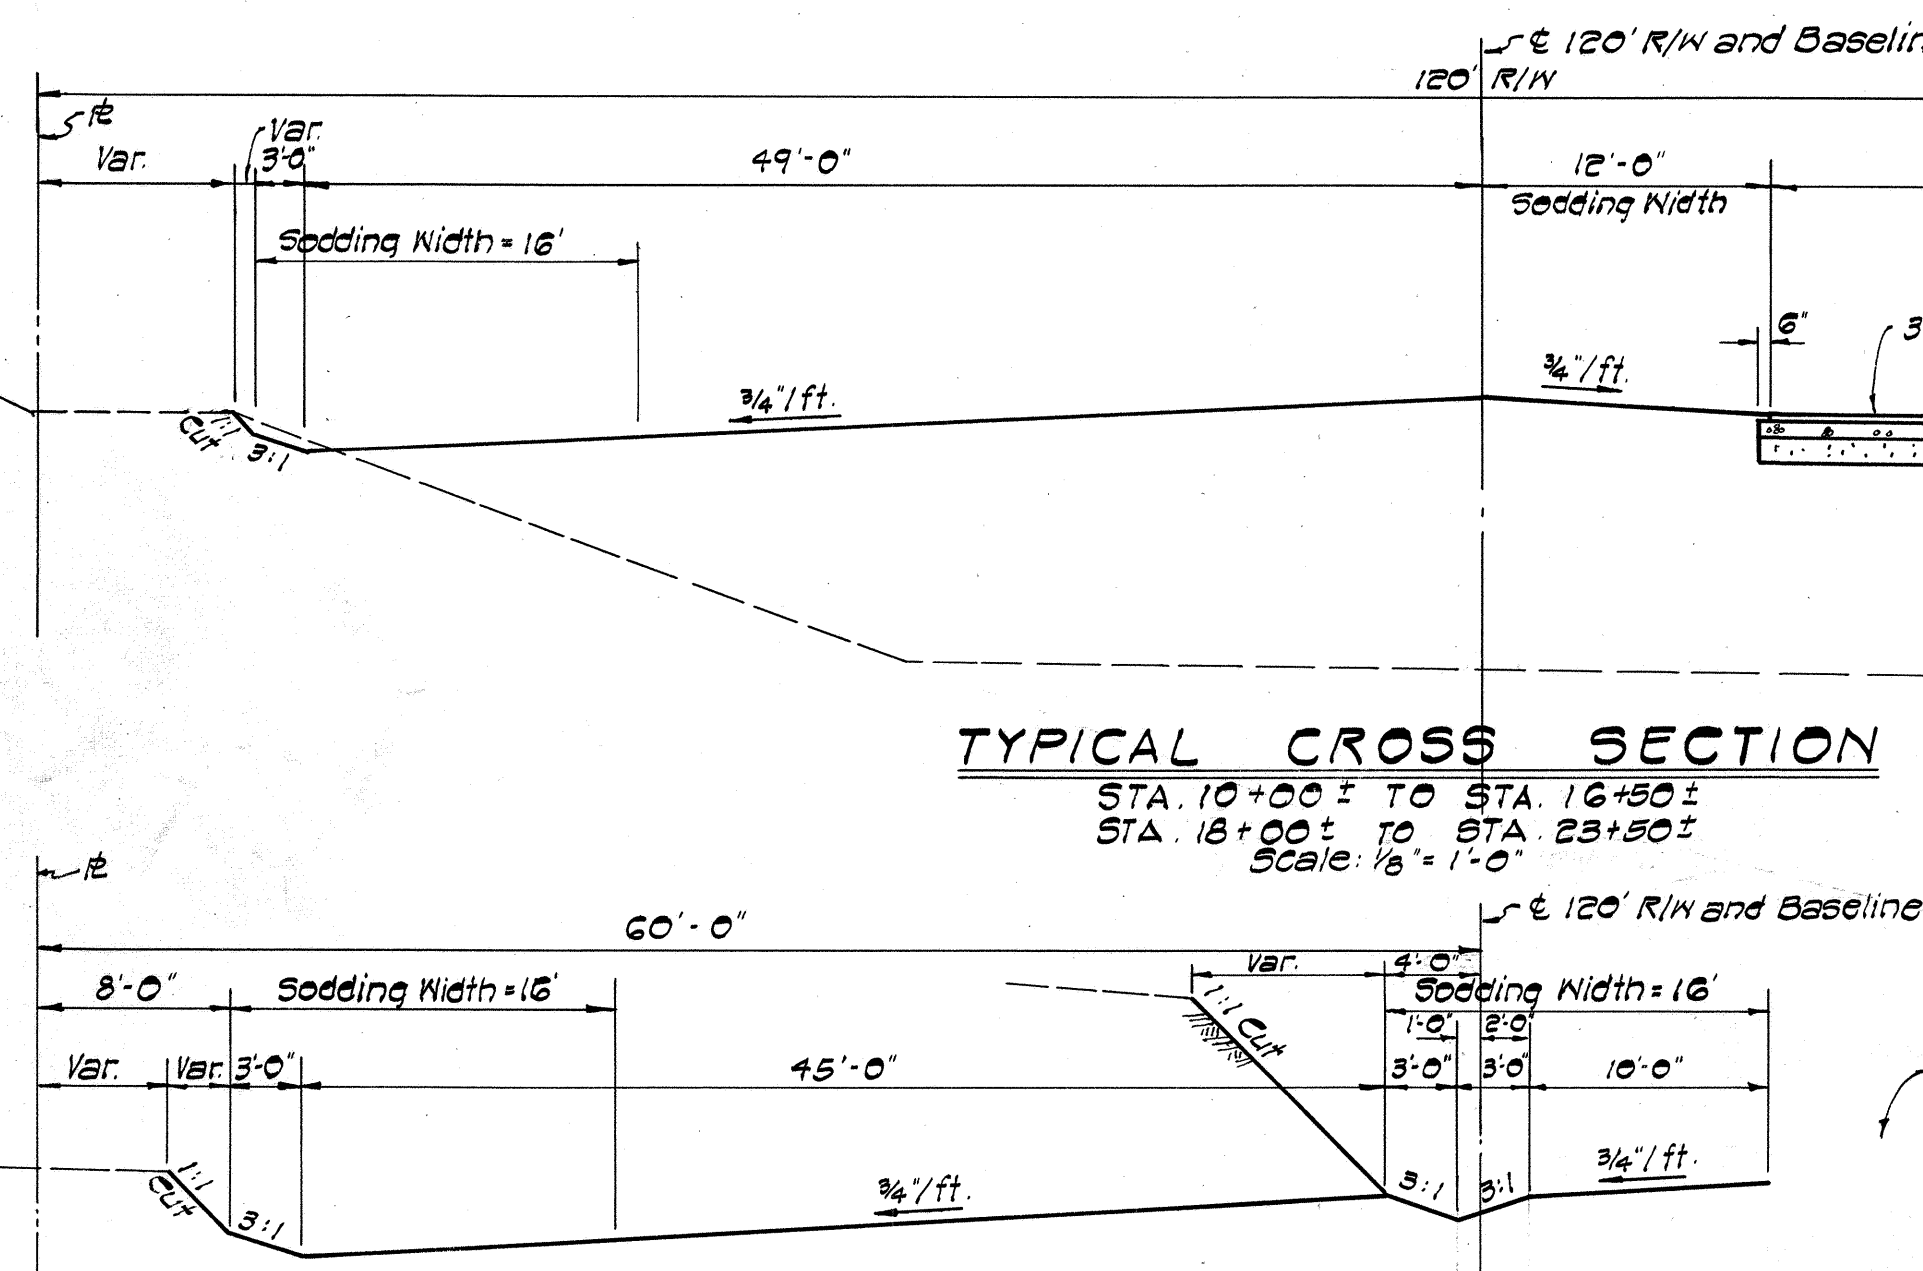



TYPICAL CROSS SECTION
STA. 23+50 ± TO STA. 27+10 ±
Scale: 1/8" = 1'-0"

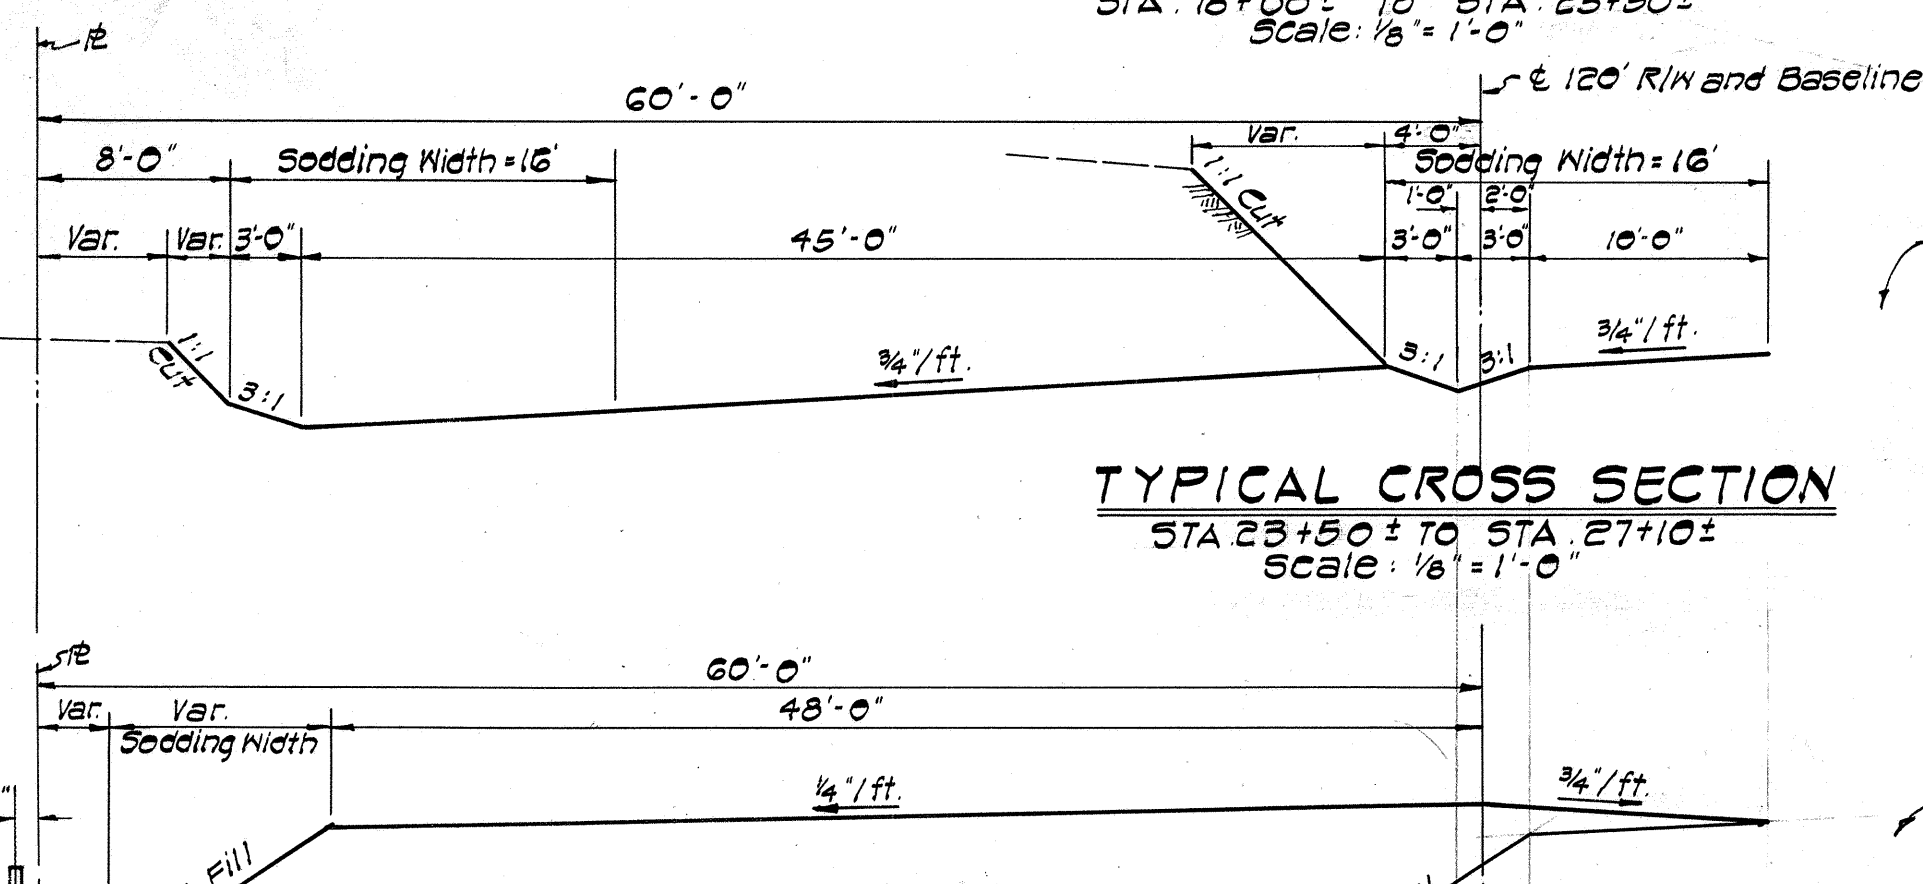

TYPICAL CROSS SECTION
STA. 103+50 TO STA. 125+50
Scale: 1/8" = 1'-0"


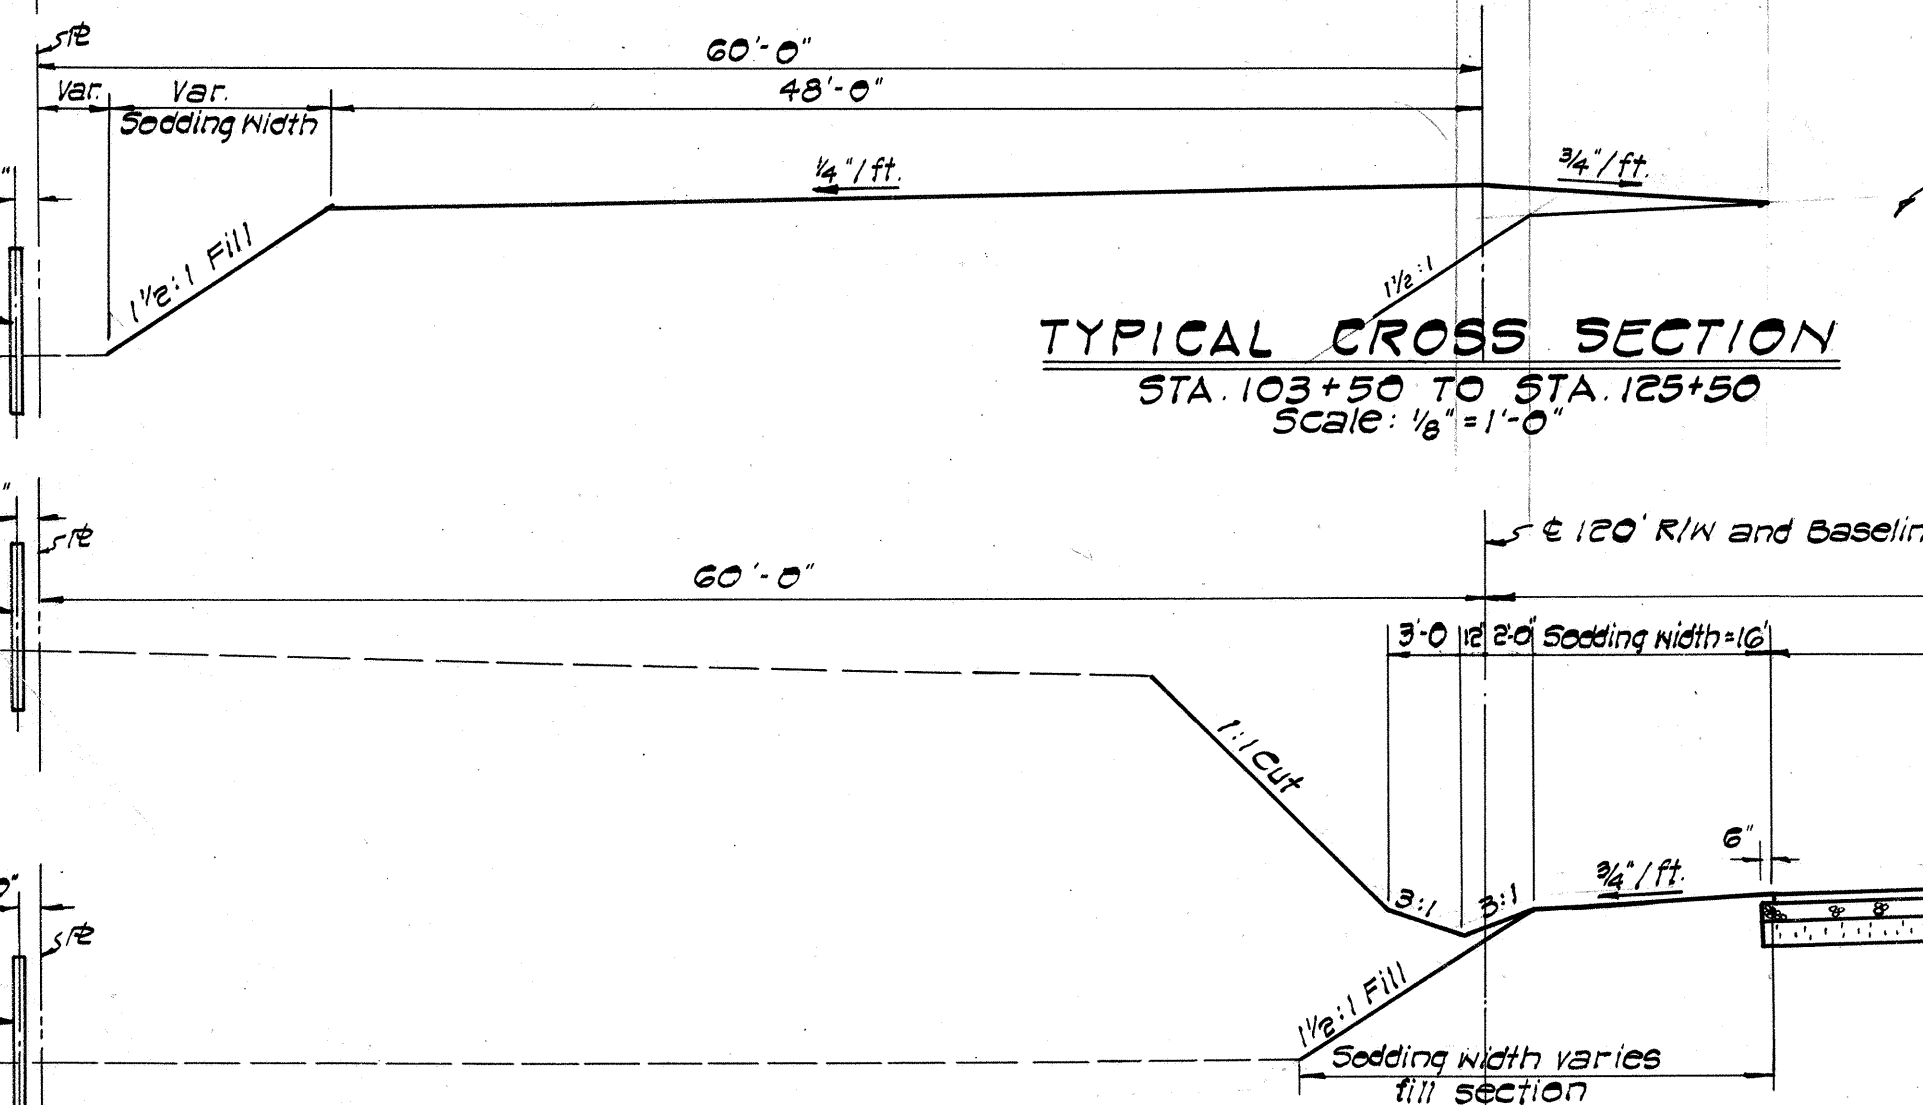


SUPERELEVATION SECTION
STA. 6+05 ± TO STA. 186+60
Scale: 1/8" = 1'-0"

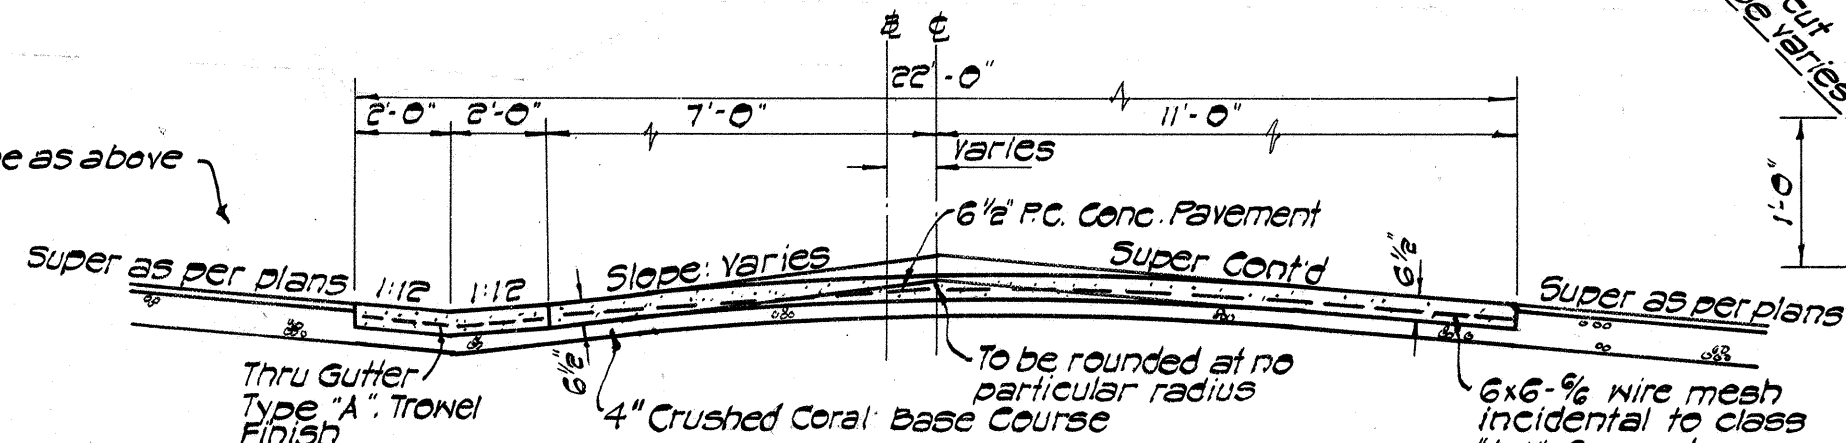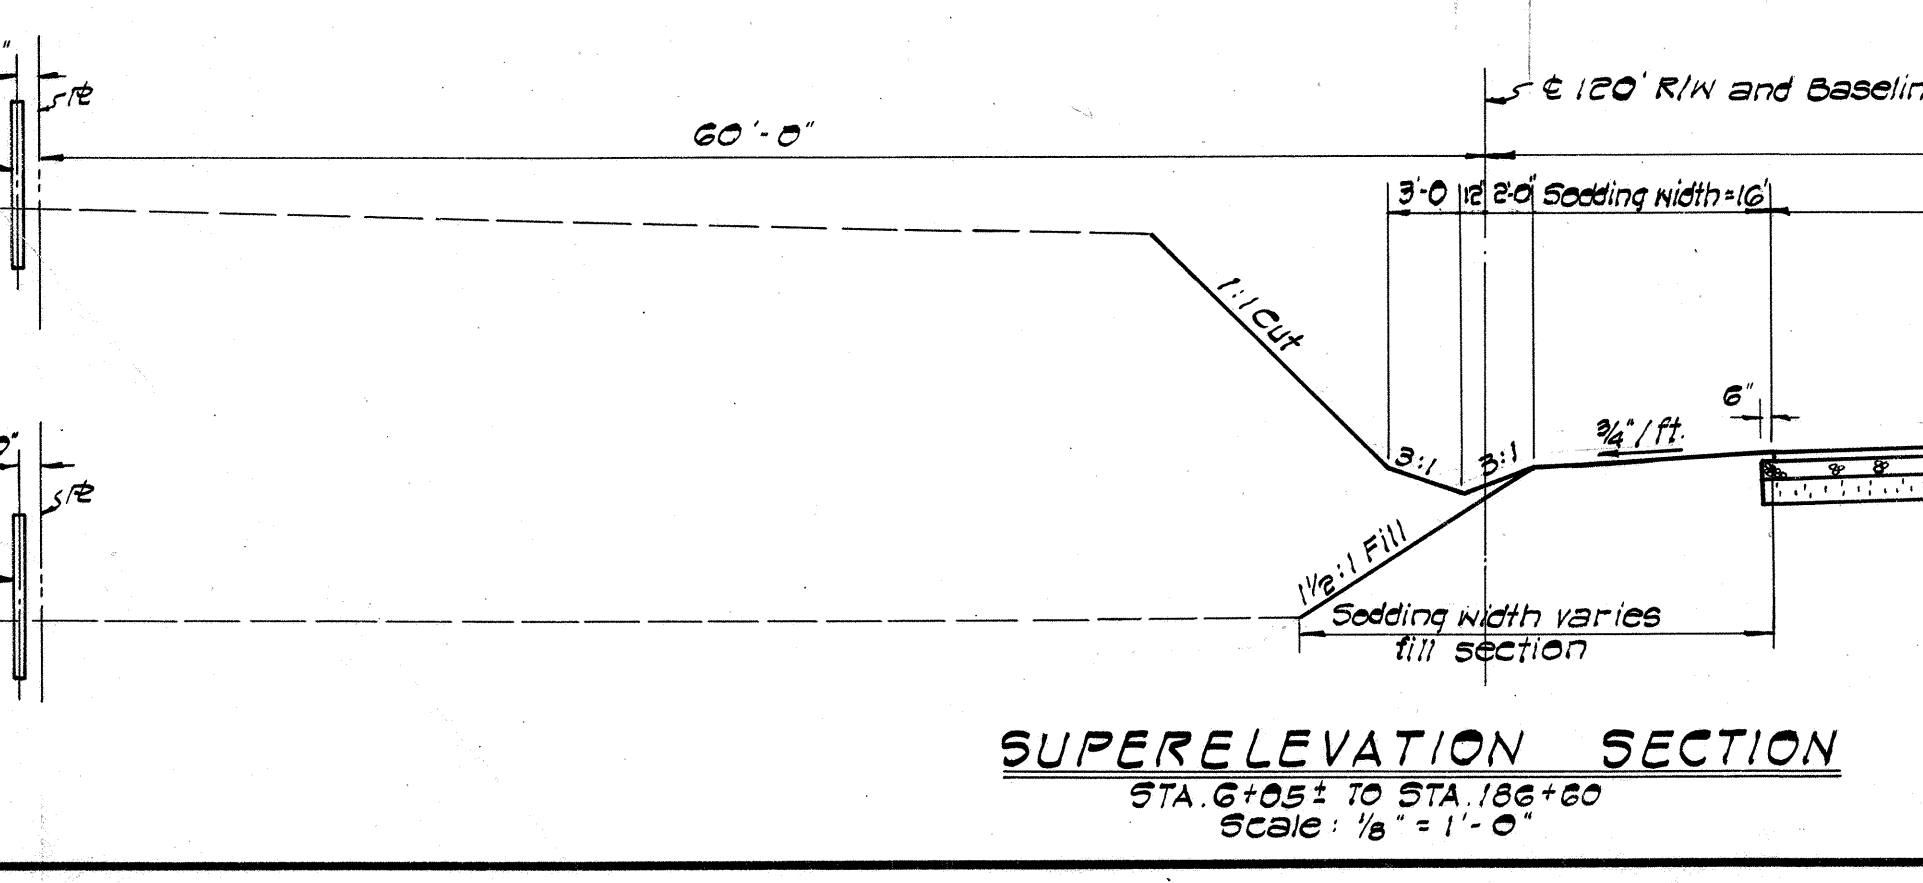


TYPICAL SECTION AT MEDIAN OPENING ON CURVES AT LIKE HIGHWAY
Scale: 1/4" = 1'-0"

TYPE 'AG' CURB & GUTTER
Scale: 1" = 1'-0"

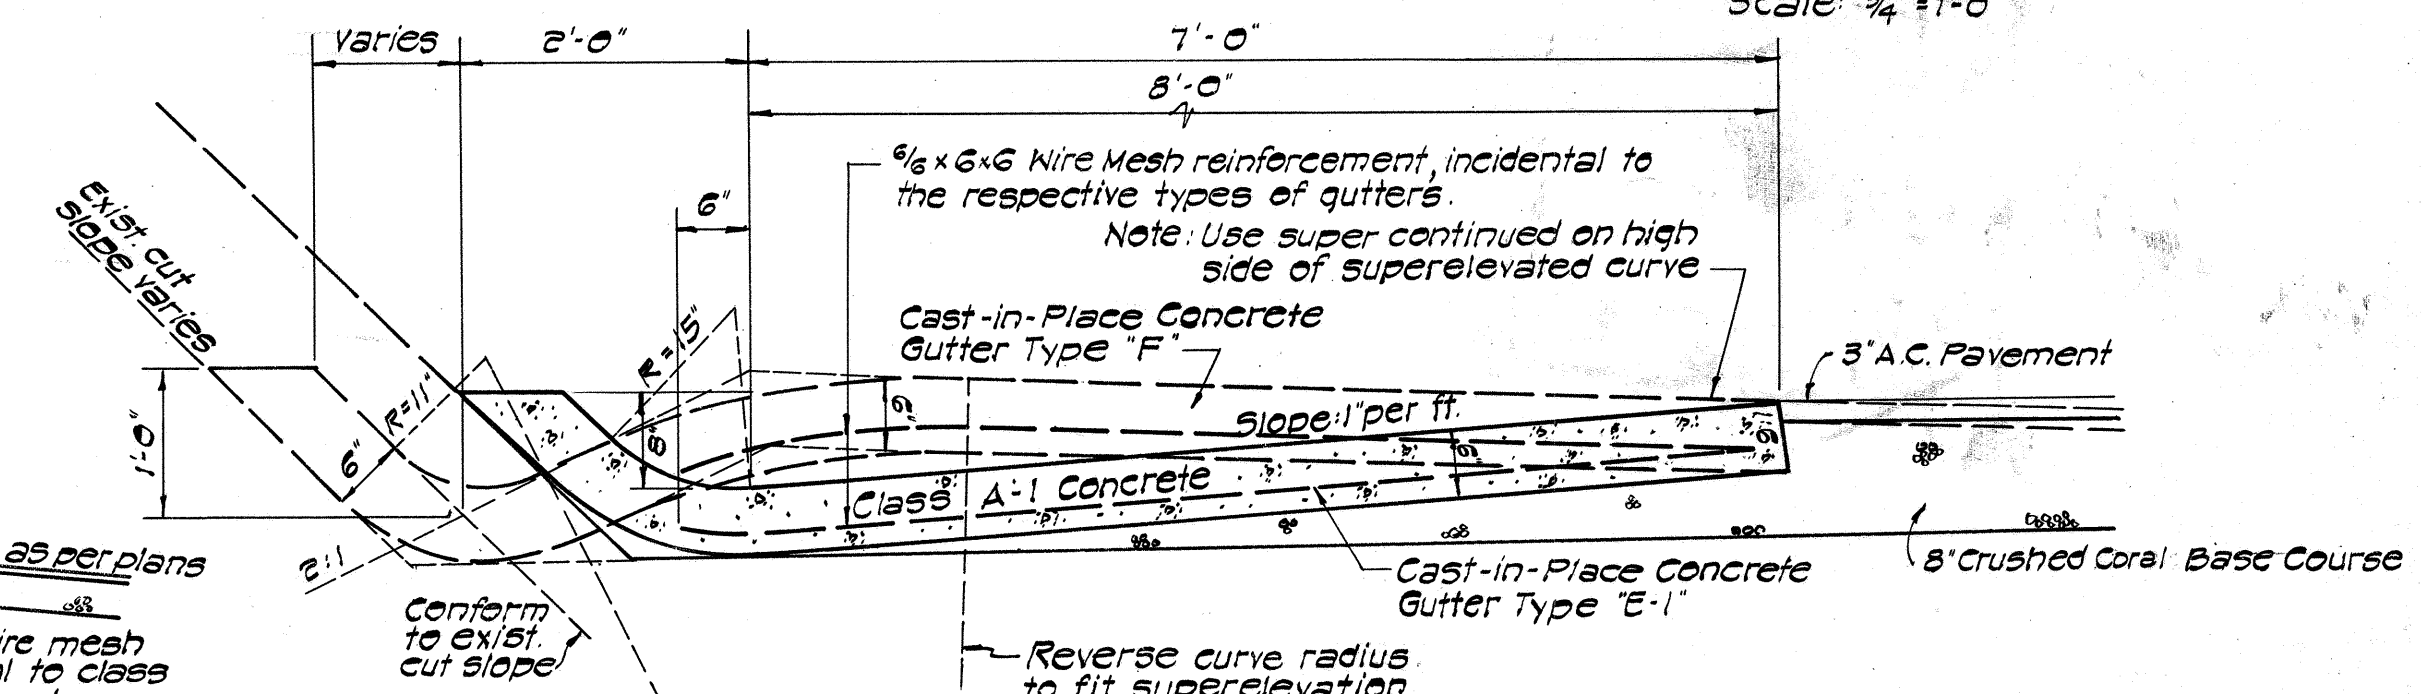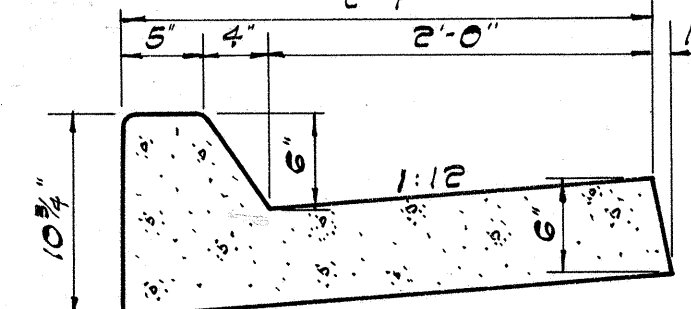

TYPE 'E-1' & TYPE 'F' CONCRETE GUTTER
Scale: 3/4" = 1'-0"

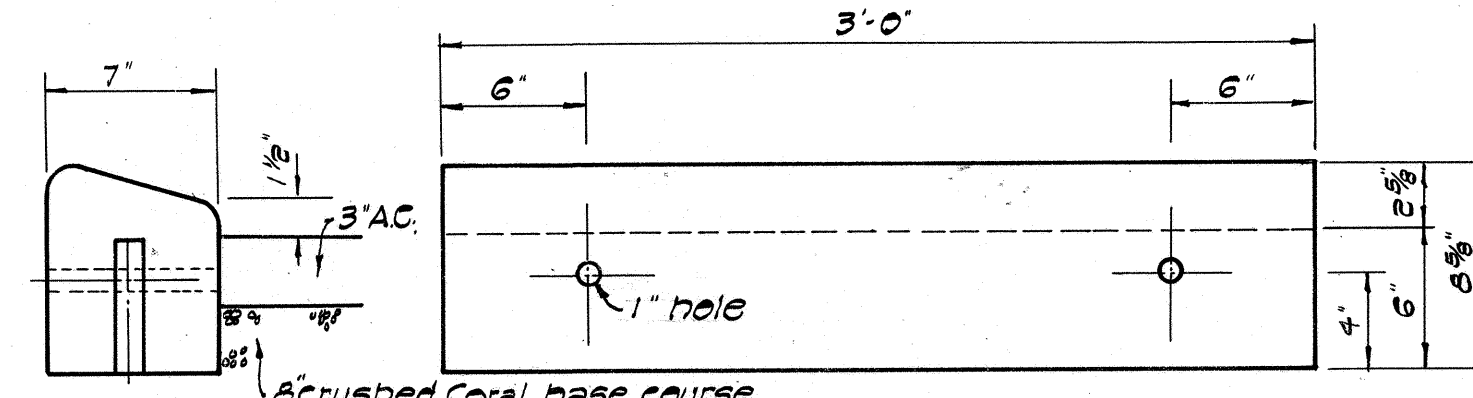

DETAIL OF CONCRETE HEADER
Scale: 1 1/2" = 1'-0"

PROPERTY OF DIVISION OF ENGINEERING

JOB NO. 12-63

REVISION DATE	DESCRIPTION	MADE BY	APPROVED
6-25-62	Sodding width 16' on tangent & super-elevation section	R.M.T.	H.A.T.
COMMUNITY PLANNING INCORPORATED CIVIL ENGINEERS - SURVEYORS - CONSULTANT PLANNERS			
DEPARTMENT OF PUBLIC WORKS CITY AND COUNTY OF HONOLULU DIVISION OF ENGINEERING IMPROVEMENT DISTRICT NO. 162 KAHALU CUTOFF ROAD KANEHOE, HEEA, AHUIMAHU & KAHALU, KOOLAUPOKO, OAHU			
TYPICAL ROADWAY CROSS SECTIONS			
ENGINEER <u>STF</u>	DATE FINAL REPORT <u>6-27-62</u>		
DRAFTSMAN <u>E.A.</u>	CHECKED BY <u>M.H.I.</u>		
SCALE <u>AS SHOWN</u>	TRACER <u>E.A.</u>		
APPROVED <u>[Signature]</u>	APPROVED <u>[Signature]</u>		
CHIEF ENGINEER <u>[Signature]</u>	DIRECTOR, DIVISION OF ENGINEERING <u>[Signature]</u>		
N.S. <u>[Signature]</u>	PROFILE <u>[Signature]</u>	C.D. <u>[Signature]</u>	
CR. SEC. <u>[Signature]</u>	P.D. <u>[Signature]</u>	S.D. <u>[Signature]</u>	
N.M. BY: <u>[Signature]</u>	F.W. BY: <u>[Signature]</u>	S. BY: <u>[Signature]</u>	
APPROVED <u>[Signature]</u>			
REG. ENGR. CERT. NO. 410-E			