


NOTE:
All Azimuths based
on Mokeua Δ


PLAN	DATE
NO.	
NO. OF WAY CHECKED	
NOTE BOOK ALIGNMENT CHECKED	
PLOTTED	
SURVEYED	

PROFILE	DATE
NO.	
STRUCTURE NOTATION: CHD.	
NOTE BOOK GRADE	
PLOTTED	
SURVEYED	

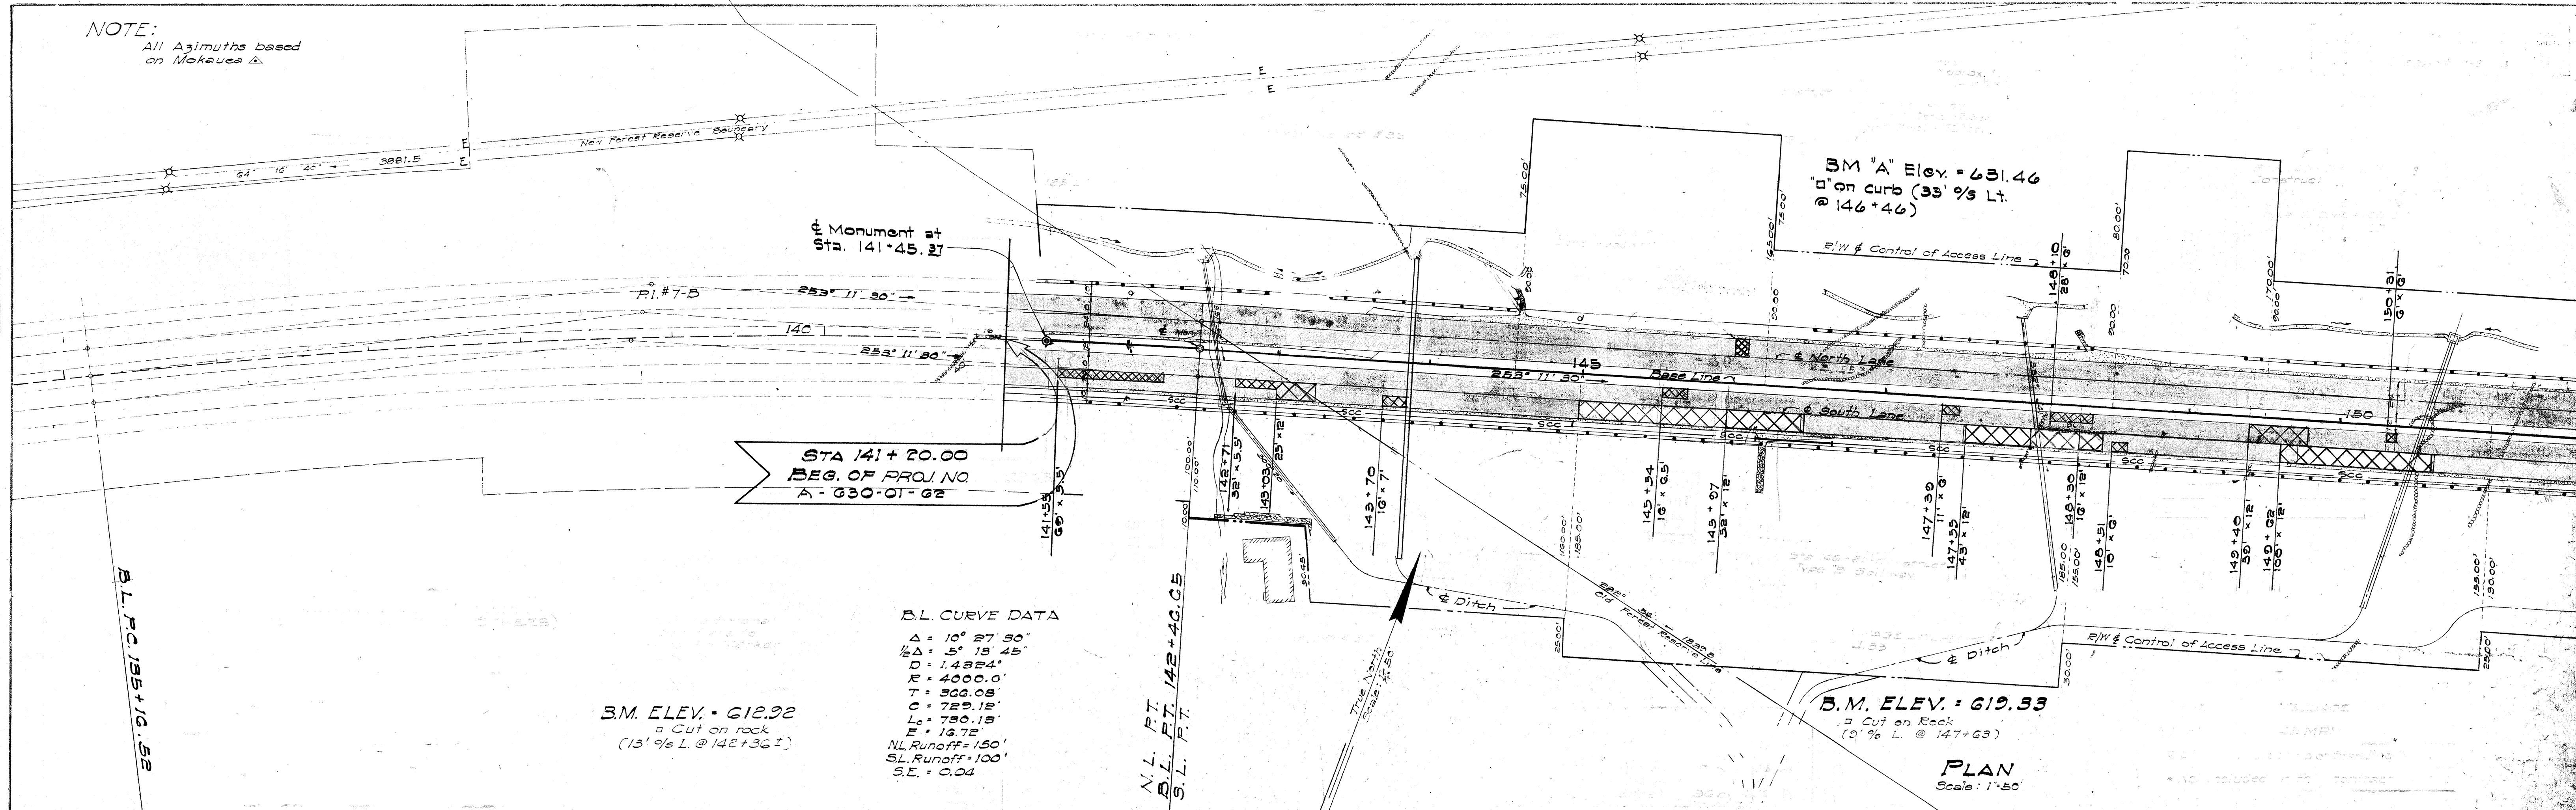


HIGHWAY RECONSTRUCTION LEGEND

- Reconstructed Area
- Resurfaced Area
- Signal Corps Cable
- Signal Corps Cable in Conduit

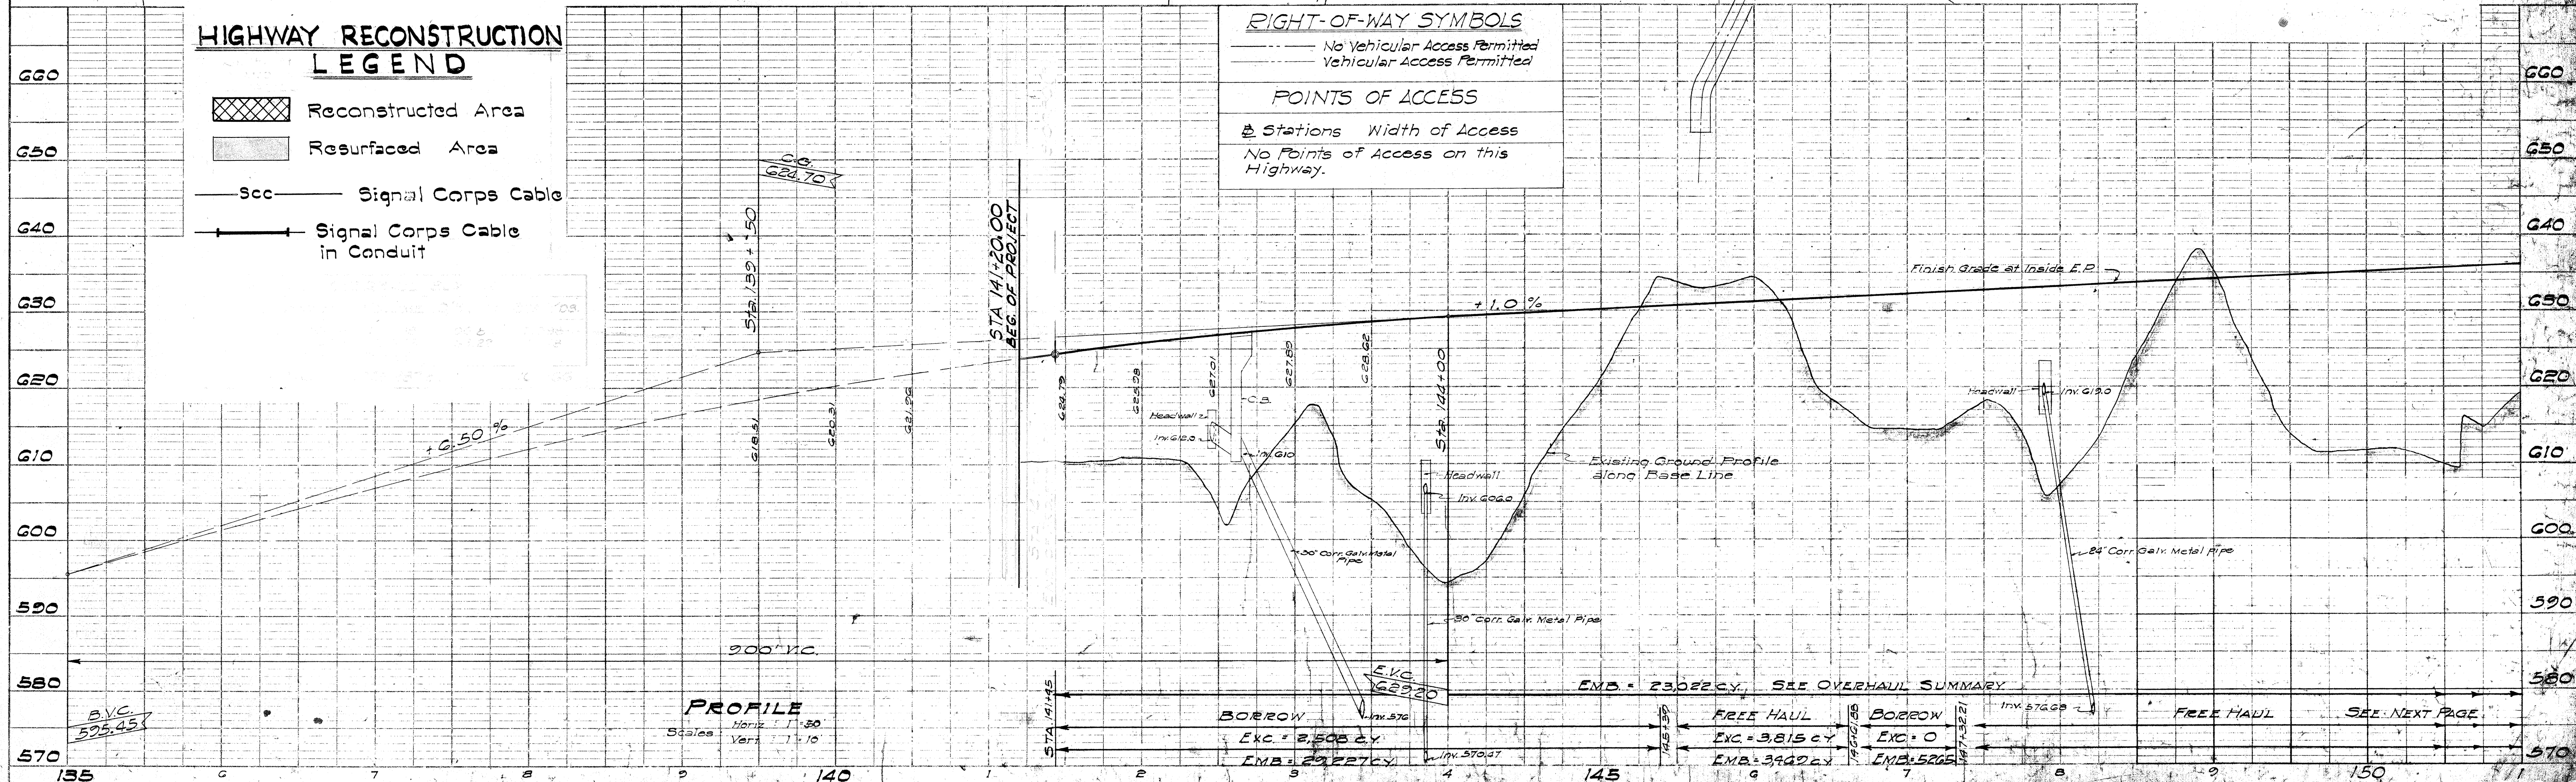


NO.	DATE
NOTE BOOK	BY
GRADES CHECKED	
S. M.3 NOTED	
STRUCTURE NOTATIONS CH'ND.	
PROFILE	
SURVEYED	
PLOTTED	

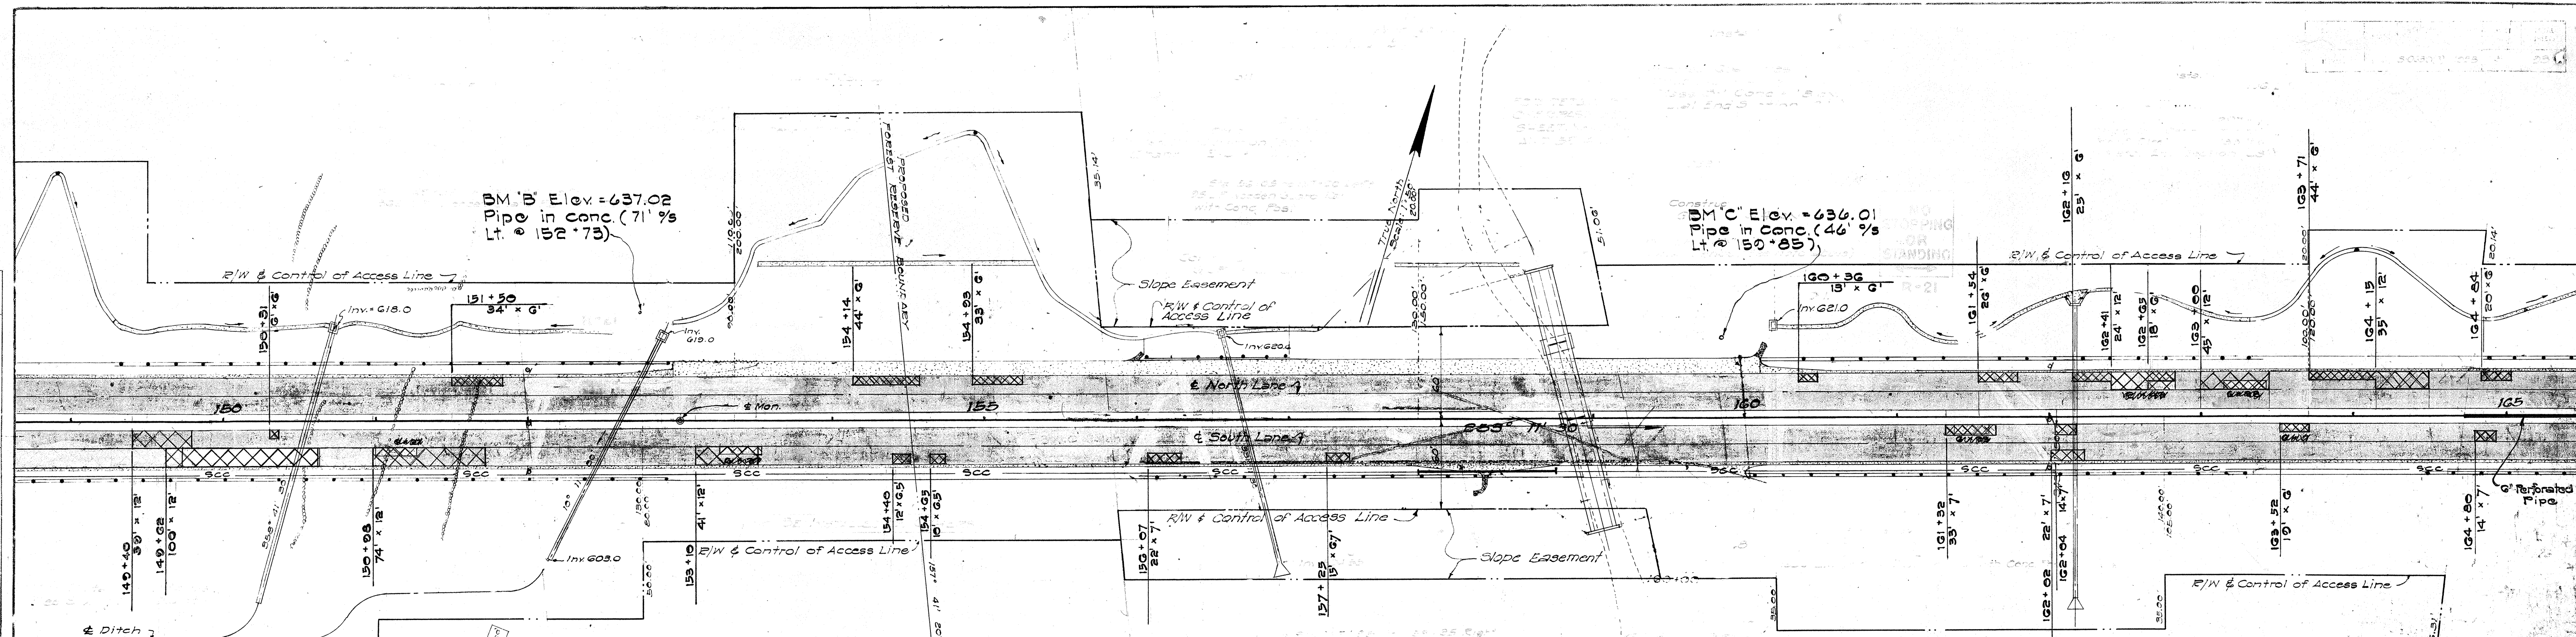



HIGHWAY RECONSTRUCTION LEGEND

-  Reconstruction Area
 Resurfaced Area
 See Signal Corps Cable
 Signal Corps Cable in Conduit

PLAN
Scale: 1" = 50'


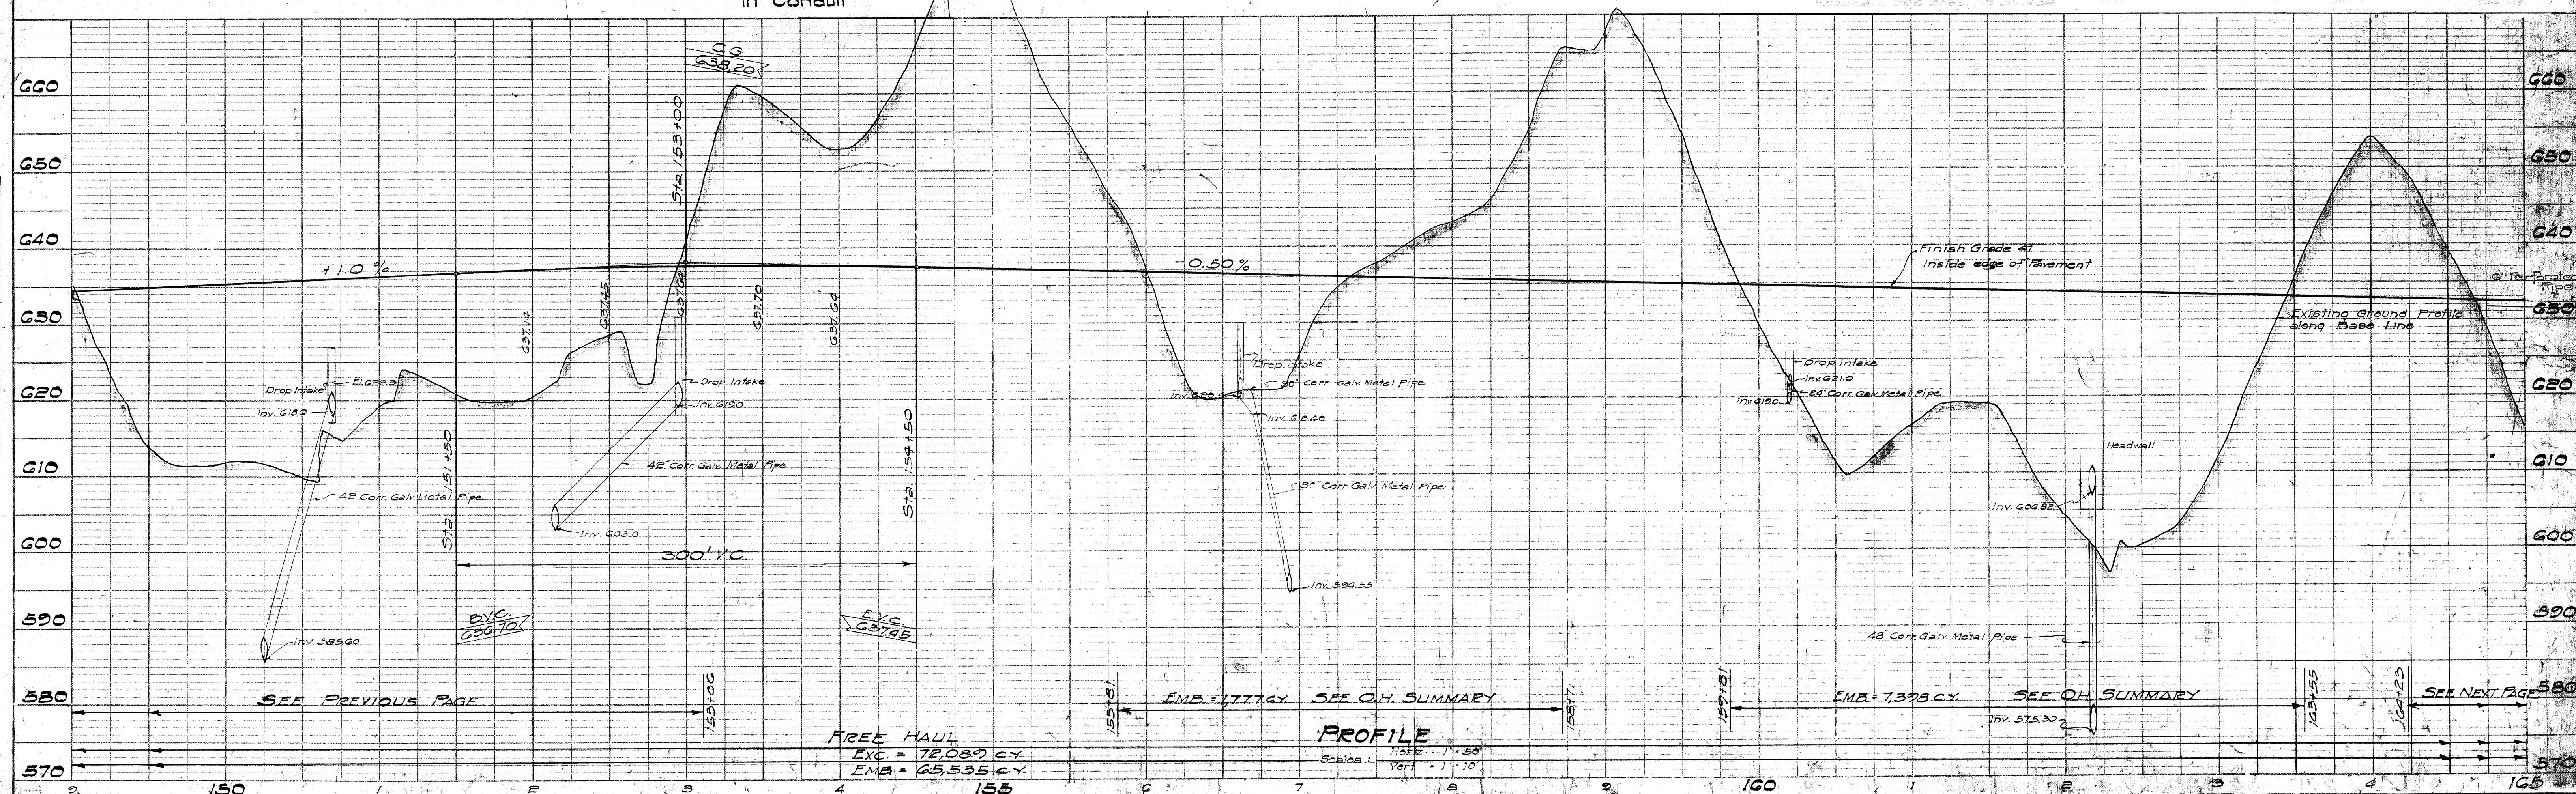


PROFILE		BY	DATE
	SURVEYED		
	PLOTTED		
NOTE BOOK	GRADES CHECKED		
NO.	S. M. & NOTED		
	STRUCTURE NOTATIONS CH. NO.		

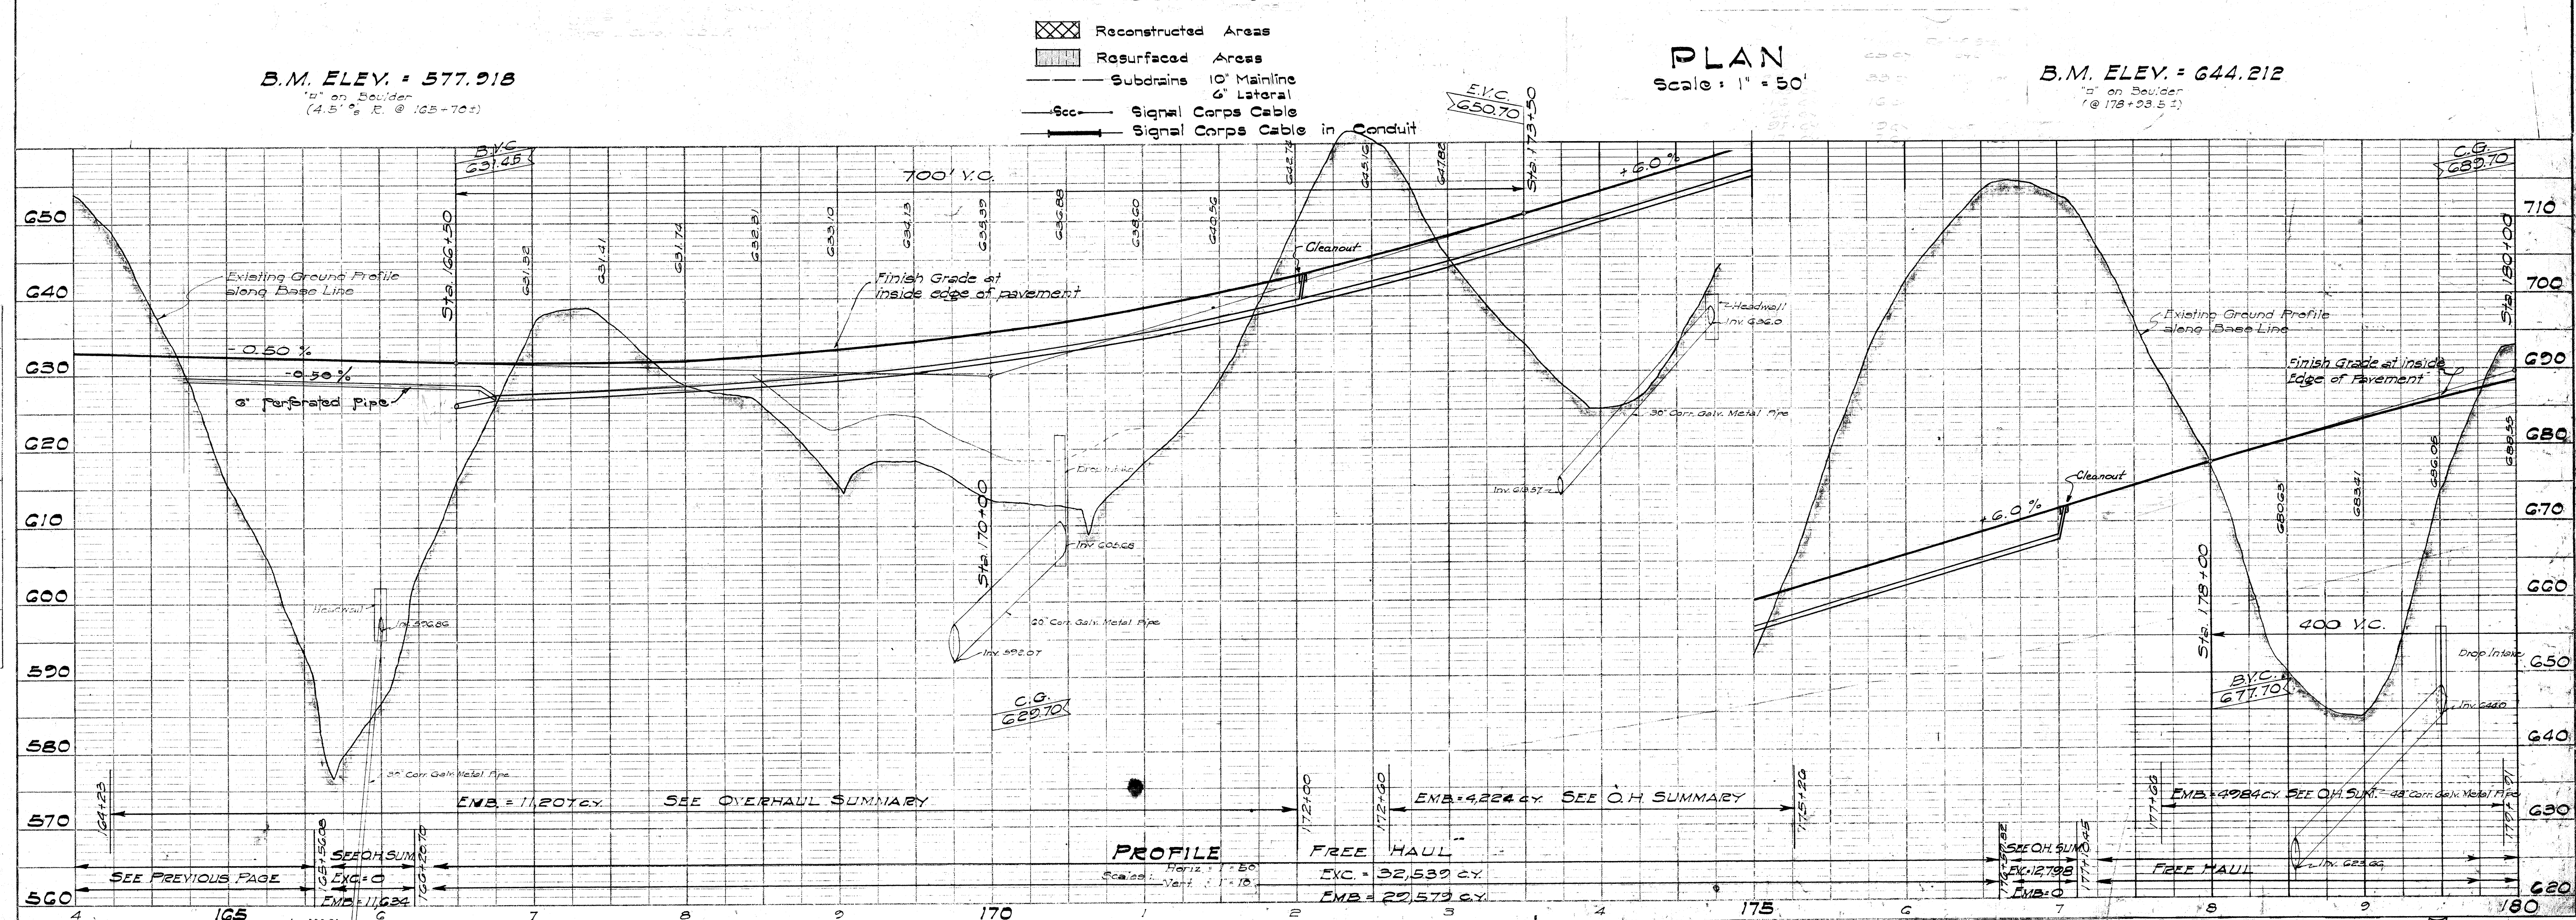
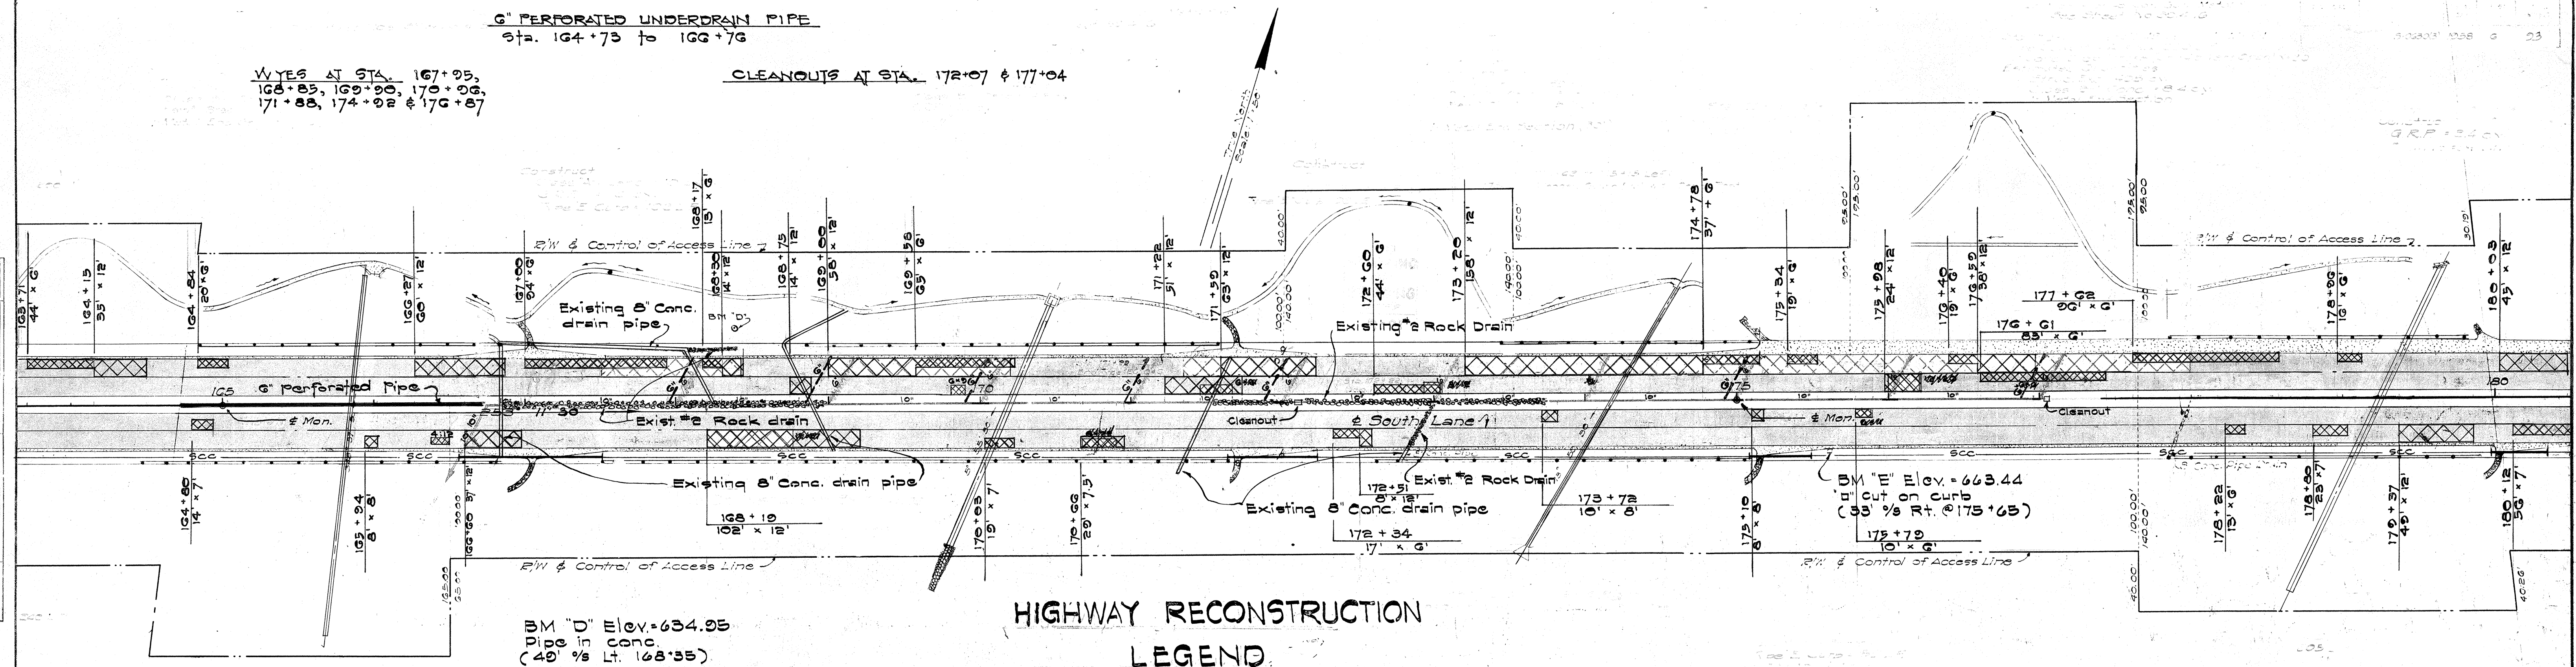


PLAN	DATE
SURVEYED	BY
PLOTTED	
NOTE BOOK	
ALIGNMENT CHECKED	
RT. OF WAY CHECKED	
NO. 100	

PROFILE	DATE
SURVEYED	BY
PLOTTED	
NOTE BOOK	
GRADES CHECKED	
NO. 100	
STRUCTURE NOTING CHD.	

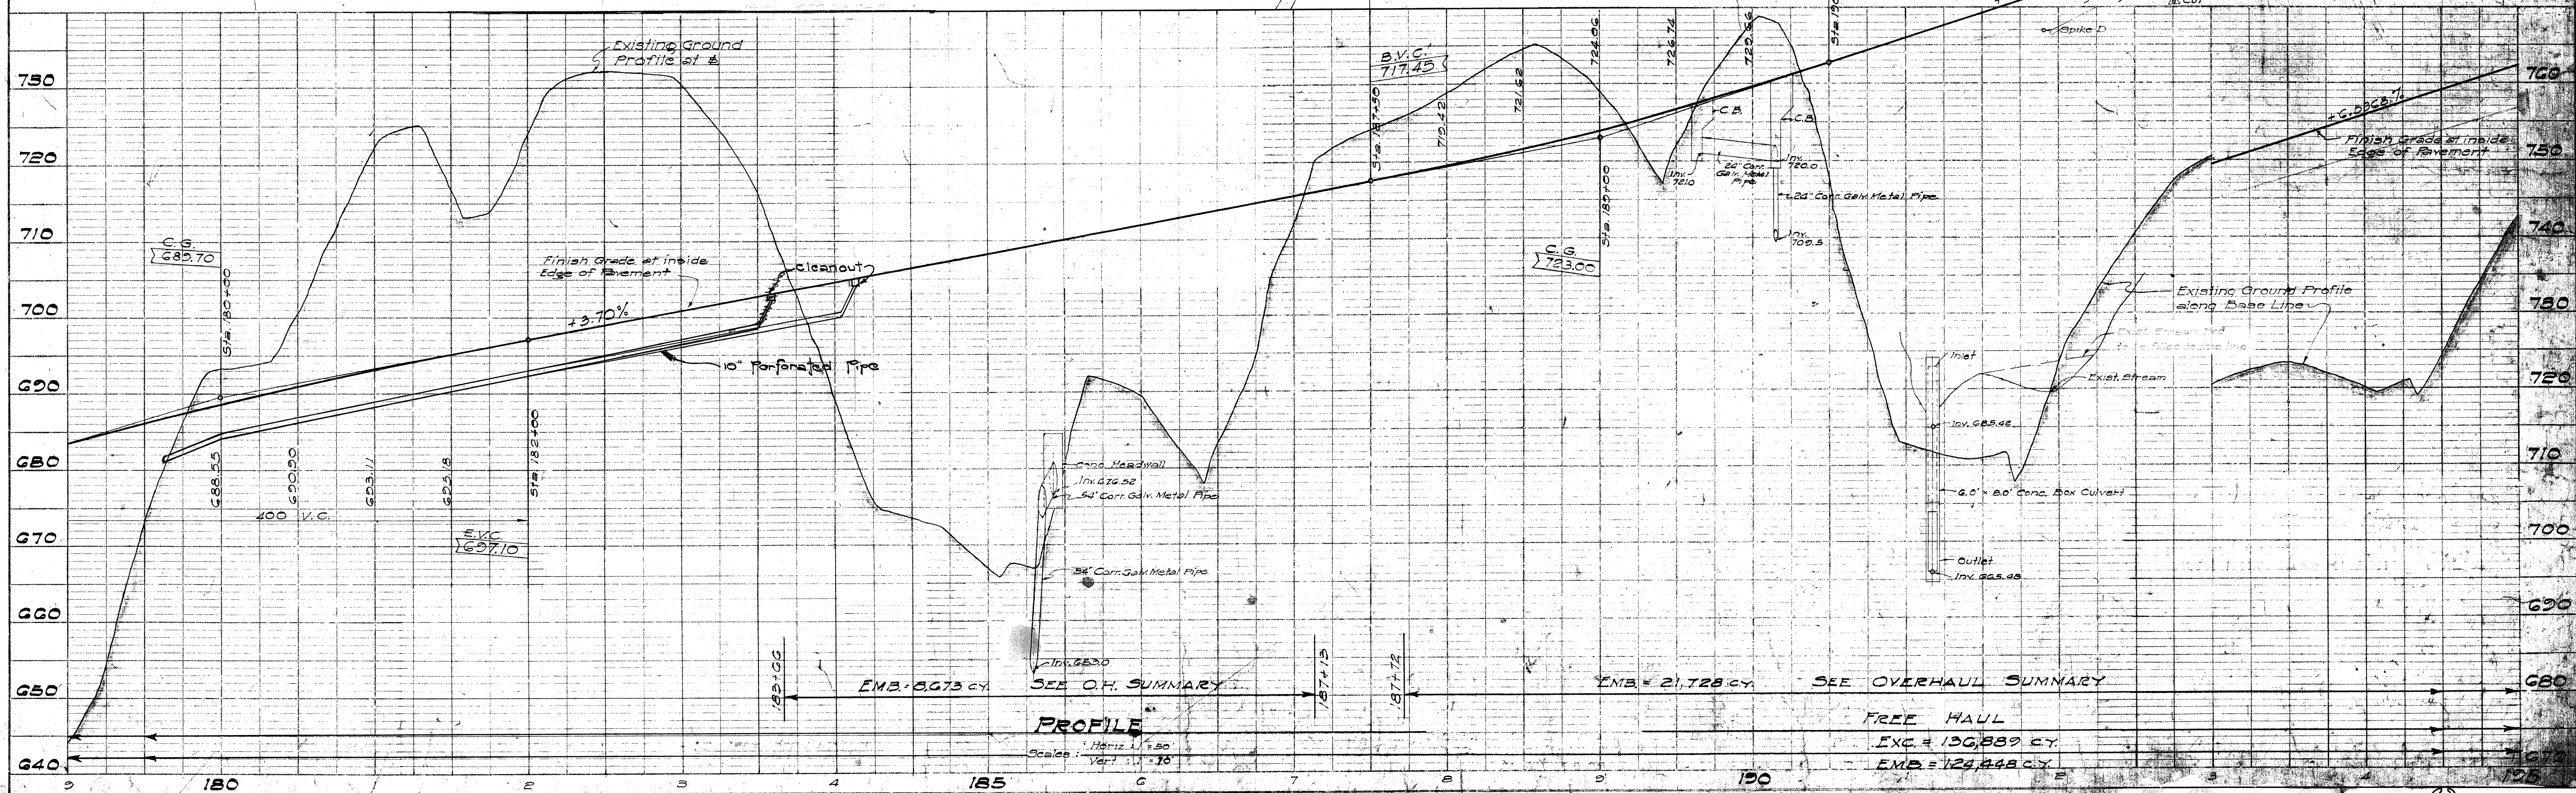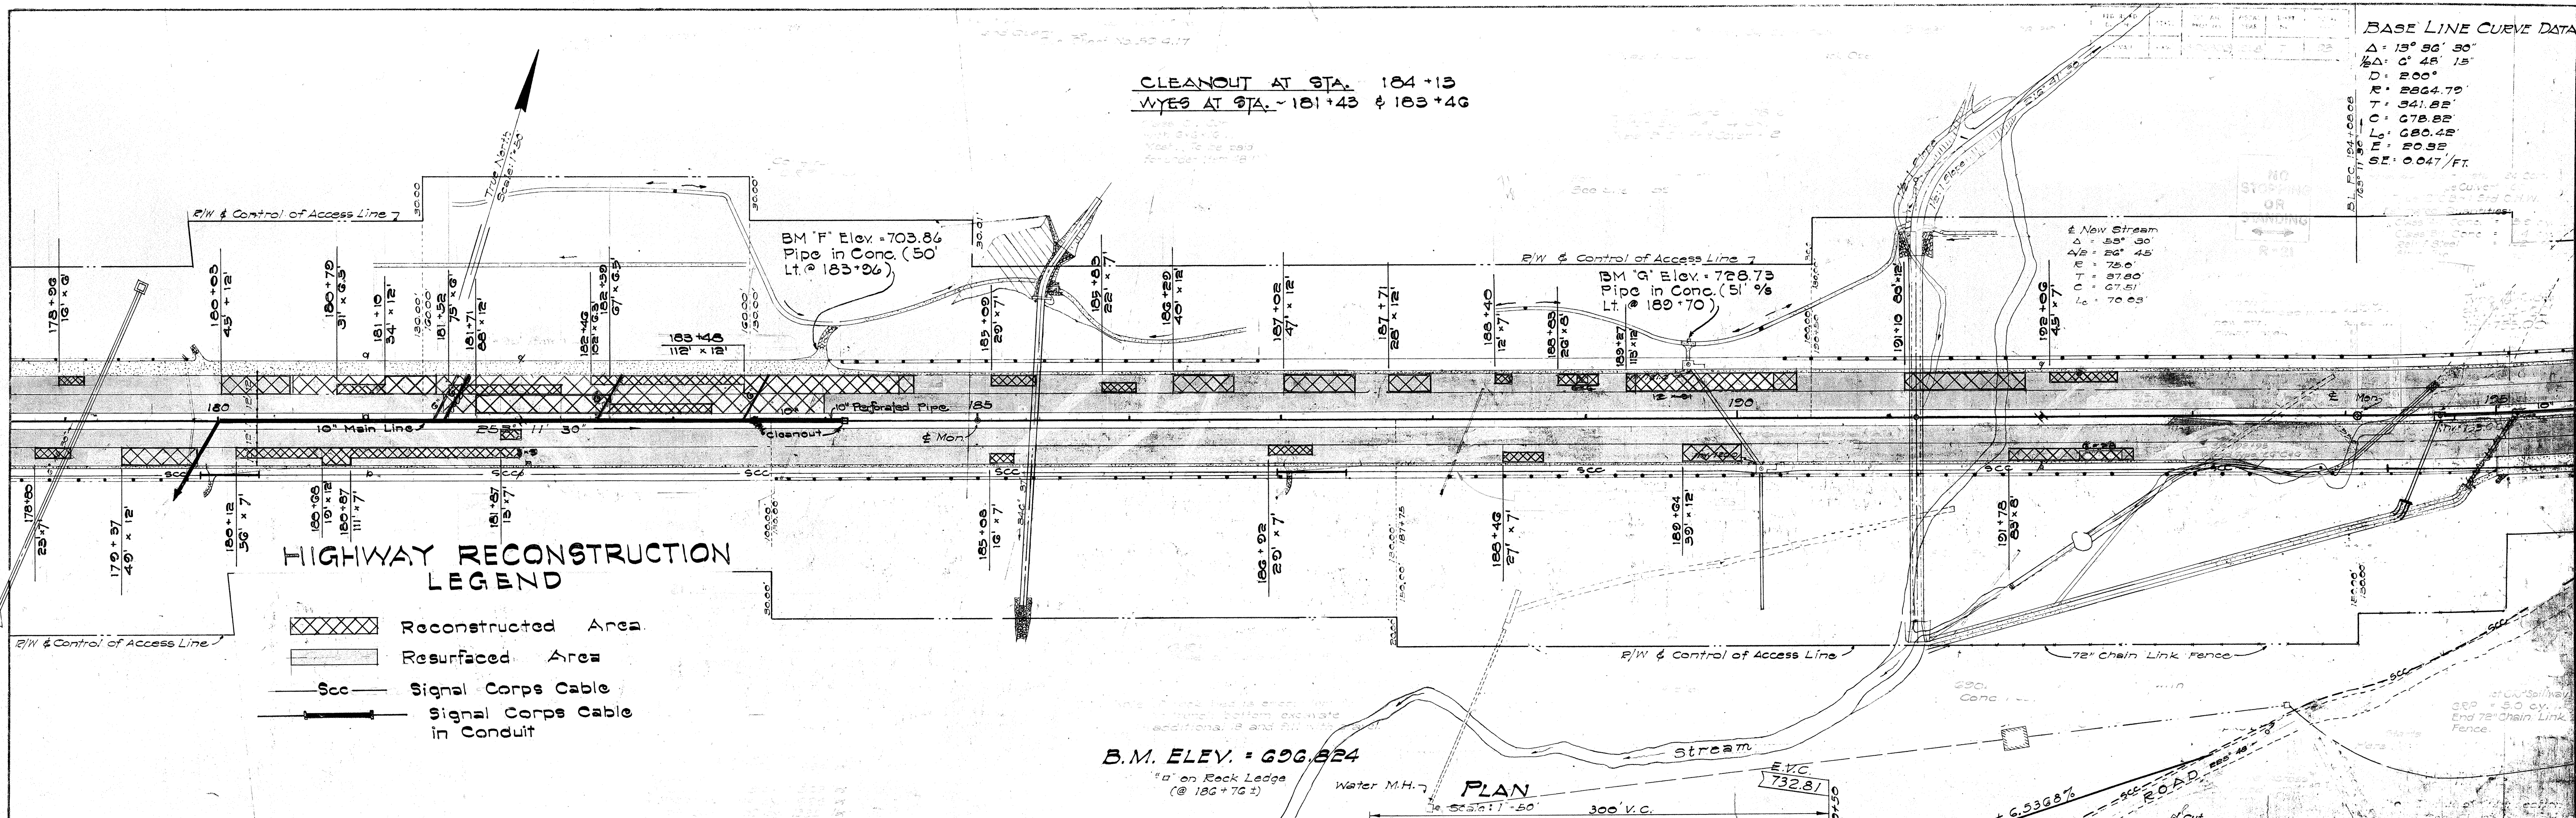

DATE	BY	SURVEYED	PROFILE
		PLOTTED	
		GRADES CHECKED	NOTE 500K
		B. M.'S NOTED	NO.
		STRUCTURE NOTATIONS CH'VD.	

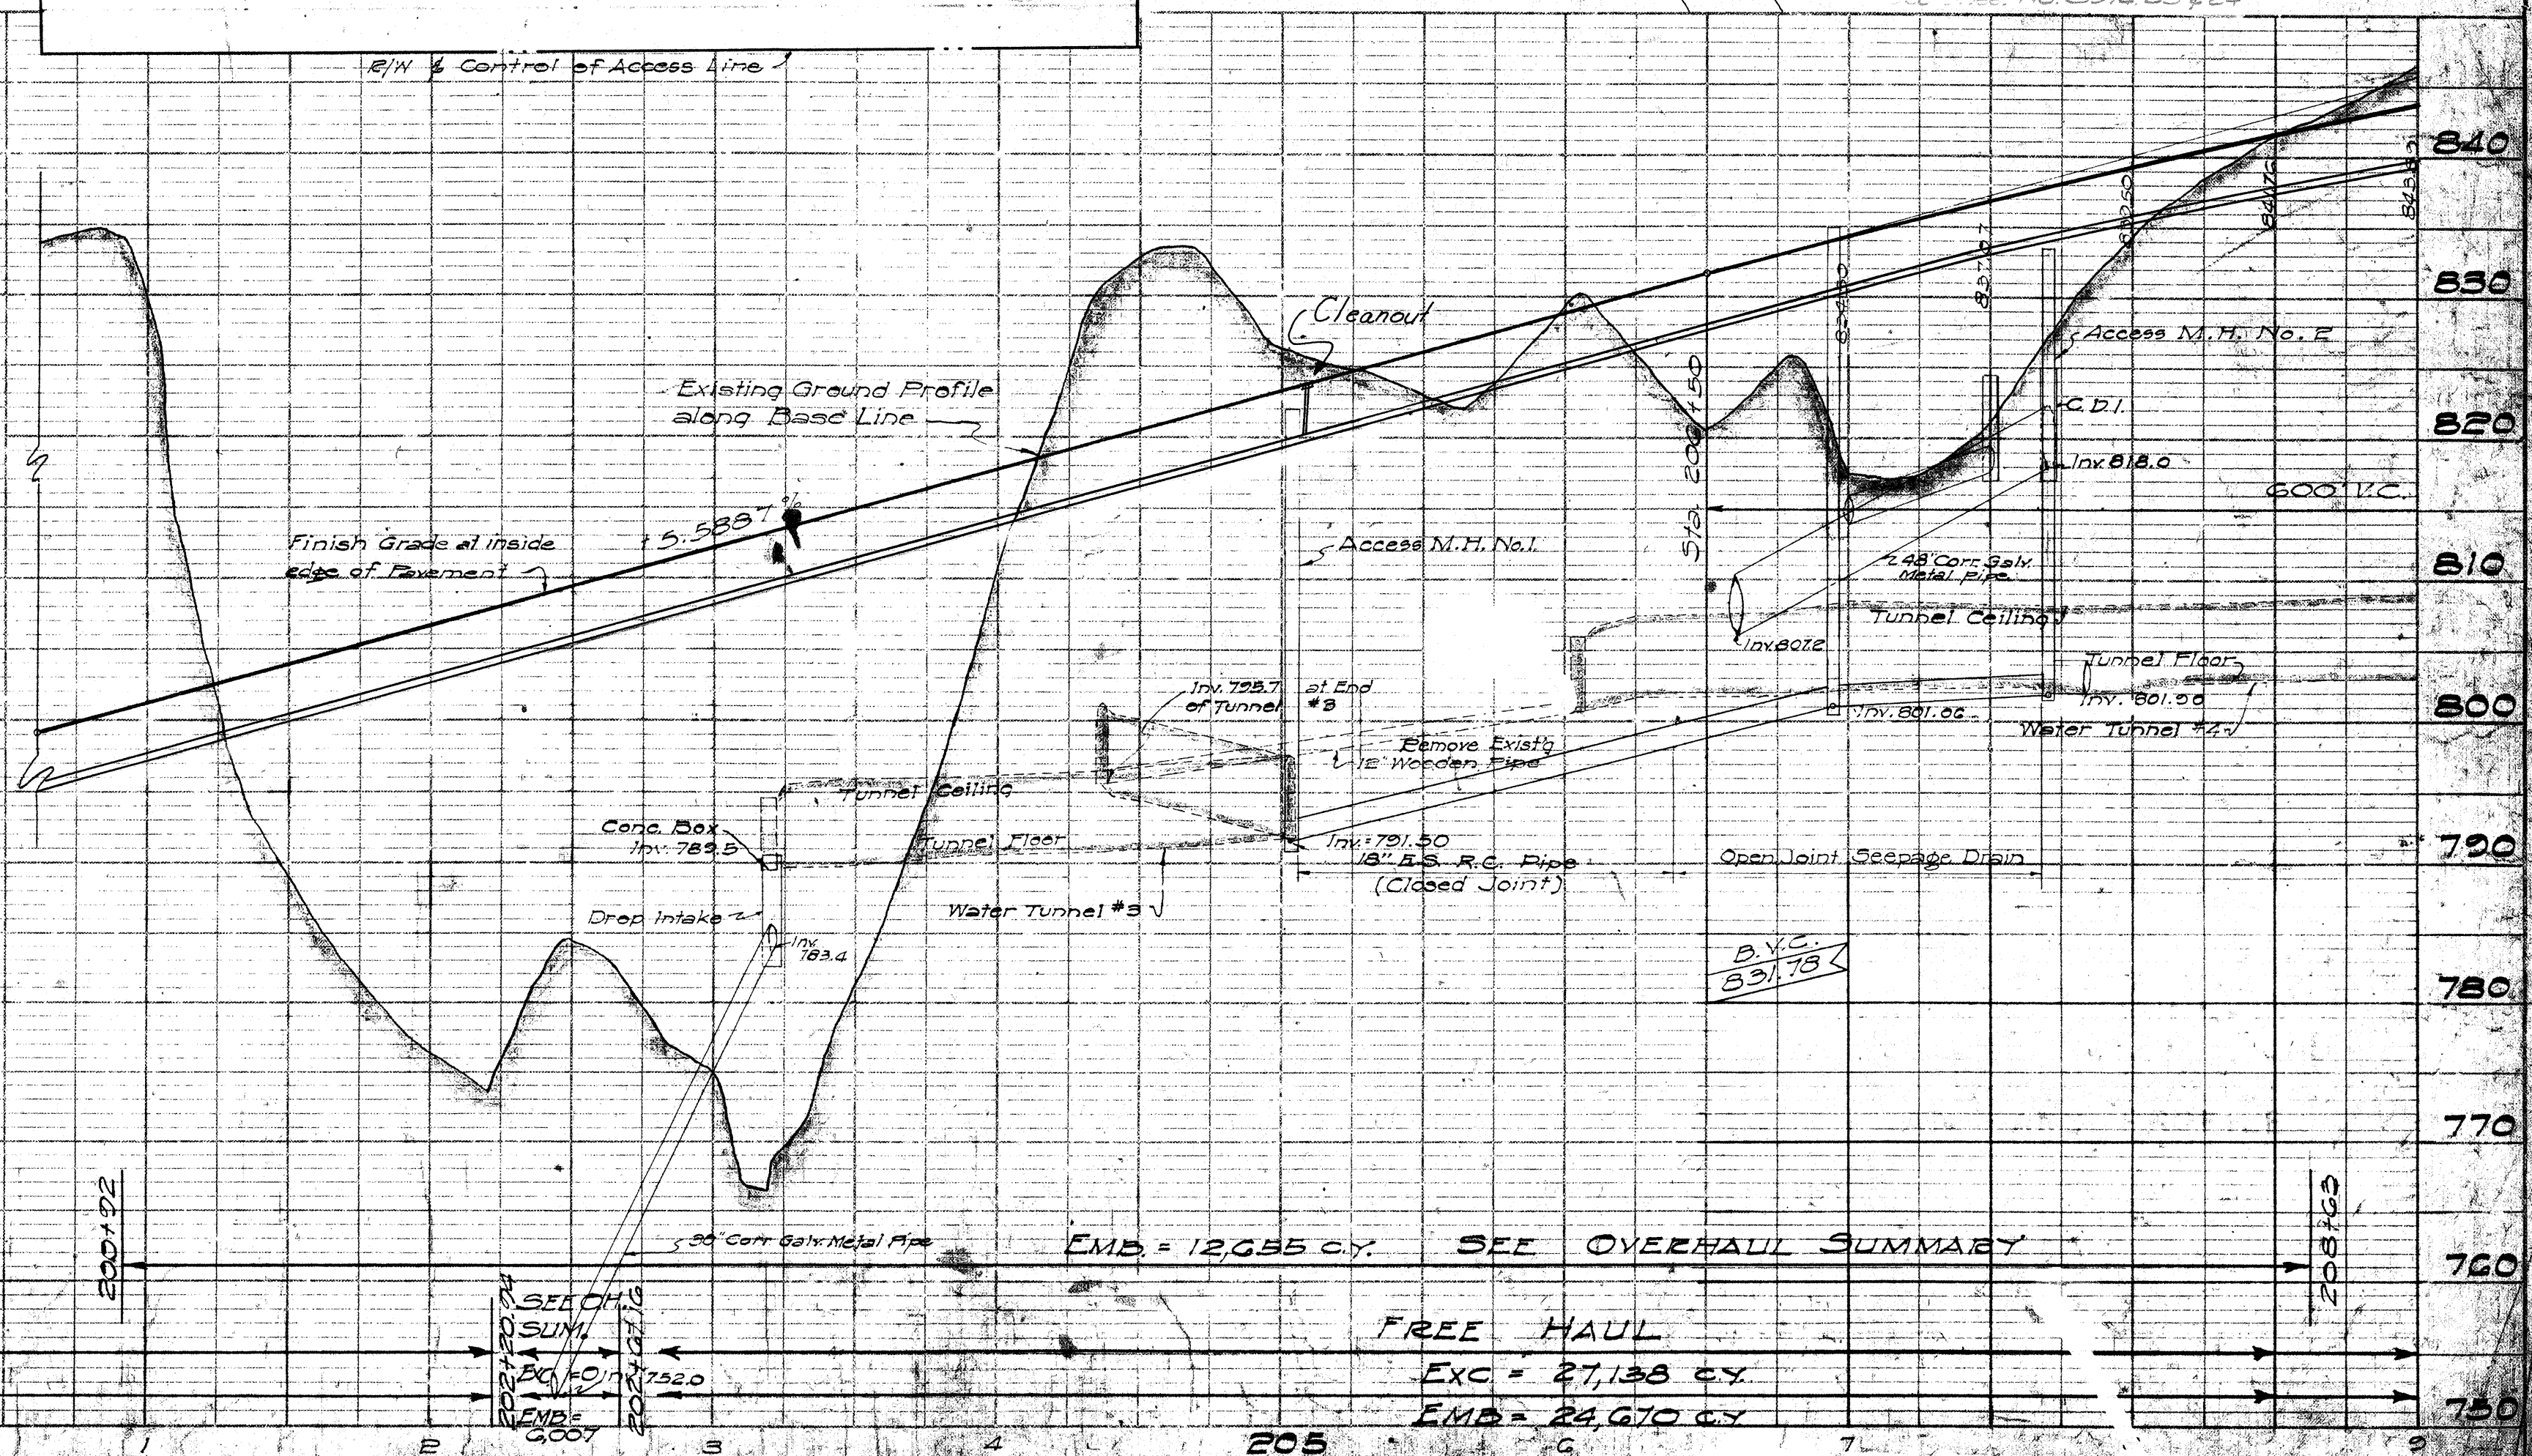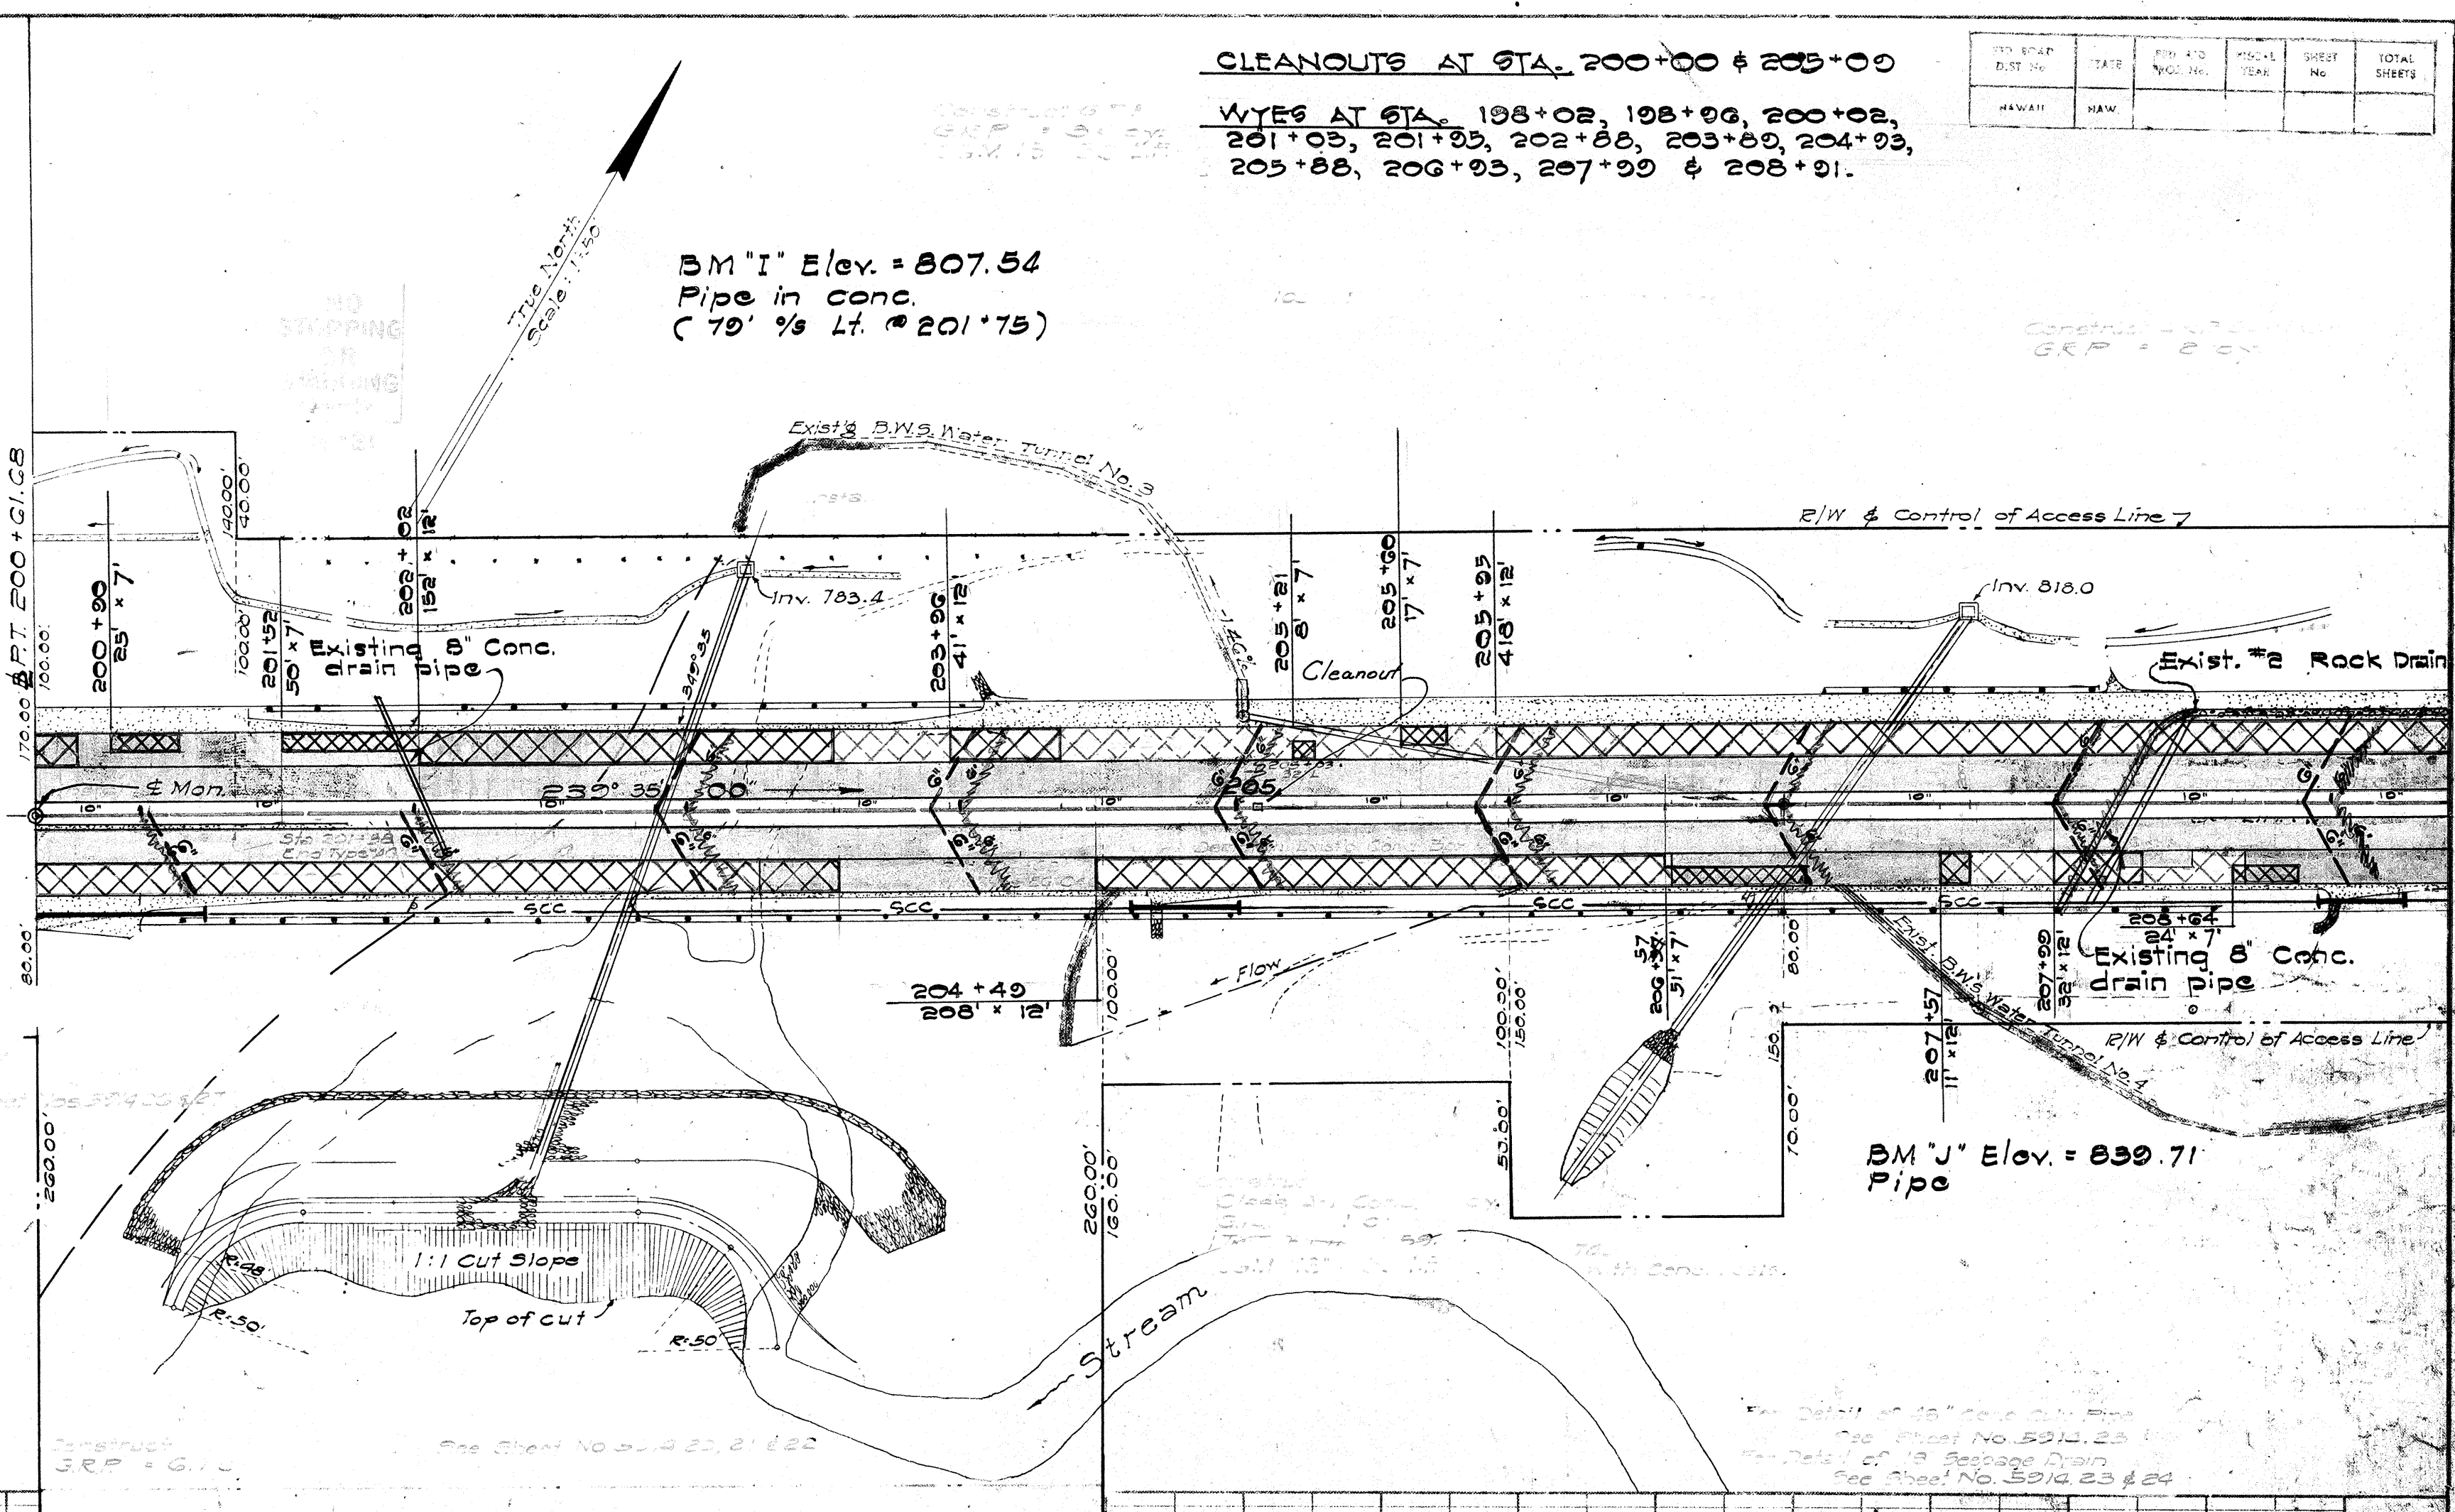

PLAN	SURVEYED	BY	DATE
	PHOTOD		
NOTE BOOK	ALIGNMENT CHECKED		
NO.	RT. OF WAY CHECKED		

PROFILE	SURVEYED	BY	DATE
	PLOTTED		
NOTE BOOK	GRADES CHECKED		
NO.	B. M.'S NOTED		
	STRUCTURE NOTATIONS CHECKED		

