

INDEX TO DRAWINGS	
SHEET NO.	DESCRIPTION
1	TITLE SHEET
2	TYPICAL SECTIONS
3-8	PLAN & PROFILE
9	DRAINAGE DETAILS

STATE OF HAWAII

DEPARTMENT OF TRANSPORTATION

HIGHWAYS DIVISION

HONOLULU, HAWAII

"AS BUILT"

PLANS FOR

INSTALLATION OF PERFORATED UNDERDRAINS

AND


RECONSTRUCTION AND RESURFACING

OF A PORTION OF

LIKELIKE HIGHWAY

(STA. 141+20 TO STA. 222+38)

PROJECT NO. A-630-01-62

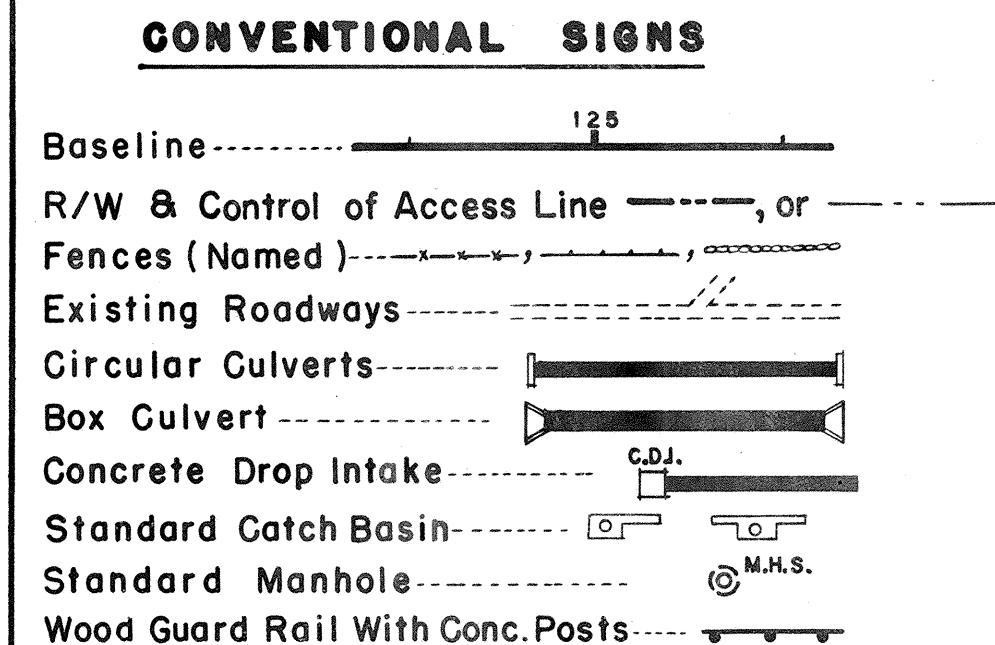

NOTE :

ALL CHANGES MADE DURING CONSTRUCTION

HAVE BEEN NOTED ON THESE TRACINGS IN


RED AND CHECKED BY :

*T. Williams*

for PROJECT ENGINEER


9-15-65

DATE

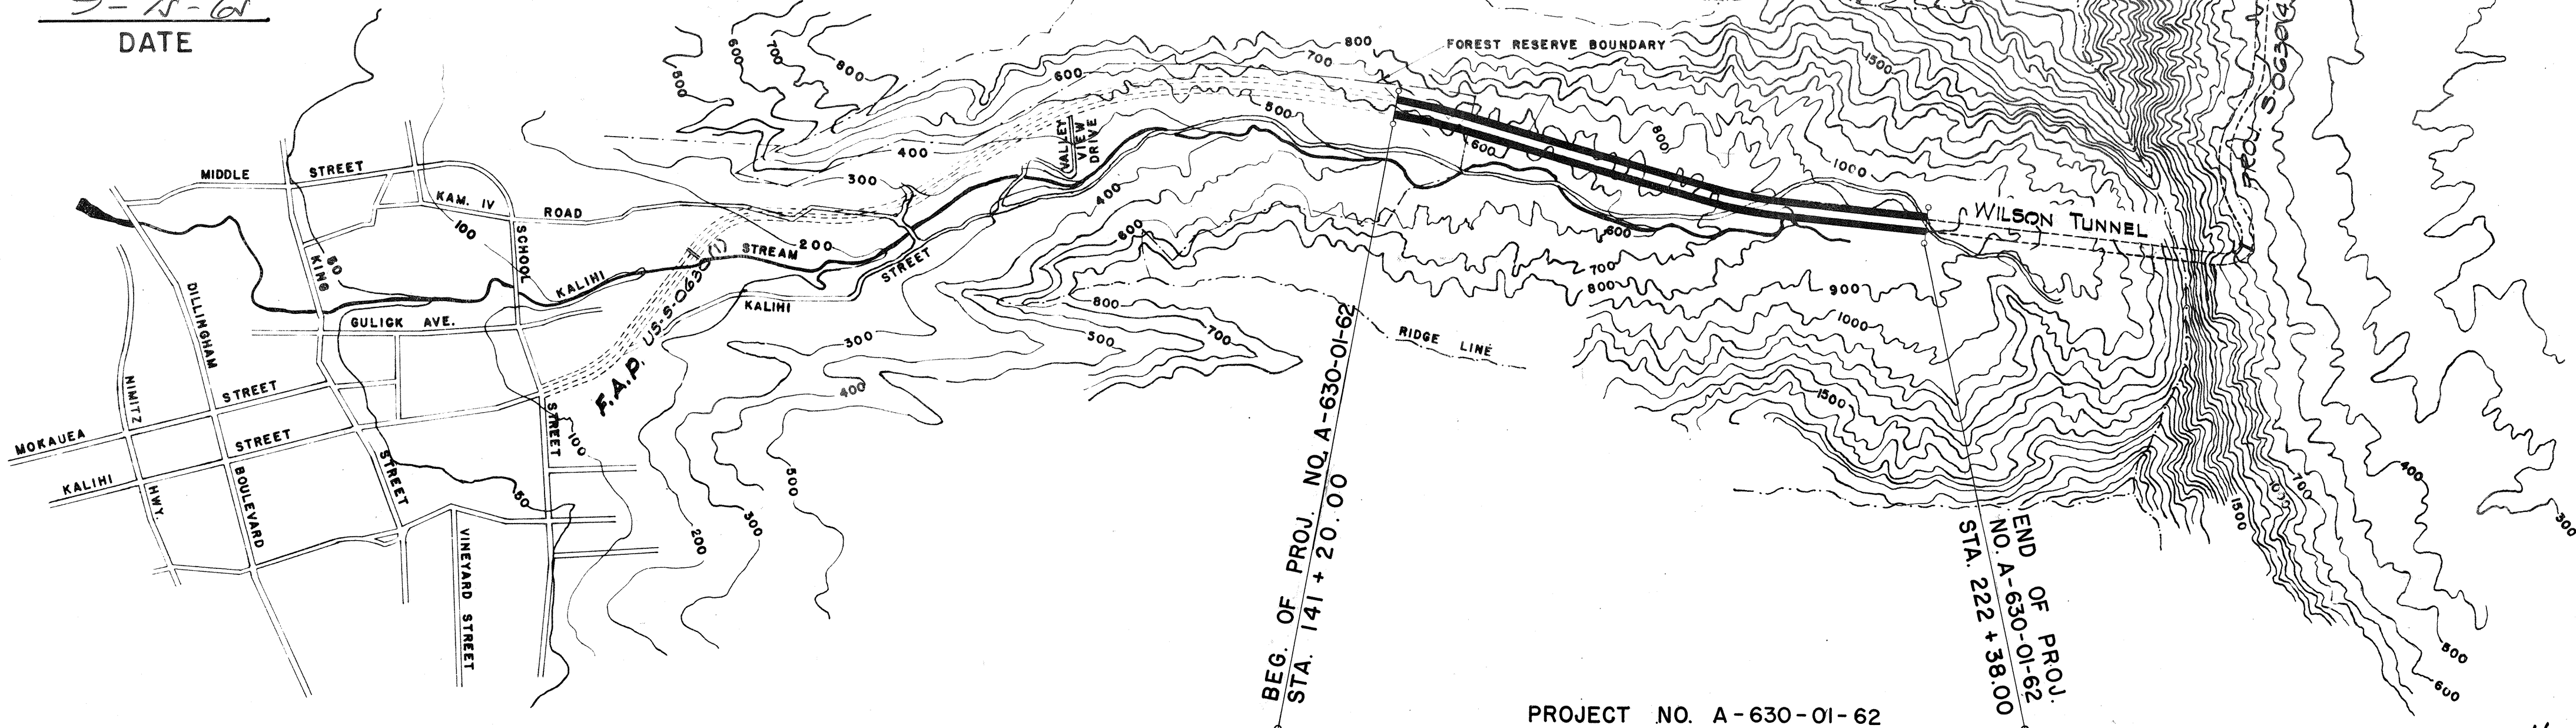

LAYOUT OF PROJECT

SCALE : 1" = 1667'

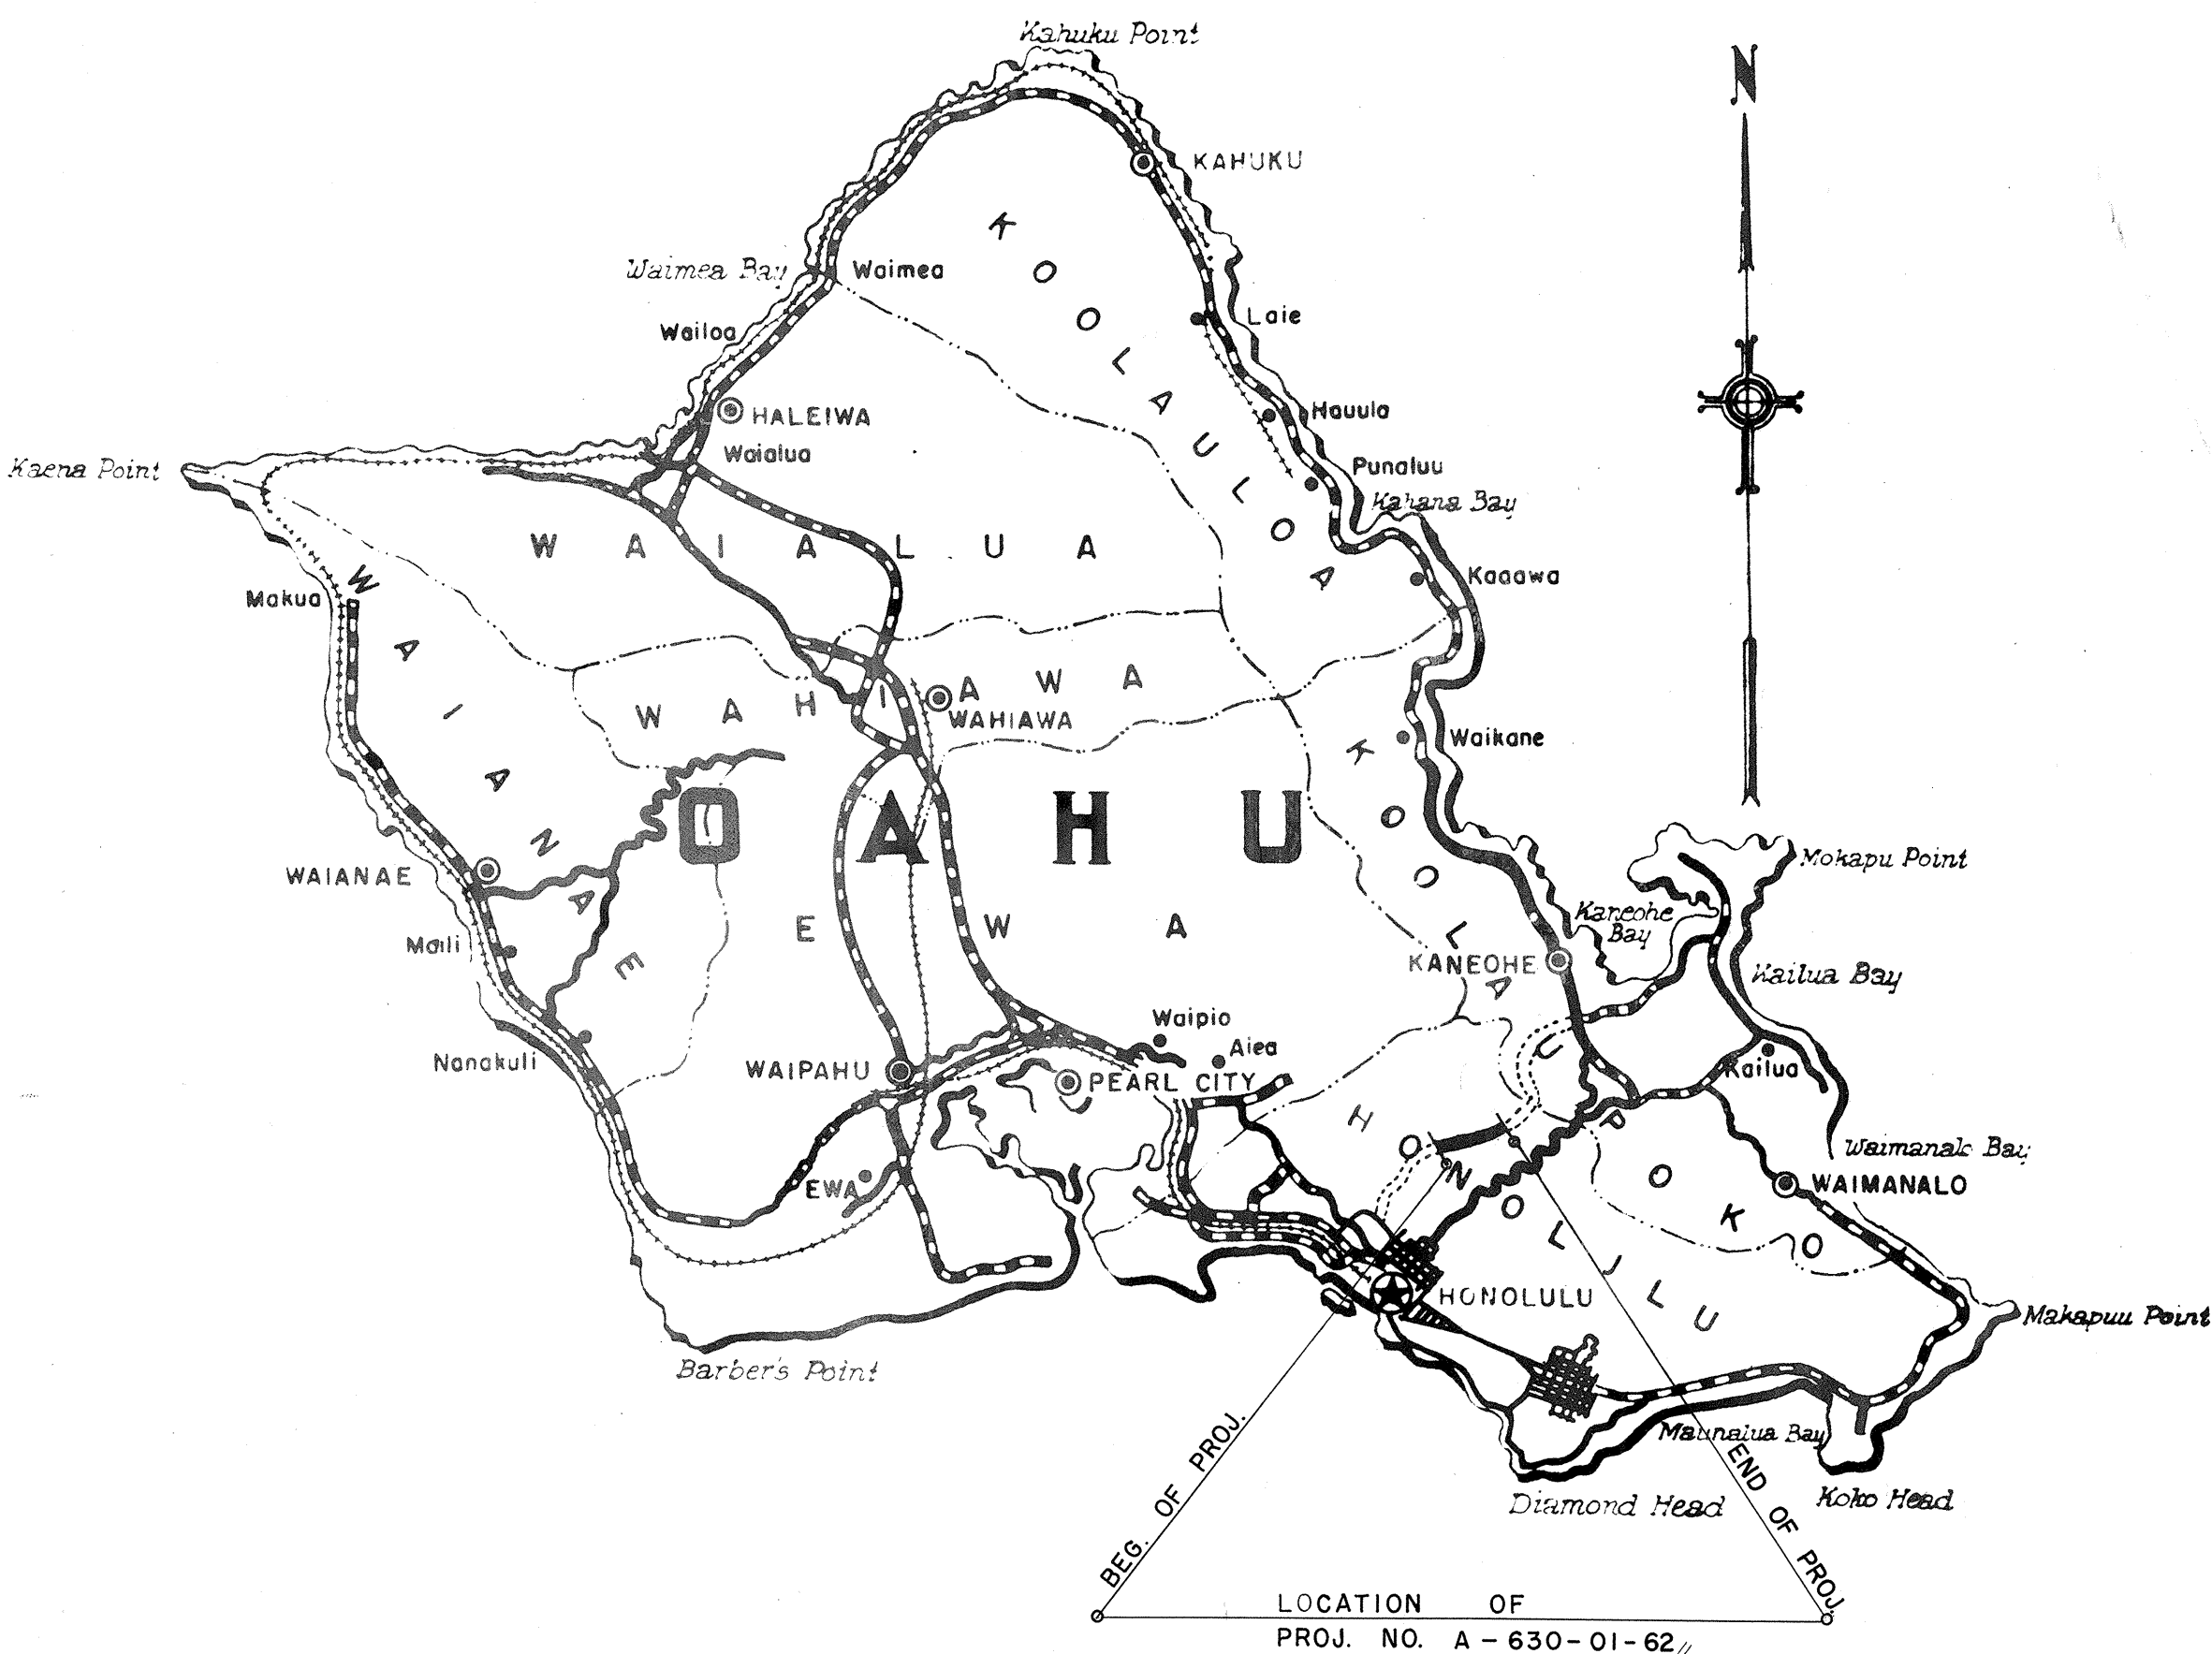

APPROVED: \_\_\_\_\_

DATE: 7/9/62

Director, Department of Transportation