



TYPICAL SECTION ON CURVES

SCALE: 1/4" = 1'-0"

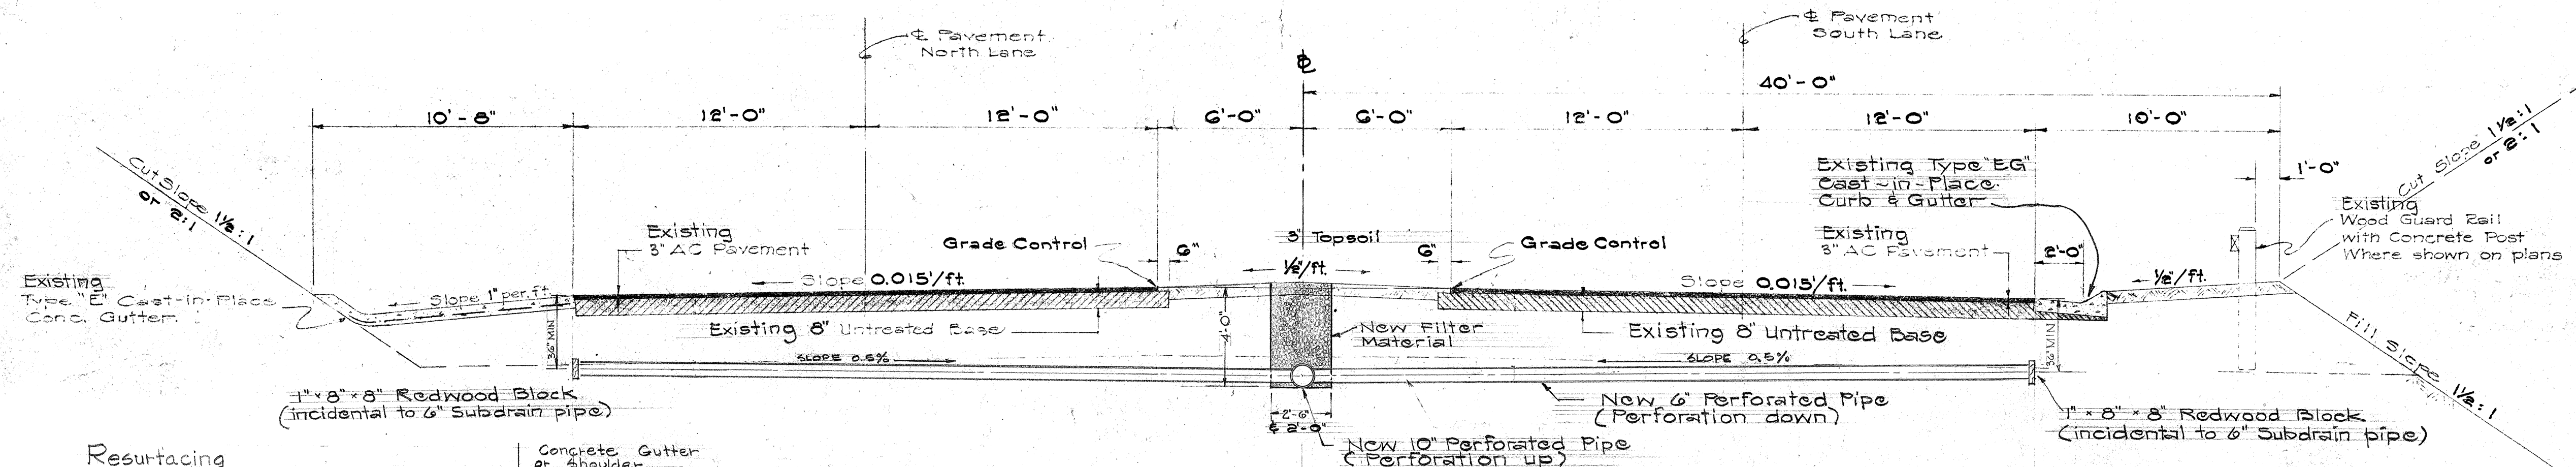


TYPICAL SECTION ON TANGENTS

SCALE: 1/4" = 1'-0"

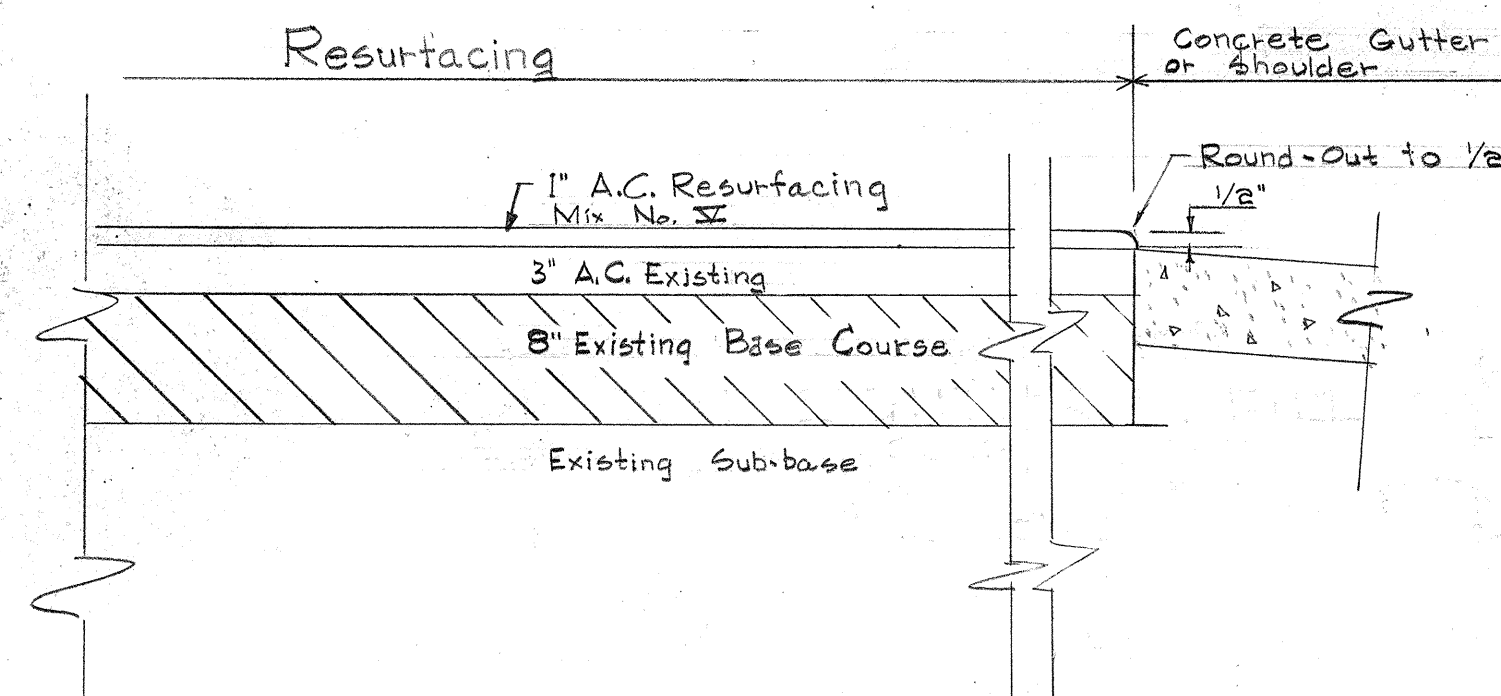

TYPICAL SECTION SHOWING RESURFACING

SCALE: 1" = 1'-0"

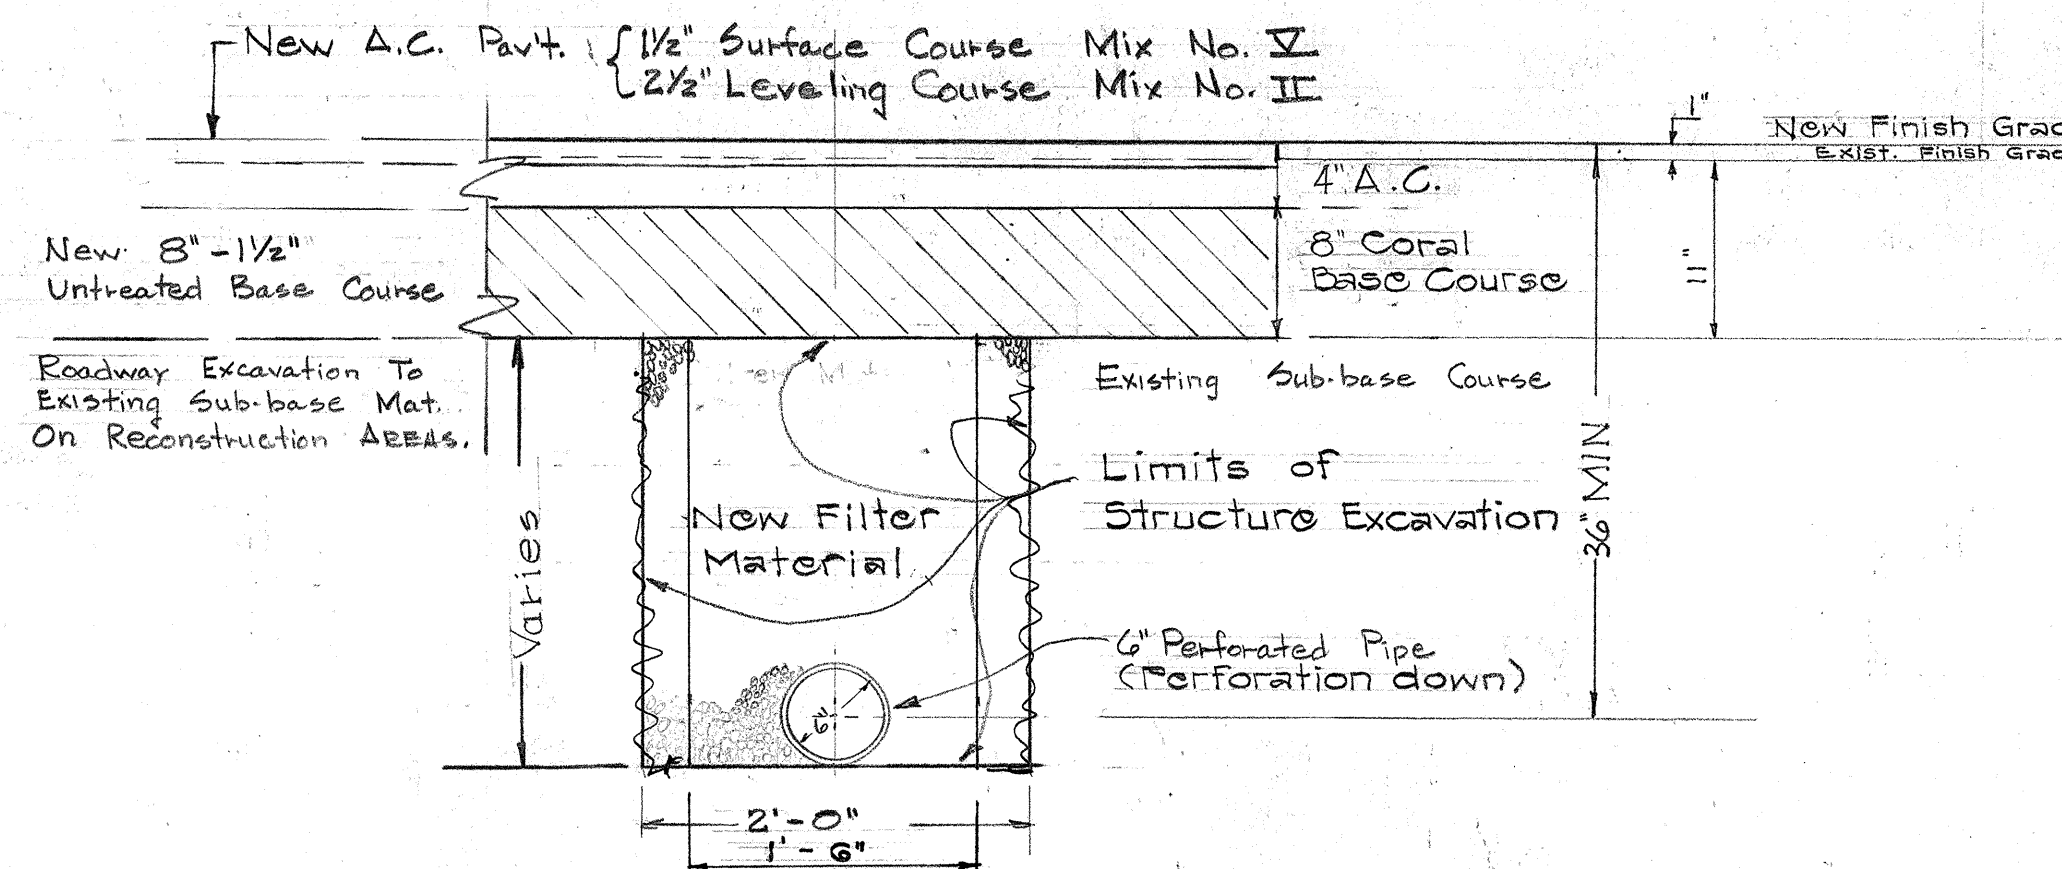

TYPICAL RECONSTRUCTION SECTION & 6" SUB-DRAIN SECTION

SCALE: 1" = 1'-0"

STATE OF HAWAII
DEPARTMENT OF TRANSPORTATION
HIGHWAYS DIVISION
TYPICAL SECTIONS
LIKELIKE HIGHWAY
(Sta. 141+20 to Sta. 222+38)
Project No. A-630-01-62
Scale: As Noted July 2, 1962

SHEET No. OF SHEETS

DATE: _____
DESIGNED BY: _____
CHECKED BY: _____
ORIGINAL PLAN: _____
NOTE BOOK: _____
NO. _____