

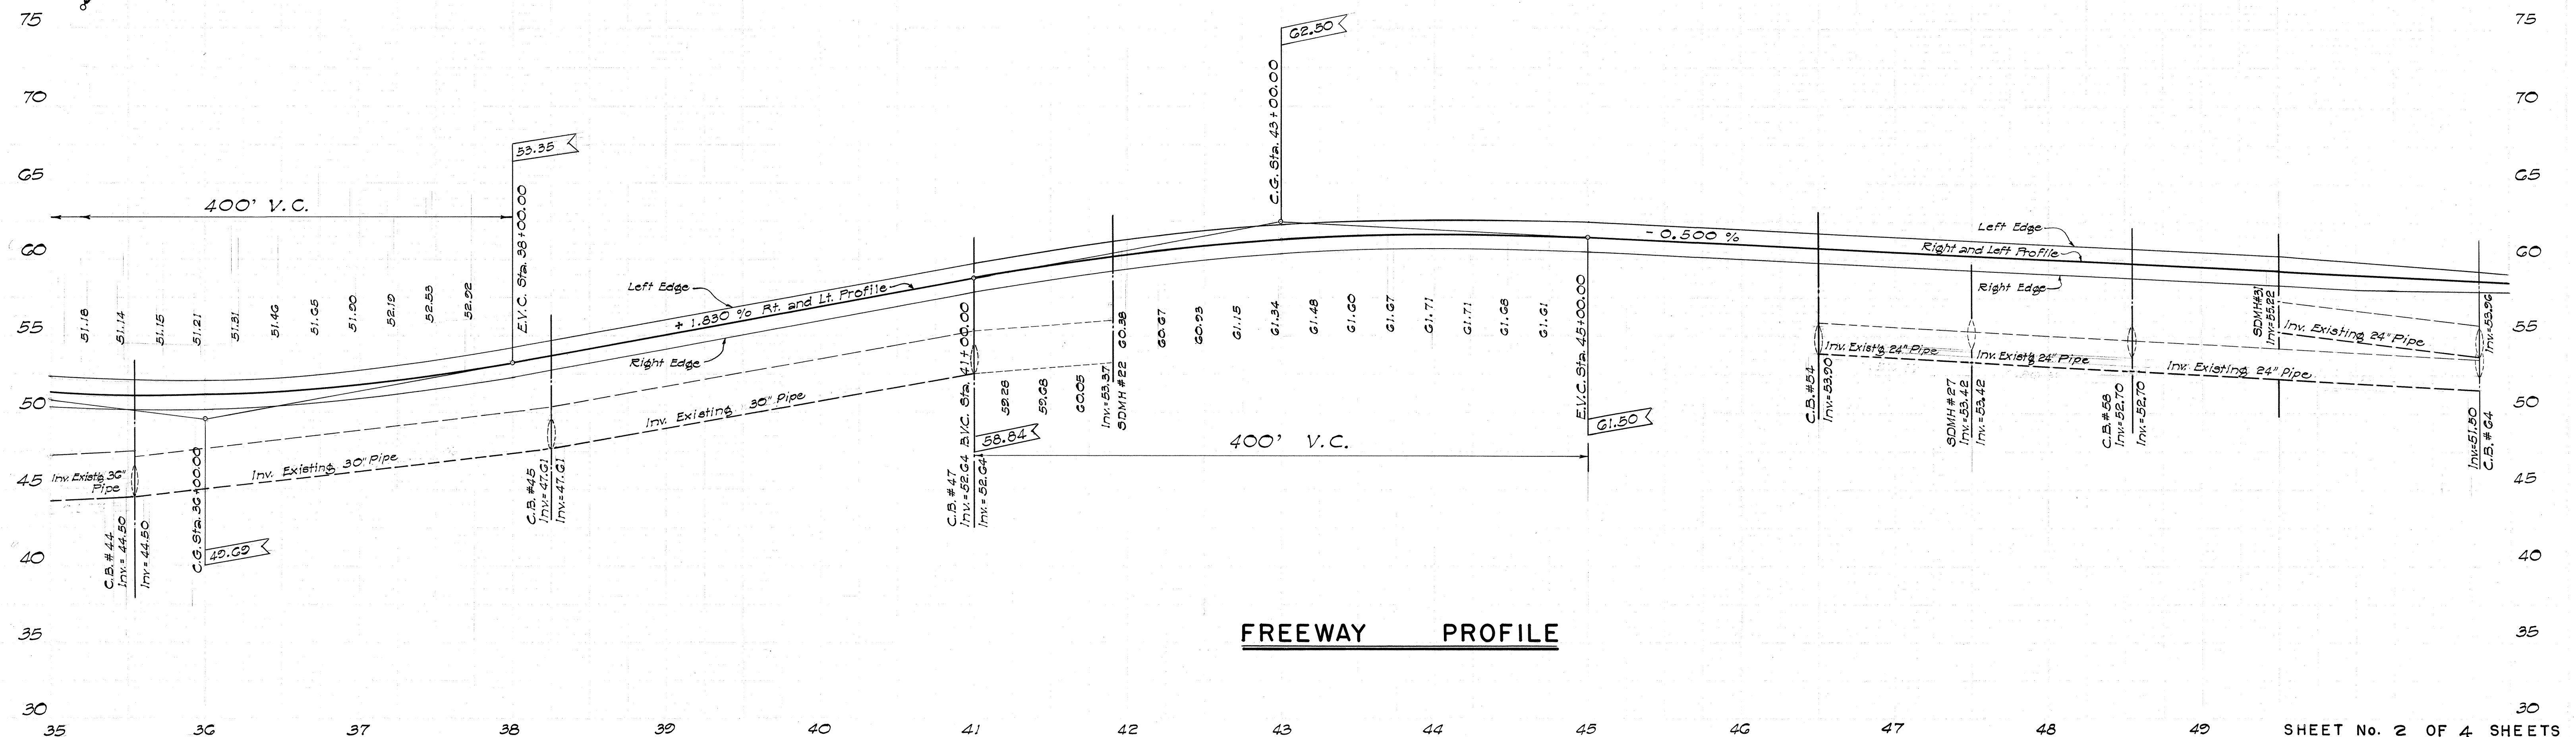
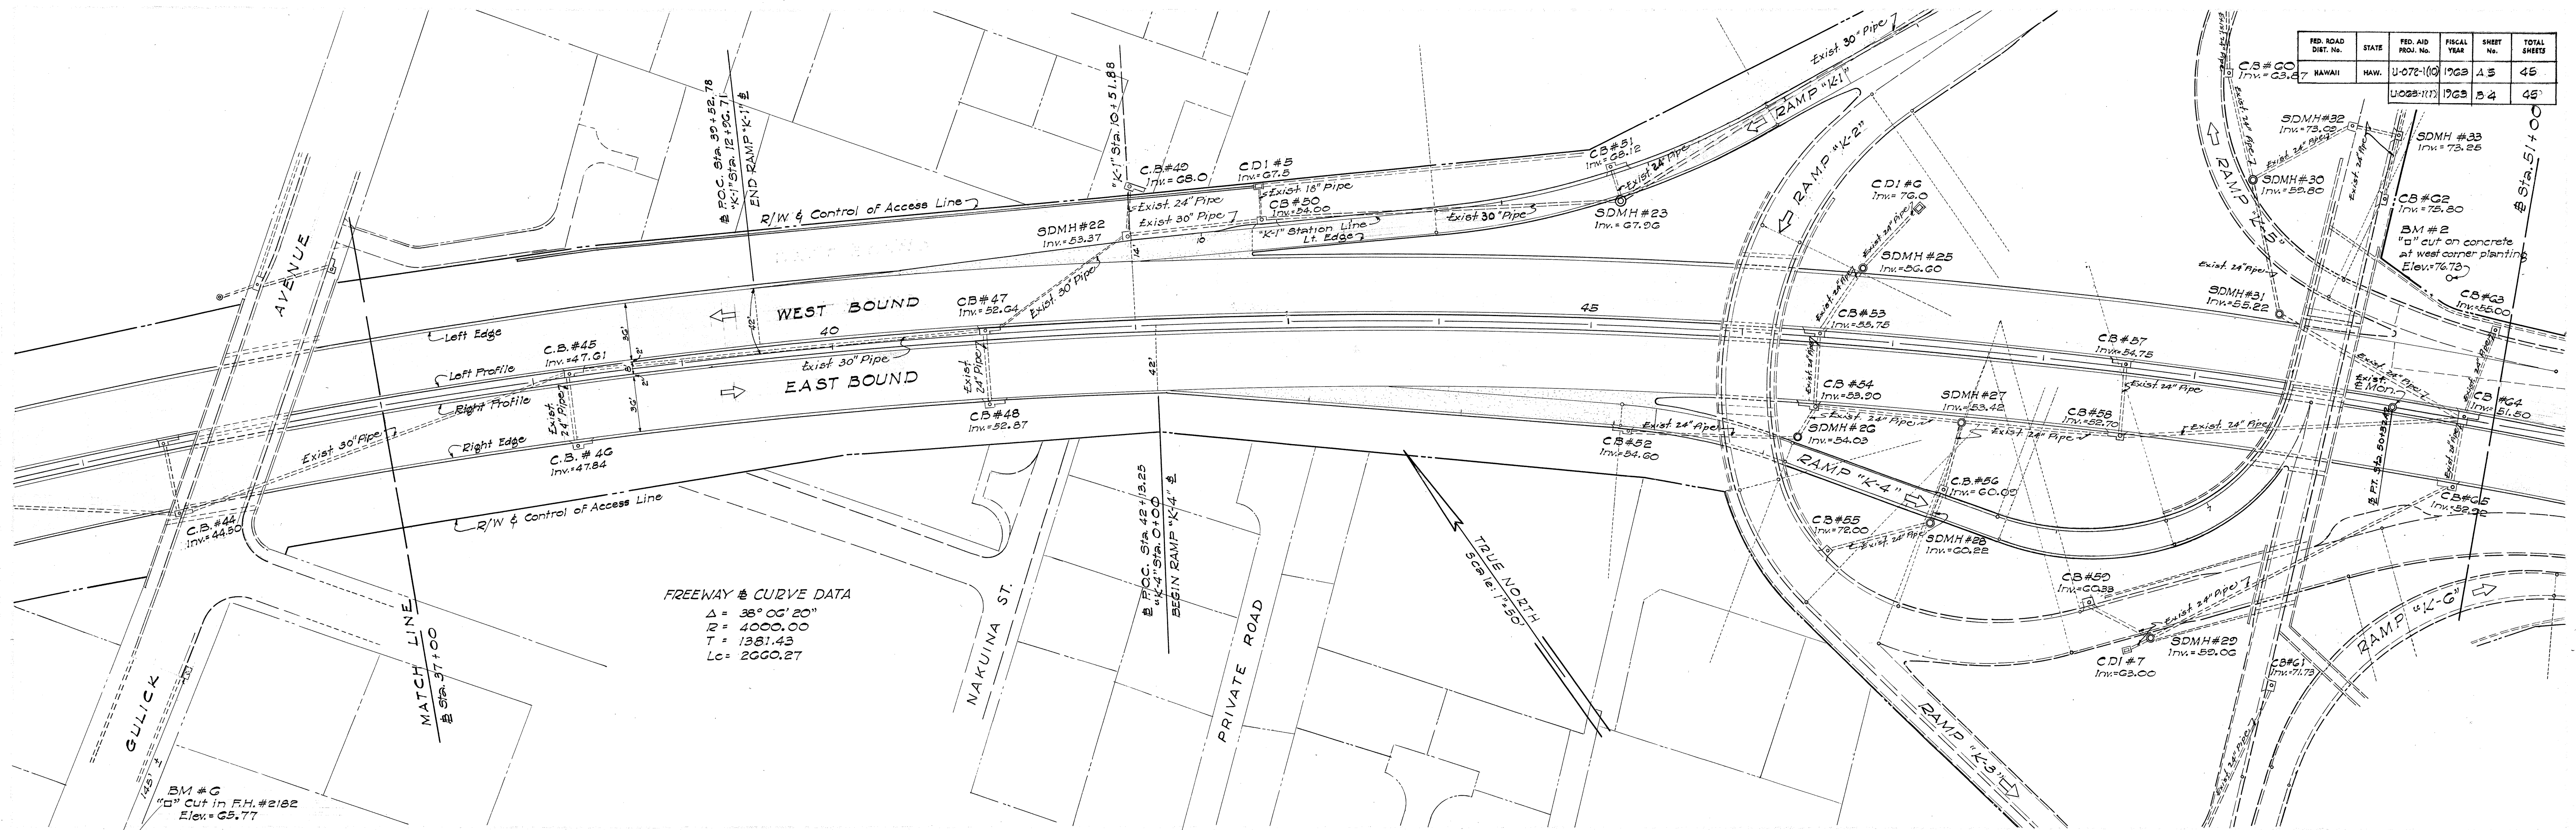


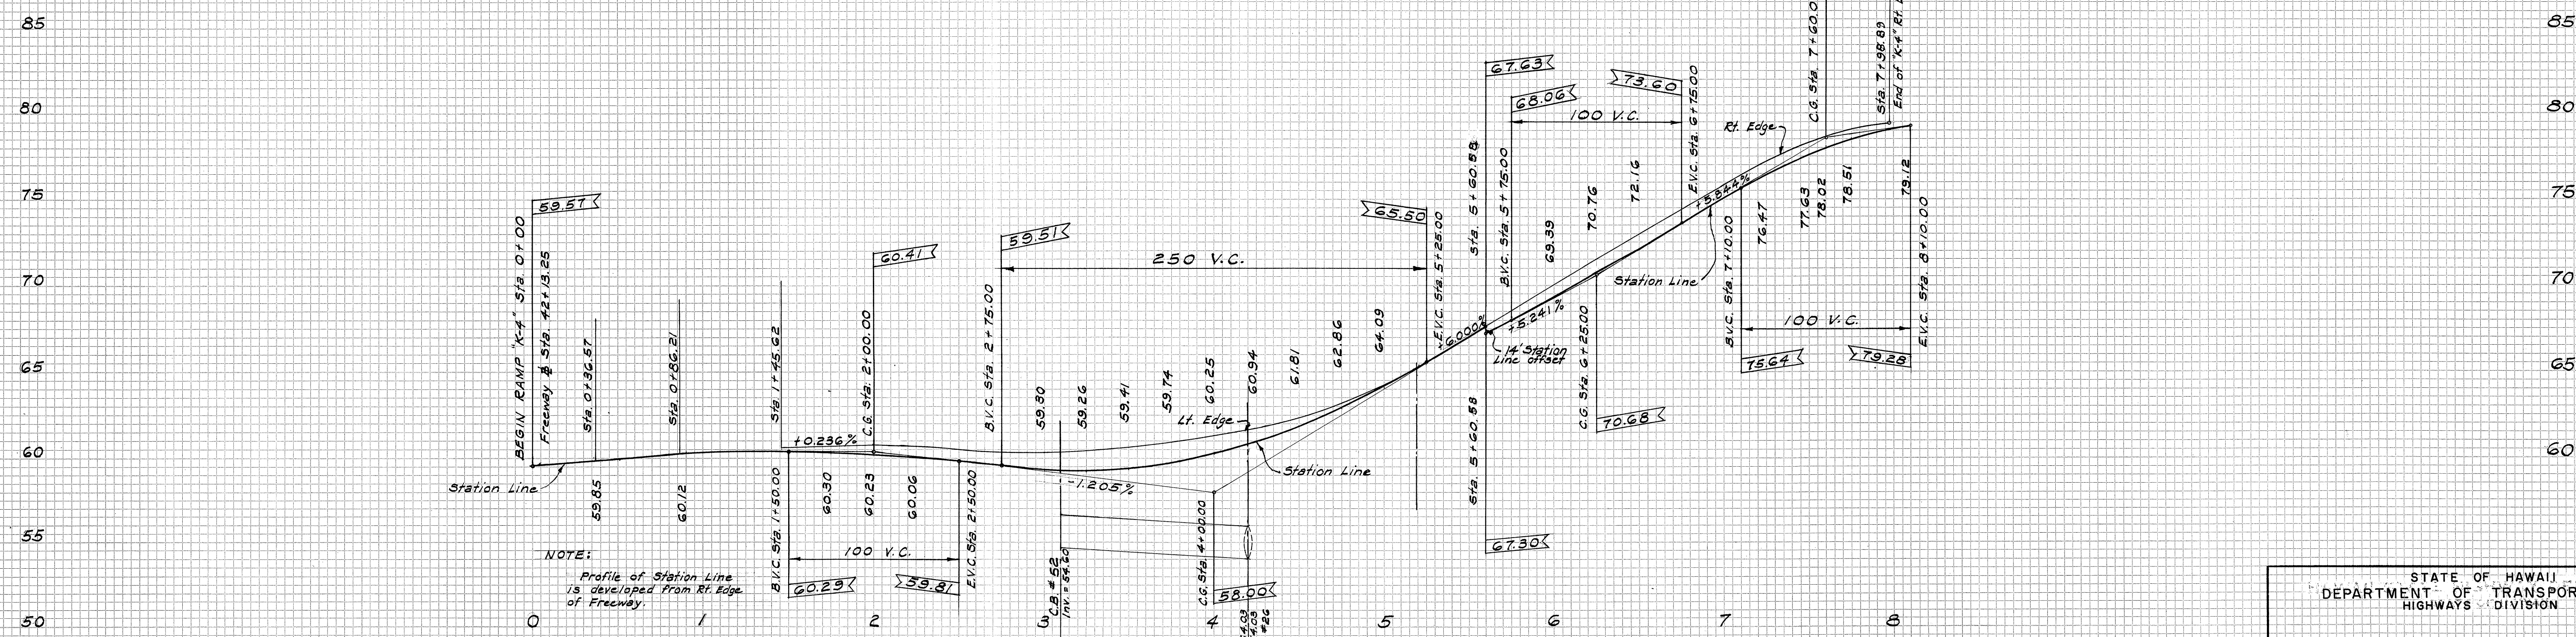

FED. ROAD DIST. No.	STATE	FED. AID PROJ. No.	FISCAL YEAR	SHEET No.	TOTAL SHEETS
	HAWAII				

DATE	BY	FINAL SURVEY	NO. OF SHEETS	NO. OF SHEETS

DATE	BY	ORIGINAL SURVEY	NO. OF SHEETS	NO. OF SHEETS

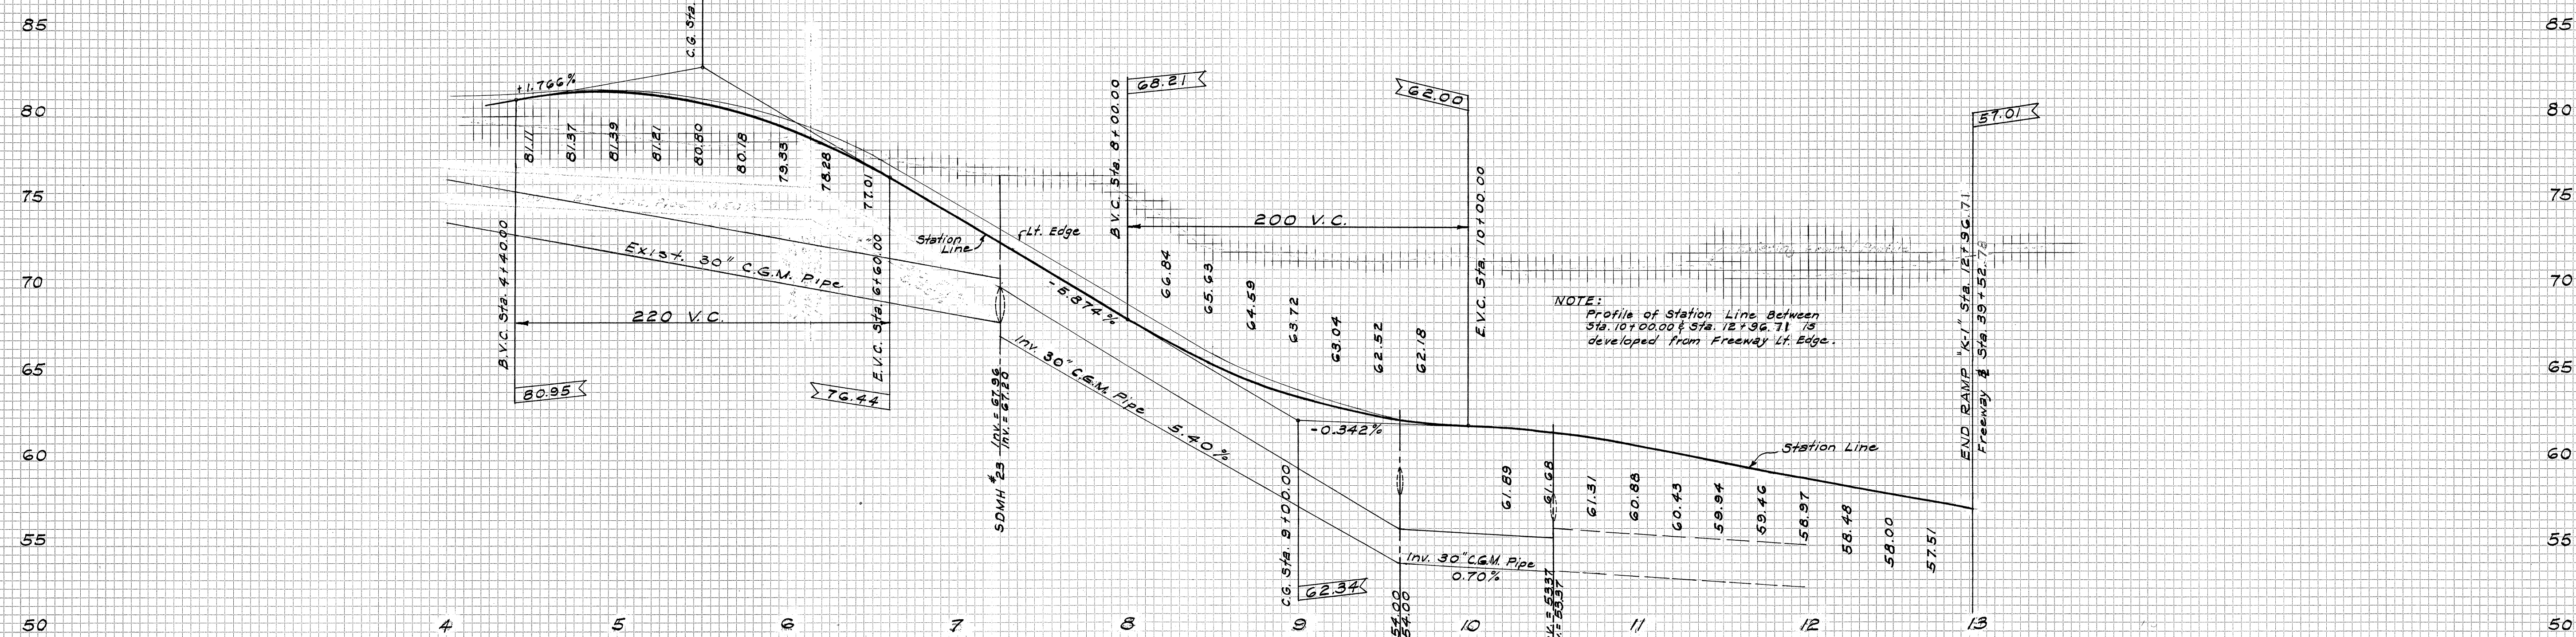

STATE OF HAWAII
DEPARTMENT OF TRANSPORTATION
HIGHWAYS DIVISION

PROFILES — RAMPS "K-1" & "K-4"

LIKELIKE HIGHWAY U-063-1(1)

SCALE: HOR. 1" = 50'
VERT. 1" = 5'

DATE: DEC., 1959