




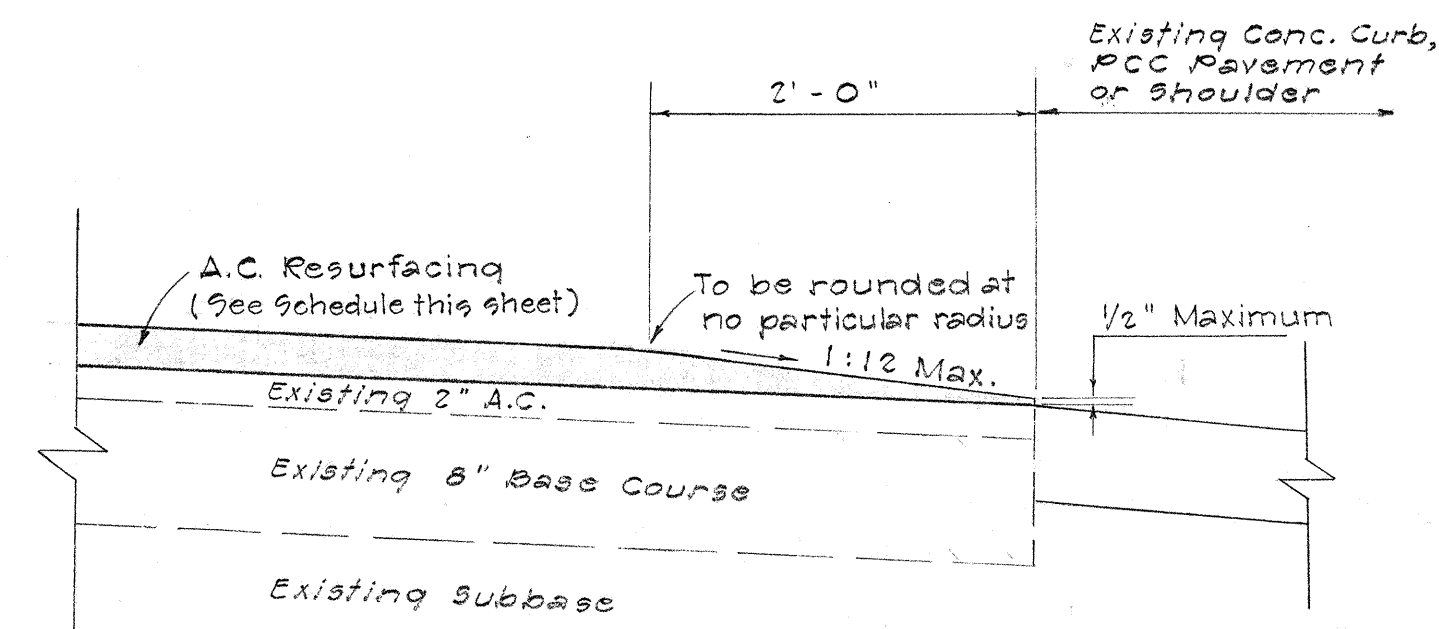

TYPICAL RESURFACING SECTION
Scale: 1" = 1'-0"

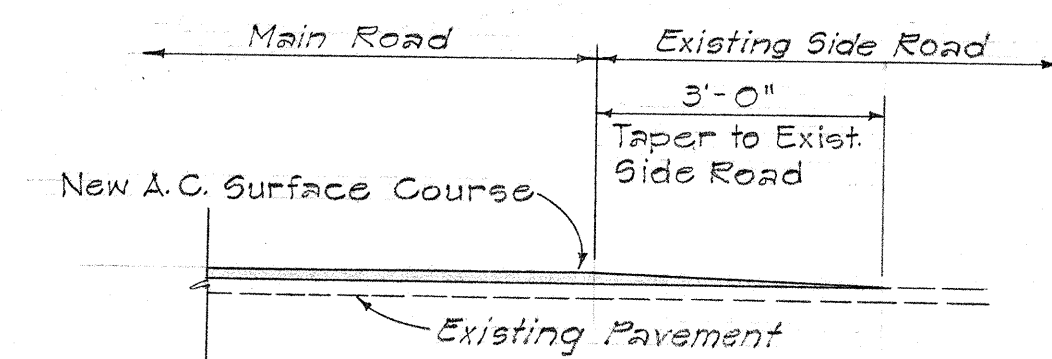


TYPICAL SECTION-SIDE ROAD CONNECTION
Not to Scale

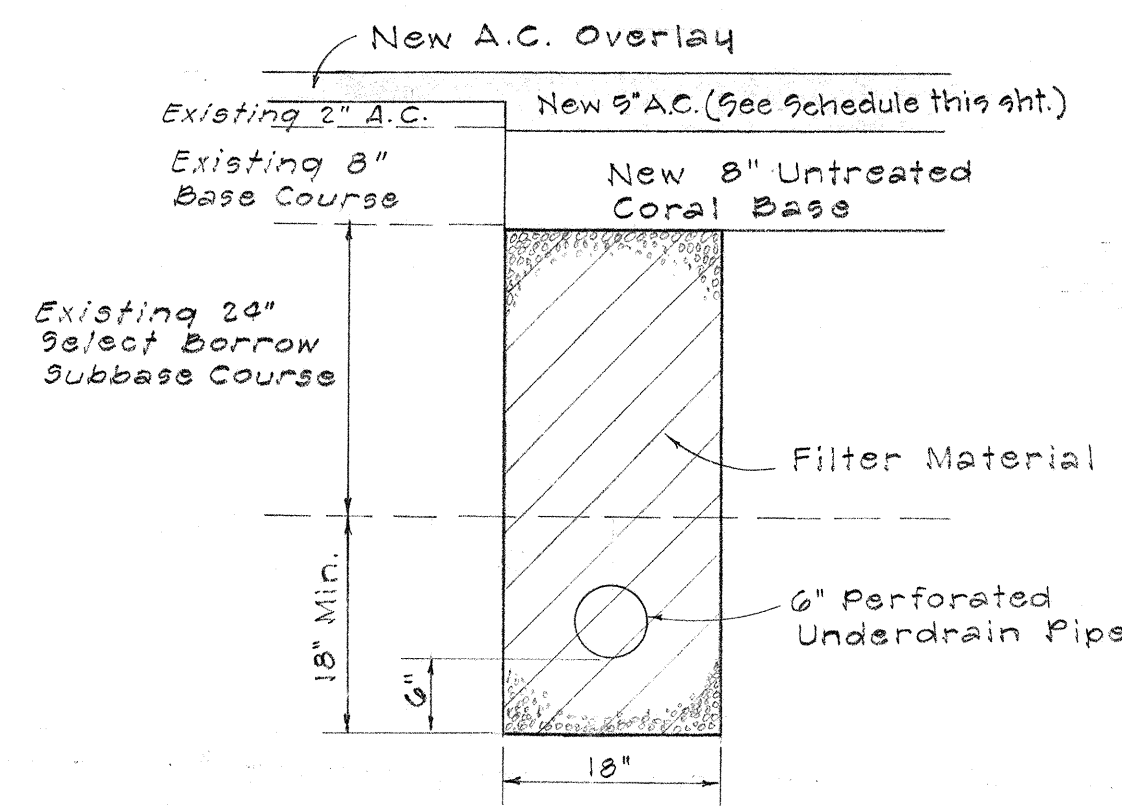

TYPICAL RECONSTRUCTION & UNDERDRAIN SECTION
Scale: 3/4" = 1'-0"


NOTES:

1. Hatched area denotes limit of Structure Excavation and Filter Material payline.
2. Roadway Excavation to bottom of new 8" Untreated Coral Base.
3. Filter Material not required for 6" Non-Perforated Underdrain Pipe.
4. See Sht. No. 5 for typical 6" Underdrain Pipes.

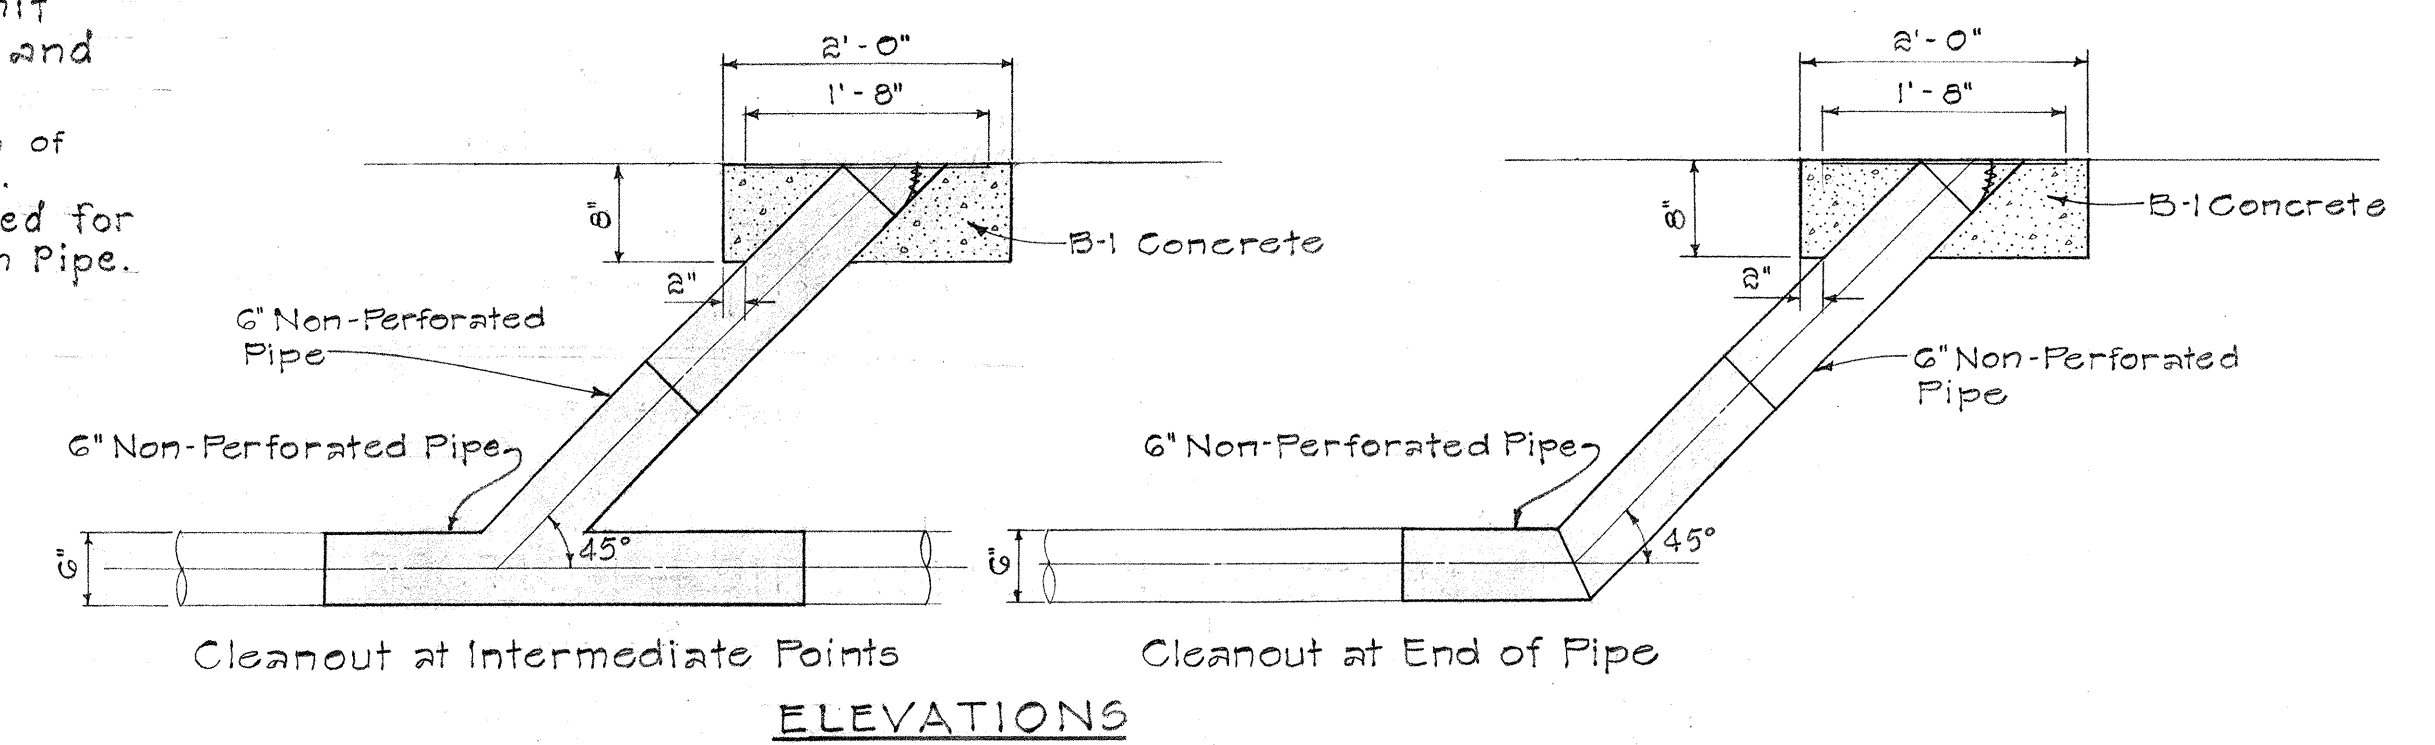


NOTES:

1. Steel plate shall be thoroughly cleaned and painted with one coat of high grade asphaltum.
2. Shaded area denotes limit of payment for cleanouts.

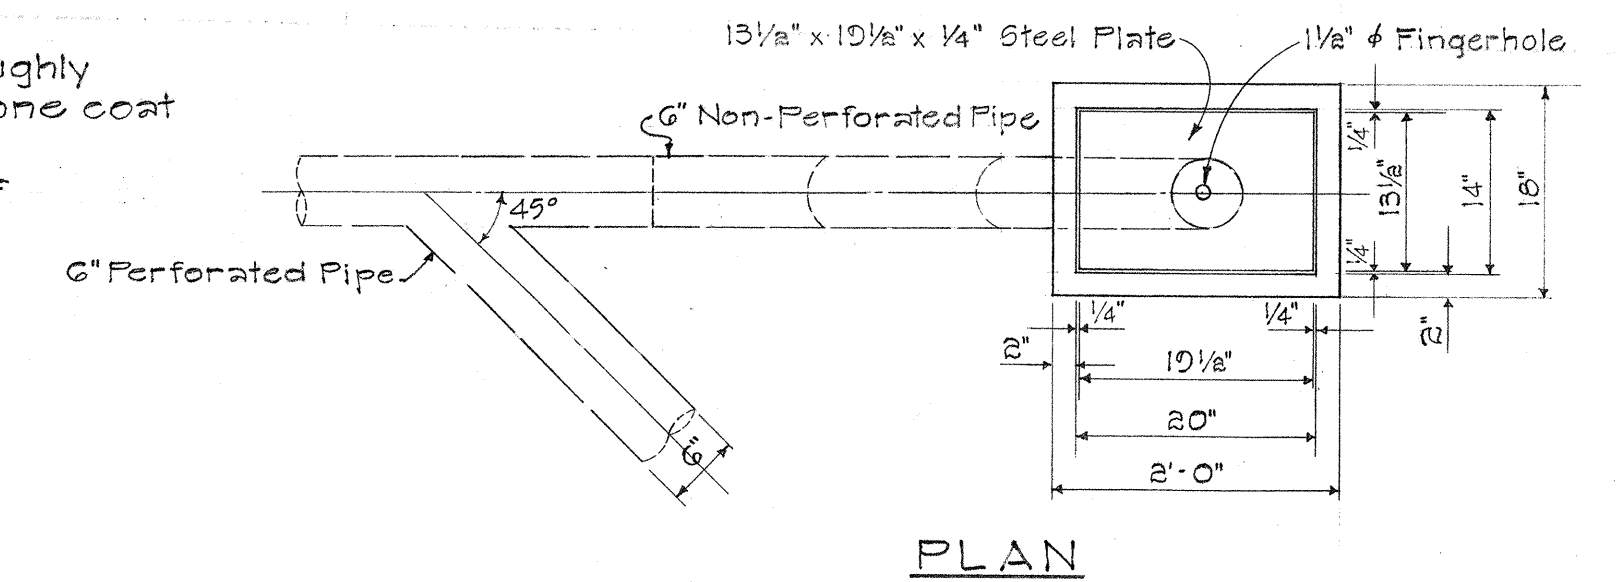

DETAIL OF CLEANOUT AND CONCRETE BLOCKS
Scale: 3/4" = 1'-0"

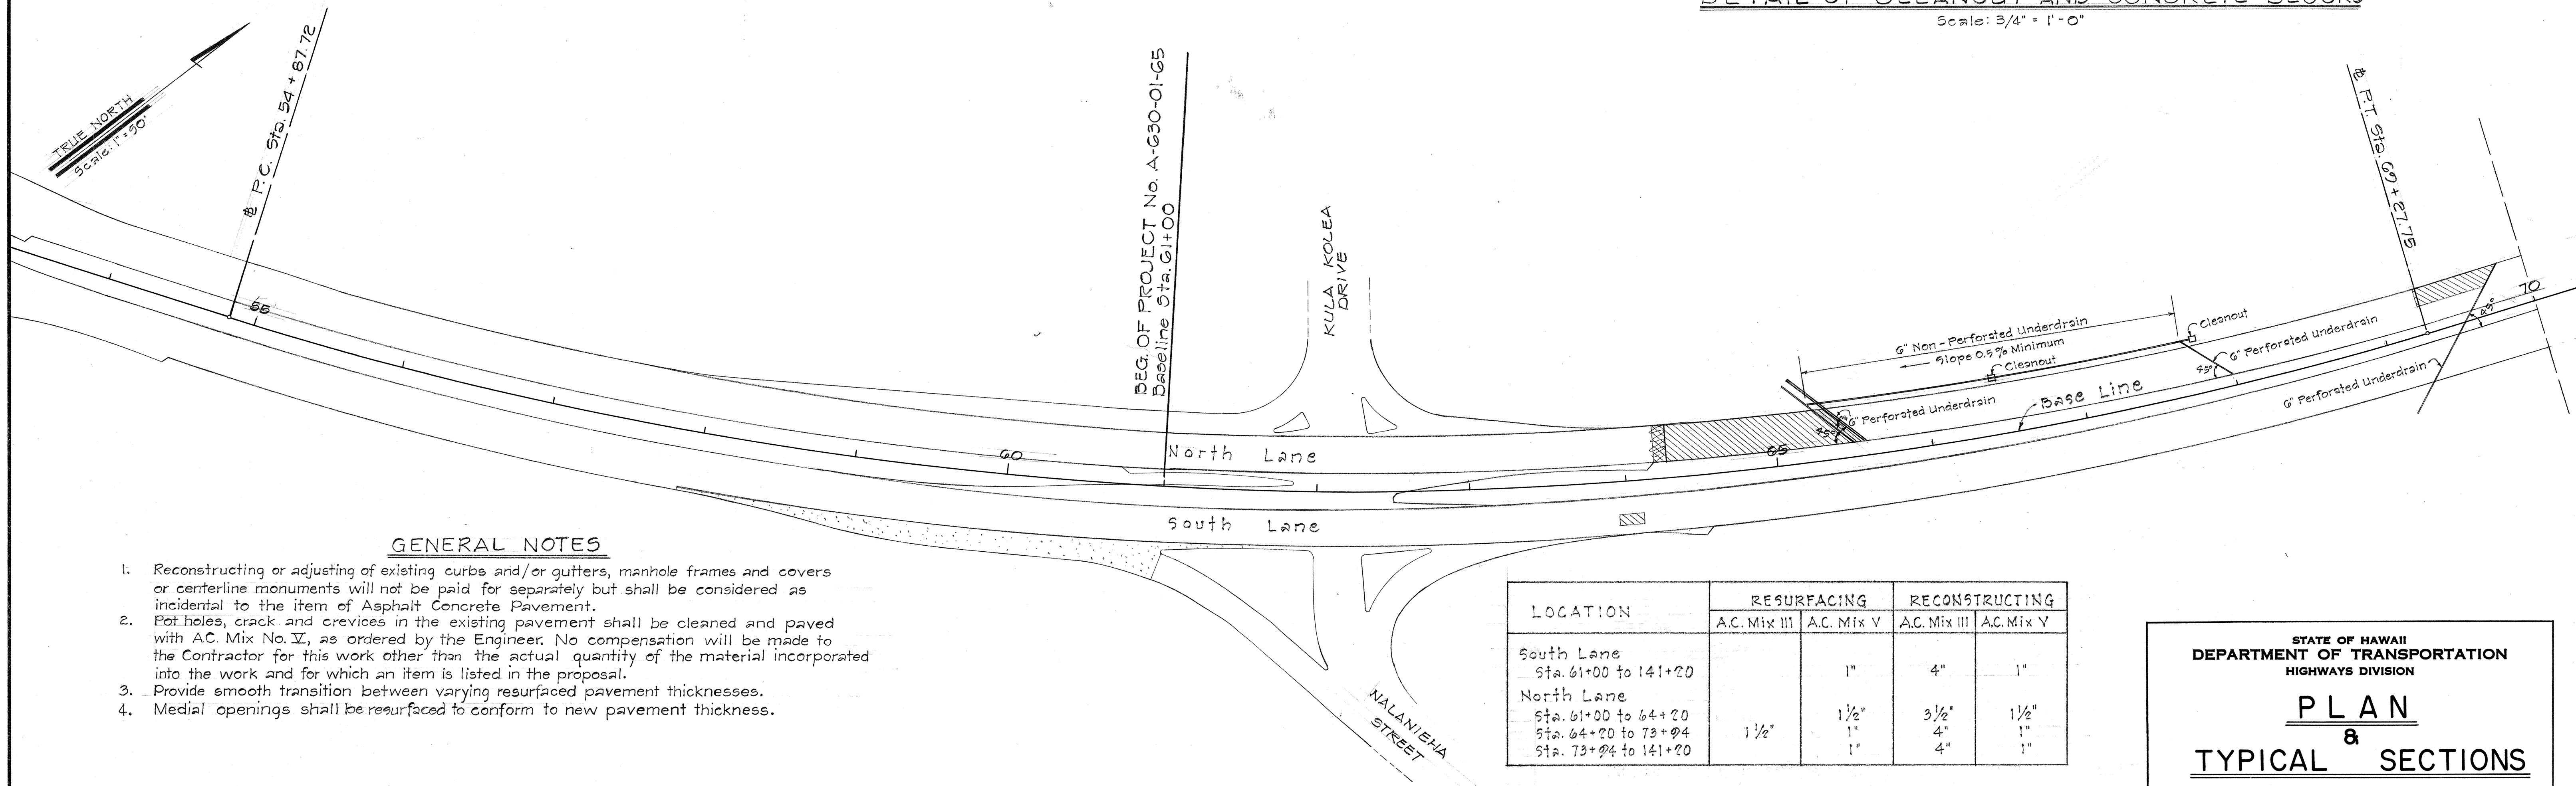

GENERAL NOTES

1. Reconstructing or adjusting of existing curbs and/or gutters, manhole frames and covers or centerline monuments will not be paid for separately but shall be considered as incidental to the item of Asphalt Concrete Pavement.
2. Pot holes, crack and crevices in the existing pavement shall be cleaned and paved with A.C. Mix No. V, as ordered by the Engineer. No compensation will be made to the Contractor for this work other than the actual quantity of the material incorporated into the work and for which an item is listed in the proposal.
3. Provide smooth transition between varying resurfaced pavement thicknesses.
4. Medial openings shall be resurfaced to conform to new pavement thickness.

LOCATION	RESURFACING		RECONSTRUCTING	
	A.C. Mix III	A.C. Mix V	A.C. Mix III	A.C. Mix V
South Lane Sta. 61+00 to 141+20		1"	4"	1"
North Lane Sta. 61+00 to 64+20		1 1/2"	3 1/2"	1 1/2"
Sta. 64+20 to 73+04	1 1/2"	1"	4"	1"
Sta. 73+04 to 141+20		1"	4"	1"

Areas to be reconstructed.

STATE OF HAWAII
DEPARTMENT OF TRANSPORTATION
HIGHWAYS DIVISION


PLAN
TYPICAL SECTIONS

PROJ. NO. A-630-01-65
Feb. 1965


SHEET No. 1 OF 4 SHEETS

SURVEY PLOTTED BY	DATE
DRAWN BY	
DESIGNED BY	
NOTE BOOK	
CHECKED BY	
No.	

ORIGINAL PLAN	SURVEY PLOTTED BY	DATE
NOTE BOOK	DESIGNED BY	"
NO.	QUANTITIES BY	"
	CHECKED BY	"

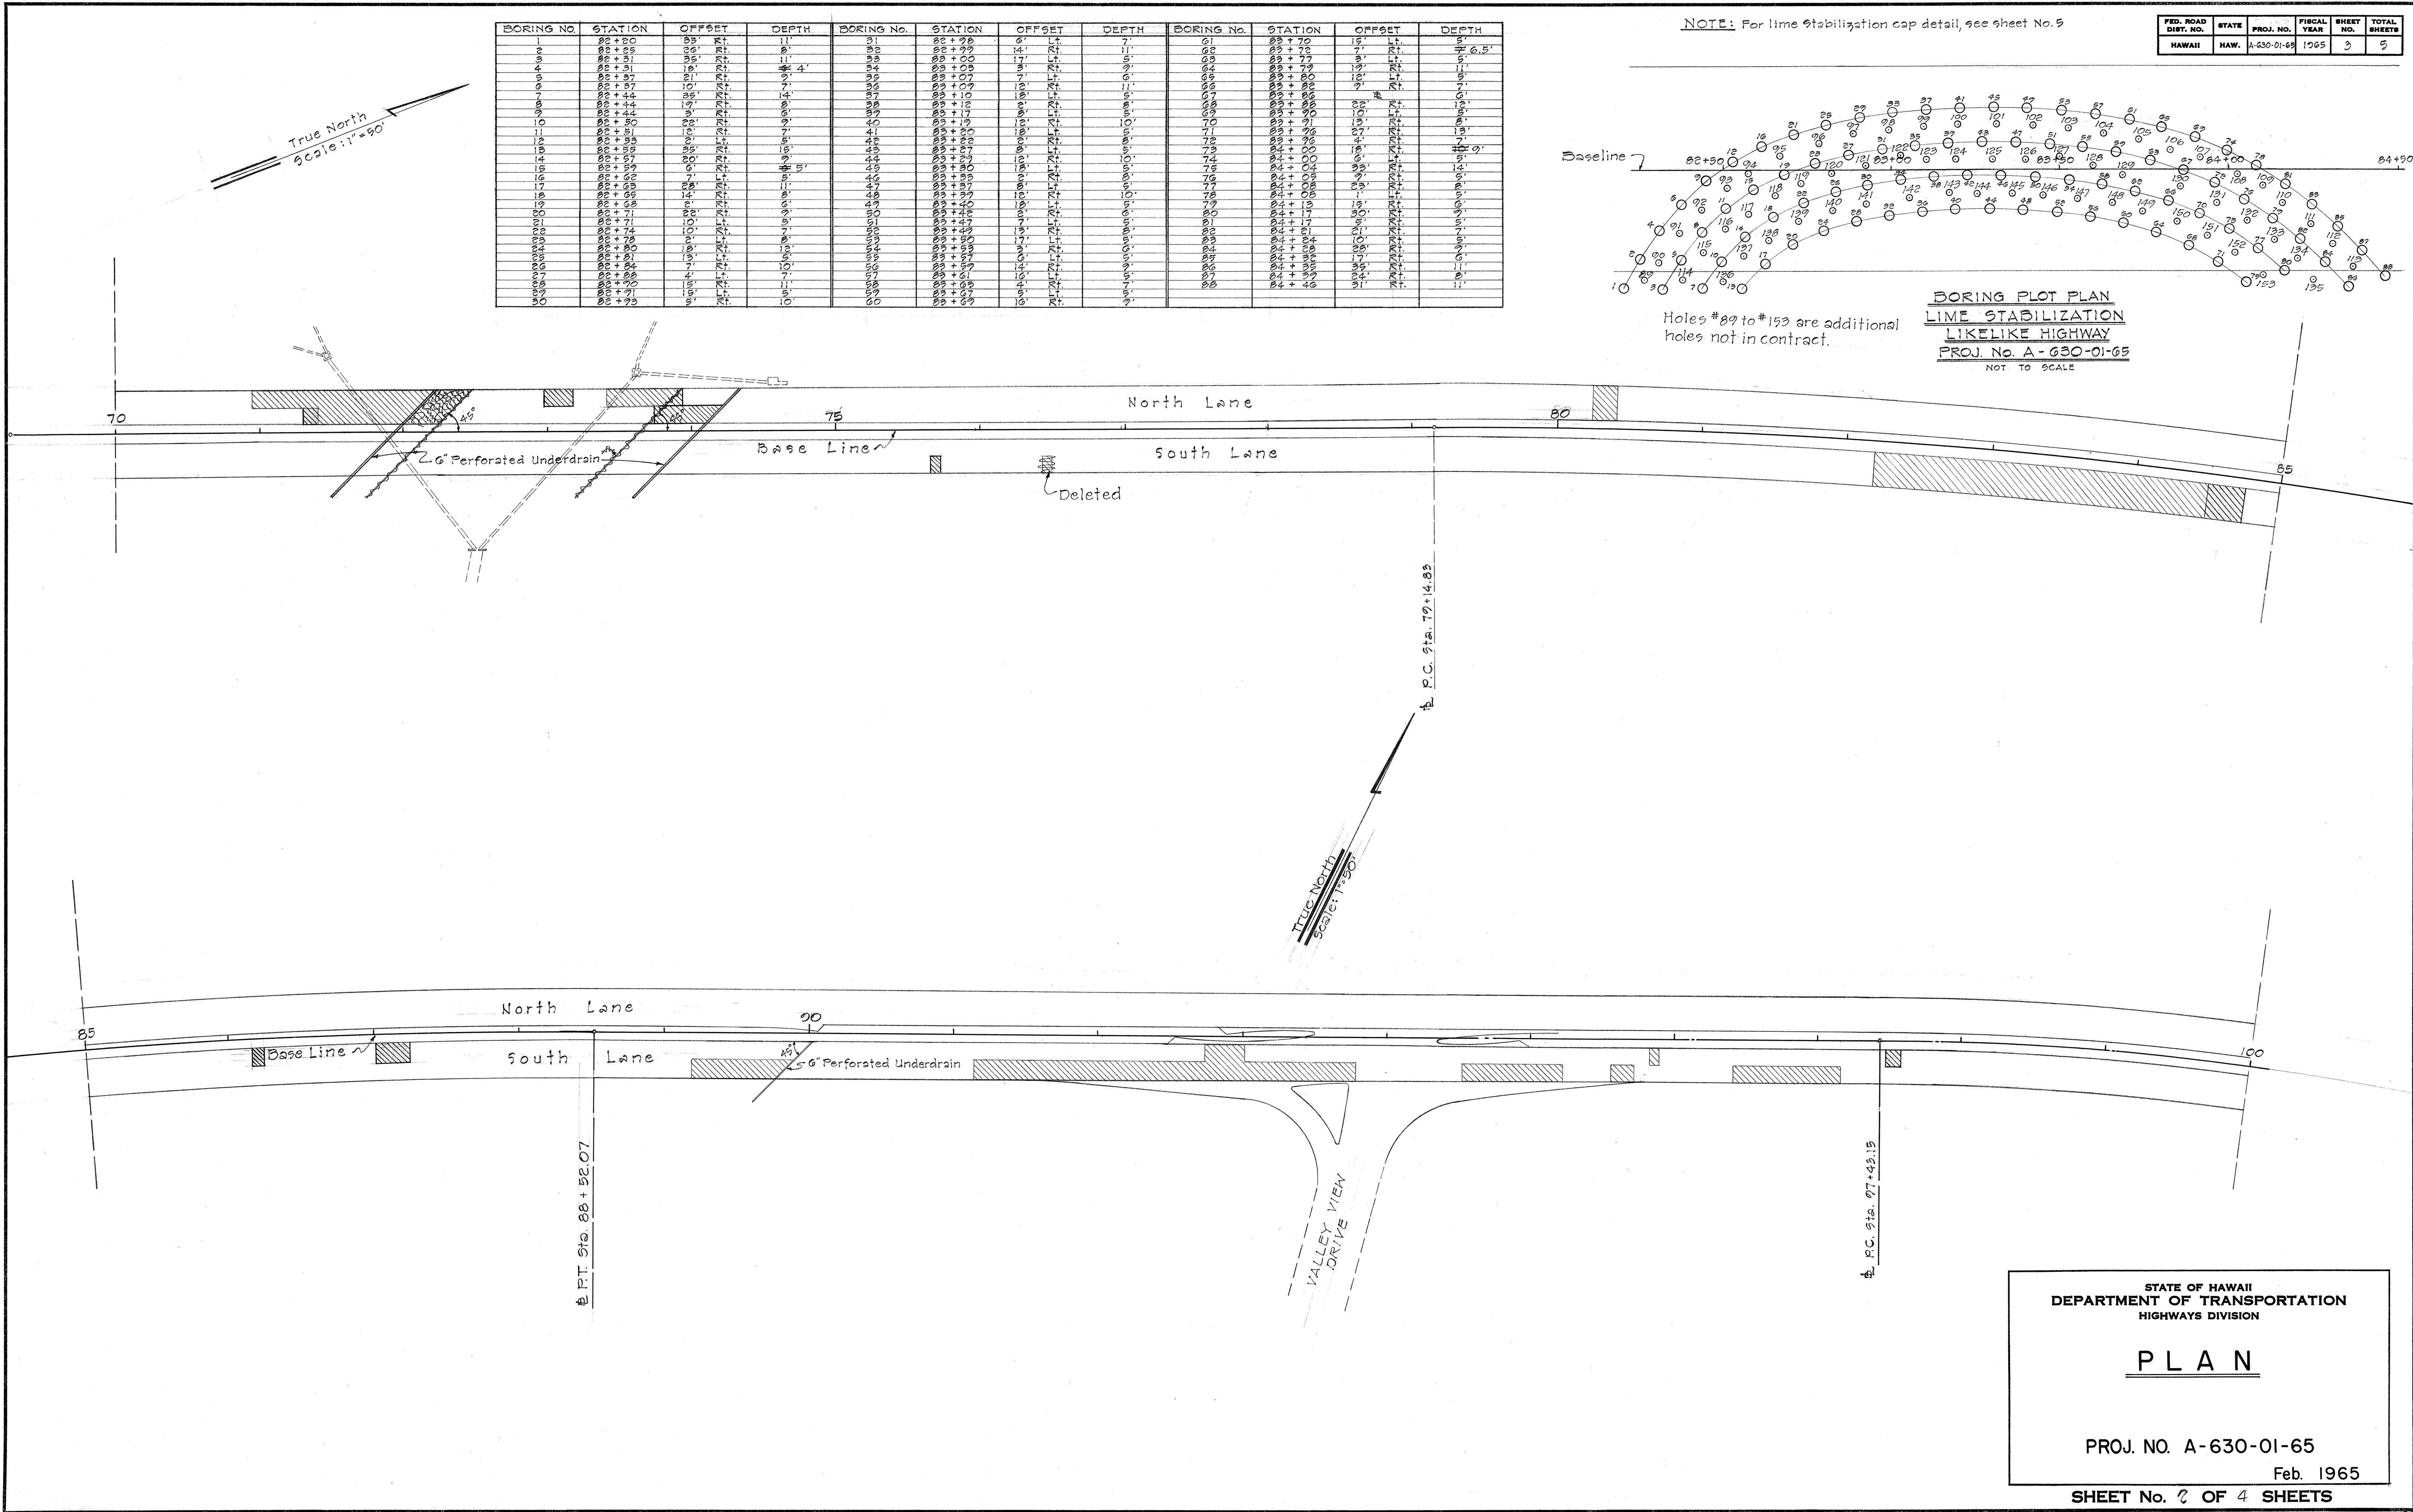

FED. ROAD DIST. NO.	STATE	PROJ. NO.	FISCAL YEAR	SHEET NO.	TOTAL SHEETS
HAWAII	HAW.	A-630-01-65	1965	4	5

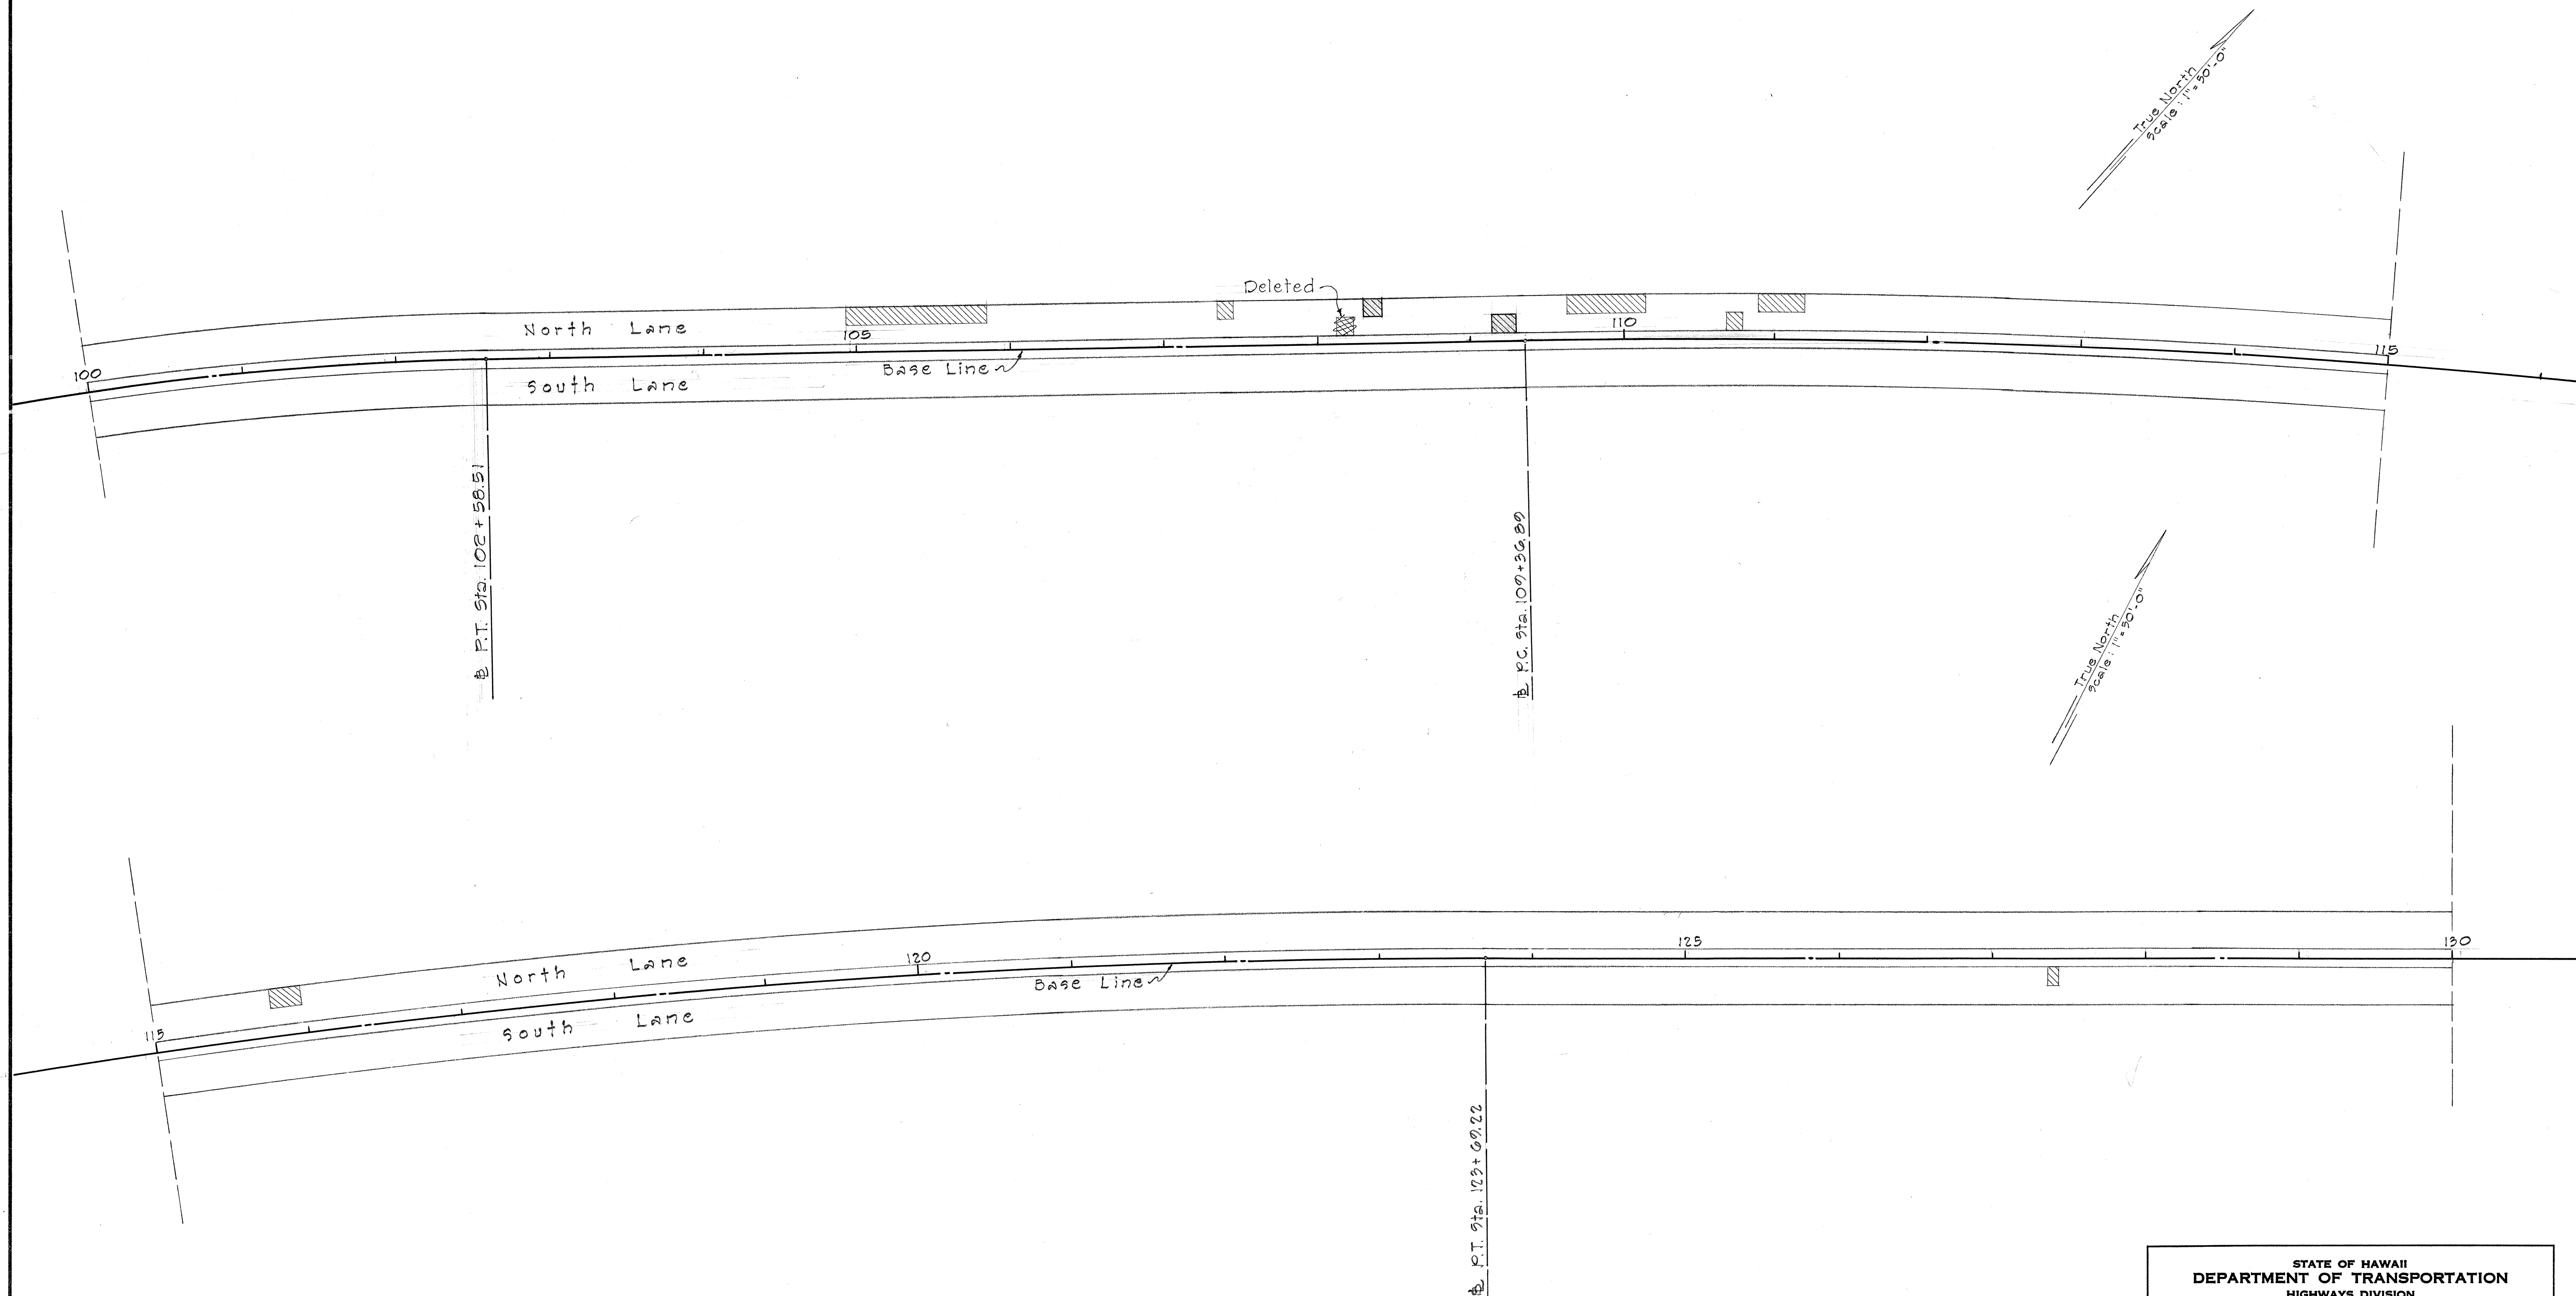

ORIGINAL PLAN	DATE
SURVEY PLOTTED BY	
DRAWN BY	
DESIGNED BY	
QUANTITIES BY	
CHECKED BY	

STATE OF HAWAII
DEPARTMENT OF TRANSPORTATION
HIGHWAYS DIVISION


PLAN

PROJ. NO. A-630-01-65



Feb. 1965

SHEET No. 3 OF 4 SHEETS

FED. ROAD DIST. NO.	STATE	PROJ. NO.	FISCAL YEAR	SHEET NO.	TOTAL SHEETS
HAWAII	HAW.	A-630-01-65	1965	5	5

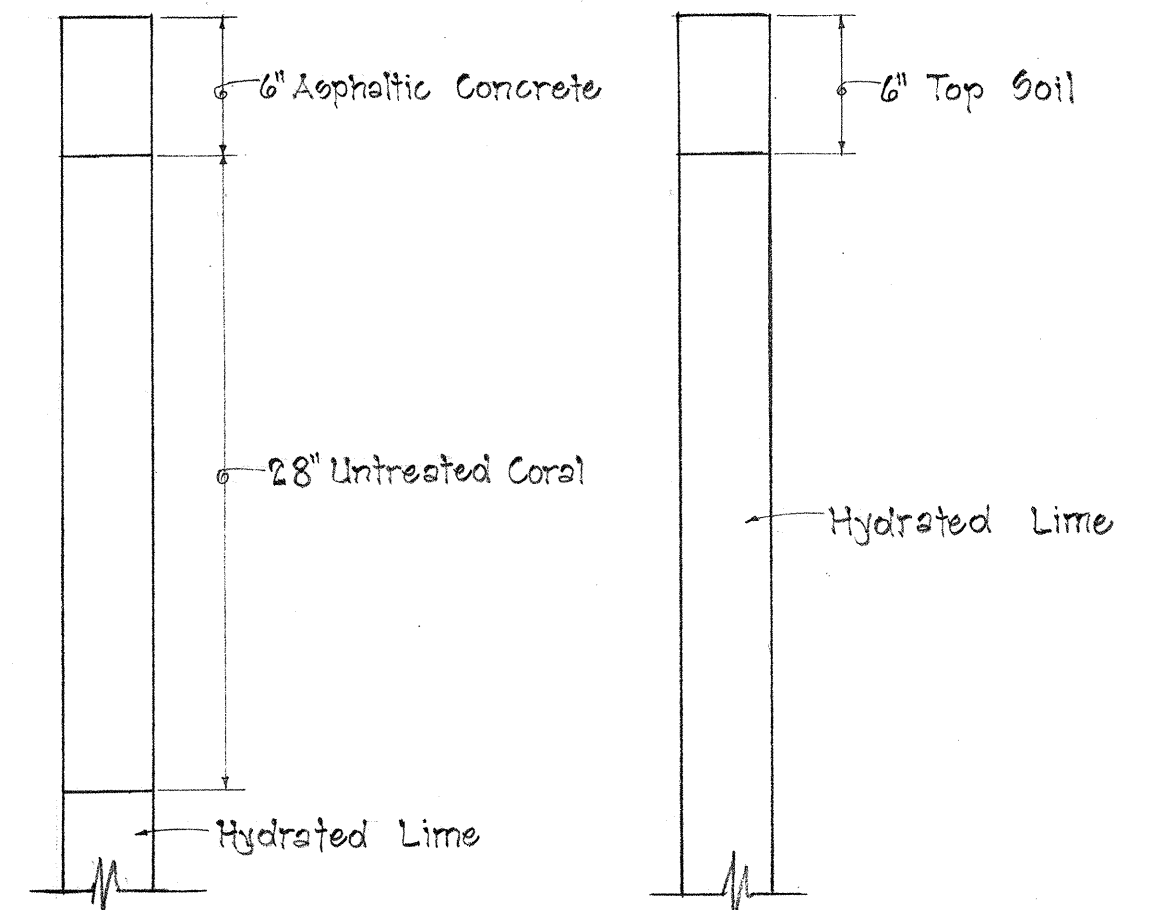

FOR HOLES ON PAV'T. FOR HOLES ON SHOULDER OR MEDIAN
LIME STABILIZATION CAP DETAILS
 Scale: Not to Scale

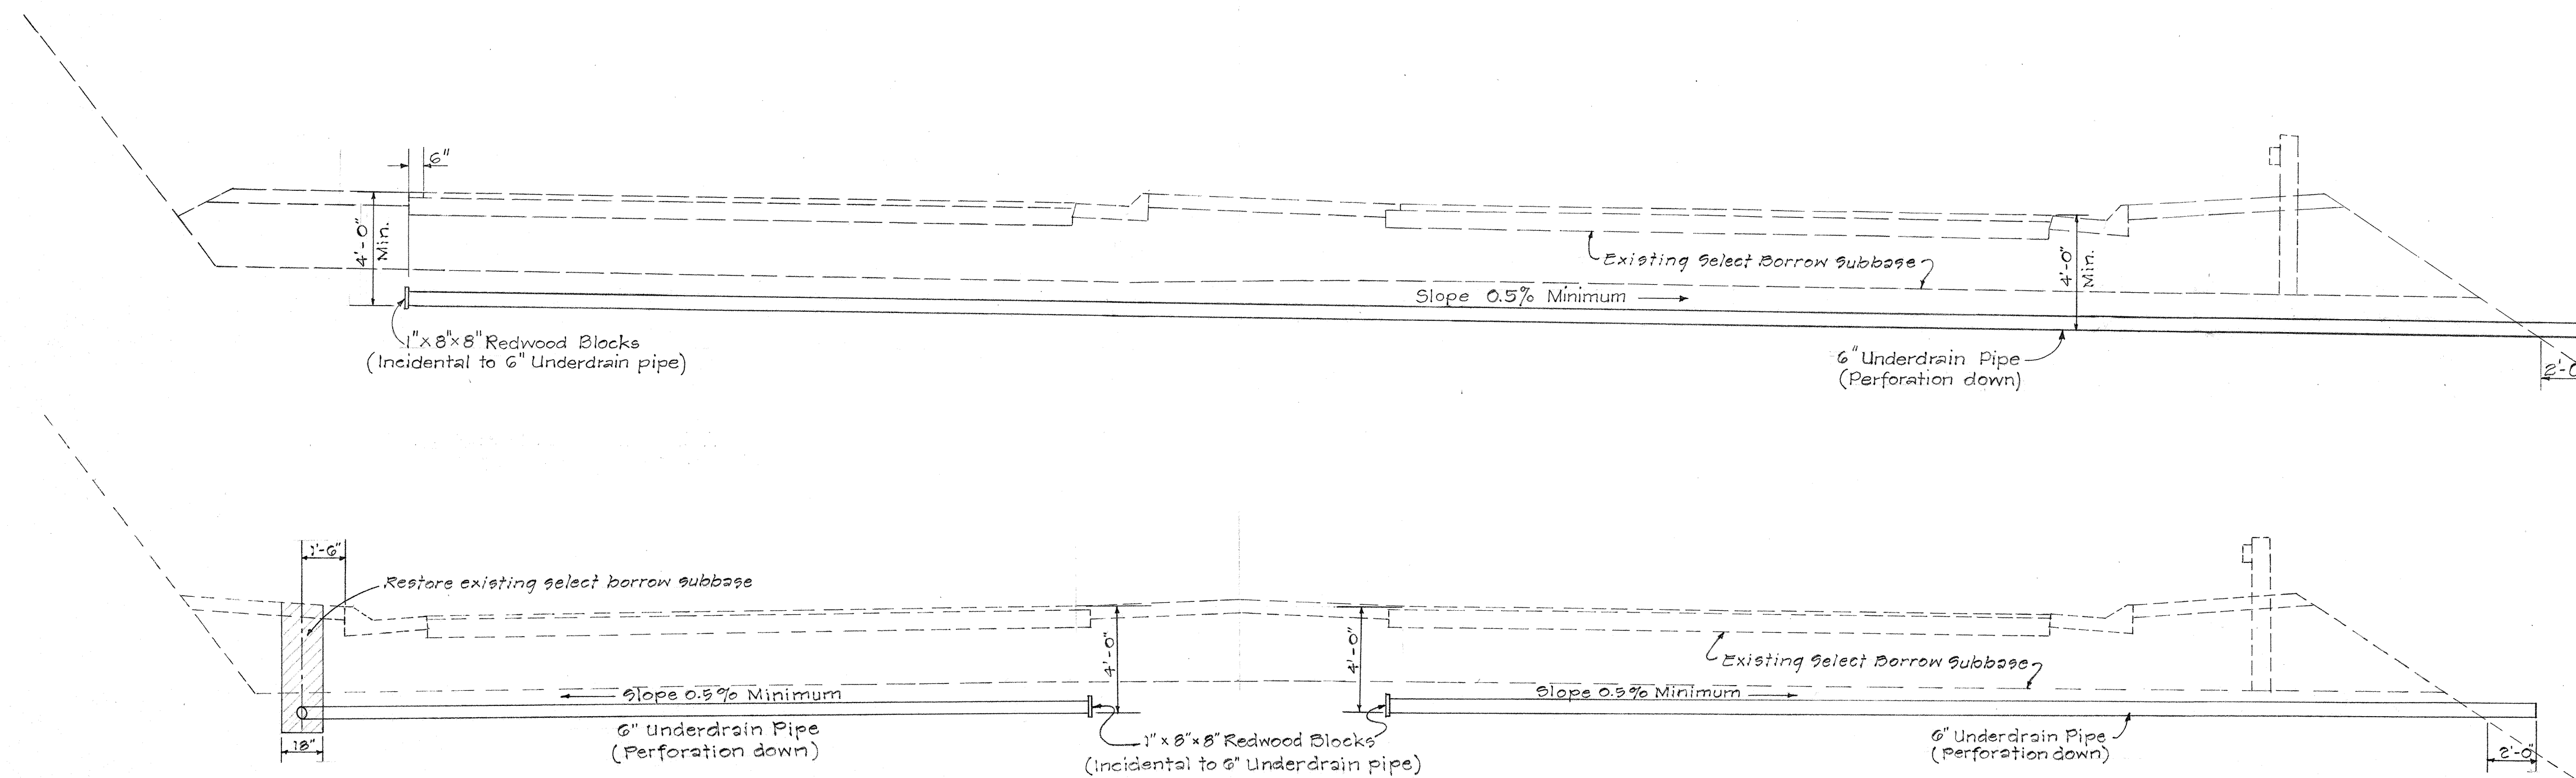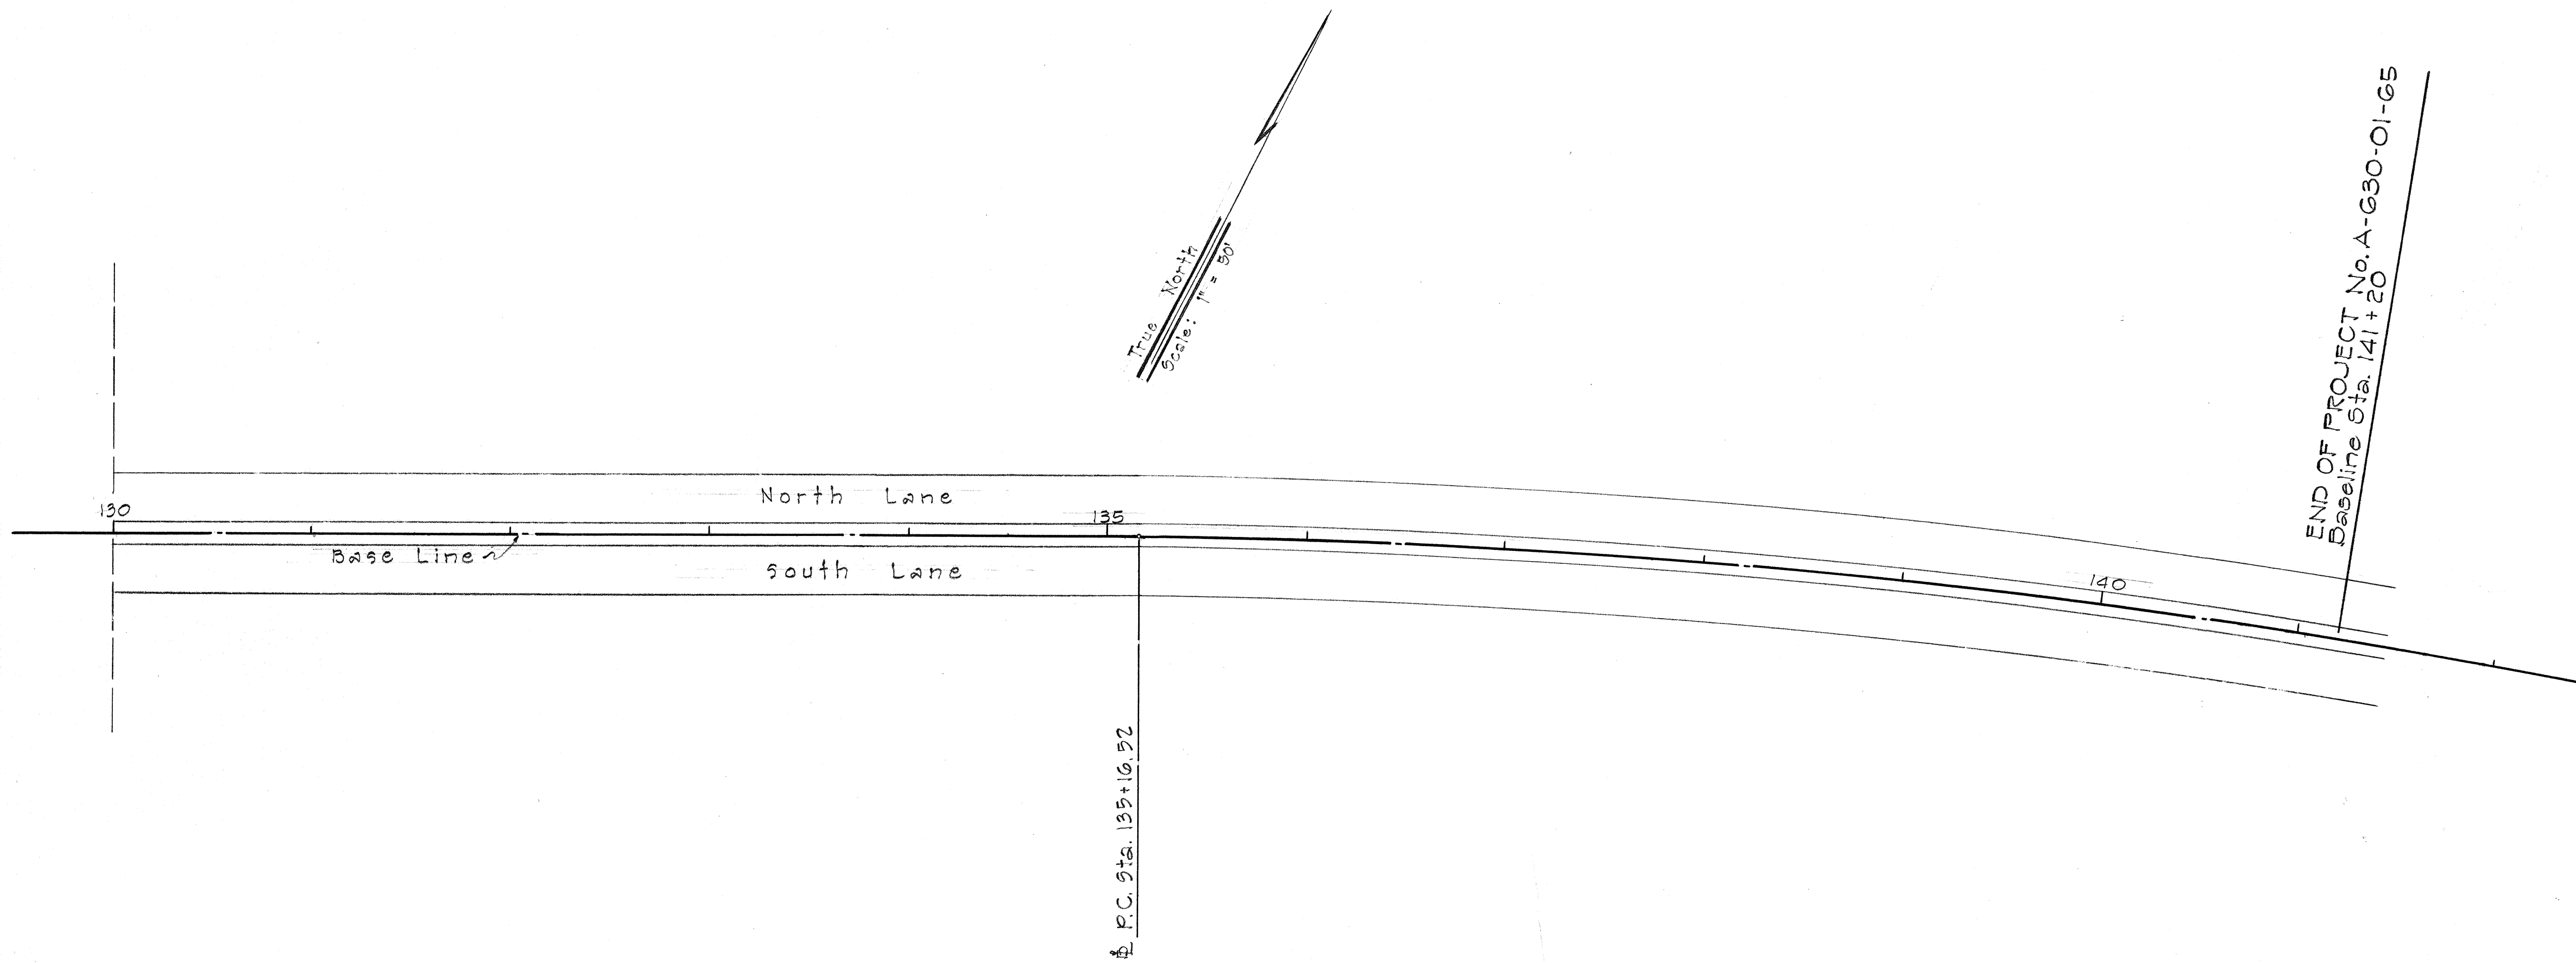

NOTE: Hatched Area denotes limit of Structure Excavation payline.

TYPICAL SECTIONS FOR 6" UNDERDRAIN PIPES
 NOT TO SCALE

STATE OF HAWAII
 DEPARTMENT OF TRANSPORTATION
 HIGHWAYS DIVISION

PLAN

PROJ. NO. A-630-01-65

Feb. 1965

SHEET No. 4 OF 4 SHEETS

SURVEY PLOTTED BY	DATE
DRAWN BY	
DESIGNED BY	
NOTE BOOK	
QUANTITIES BY	
CHECKED BY	