


FED ROAD DIST NO	STATE	FED. AC	FISCAL YEAR	BEGGT NO	TOTAL CMPTS
HAWAII	HAW	A-630-01-65	1965	1	5

"AS BUILT" PLANS FOR

PROJECT NO. A-630-01-65


SCALE : PLAN.....1"=50'

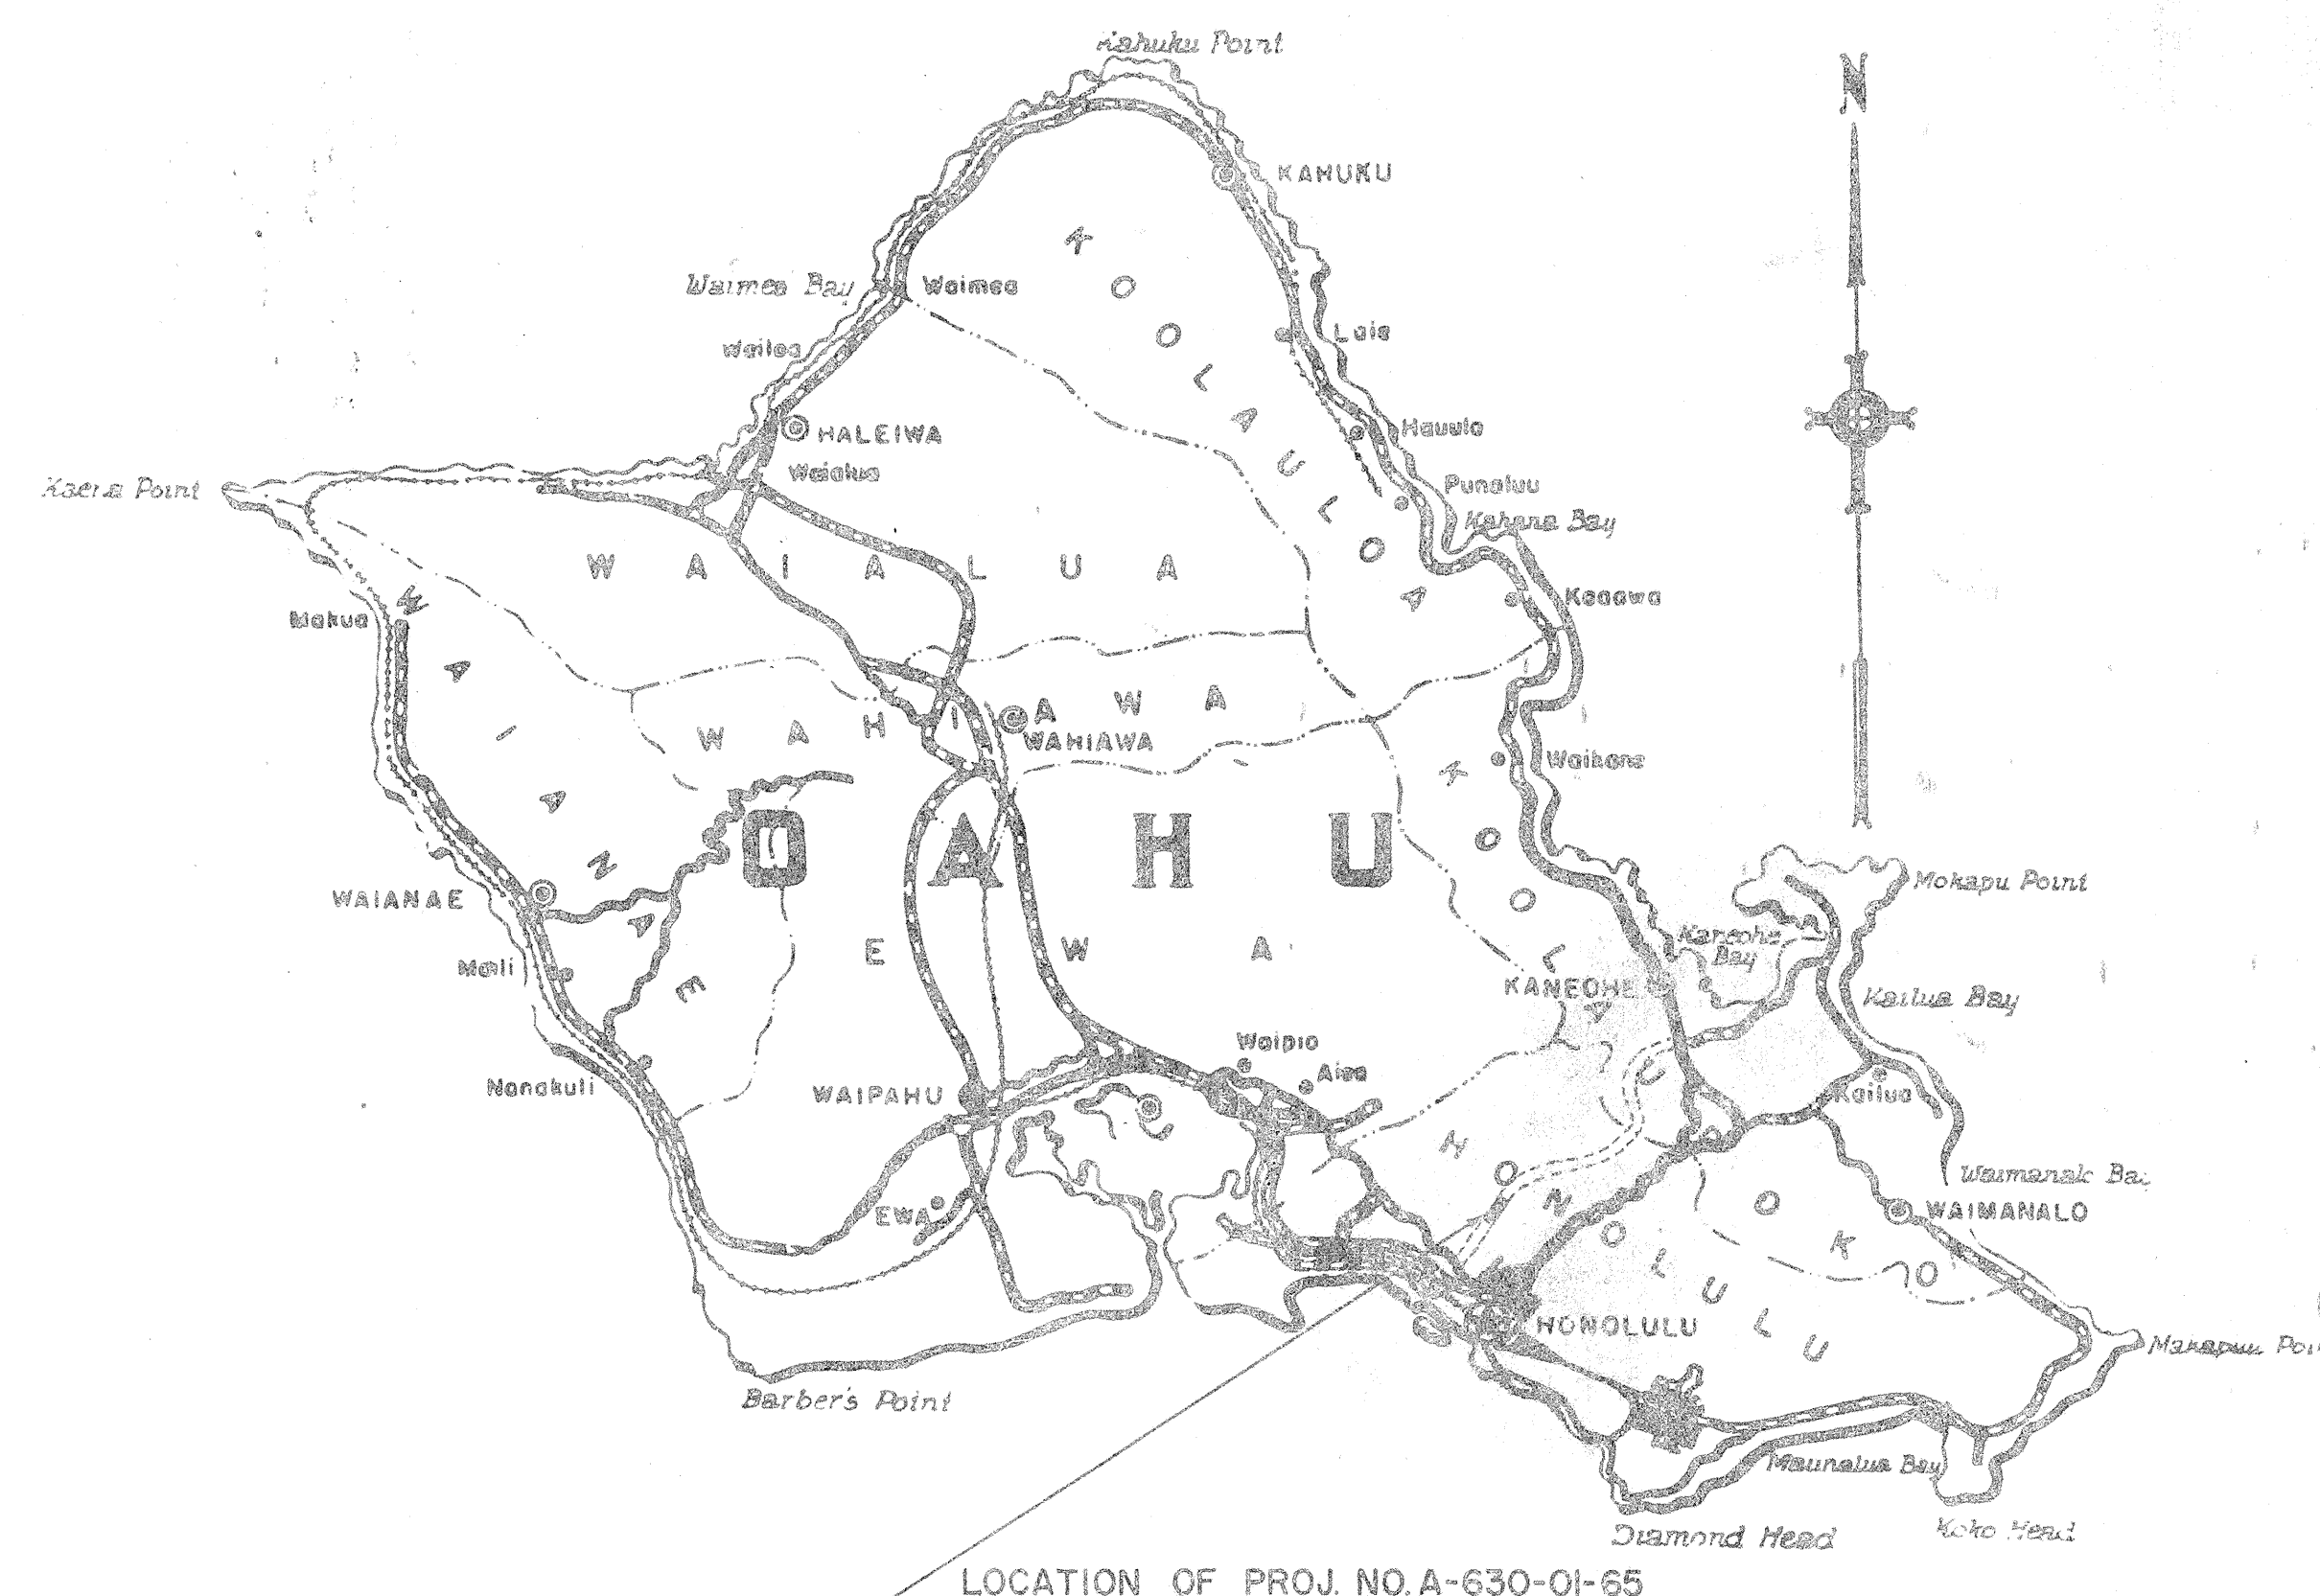

NOTE:

ALL CHANGES MADE DURING CONSTRUCTION HAVE BEEN
NOTED IN RED ON THESE TRACINGS AND CHECKED BY:

Daria Aceto
PROJECT ENGINEER
6/14/67
DATE

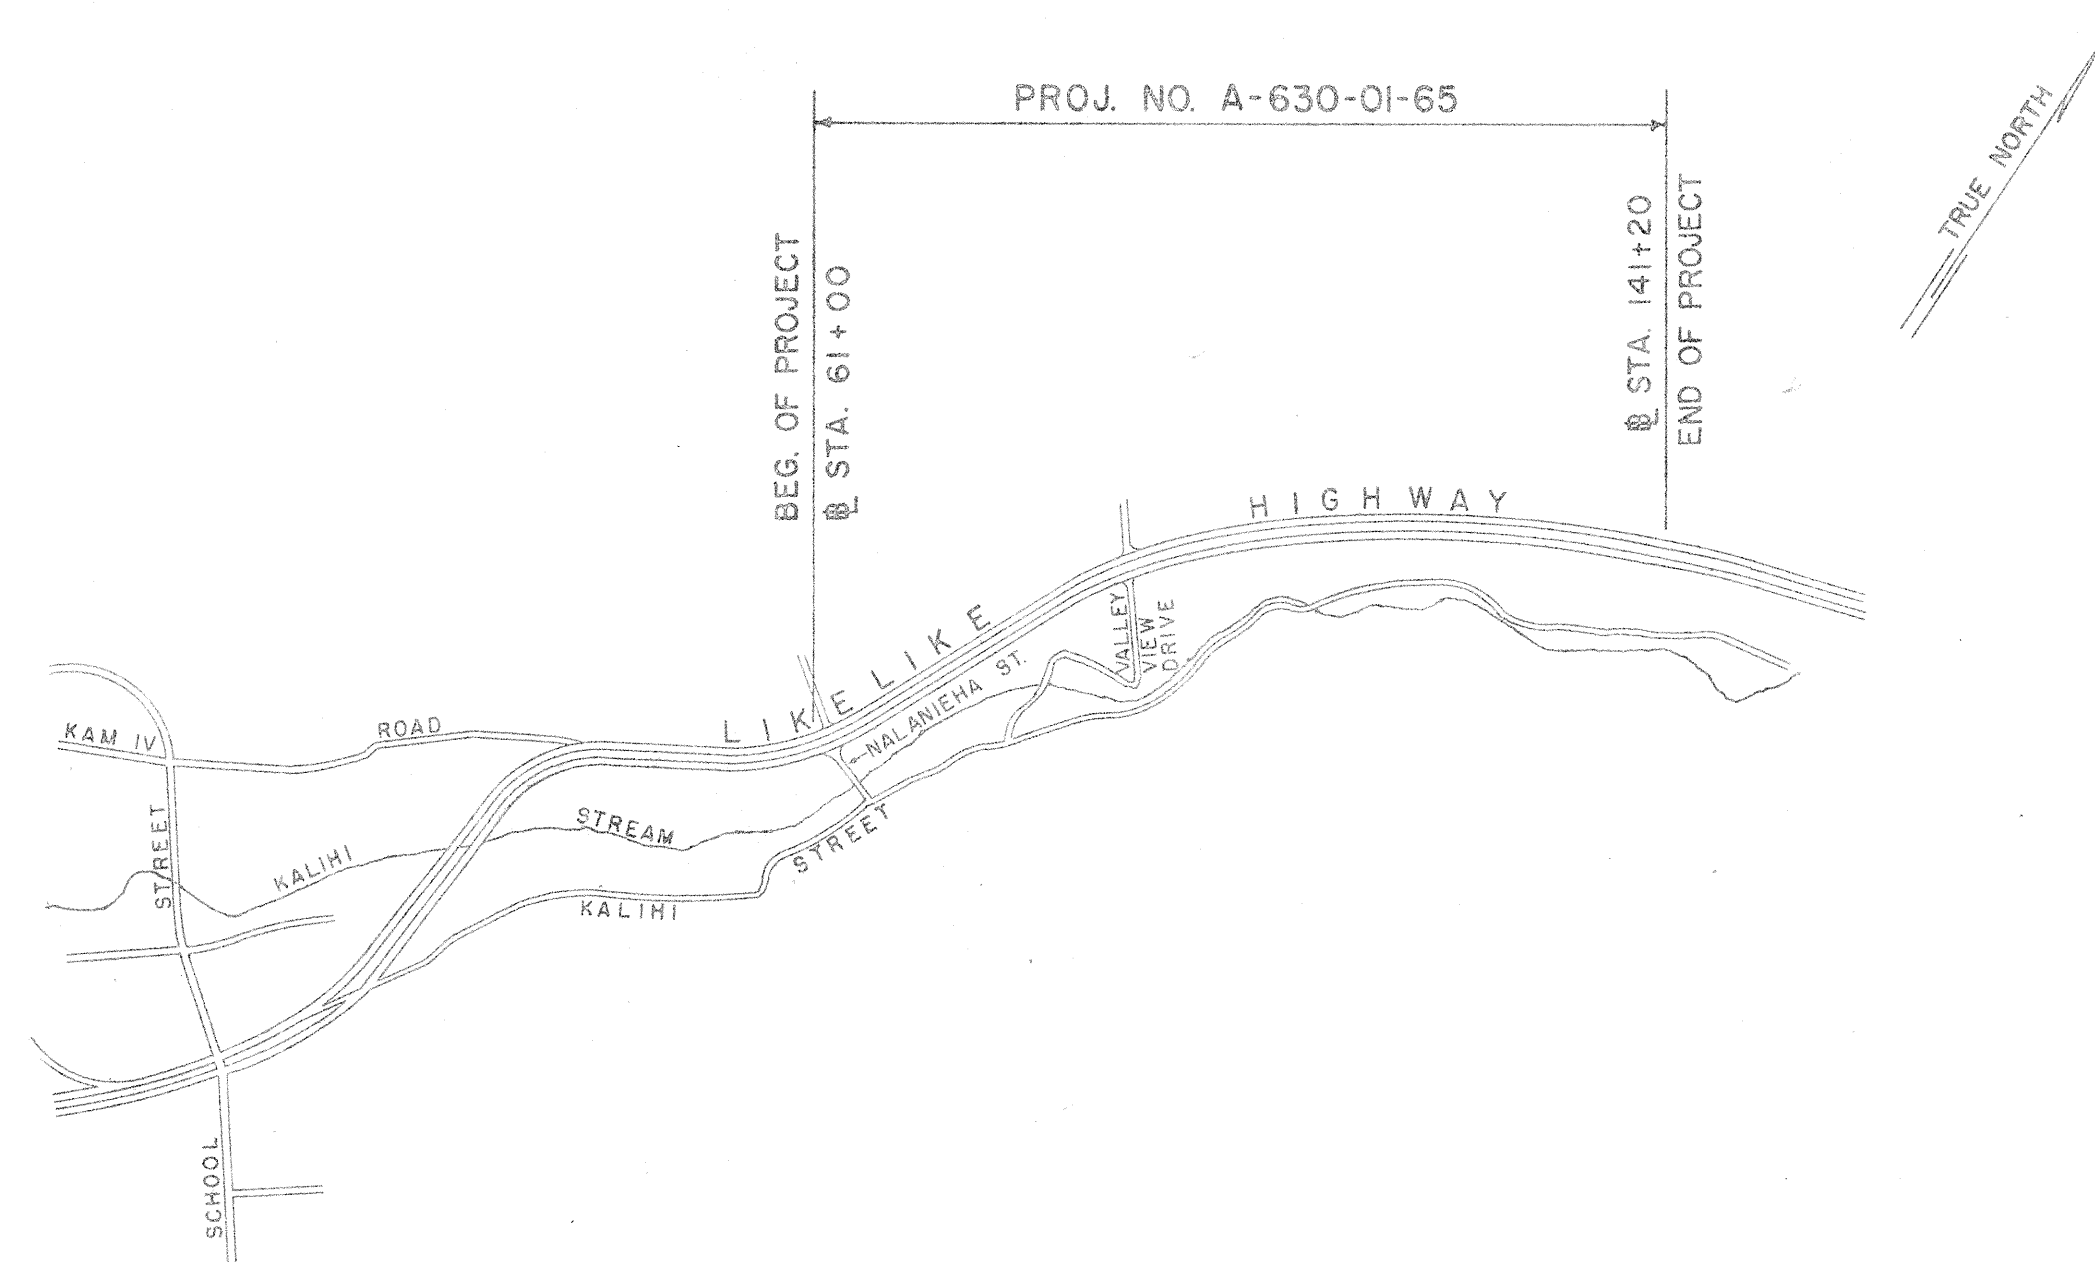

LENGTH OF PROJECT 1.519 mi.

L A Y O U T P L A N

SCALE: 1" = 1667'

APPROVED: *Louis Chatard* DATE *23 Apr 65*
DIRECTOR OF TRANSPORTATION

ORIGINAL PLAN	SURVEY PLOTTED BY DESIGNED BY DRAWN BY THRU BY NOTE BOOK	DATE
No. _____	QUANTITIES CHECKED BY CHECKED BY A. NARAYANI	APRIL 1969