
INDEX TO DRAWINGS	
SHEET NO.	DESCRIPTION
	TITLE SHEET
2-6	PLANS & MISCELLANEOUS DETAILS

HAWAII STATE OF DEPARTMENT OF TRANSPORTATION HIGHWAYS DIVISION HONOLULU, HAWAII "AS BUILT" PLANS FOR

RECONSTRUCTING AND RESURFACING A PORTION OF LIKELIKE HIGHWAY, BECKLEY STREET TOWARD KULA KOLEA PROJECT NO. 63A-01-67

> DISTRICT OF HONOLULU ISLAND OF OAHU


> > SCALE : PLAN..... | " = 50"

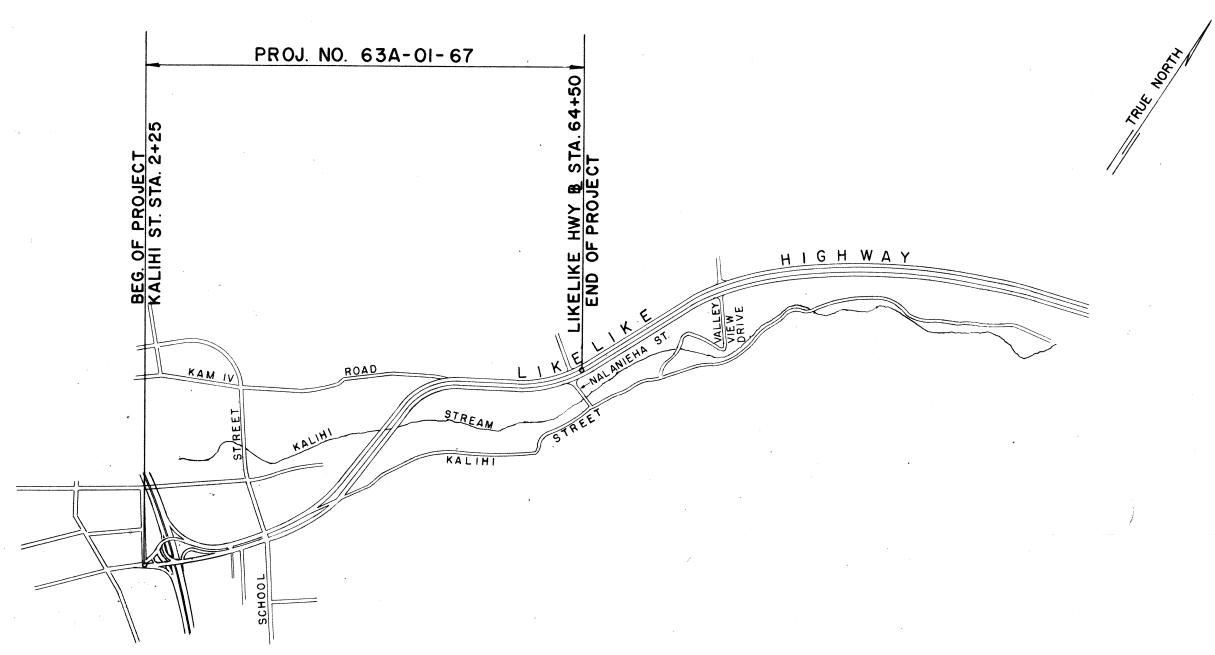

NOTE:

ALL CHANGES MADE DURING CONSTRUCTION HAVE BEEN NOTED ON THESE TRACINGS IN RED AND CHECKED BY:

8-12-68 DATE

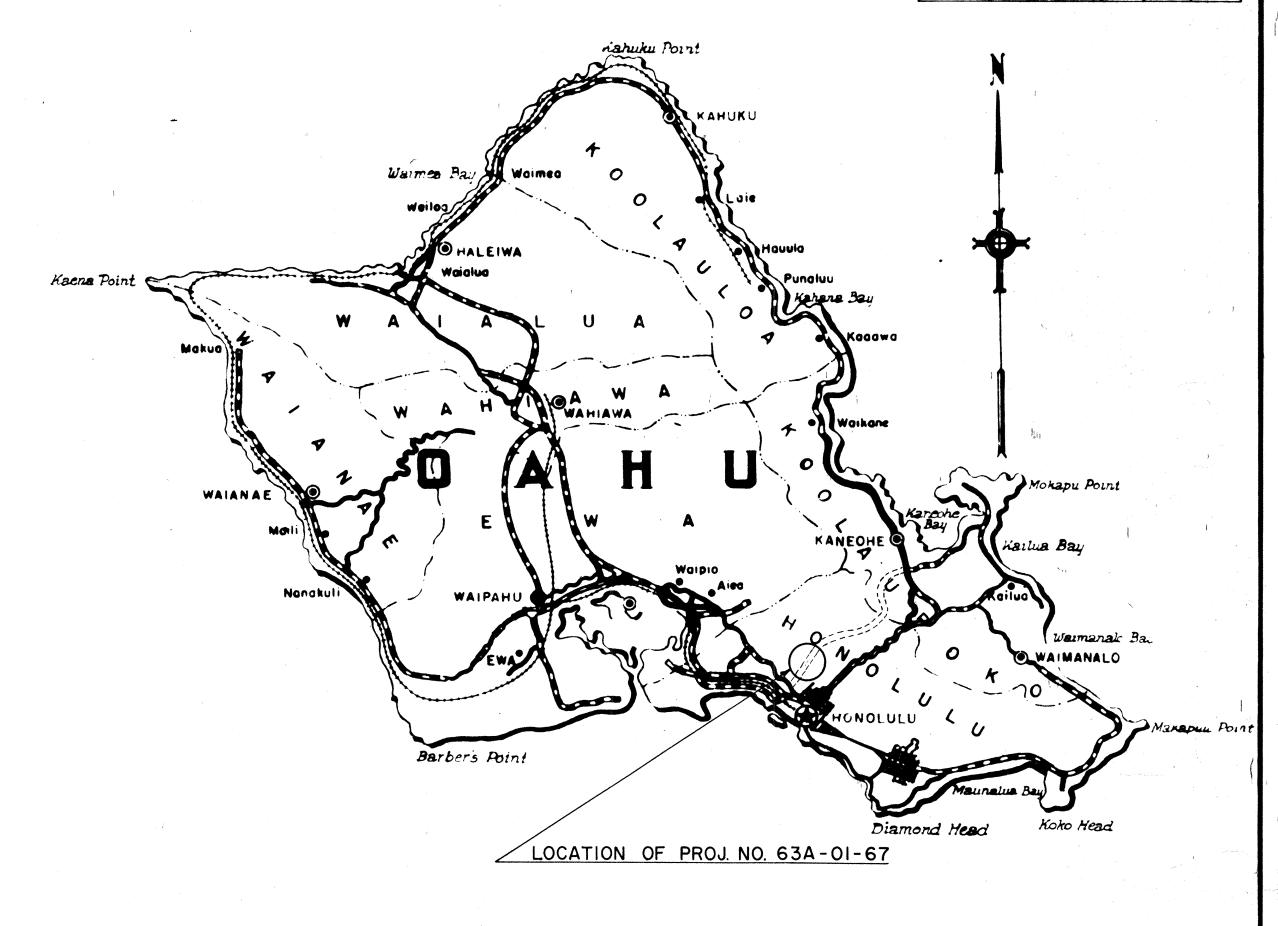

GENERAL NOTES

- I. BEFORE PLACEMENT OF THE FINISHED COURSE OVER THE EXISTING PAVEMENT, THE CONTRACTOR SHALL PLACE A THIN LAYER OF LEVELING COURSE, MIX NO. ▼ TO SMOOTH OUT ANY IRREGULARITIES IN THE EXISTING PAVEMENT. NO COMPENSATION WILL BE MADE TO THE CONTRACTOR FOR THIS WORK OTHER THAN THE ACTUAL QUANTITY OF THE MATERIAL INCORPORATED INTO THE WORK AND FOR WHICH AN ITEM IS LISTED IN THE PROPOSAL.
- 2. MEDIAL OPENINGS SHALL BE RESURFACED TO CONFORM TO NEW PAVEMENT THICKNESS.
- 3. PROVIDE SMOOTH TRANSITION BETWEEN VARYING RESURFACED PAVEMENT THICKNESSES AND CONNECTIONS TO EXISTING PAVEMENT.
- 4. THE PAVEMENT DESIGN FOR THE RECONSTRUCTED AREA SHALL BE 8" ASPHALTIC CONCRETE (I"MIX 文, 7" MIX III).
- 5. AFTER PAVING, THE CONTRACTOR SHALL LOCATE ALL EXISTING MANHOLES IN THE MANNER SATISFACTORY TO THE ENGINEER. THE WORK SHALL BE CONSIDERED AS INCIDENTAL TO THE ITEM OF ASPHALT CONCRETE PAVEMENT.
- 6. NOTES PERTAINING TO ANYTHING OTHER THAN RESURFACING, RECONSTRUCTING, AND UNDERDRAINS SHALL BE DISREGARDED.

TOR OF TRANSPORTATION

LEGEND

ASPHALT CONCRETE PAVEMENT

1 1/2" ASPHALT CONCRETE PAVEMENT

2 1/2" ASPHALT CONCRETE PAVEMENT

LENGTH OF PROJECT 1.63 mi.

LAYOUT PLAN

SCALE: 1" = 1667'