The state of the s	1DE	X	TC	D	RA	WIN	GS		· Nyfe	
SHEET NO.		DESCRIPTION								
1	TITLE SHEET									
2-3										
The second of th	e k erji	**************************************	way was a way		er.			and the second second second		
								parate as a resident to		
*										

			-							
	`								eh-	
						was the second s				
					cii ca		*			
			naga ay danah adina sakir sa							
					water the same of					
·										

					***************************************				-	

STATE OF HAWAII

DEPARTMENT OF TRANSPORTATION
HIGHWAYS DIVISION


HONOLULU, HAWAII
"AS BUILT"


RECONSTRUCT AND RESURFACE LIKELIKE HIGHWAY

WILSON TUNNEL TO LULUKU ROAD PROJECT NO. 630A-03-68

DISTRICT OF KOOLAUPOKO ISLAND OF OAHU

SCALE: PLAN.... " = 50'

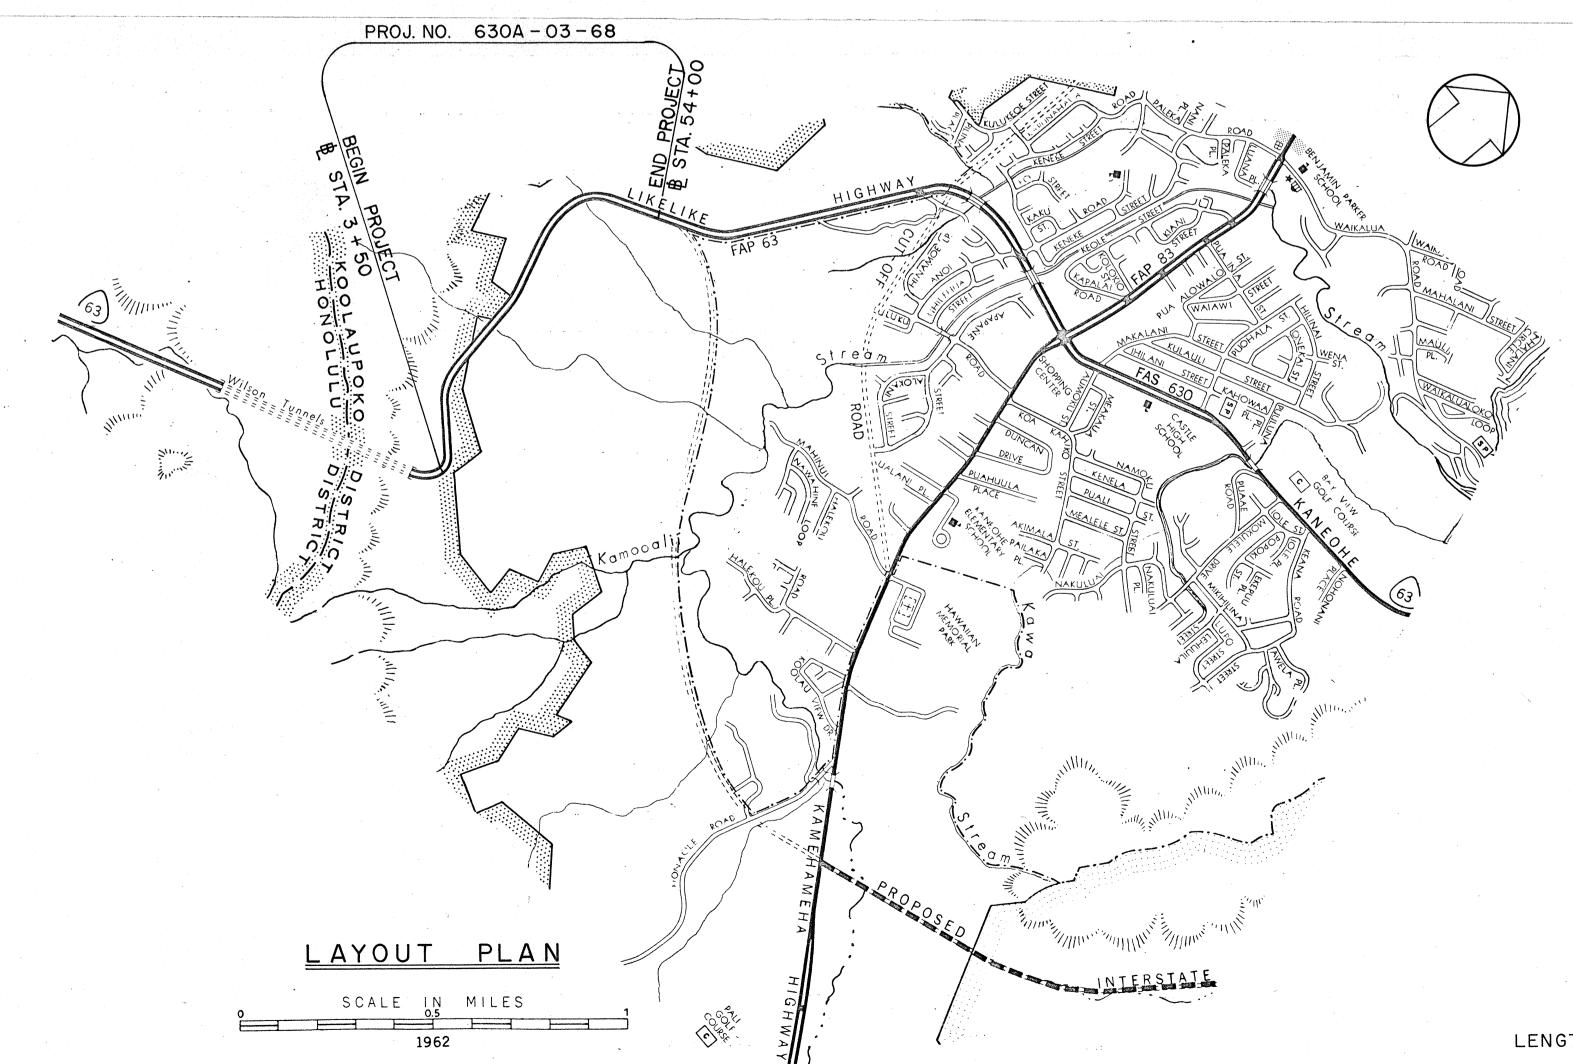

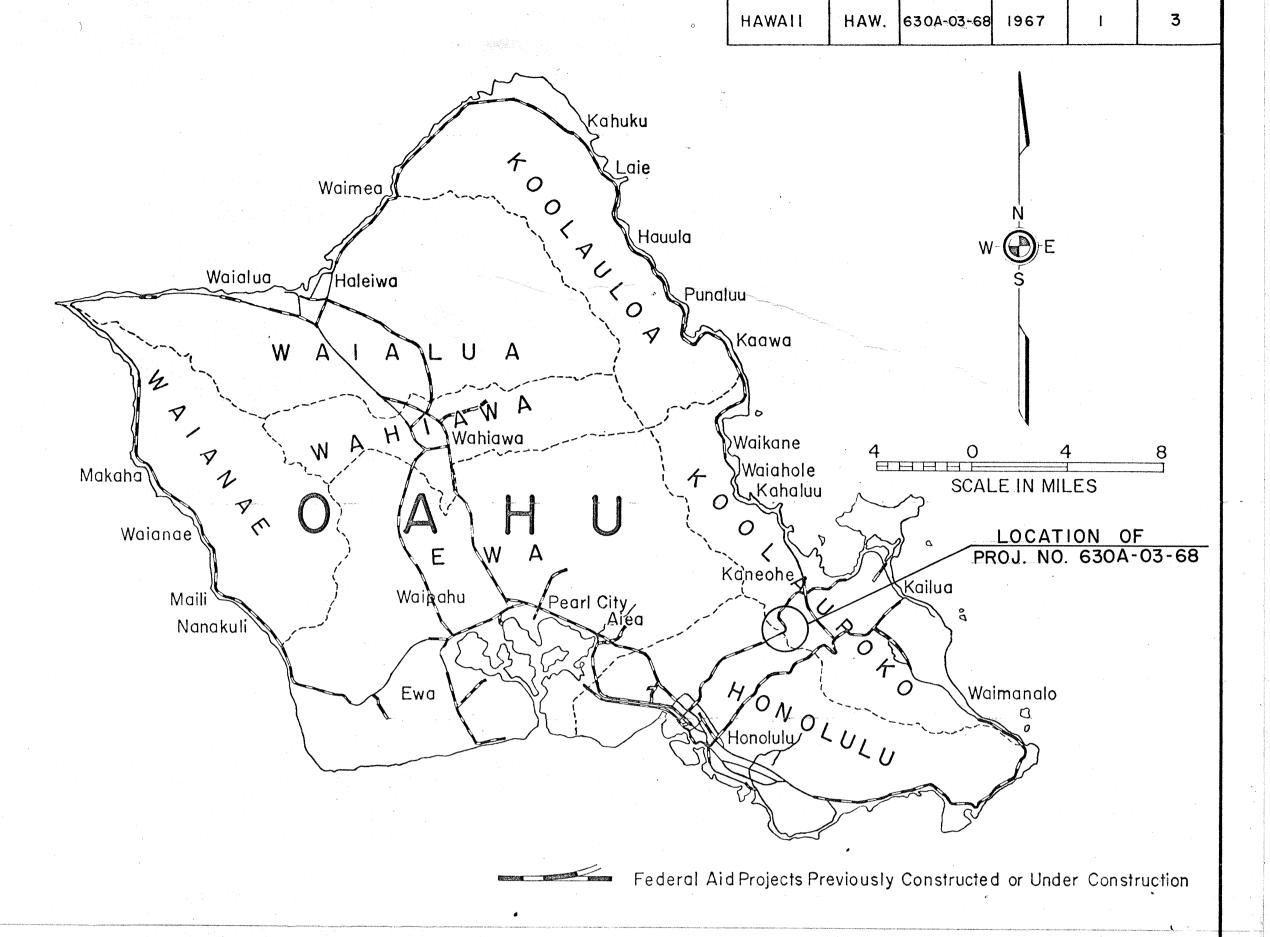

GENERAL NOTES

- I. BEFORE PLACEMENT OF THE FINISHED COURSE OVER THE EXISTING PAVEMENT, THE CONTRACTOR SHALL PLACE A THIN LAYER OF LEVELING COURSE, MIX NO. IN TO SMOOTH OUT ANY IRREGULARITIES IN THE EXISTING PAVEMENT. NO COMPENSATION WILL BE MADE TO THE CONTRACTOR FOR THIS WORK OTHER THAN THE ACTUAL QUANTITY OF THE MATERIAL INCORPORATED INTO THE WORK AND FOR WHICH AN ITEM IS LISTED IN THE PROPOSAL.
- 2. PROVIDE SMOOTH TRANSITION BETWEEN VARYING RESURFACED PAVEMENT THICKNESSES AND CONNECTIONS TO EXISTING PAVEMENT.
- 4. WHEN EXCAVATING FOR UNDERDRAINS, THE CONTRACTOR SHALL BE CAREFUL NOT TO DISTURB THE EXISTING TELEPHONE AND SIGNAL CORPS SYSTEMS,
- 5. THE EXISTING PAVEMENT MARKERS SHALL BE REMOVED BY THE CONTRACTOR AND DISPOSED OF (INCIDENTAL TO THE VARIOUS CONTRACT ITEMS).
- 6. NEW PAVEMENT MARKERS ARE TO BE INSTALLED BY OTHERS.

NOTE:

ALL CHANGES MADE DURING CONSTRUCTION HAVE BEEN NOTED ON THESE TRACINGS IN RED AND CHECKED BY:

PROJECT ENGINEER

Oug. 13, 1968

DATE

DEPARTMENT OF TRANSPORTATION STATE OF HAWAII

FED. AID FISCAL PROJ. NO. YEAR

FED: ROAD DIST. NO.

APPROVED

DIR. OF TRANSPORTATION DATE

LENGTH OF PROJECT..... 0.956 MILE