INDEX TO DRAWINGS	
SHEET NO.	DESCRIPTION
ı	TITLE SHEET
2	TYPICAL SECTION & PLAN
3	HIGHWAY LIGHTING PLAN
-	
:	
	•
,	
	5
1	

STATE OF HAWAII


DEPARTMENT OF TRANSPORTATION
HIGHWAYS DIVISION

HONOLULU, HAWAII

"AS BUILT PLANS FOR LIKELIKE HIGHWAY VALLEY VIEW DRIVE INTERSECTION IMPROVEMENT

PROJECT NO. 63A-03-68

ISLAND OF OAHU

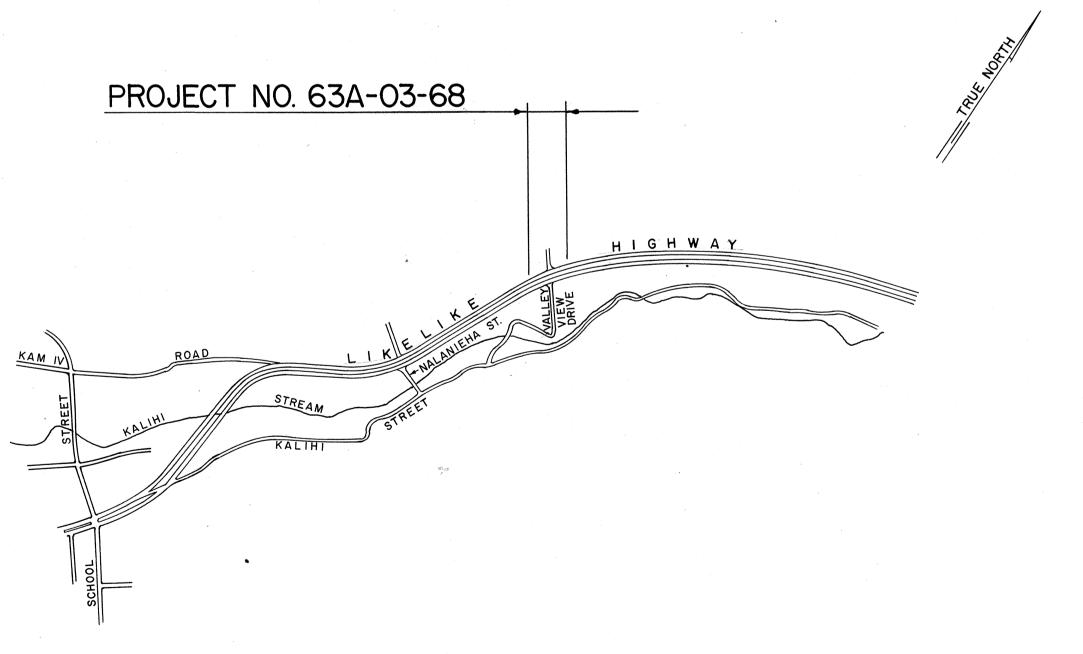

Waillande Wainande Wa

NOTE:

ALL CHANGES MADE DURING CONSTRUCTION HAVE BEEN NOTED IN RED ON THESE TRACINGS AND CHECKED BY:

PROJECT ENGINEER

DATE

LENGTH OF PROJECT O.114 MI.

LAYOUT PLAN

SCALE: 1"= 1667'

DEPARTMENT OF TRANSPORTATION
STATE OF HAWAII

APPROVED:
DIR. OF TRANSPORTATION DATE

STATE PROJ. NO. FISCAL

HAW. 63A-03-68 1968

D-4-1