INDEX TO DRAWINGS	
SHEET NO.	DESCRIPTION
1	TITLE SHEET
2-5	TRAFFIC SIGNAL SYSTEM
	PLANS AND DETAILS
6-8	MISCELLANEOUS
	DETAILS
7	

Mike Miura DESIGN ENG'R STATE OF HAWAII

DEPARTMENT OF TRANSPORTATION
HIGHWAYS DIVISION


HONOLULU, HAWAII
"AS BUILT"
PLANS FOR
INSTALLATION

TRAFFIC SIGNAL SYSTEM ON


## LIKELIKE HIGHWAY AT KULA KOLEA DRIVE

FEDERAL AID URBAN PROJECT NO. U-063-1(4)

DISTRICT OF HONOLULU ISLAND OF OAHU

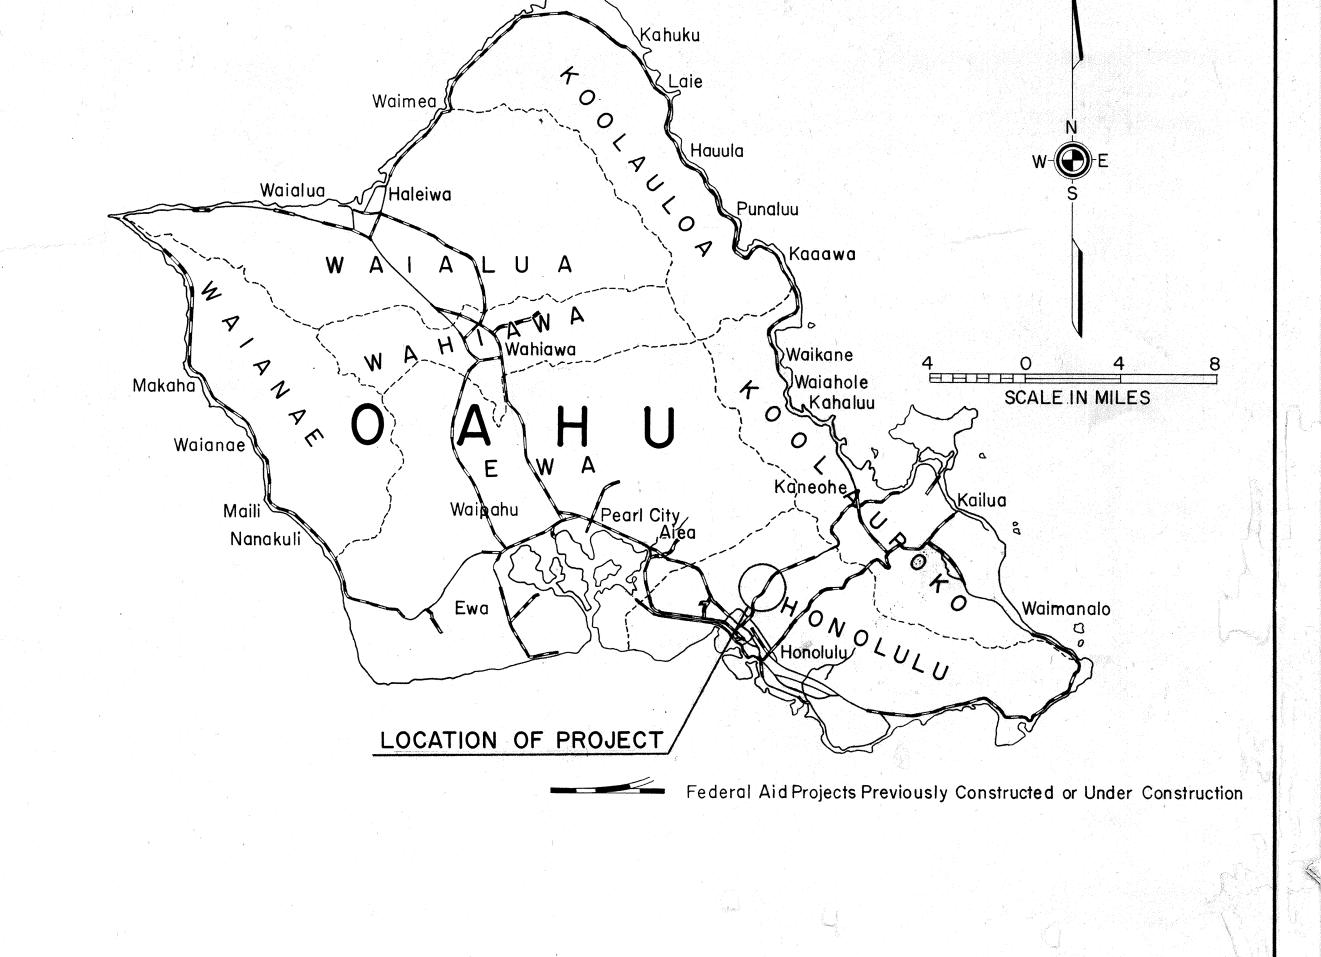

FED. ROAD DIST. NO. STATE FED. AID FISCAL S PROJ. NO. YEAR

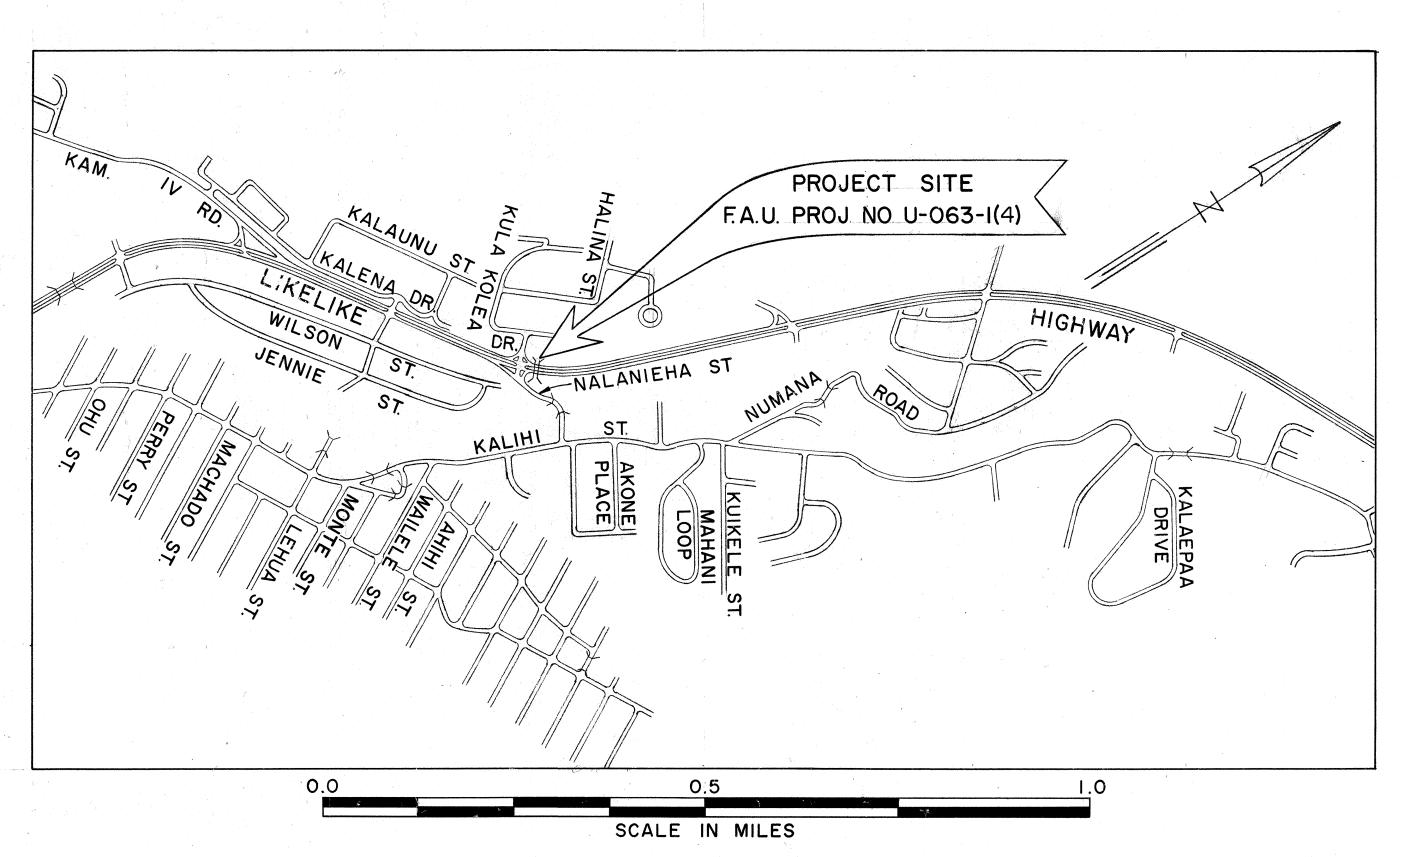

NOTE:

ALL CHANGES MADE DURING CONSTRUCTION HAVE BEEN NOTED IN RED ON THESE TRACINGS AND CHECKED BY

PROJECT ENGINEER DATE

DEPARTMENT OF TRANSPORTATION
BUREAU OF PUBLIC ROADS

APPROVED:

| The Dellage | 12-5-68 | DATE |

DEPARTMENT OF TRANSPORTATION
STATE OF HAWAII

APPROVED:

6. alway Kinglia 8/9/6

LENGTH OF PROJECT .... 0.046 Mi.

6 Mi. LA

LAYOUT PLAN

CURRENT ADT. (1968)

26,900