
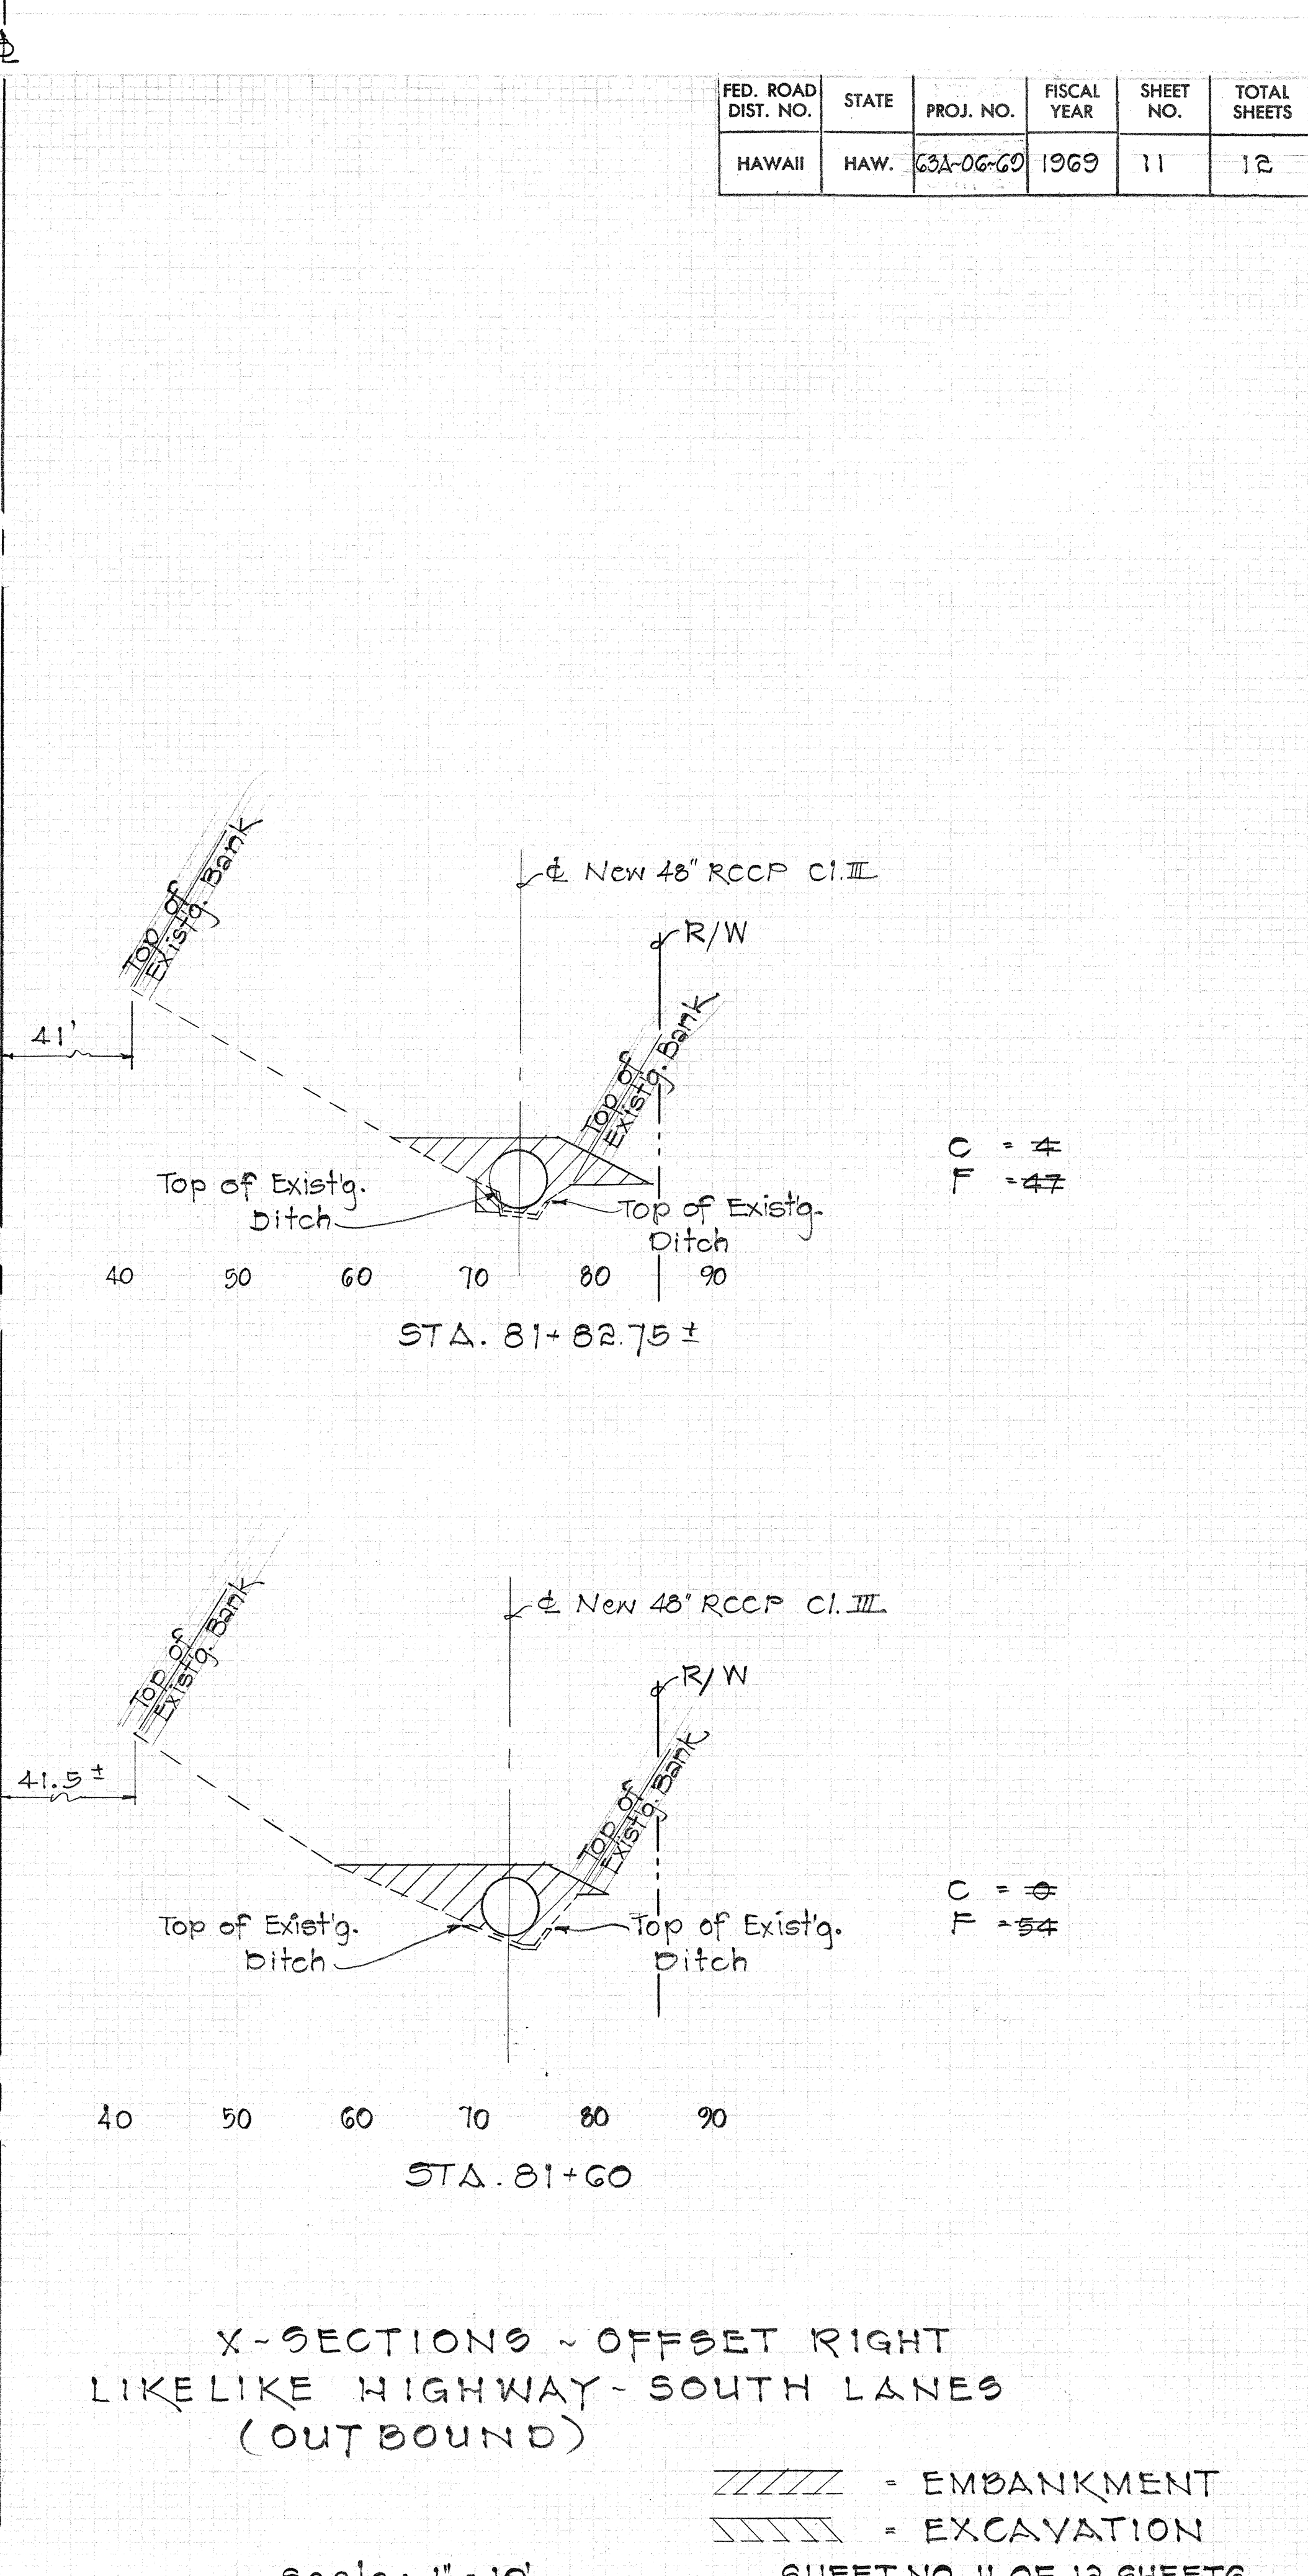
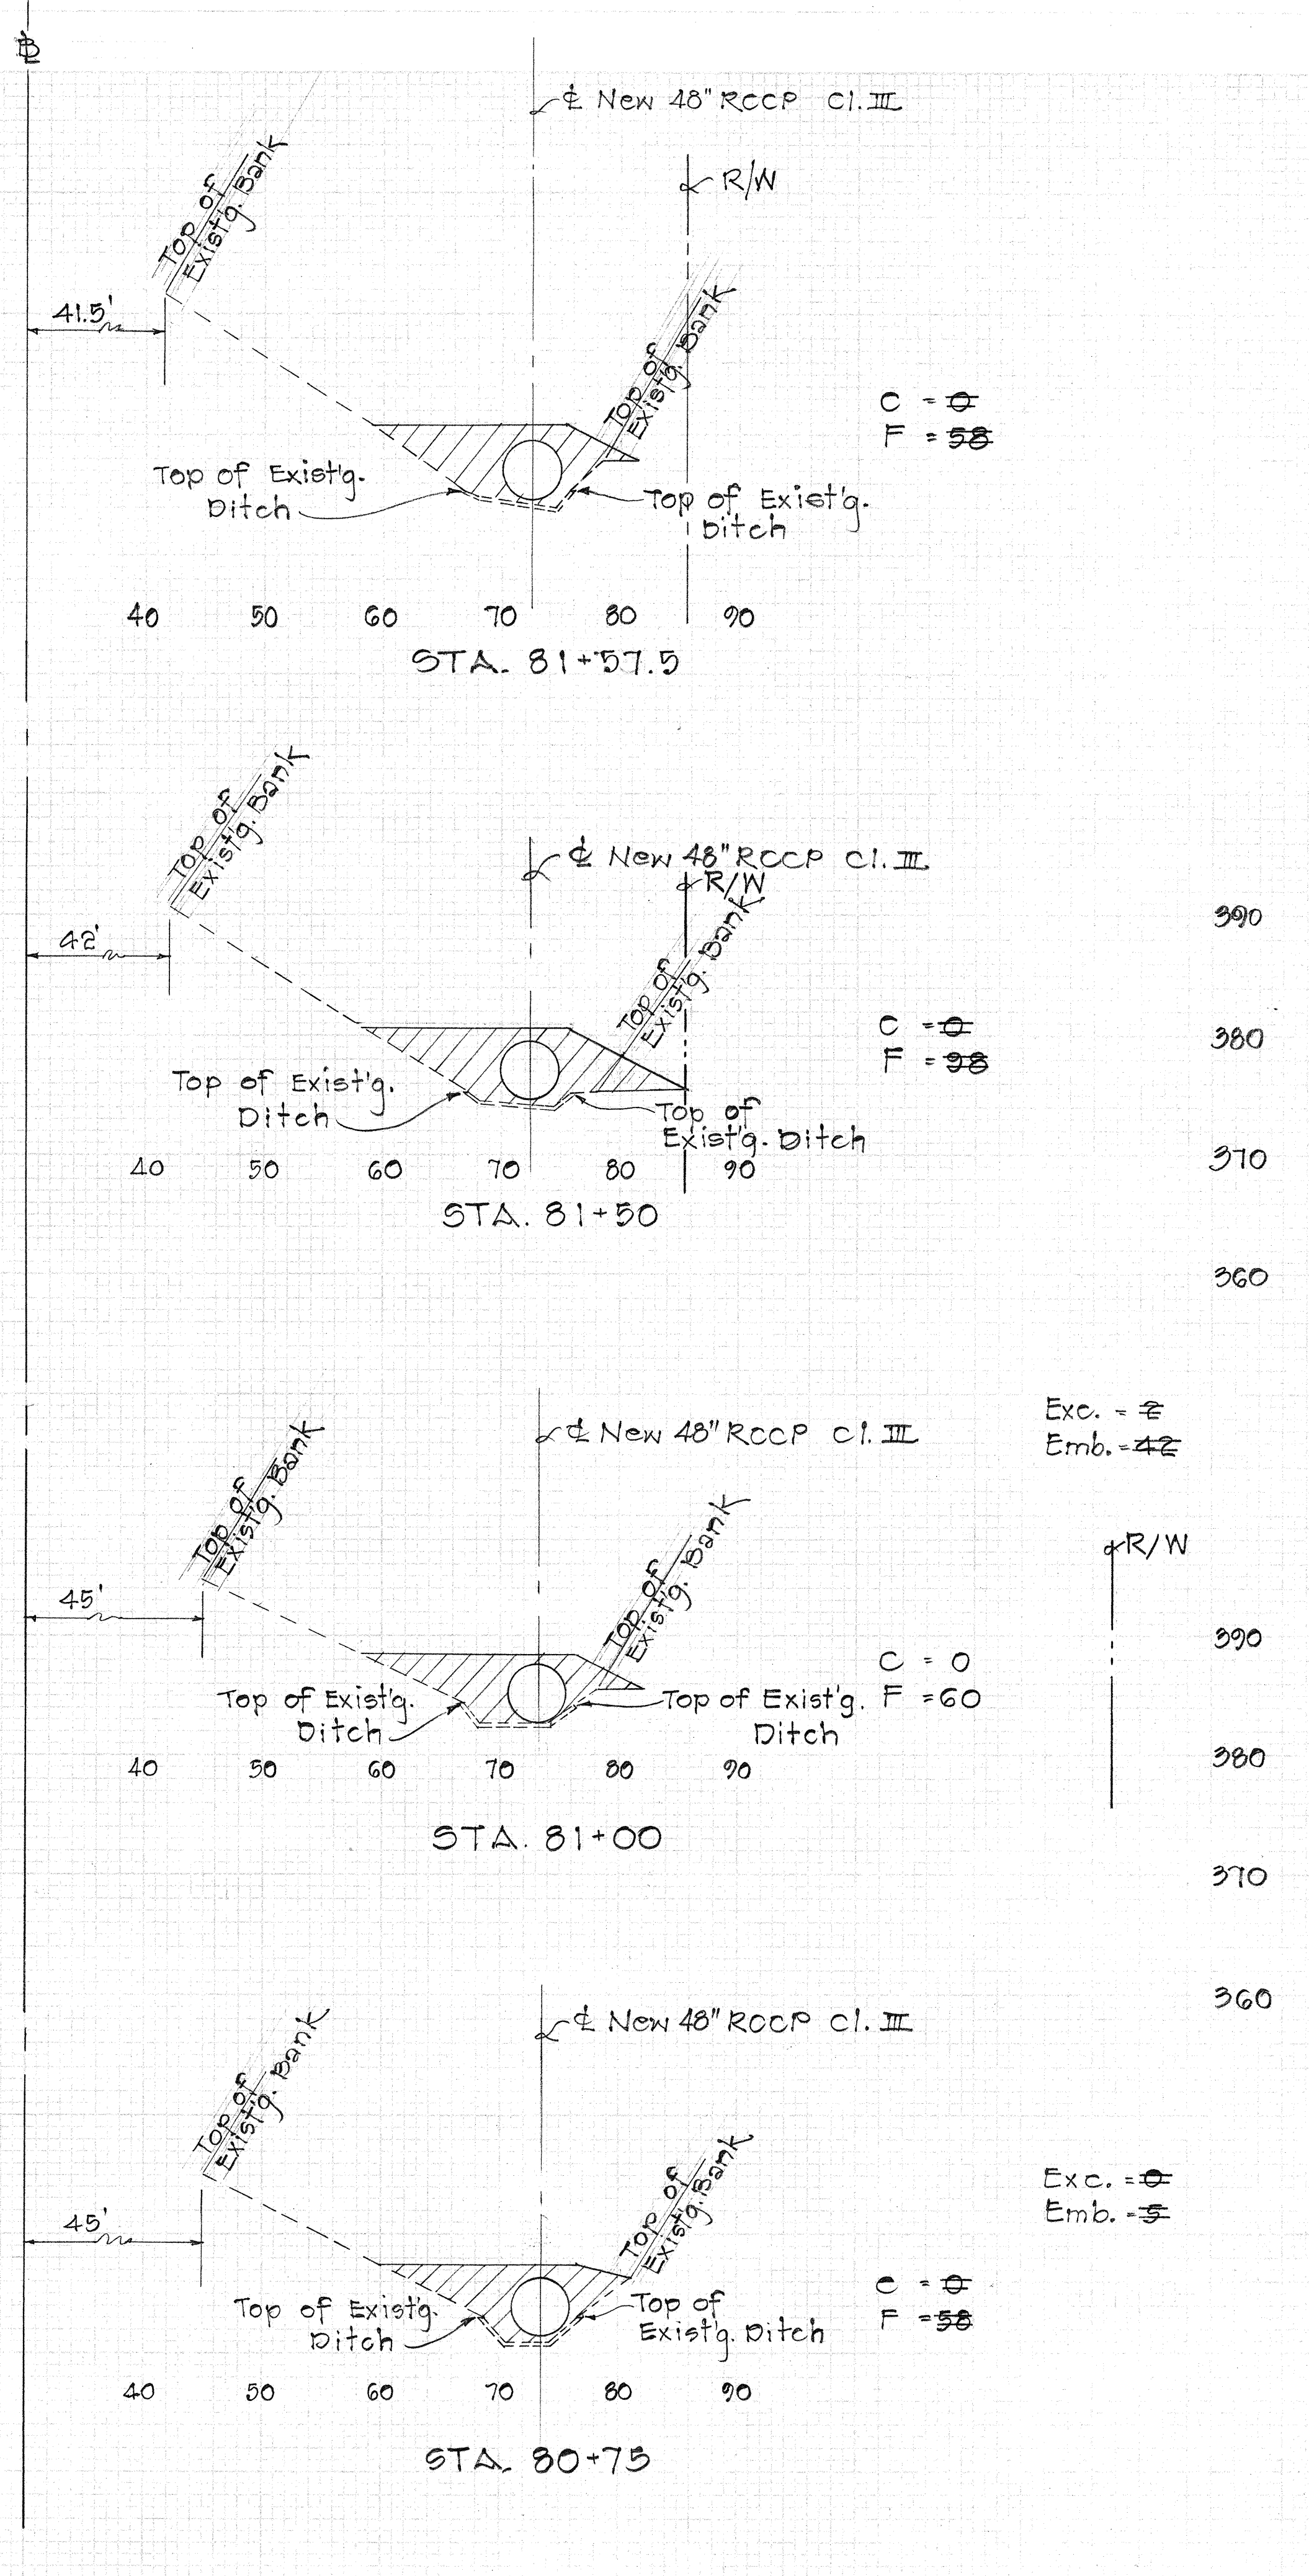


FED. ROAD DIST. NO.	STATE	PROJ. NO.	FISCAL YEAR	SHEET NO.	TOTAL SHEETS
HAWAII	HAW.	63A-06-60	1969	11	12

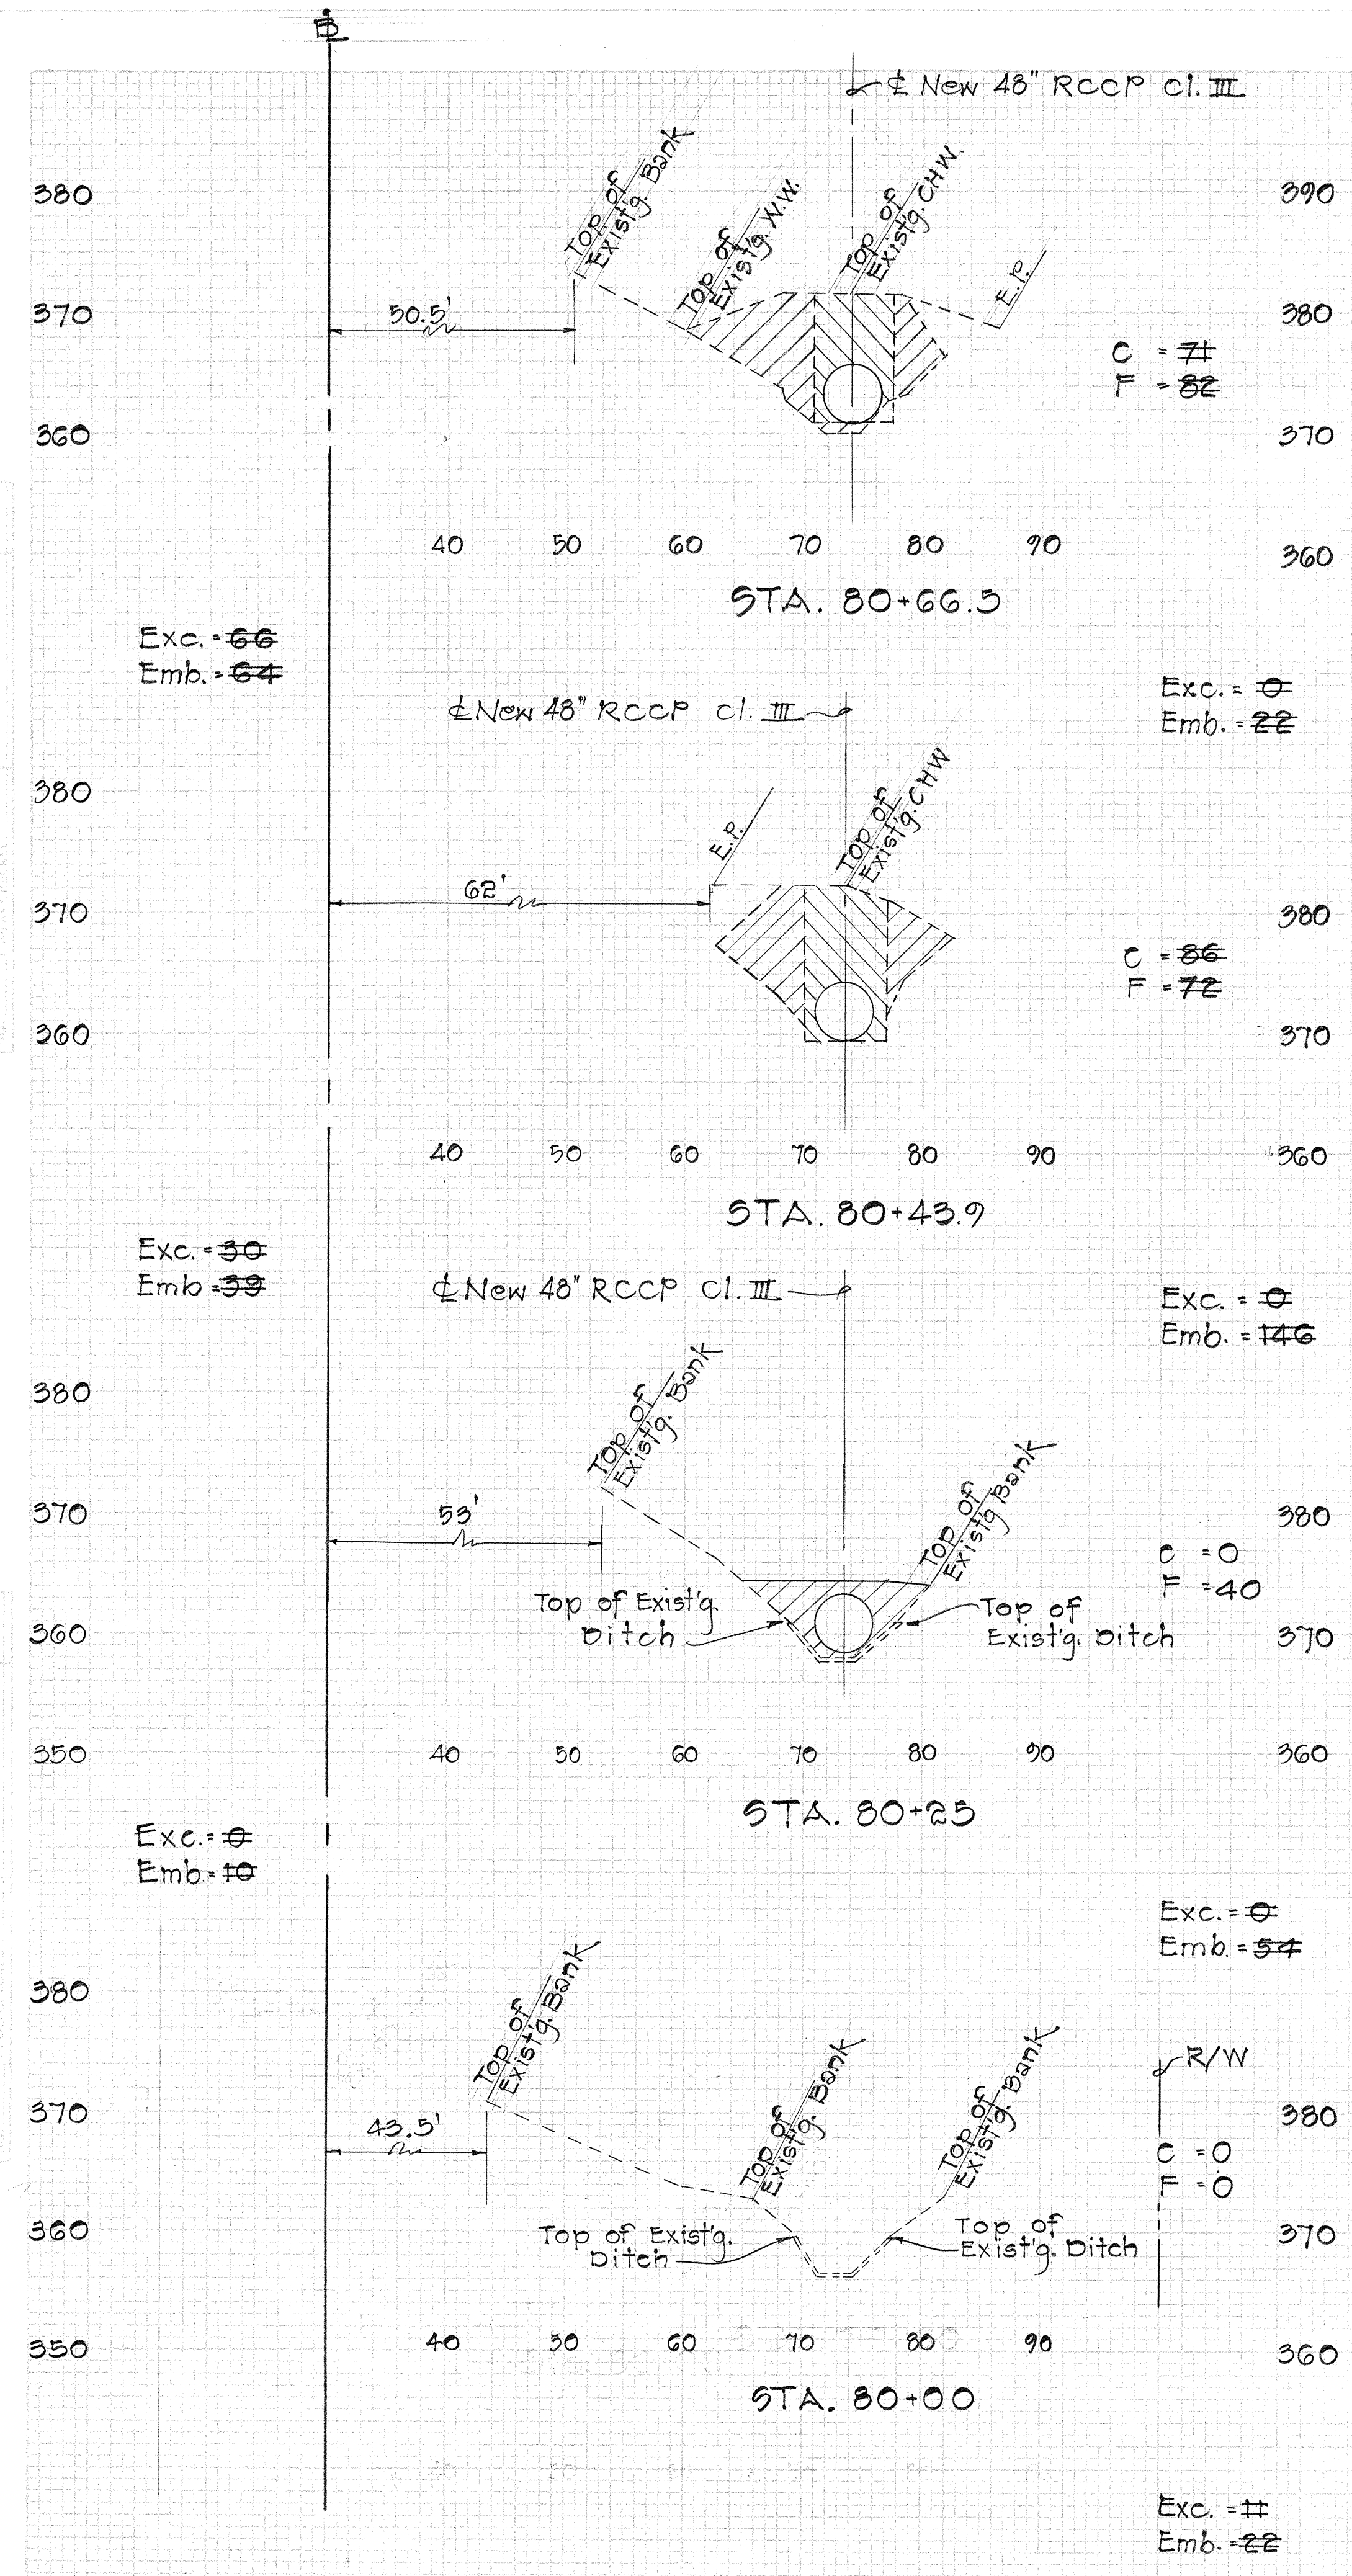

X-SECTIONS - OFFSET RIGHT
LIKELIKE HIGHWAY - SOUTH LANES
(OUTBOUND)

==== EMBAKMENT
==== EXCAVATION

Scale: 1" = 10'

SHEET NO. 11 OF 12 SHEETS

FED. ROAD DIST. NO.	STATE	PROJ. NO.	FISCAL YEAR	SHEET NO.	TOTAL SHEETS
HAWAII	HAW.	65A-06-60	1969	12	12

1. PREPARED BY: []
 2. CHECKED BY: []
 3. DESIGNED BY: []
 4. DRAWN BY: []
 5. IN CHARGE: []
 6. DATE: []
 7. SCALE: []
 8. SHEET NO.: []
 9. TOTAL SHEETS: []

