



DATE	10-2-68
DESIGNED BY	F. WONG
TRACED BY	
QUANTITIES BY	
CHECKED BY	
ORIGINAL	
PLAN	
NOTE BOOK	
No.	

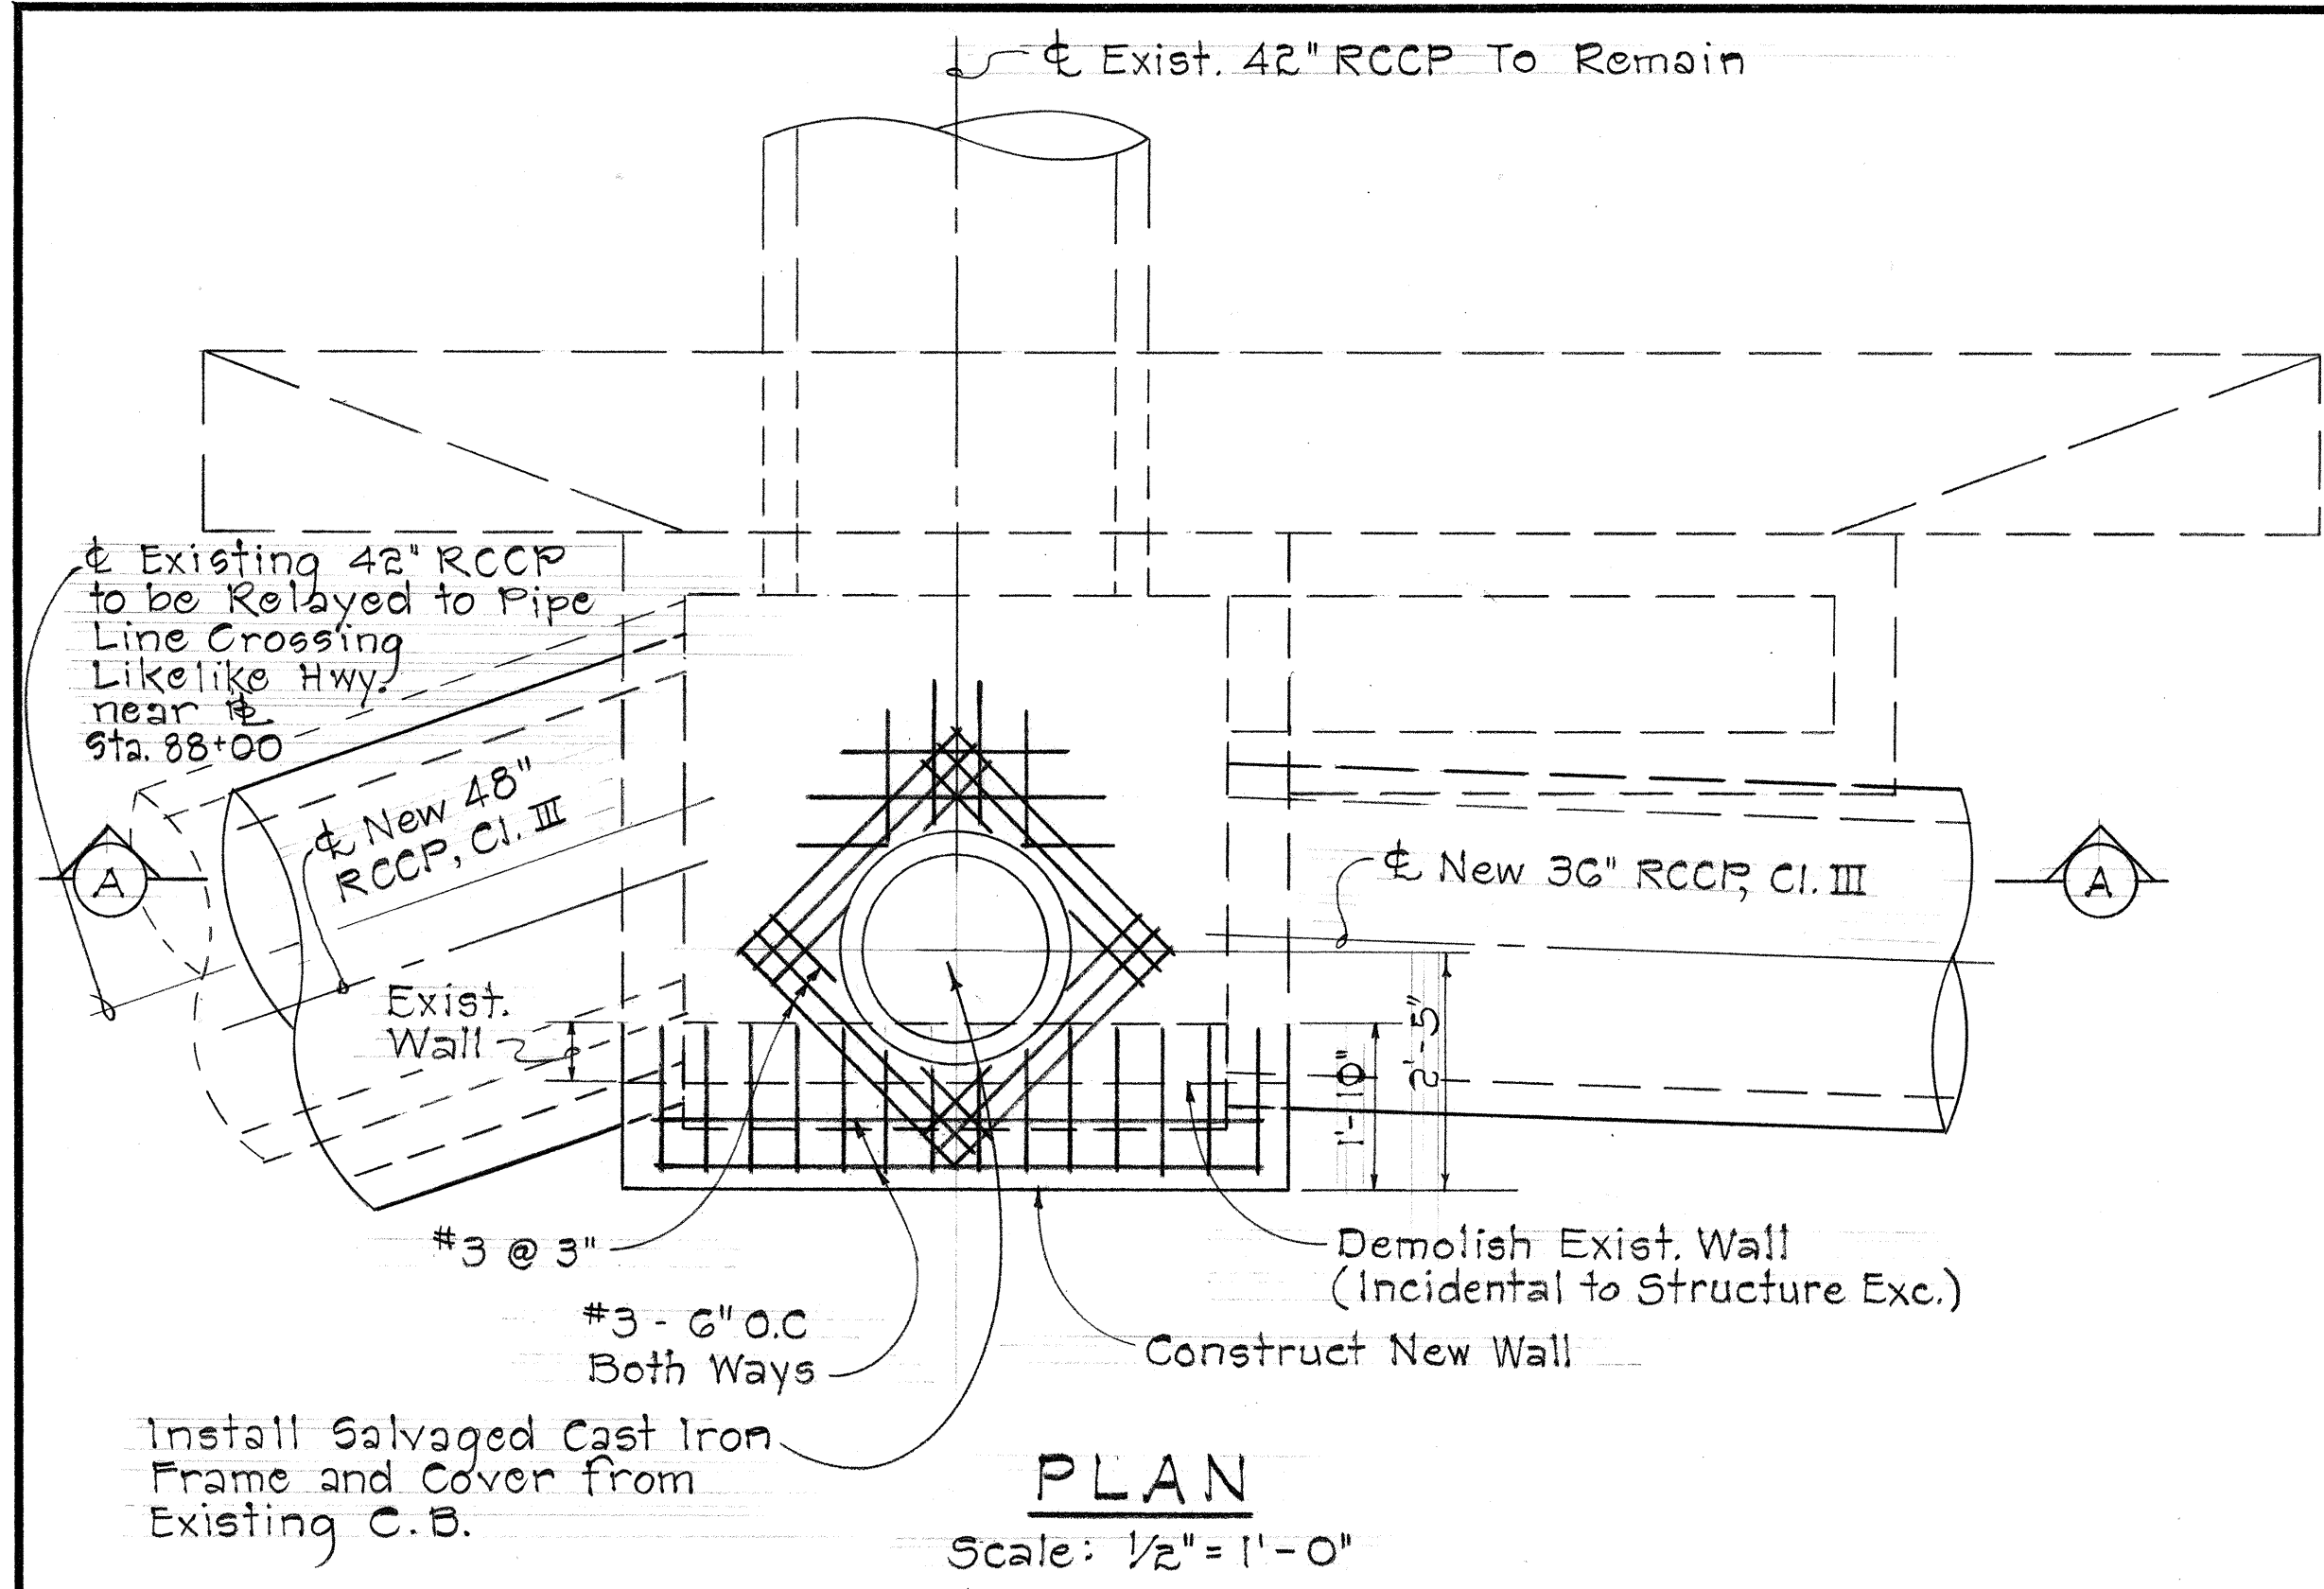

PLAN

Scale: 1/2" = 1'-0"

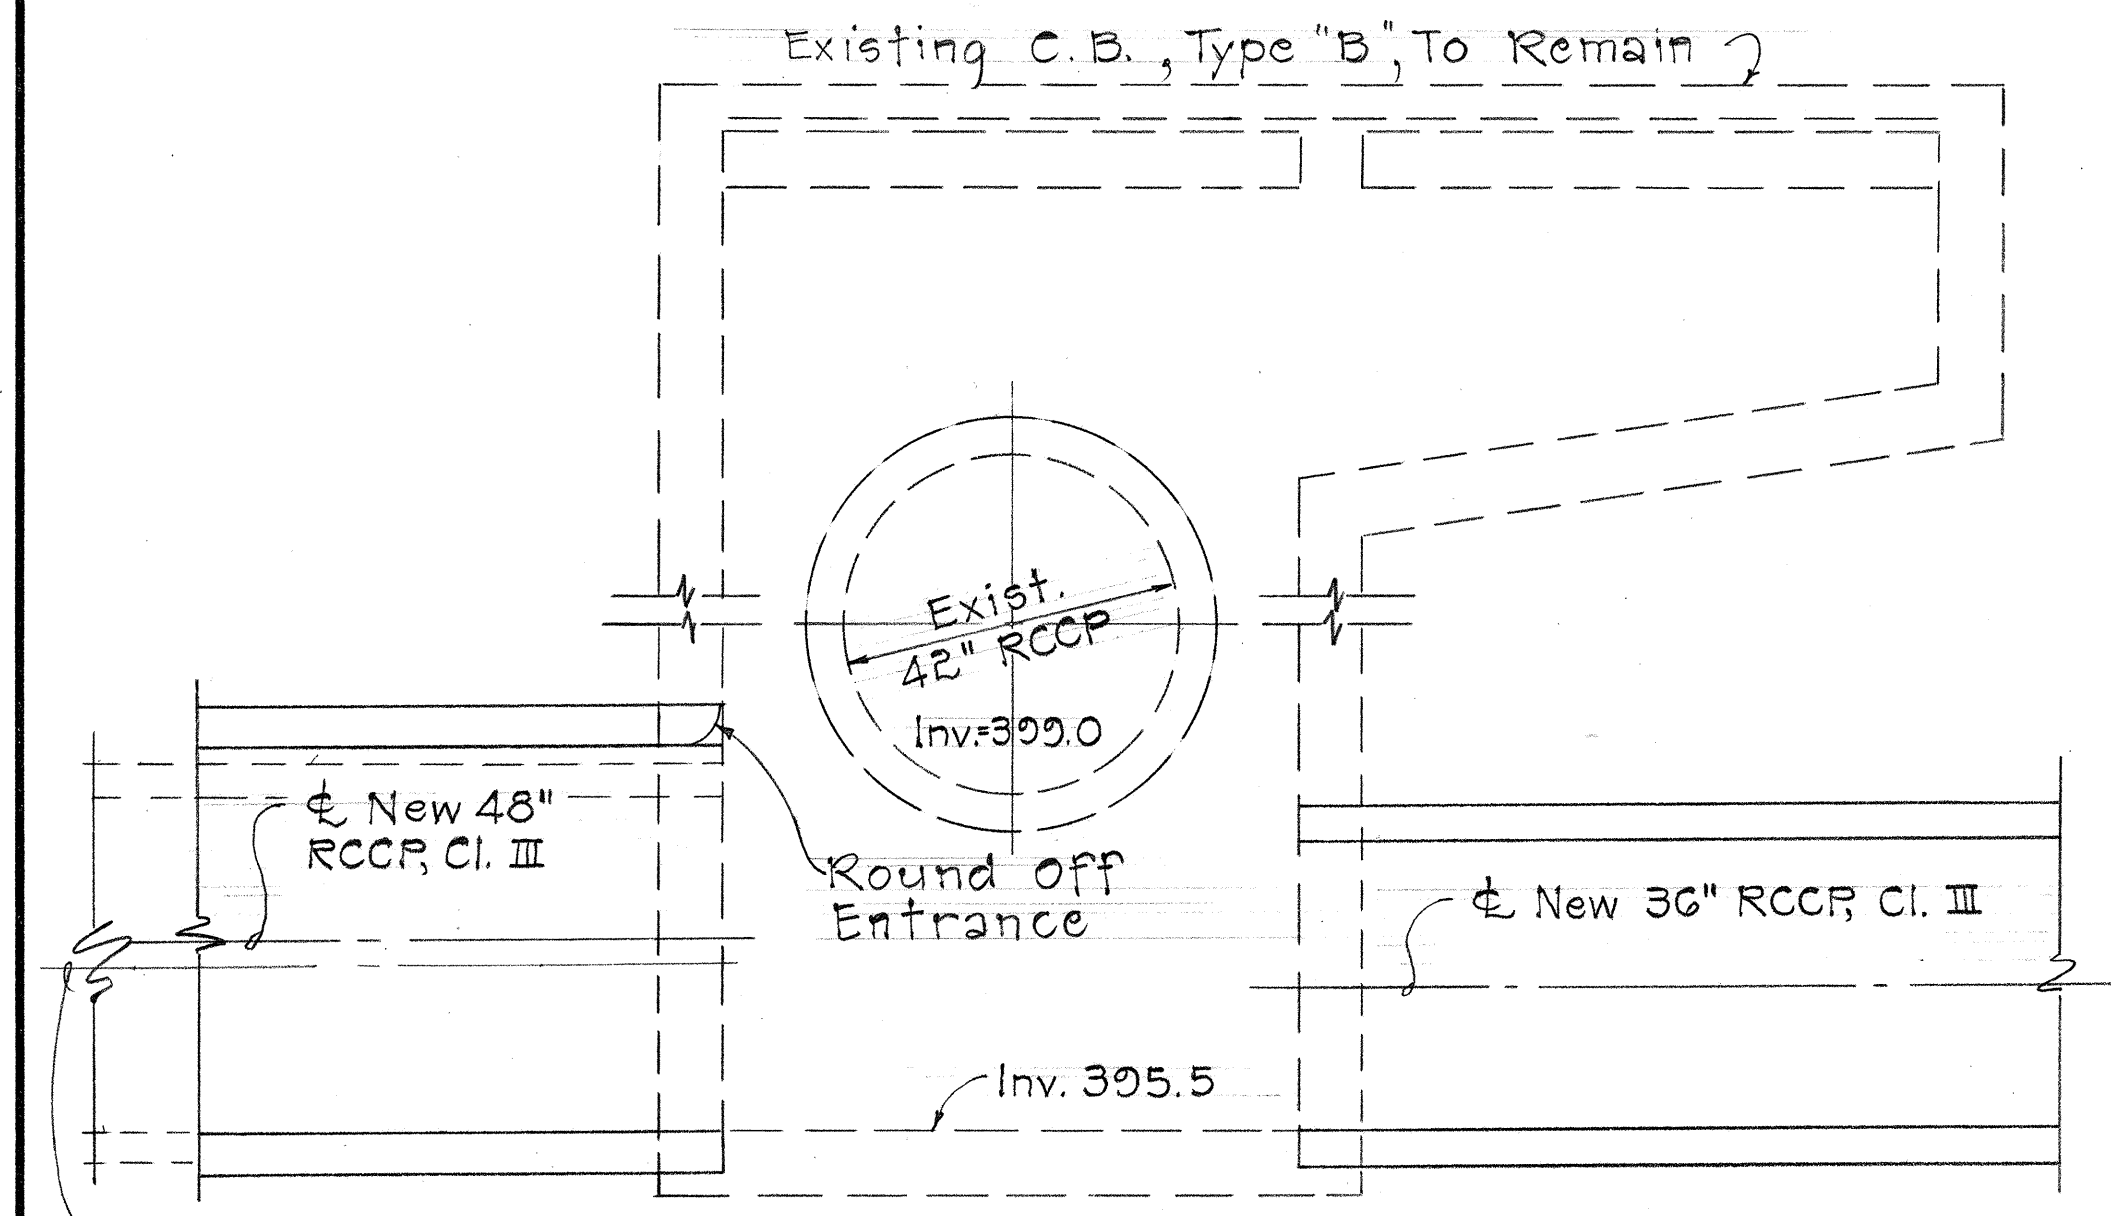

SECTION "A-A"


Scale: 1/2" = 1'-0"

TYPE "B" C.B.

Sta. 85+50


GENERAL NOTES

- Where new reinforcing steel is needed for additions to existing structures and relocation of manholes, new bars, which are in line with existing bars, shall be lapped 6 inches over the existing bars. The bars shall be placed in contact and wired in such a manner as to maintain a clearance of not less than the minimum clear distance between bars and the minimum distance to the surface of the concrete. Splicing of new bars to existing bars shall not be paid for separately, but shall be incidental to payment for "Reinforcing Steel Other Than In Bridges".
- Where modifications are made to existing drainage structures, the contractor shall be responsible for demolition of portions of the existing structure where necessary for installation of new reinforcing steel. Payment for demolition shall be incidental to "Structure Excavation." Extreme caution shall be taken to prevent damage to existing reinforcing steel. All existing reinforcing steel shall remain except at locations that will be completely demolished.
- At connections of new pipe culverts to existing drainage structures, sealing of holes made for installation of new pipes shall not be paid for separately, but shall be incidental to payment for the new pipe culvert.
- Where new pipe culvert construction crosses or nears the existing guard rails, the contractor shall see that no damage occurs to the guard rails. Where an existing guard rail interferes with a new installation, the contractor shall remove the guard rail temporarily. After completion of the new installation, the guard rail shall be re-installed. If the existing guard rail posts interfere with the new installed pipe, they may be relocated. In any event the contractor shall see that no damage occurs to either the re-installed guard rail or the new installed pipe. Payment for adjustment or relocation of the existing guard rails shall not be paid for separately, but shall be considered incidental to the items of work in the general vicinity.
- Backfill for "Structure Excavation" from Sta. 80+20 to Sta. 84+40 shall be of the same quality as material required for fill in the remainder of the section and shall be measured and paid for under the item for "Structure Excavation".
- At Sta. 80+50± after installation of the new 48" RCCP, the existing pavement for the existing access road to the H.E. Co. Substation shall be restored and paid for under item 131.01, "Restoring Highway Pavement".
- The existing Signal Corps cables and other lines shown on the plans are approximate only. The depth of the existing Signal Corps cable is approximately 30 inches. One week before excavation work starts in the vicinity of any existing Signal Corps cable, the contractor shall notify the H.T. Co. West Division Construction Supervisor, Mr. G. Stender at 898-225, so that the cable can be toned out for its exact location. H.T. Co. will assign an inspector to this project during the excavation and backfilling phase to see that proper measures are taken at all times to prevent damages to this highly important cable. The contractor shall provide adequate shoring and temporary support for the exposed Signal Corps cable in the open trench area. The contractor shall replace the Signal Corps cable to its original position after the installation of the proposed drain pipe. All expenses incurred by the contractor in supporting, protecting, and replacing the cable shall not be paid for separately, but shall be considered incidental to the items of work in the immediate vicinity.
- In the 42" Drain Line crossing Likelike Highway, the contractor has the option of relaying the existing 42" RCCP, salvaged from Sta. 84+40 to Sta. 85+50 and Sta. 80+50, and installing the pipe in the new location; or installing entirely new 42" RCCP. If the contractor elects to use the option of relaying existing RCCP, he will find that the number of linear feet of salvaged pipe will not be sufficient for the entire drain line. He shall install the relayed pipe in the two lower sections first. Any new pipe required shall be installed in the upper section leading from the new CDI to the new Type "F" C.B. In order to differentiate the quantity for this new 42" pipe in the upper section from the quantity for new 42" pipe in the other option, it shall be measured and paid for under Item No. 58.124A2 while the other option of installing entirely new 42" RCCP shall be measured and paid for under Item No. 58.124A1. Although there are two separate items for new 42" RCCP, the Standard Specifications and Special Provisions apply equally to each item. Restoration of the existing pavement shall be paid for under Item No. 131.01, "Restoring Highway Pavement."

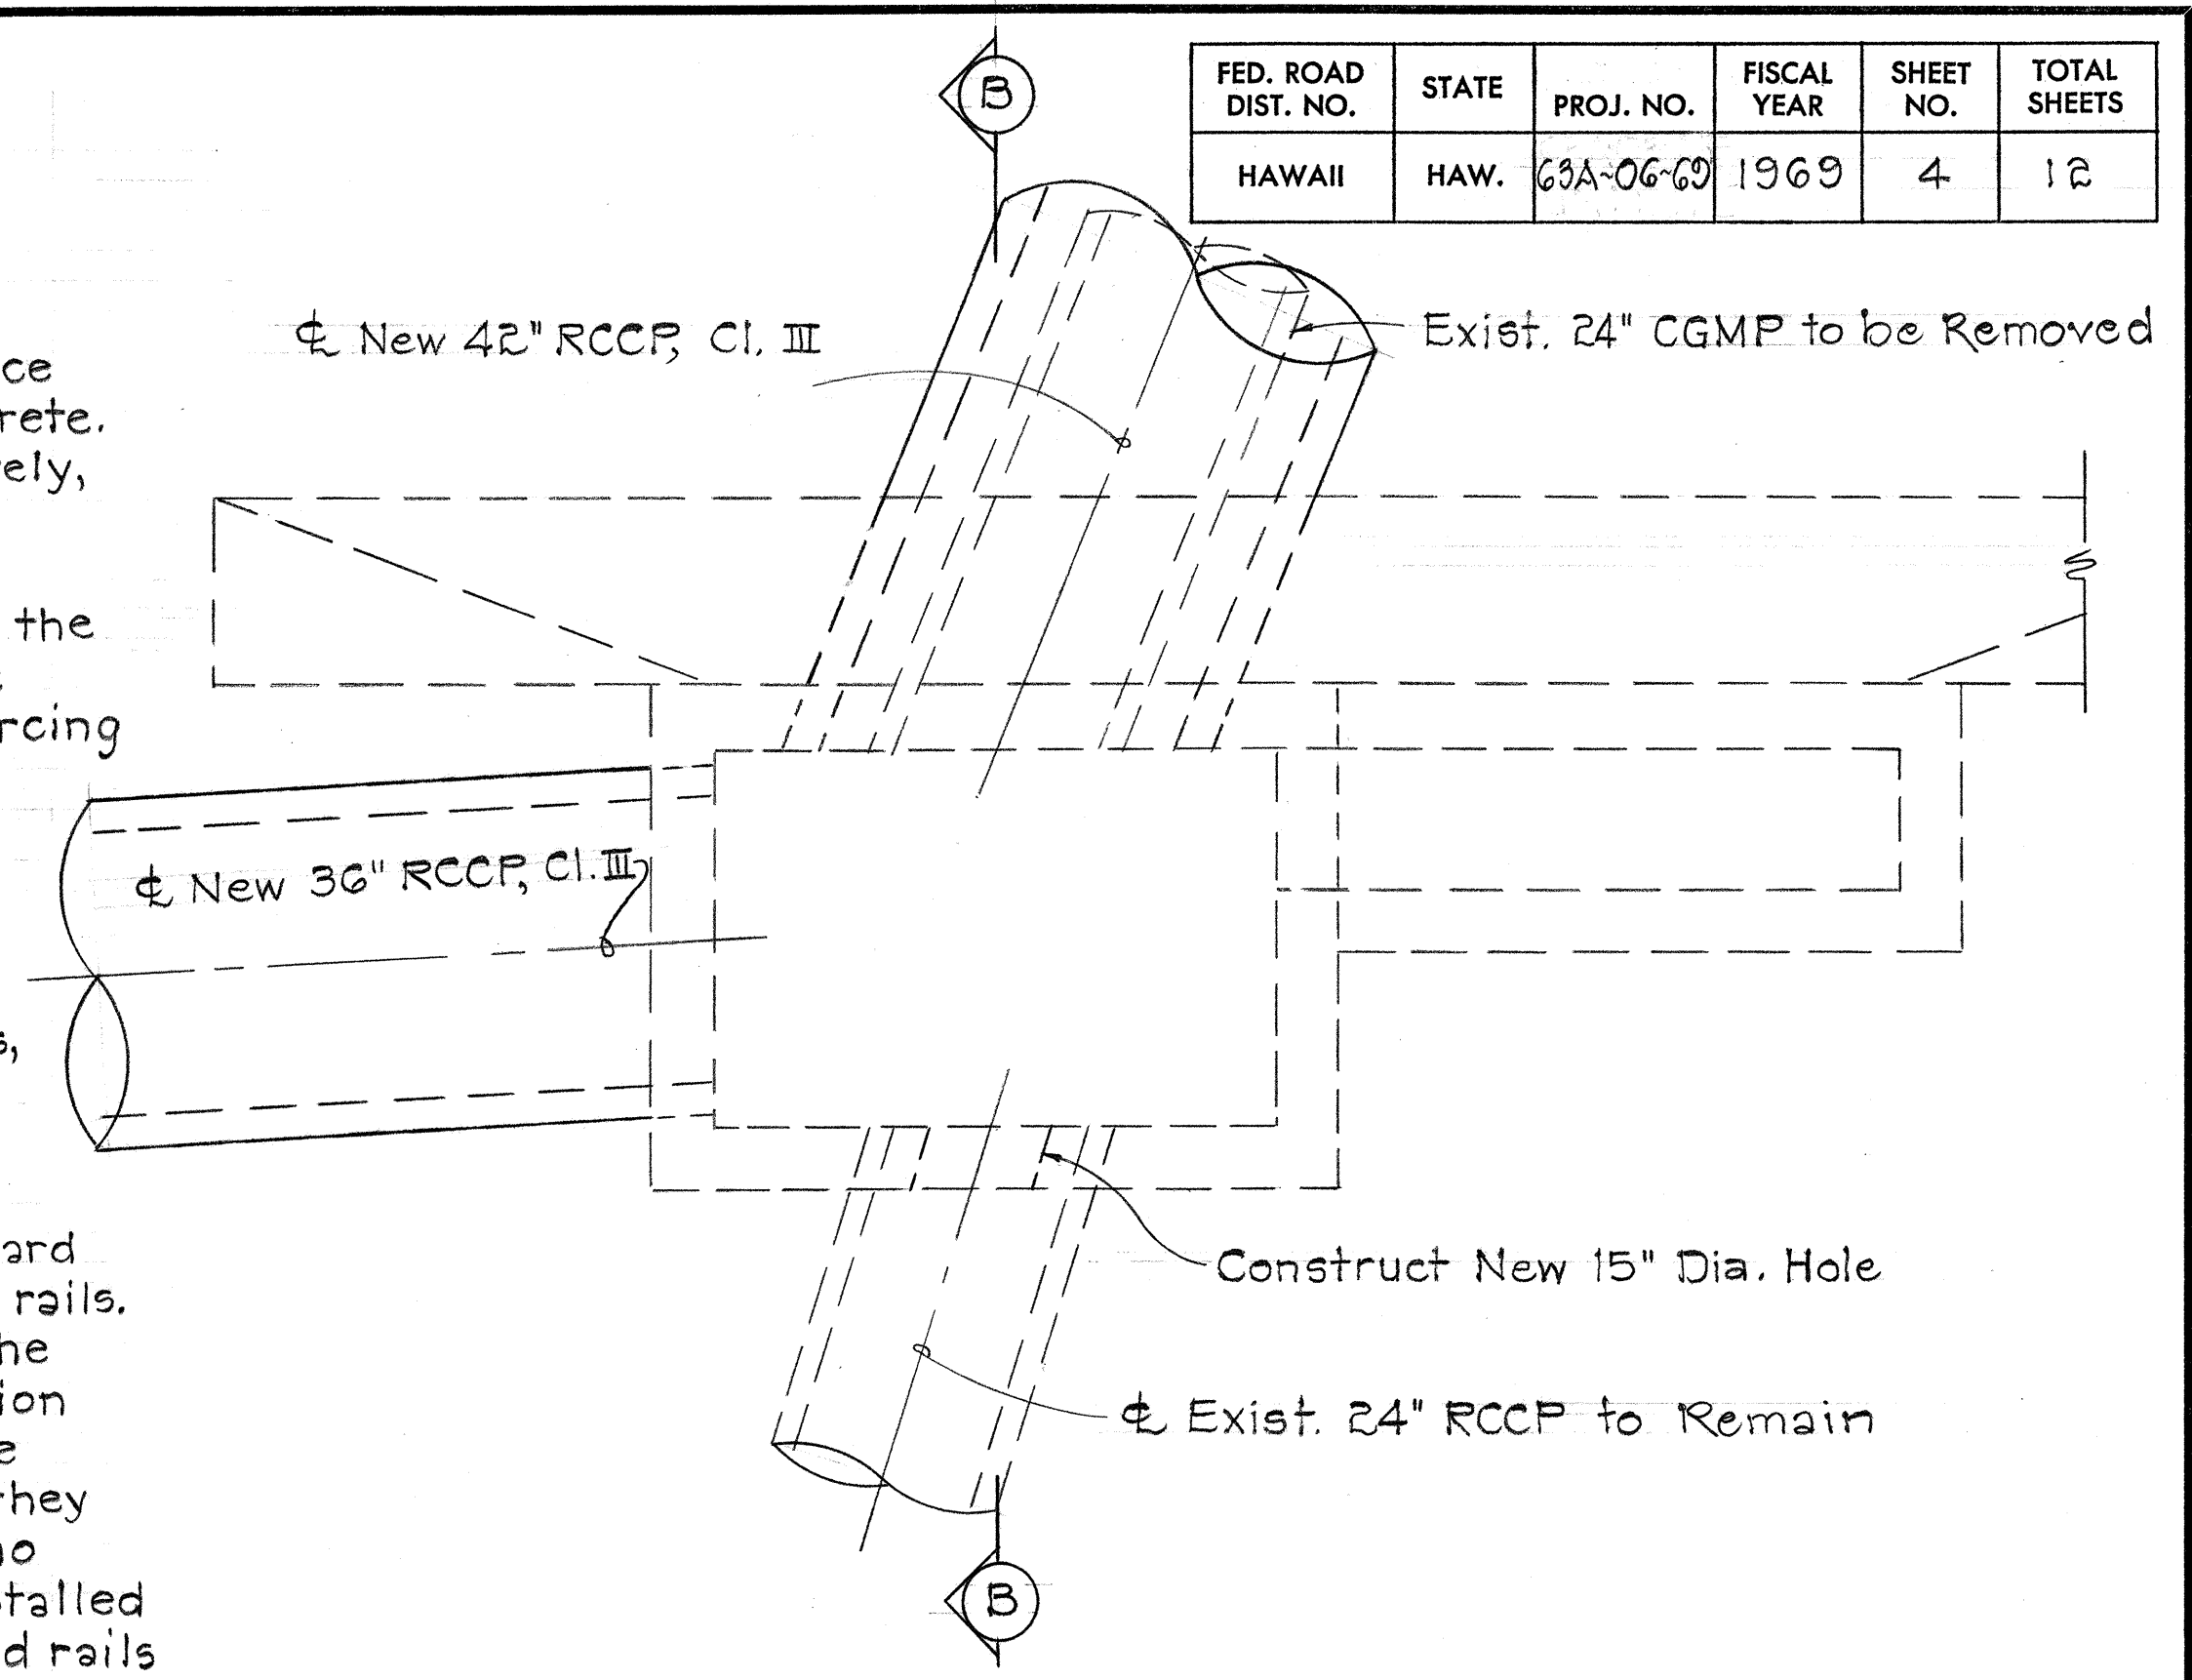

PLAN

Scale: 1/2" = 1'-0"

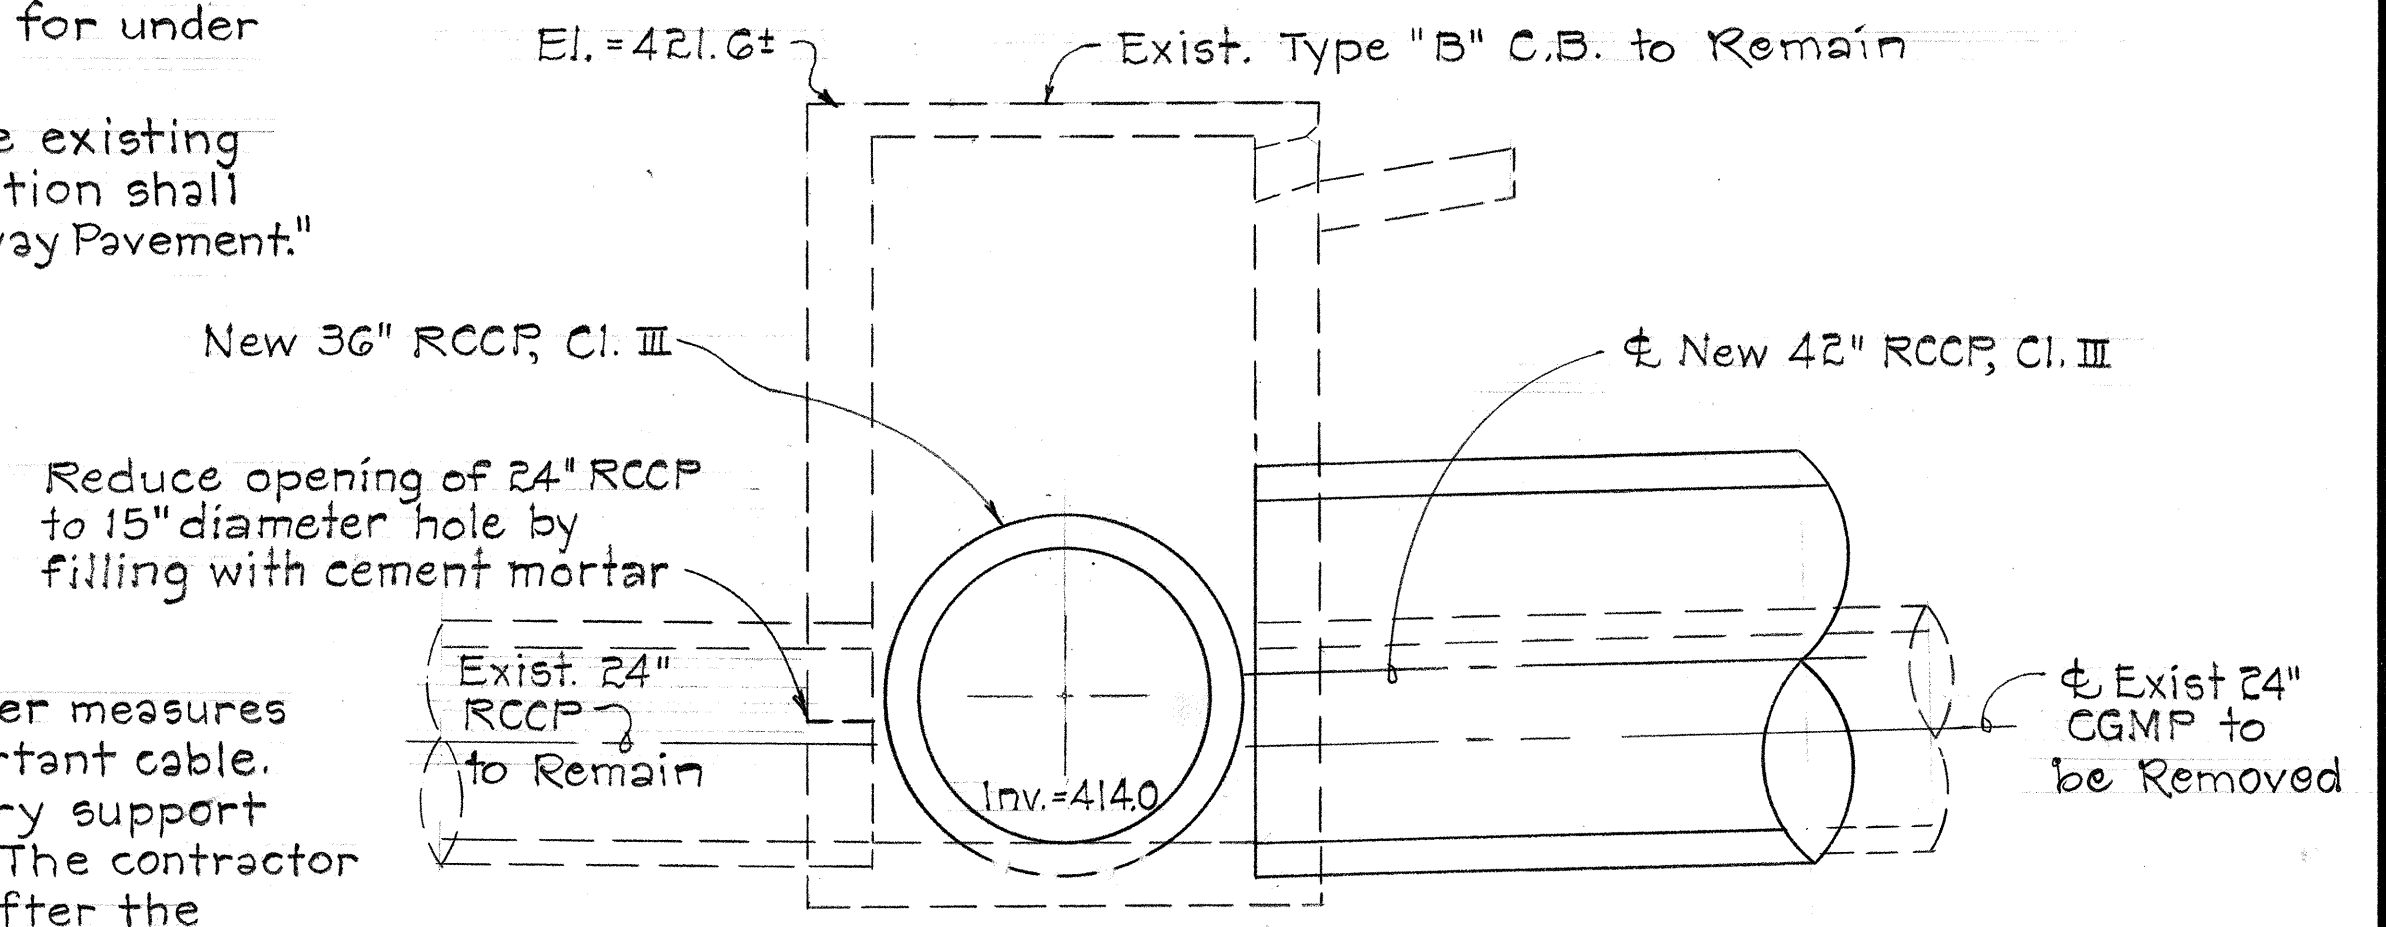

SECTION "B-B"

Scale: 1/2" = 1'-0"

TYPE "B" C.B.

Sta. 87+70

STATE OF HAWAII
DEPARTMENT OF TRANSPORTATION
HIGHWAYS DIVISION

DRAINAGE DETAILS



LIKELIKE HIGHWAY

PROJ. NO. G3A-OG-60

Scale: 1/2" = 1'-0" Date: Oct. 1968



SHEET No. 4 OF 12 SHEETS

DATE	_____
SURVEYED BY	_____
DESIGNED BY	_____
CHECKED BY	_____
ORIGINAL	_____
PLAN	_____
NOTE BOOK	_____
No.	_____

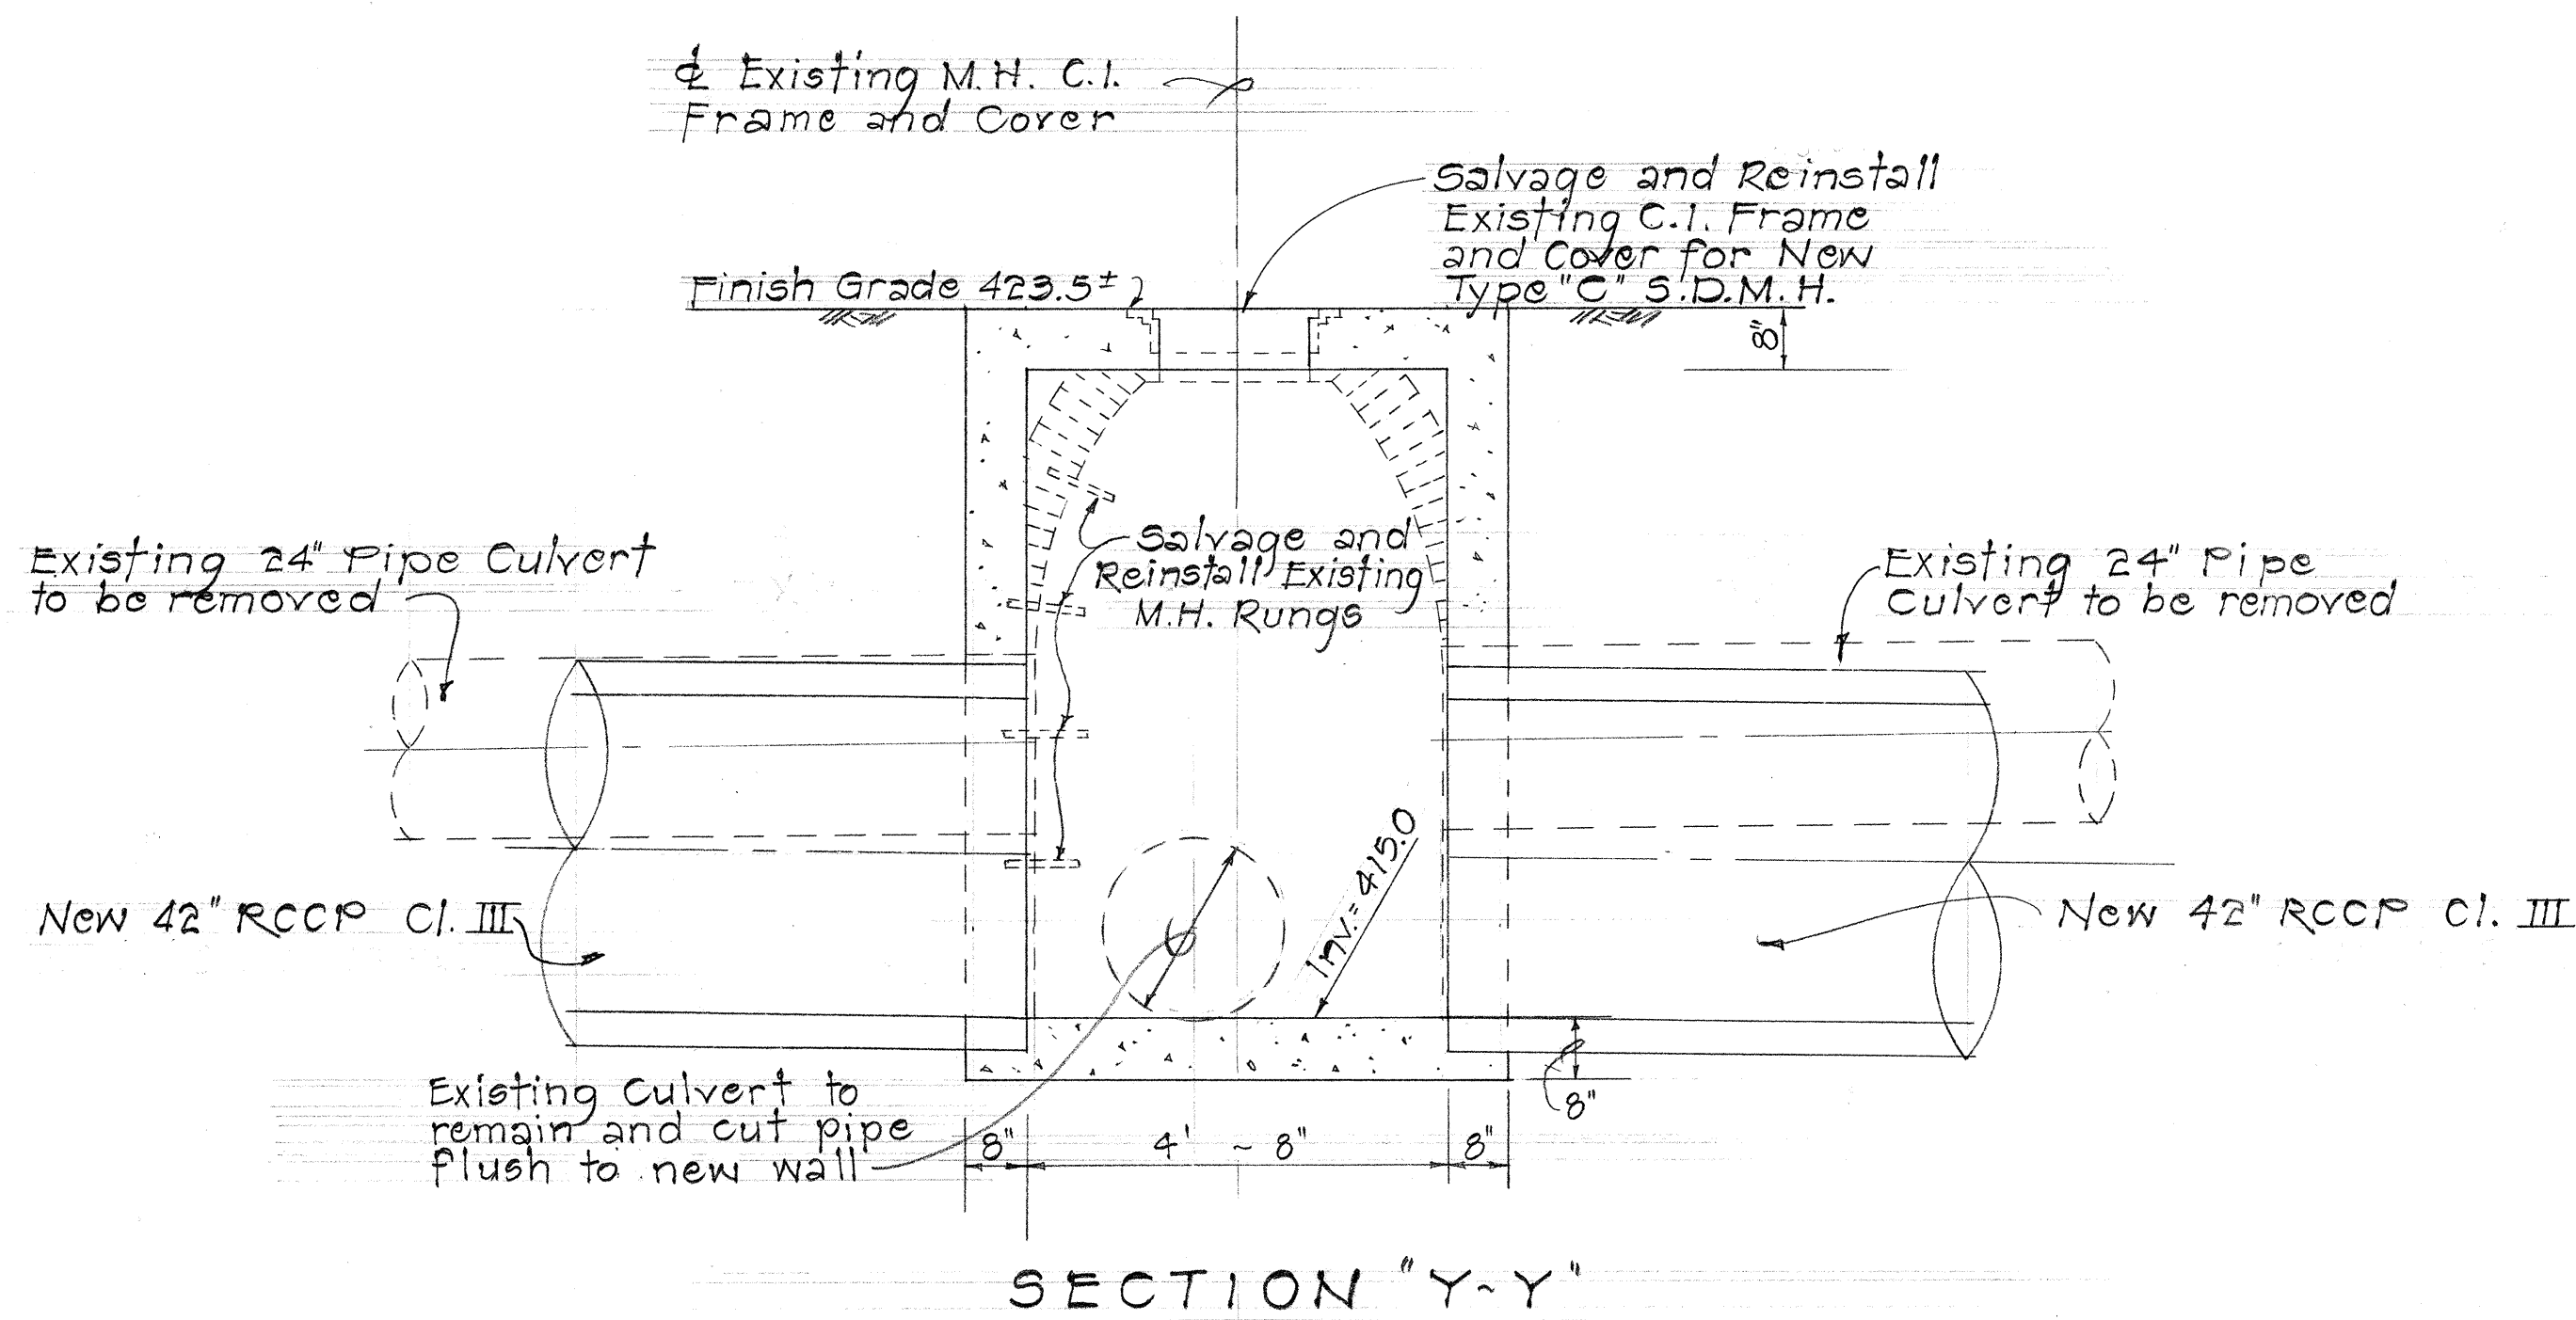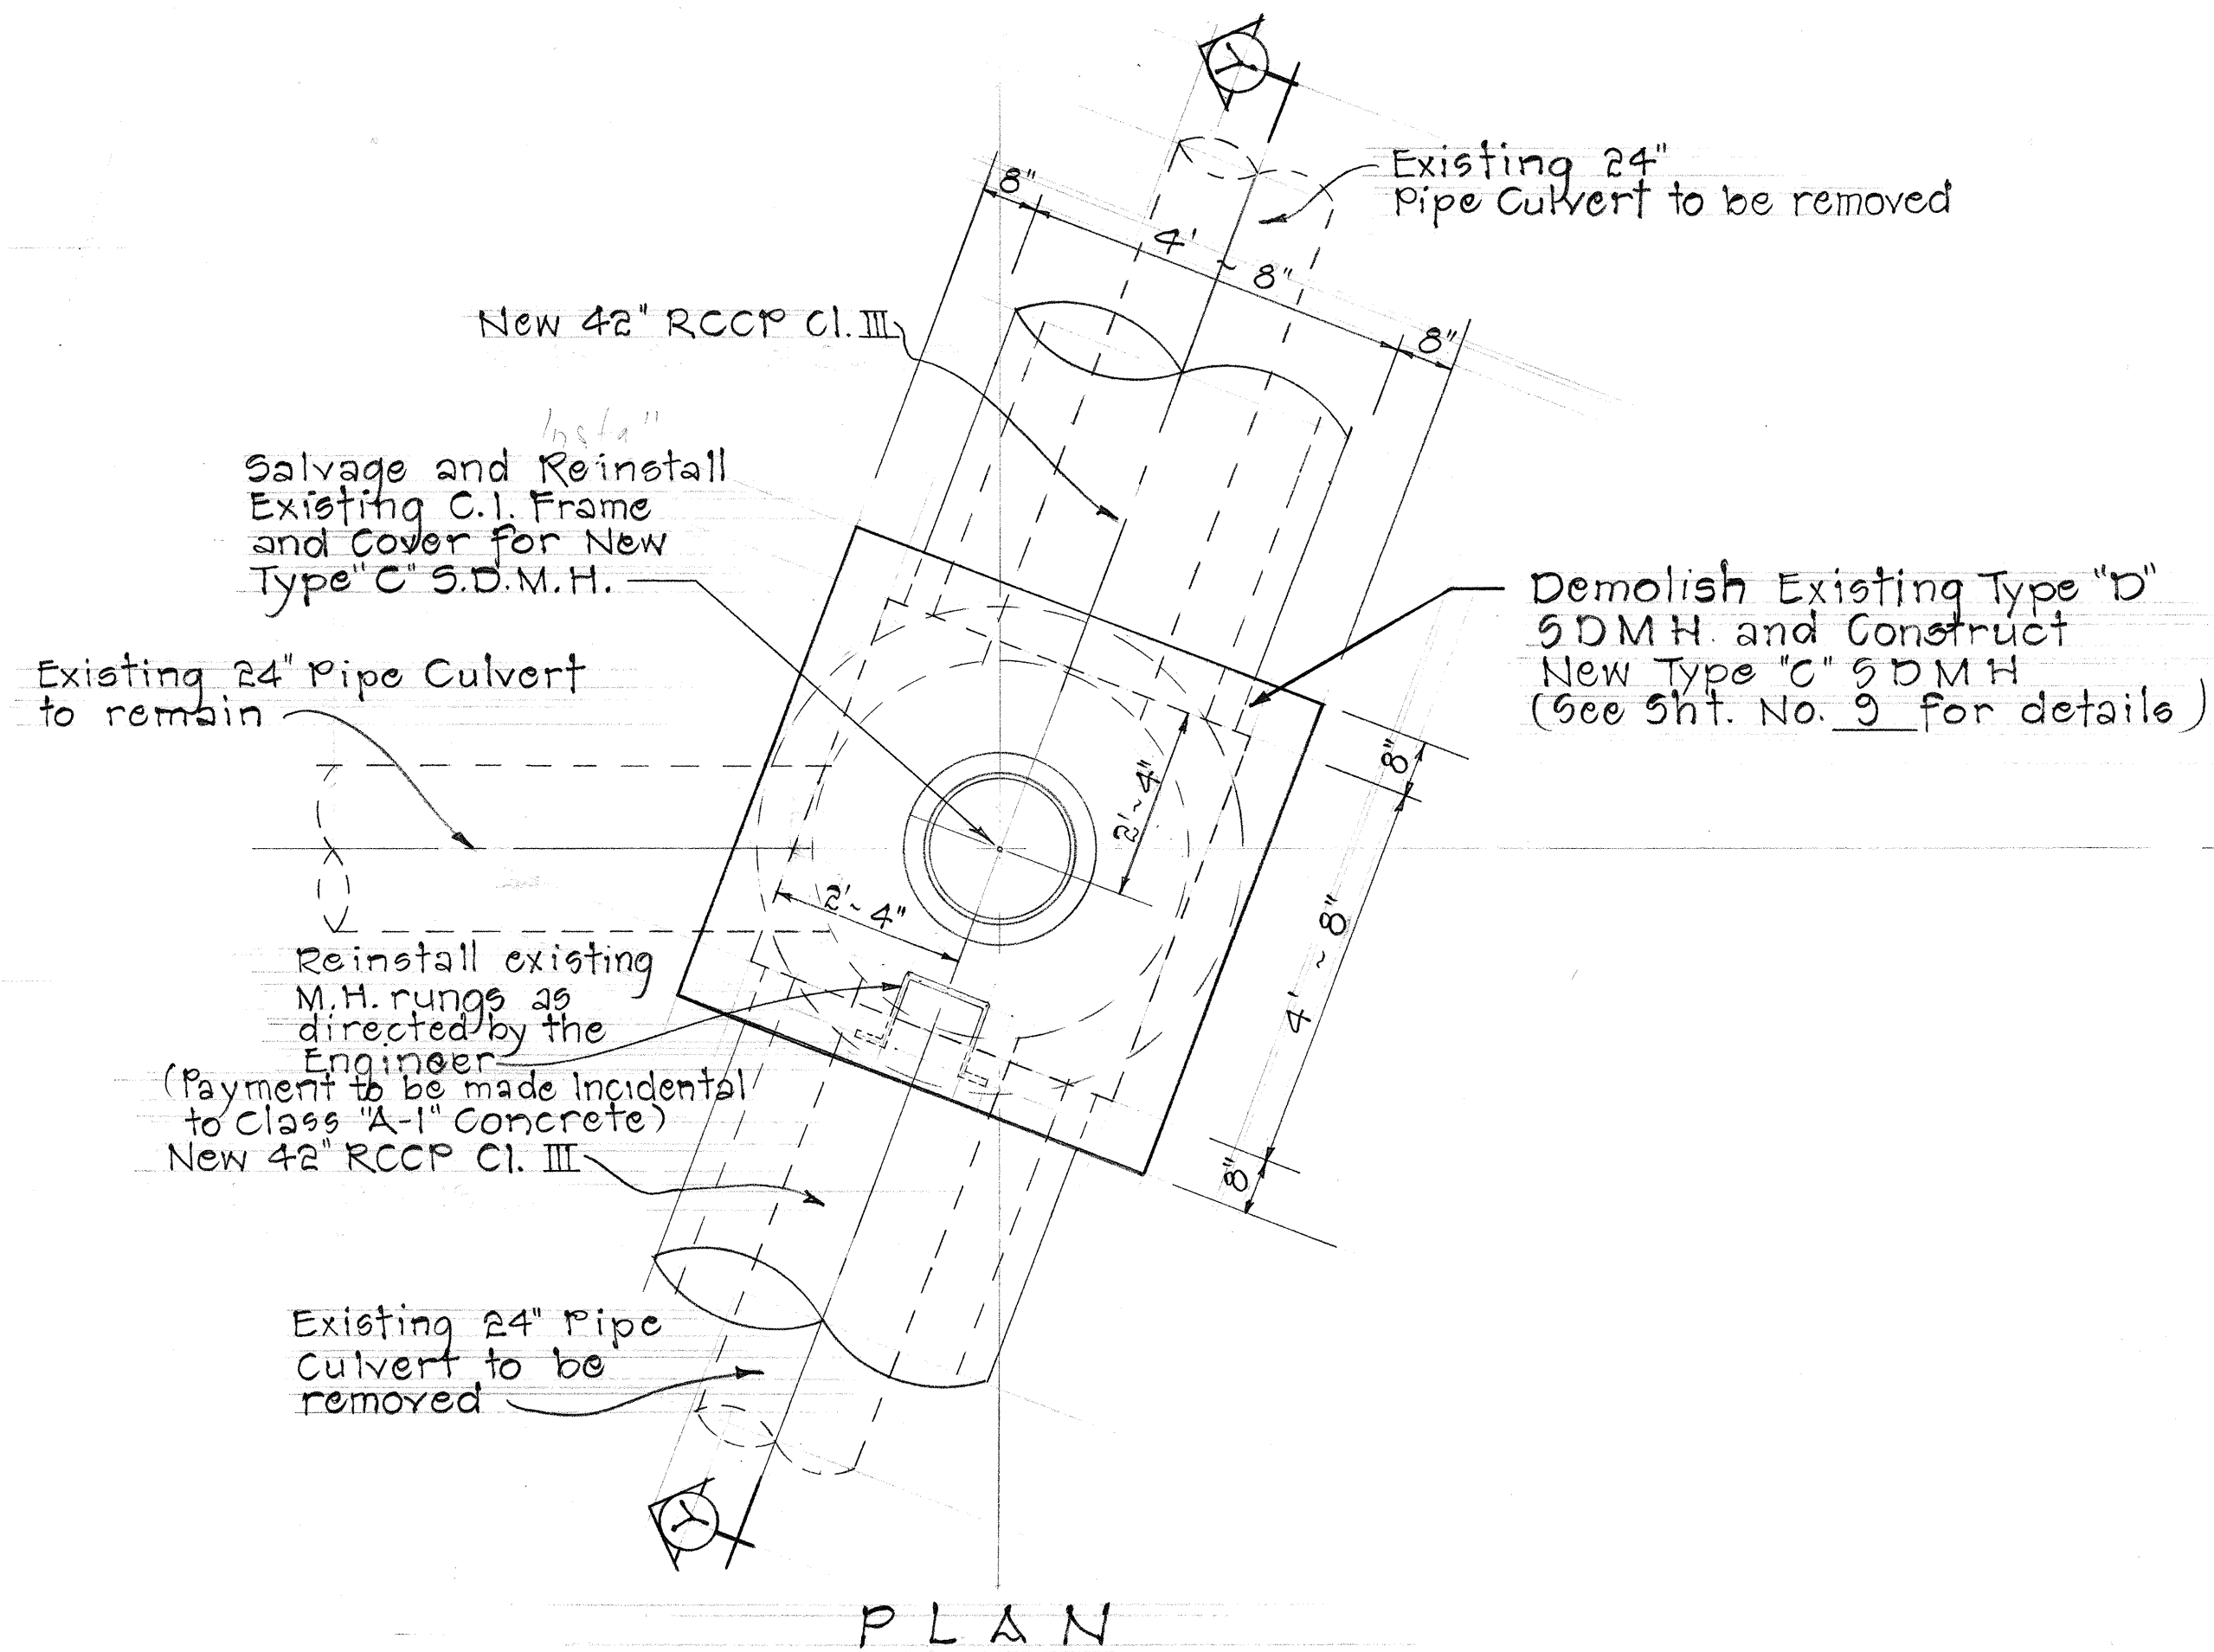

DETAIL OF NEW TYPE "C" S.D.M.H. @ STA. 87+84

Scale: 1/2" = 1'-0"

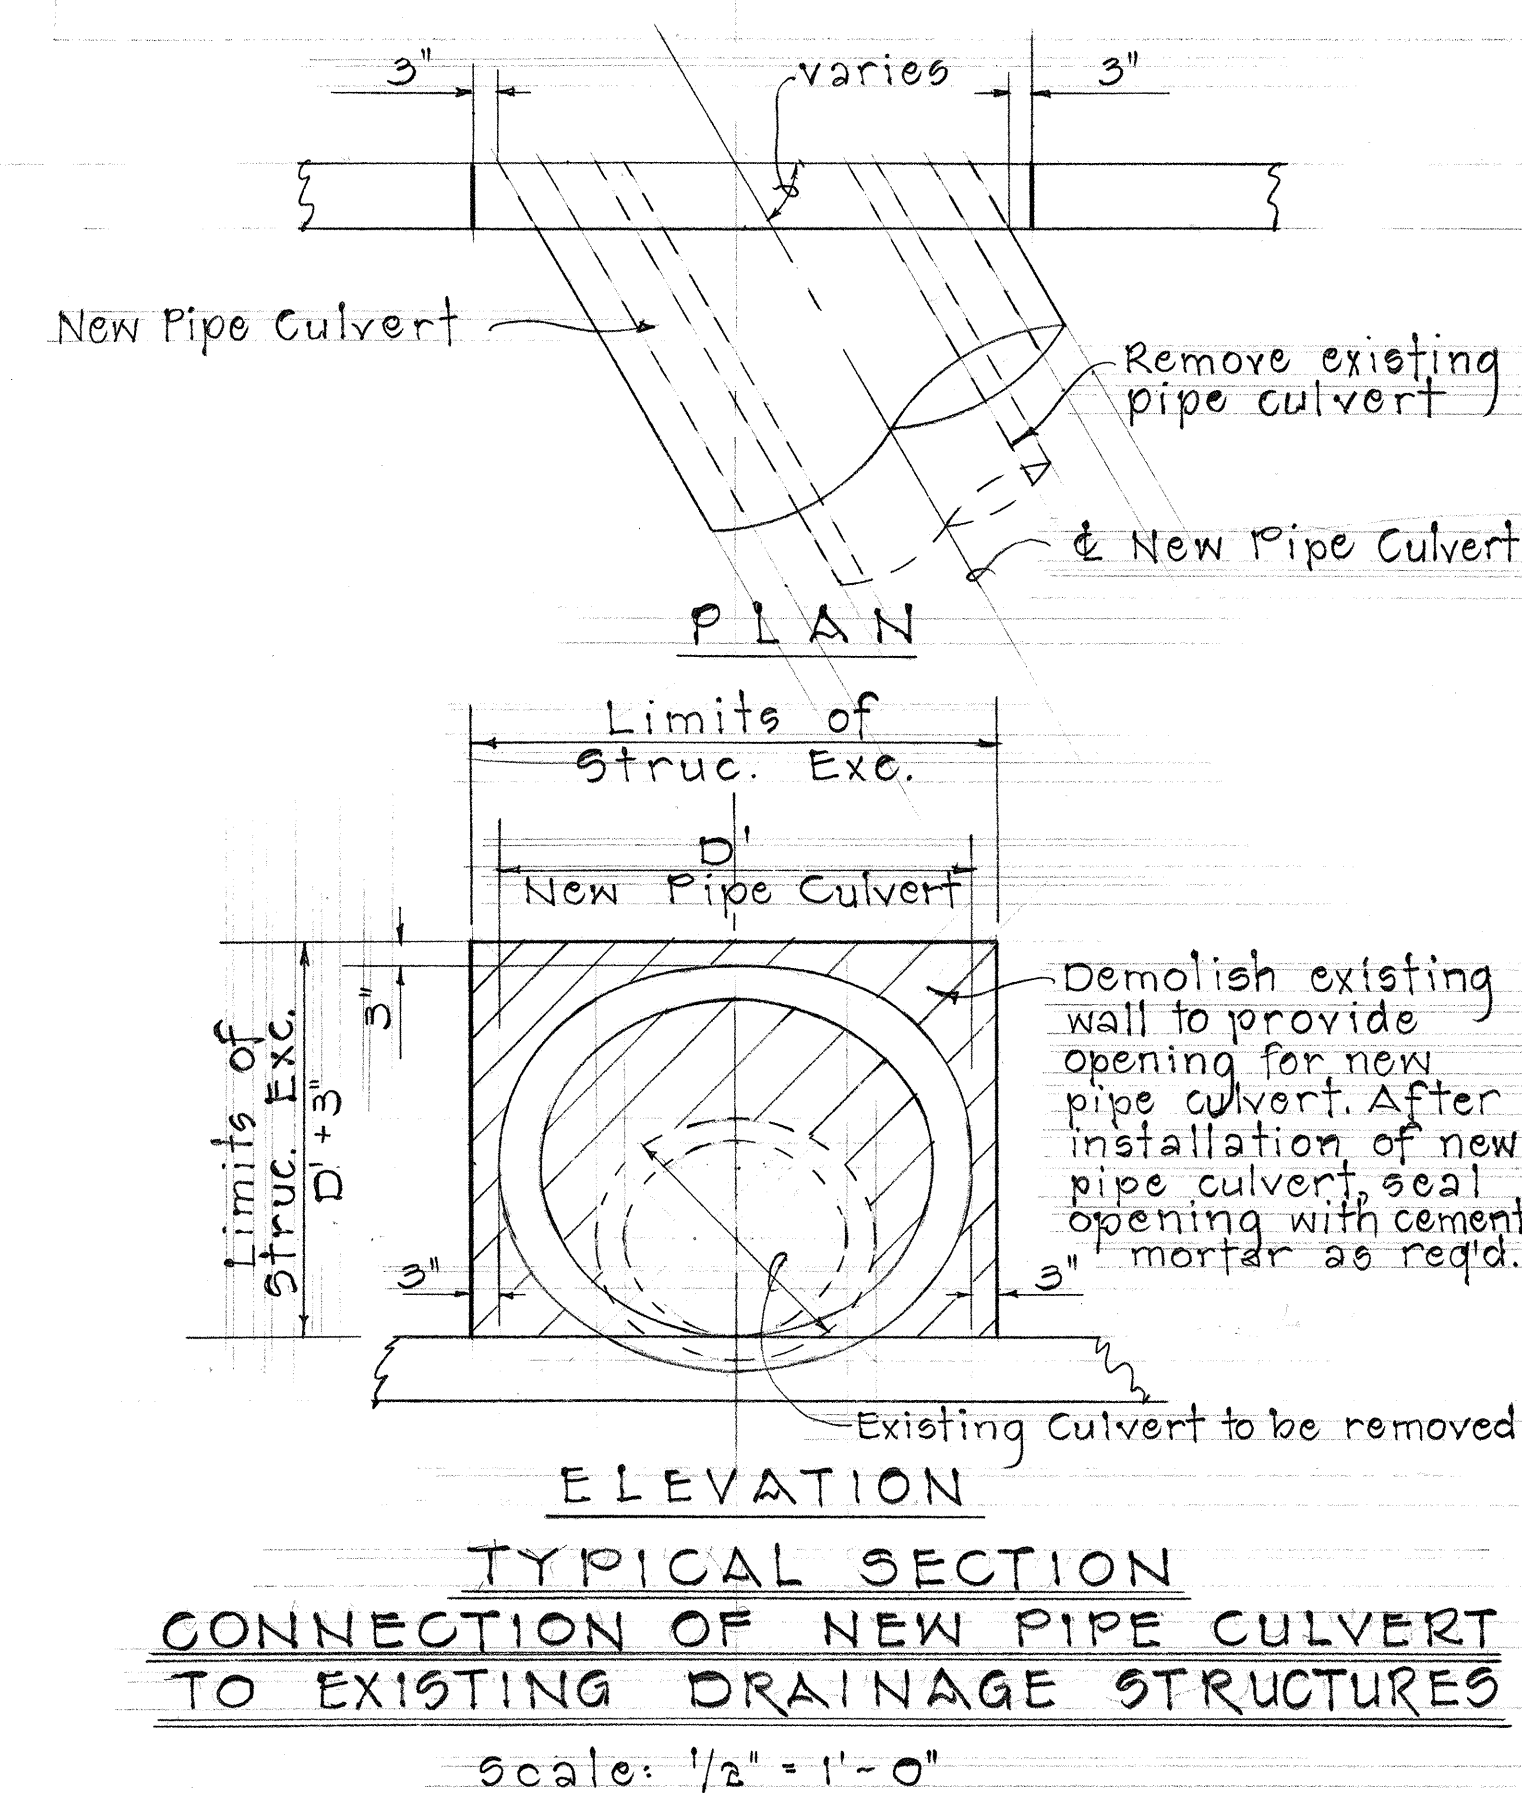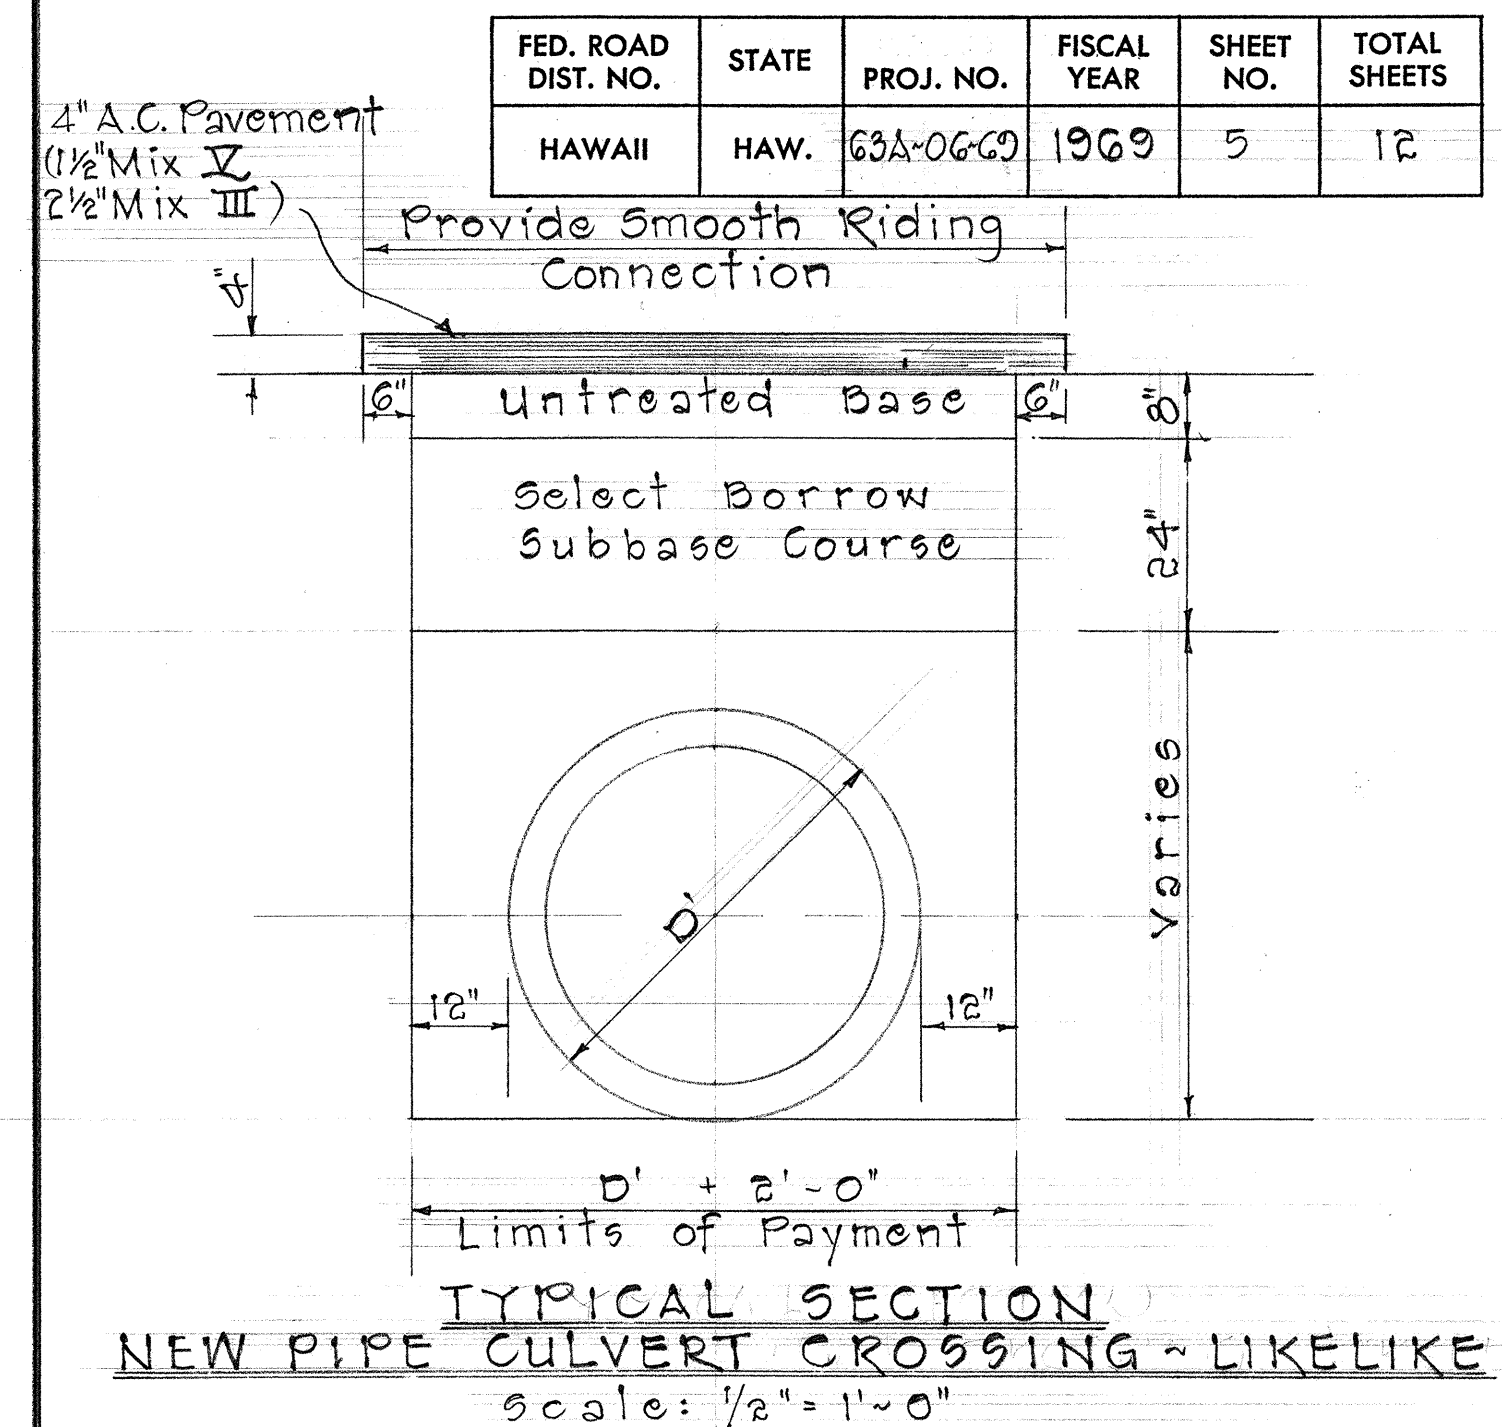




STATE OF HAWAII
DEPARTMENT OF TRANSPORTATION
HIGHWAYS DIVISION

DRAINAGE DETAILS




LIKELIKE HIGHWAY
PROJ. NO. G3A-06-60

Scale: 1/2" = 1'-0" Date: Oct. 1968
SHEET No. 5 OF 12 SHEETS

FED. ROAD DIST. NO.	STATE	PROJ. NO.	FISCAL YEAR	SHEET NO.	TOTAL SHEETS
HAWAII	HAW.	63A-06-69	1969	6	12

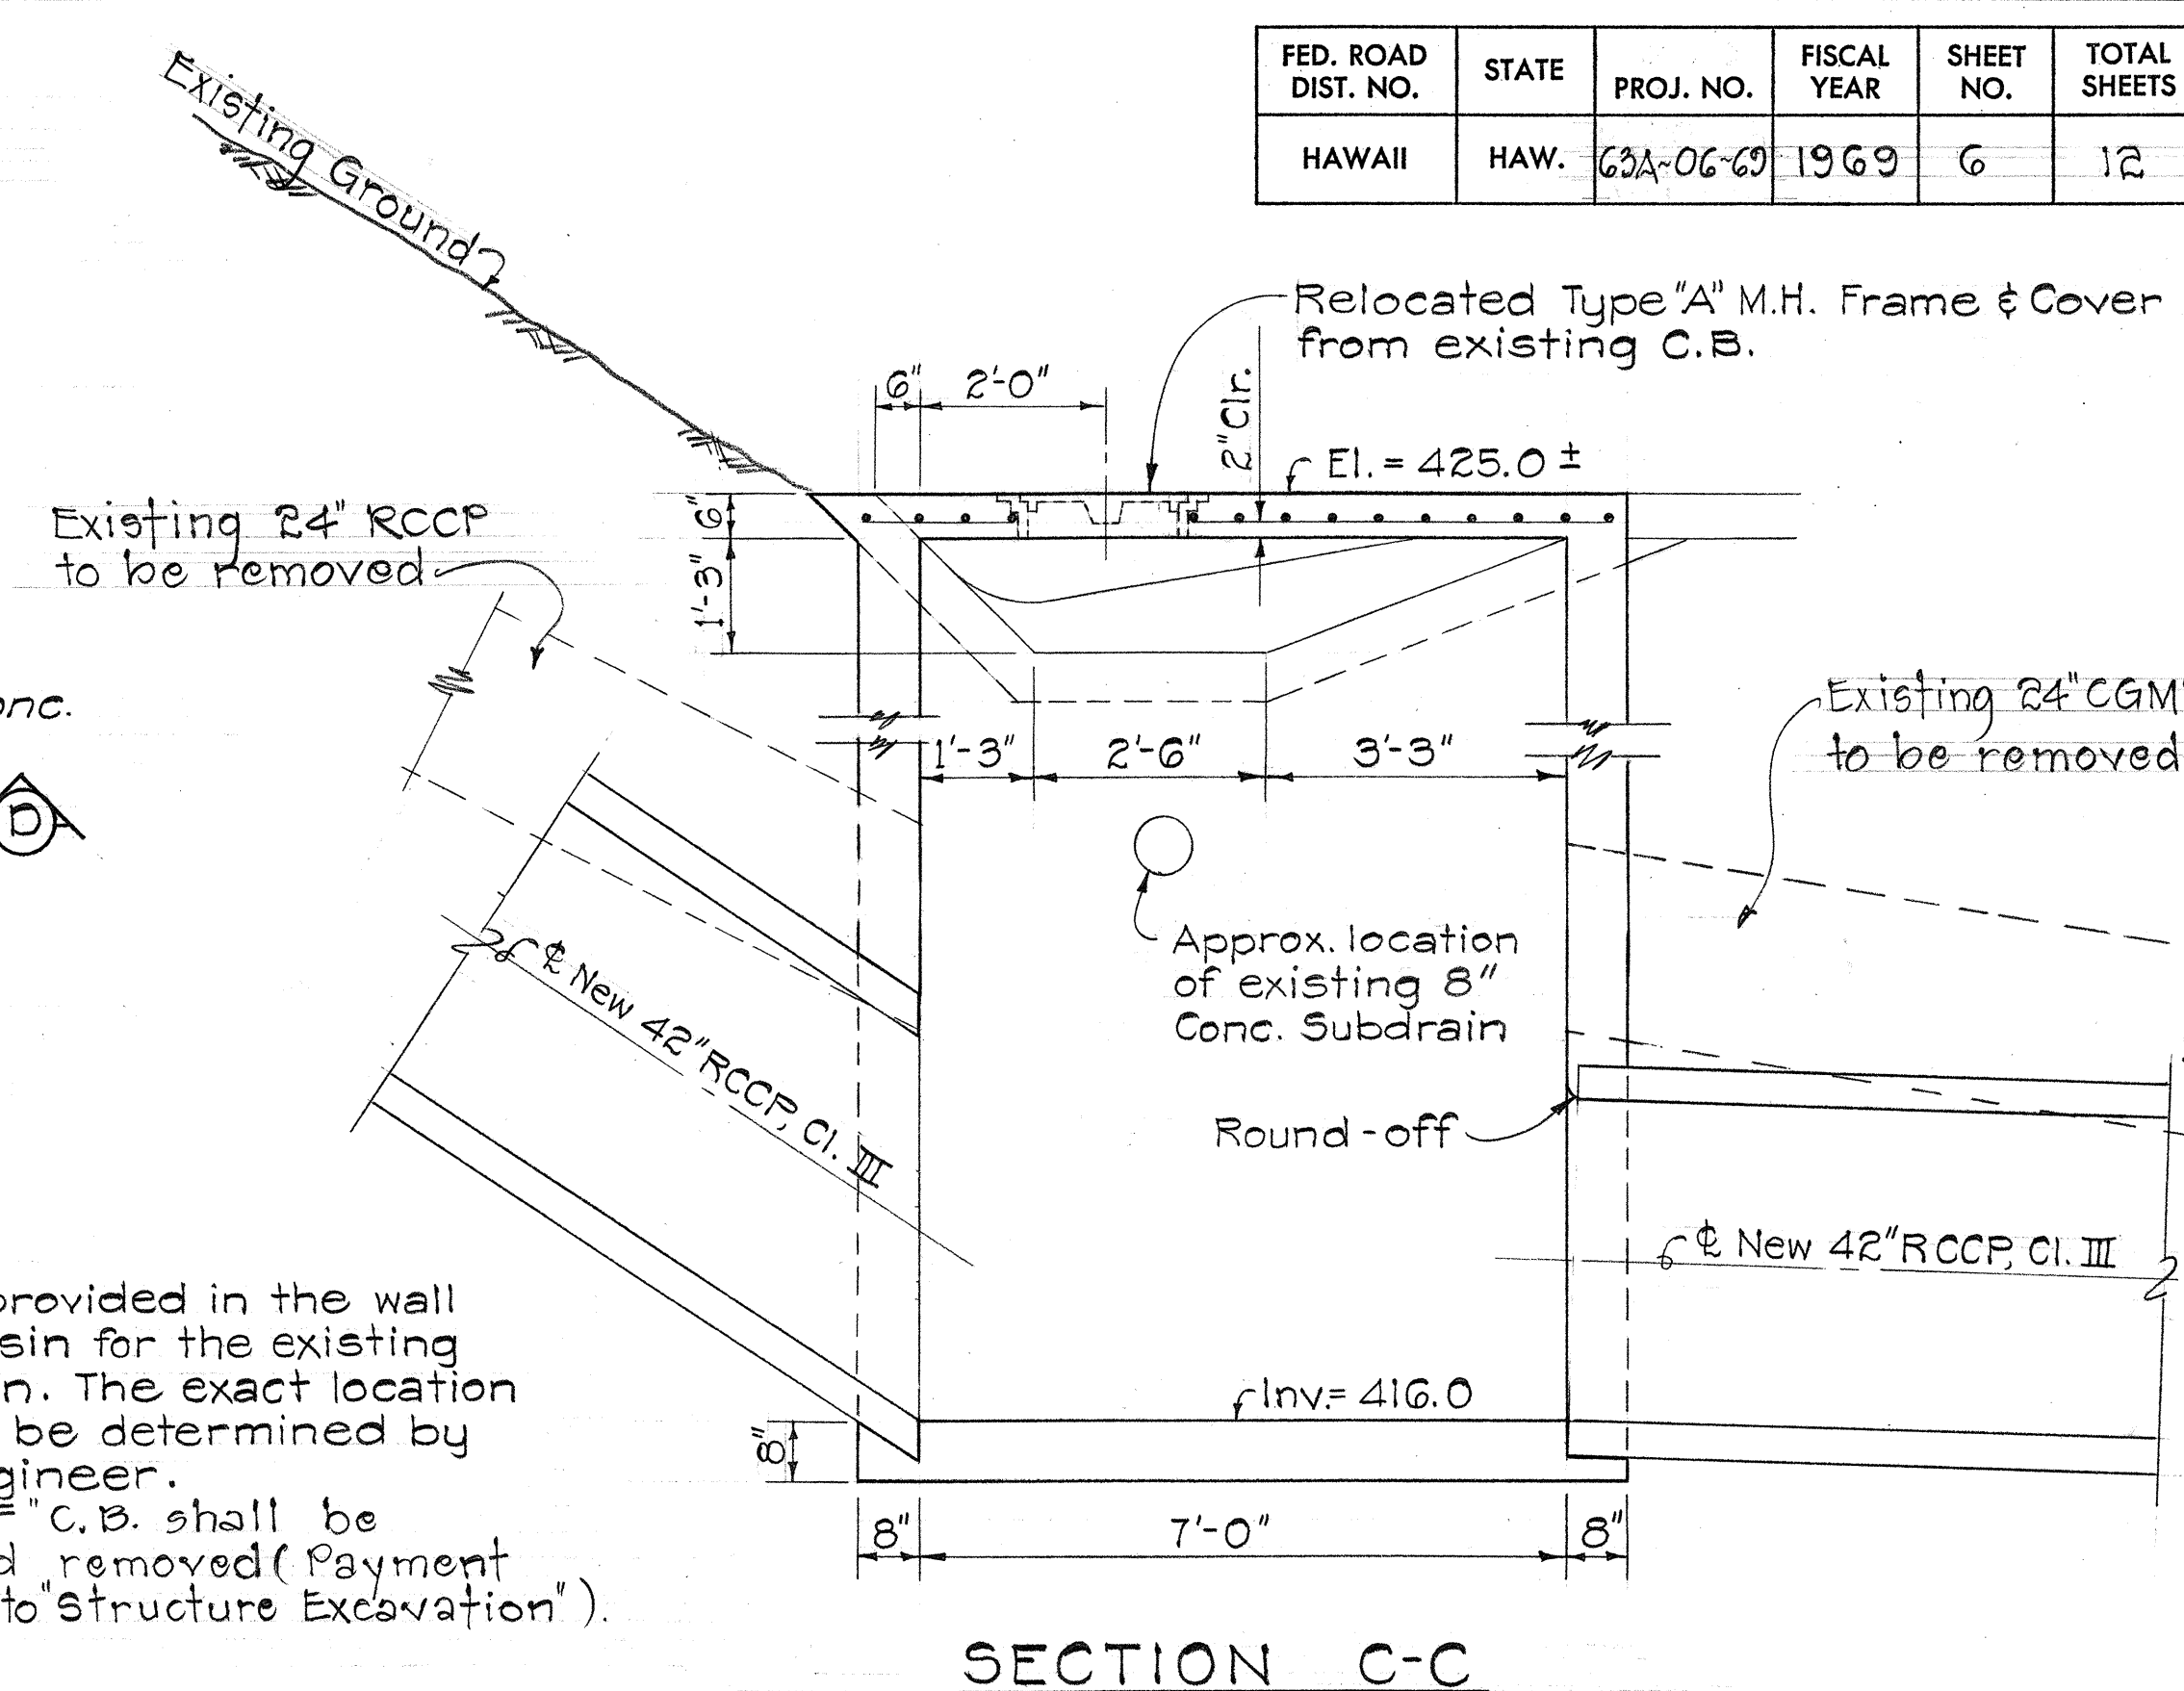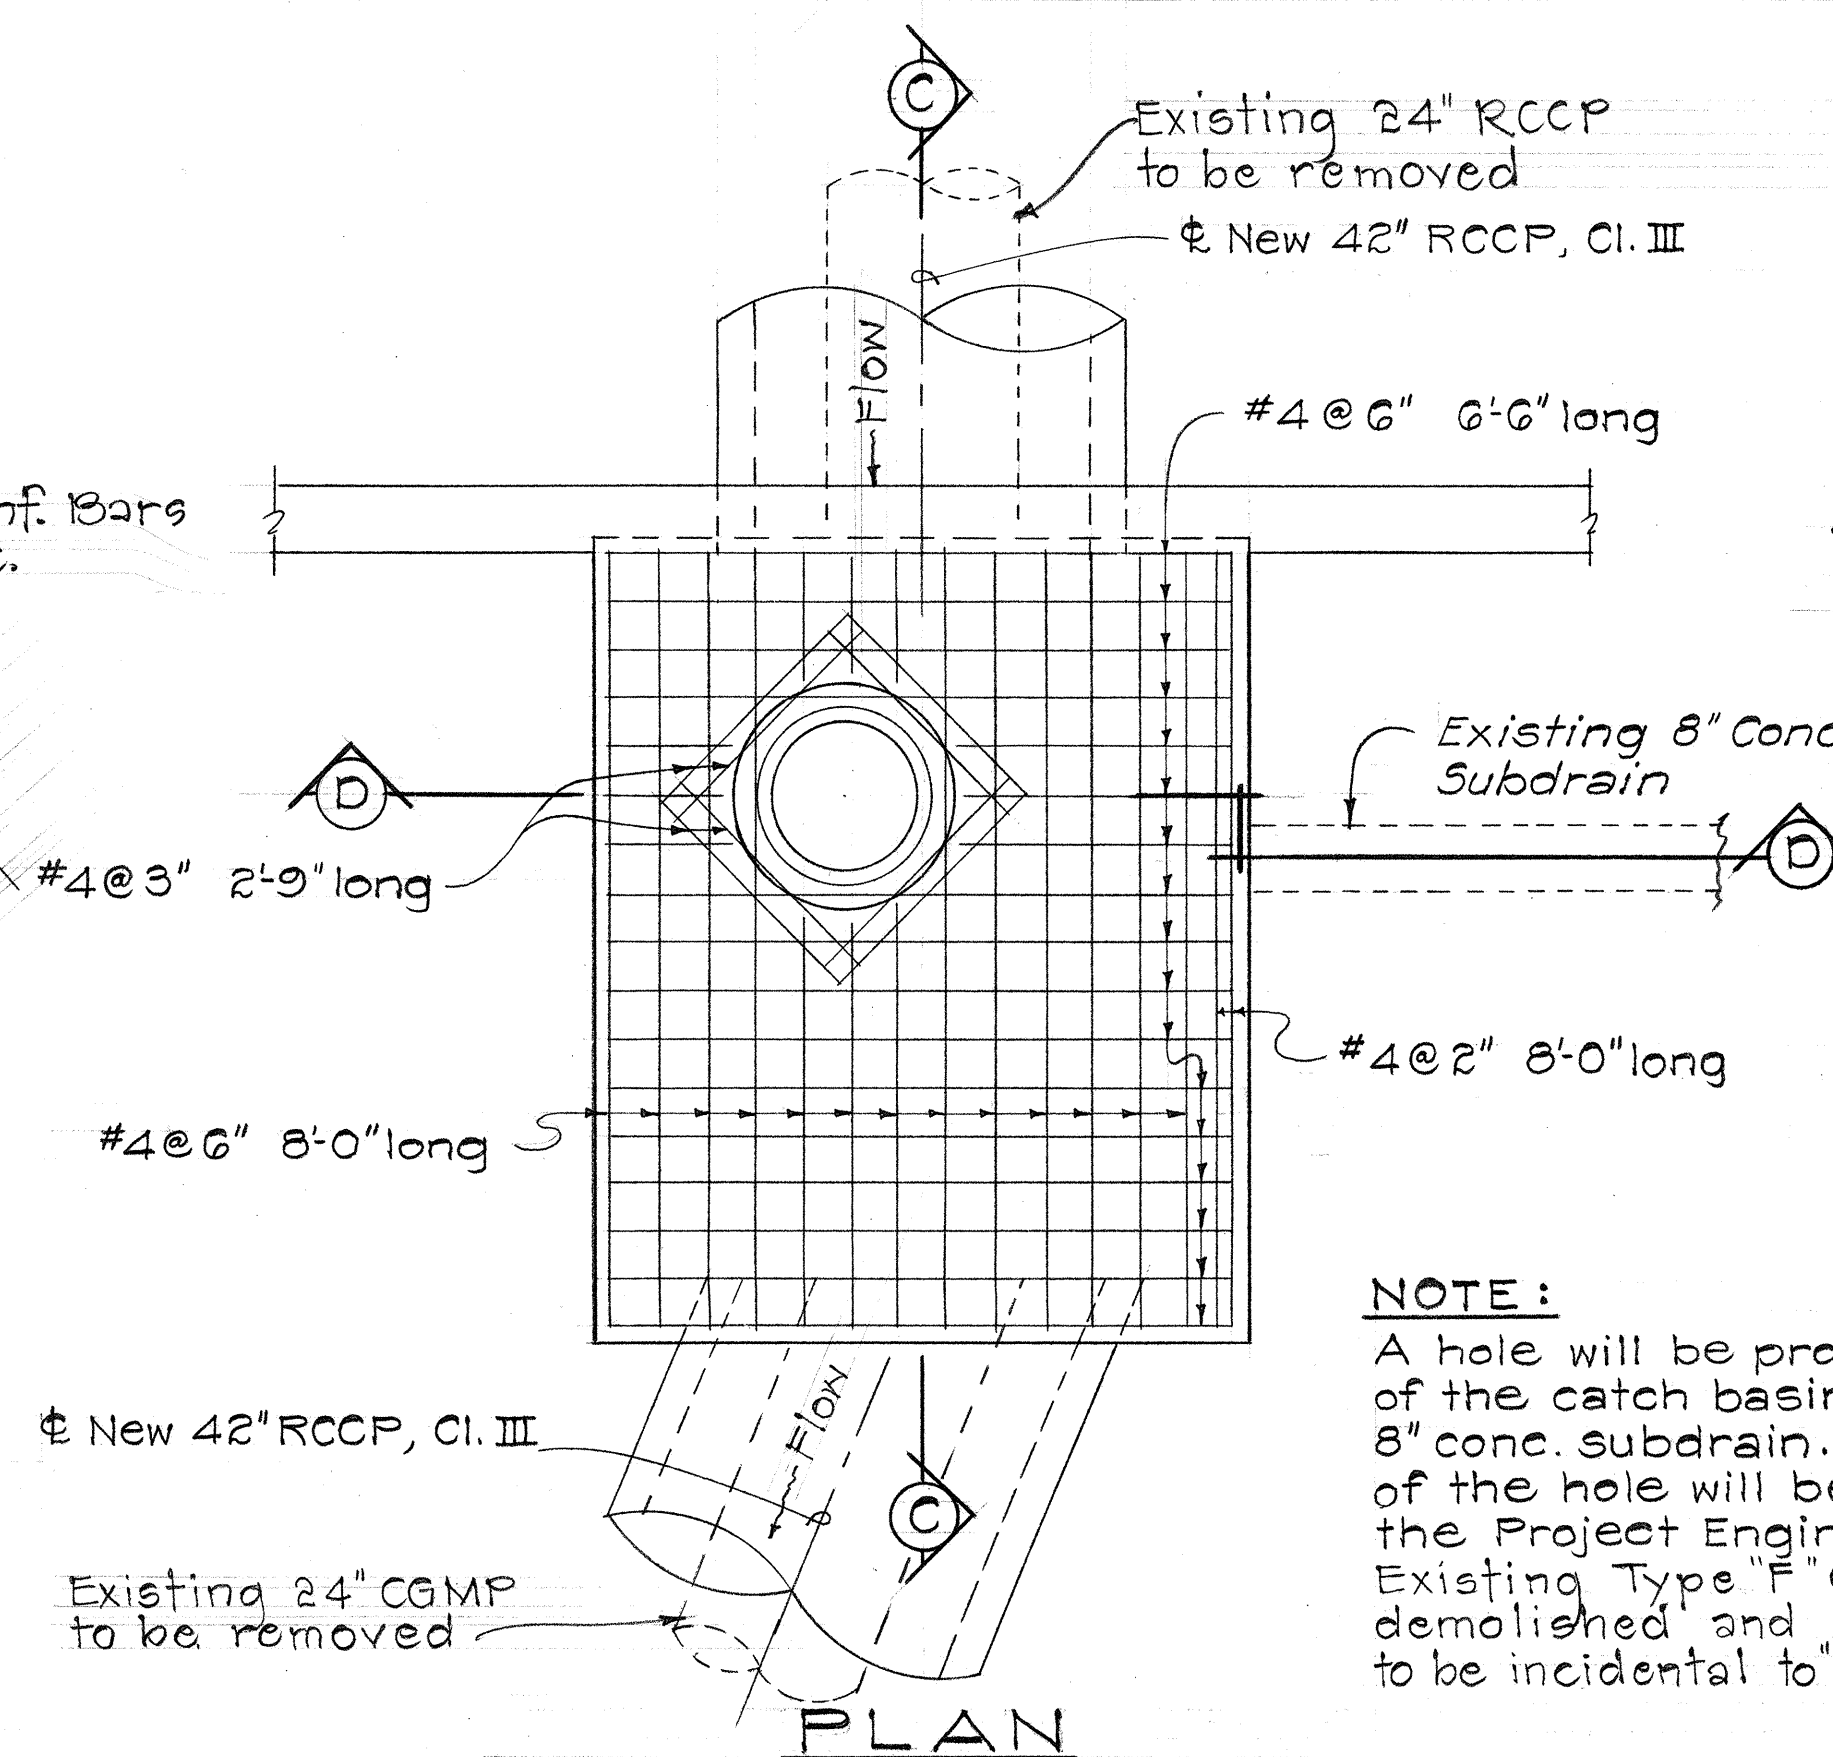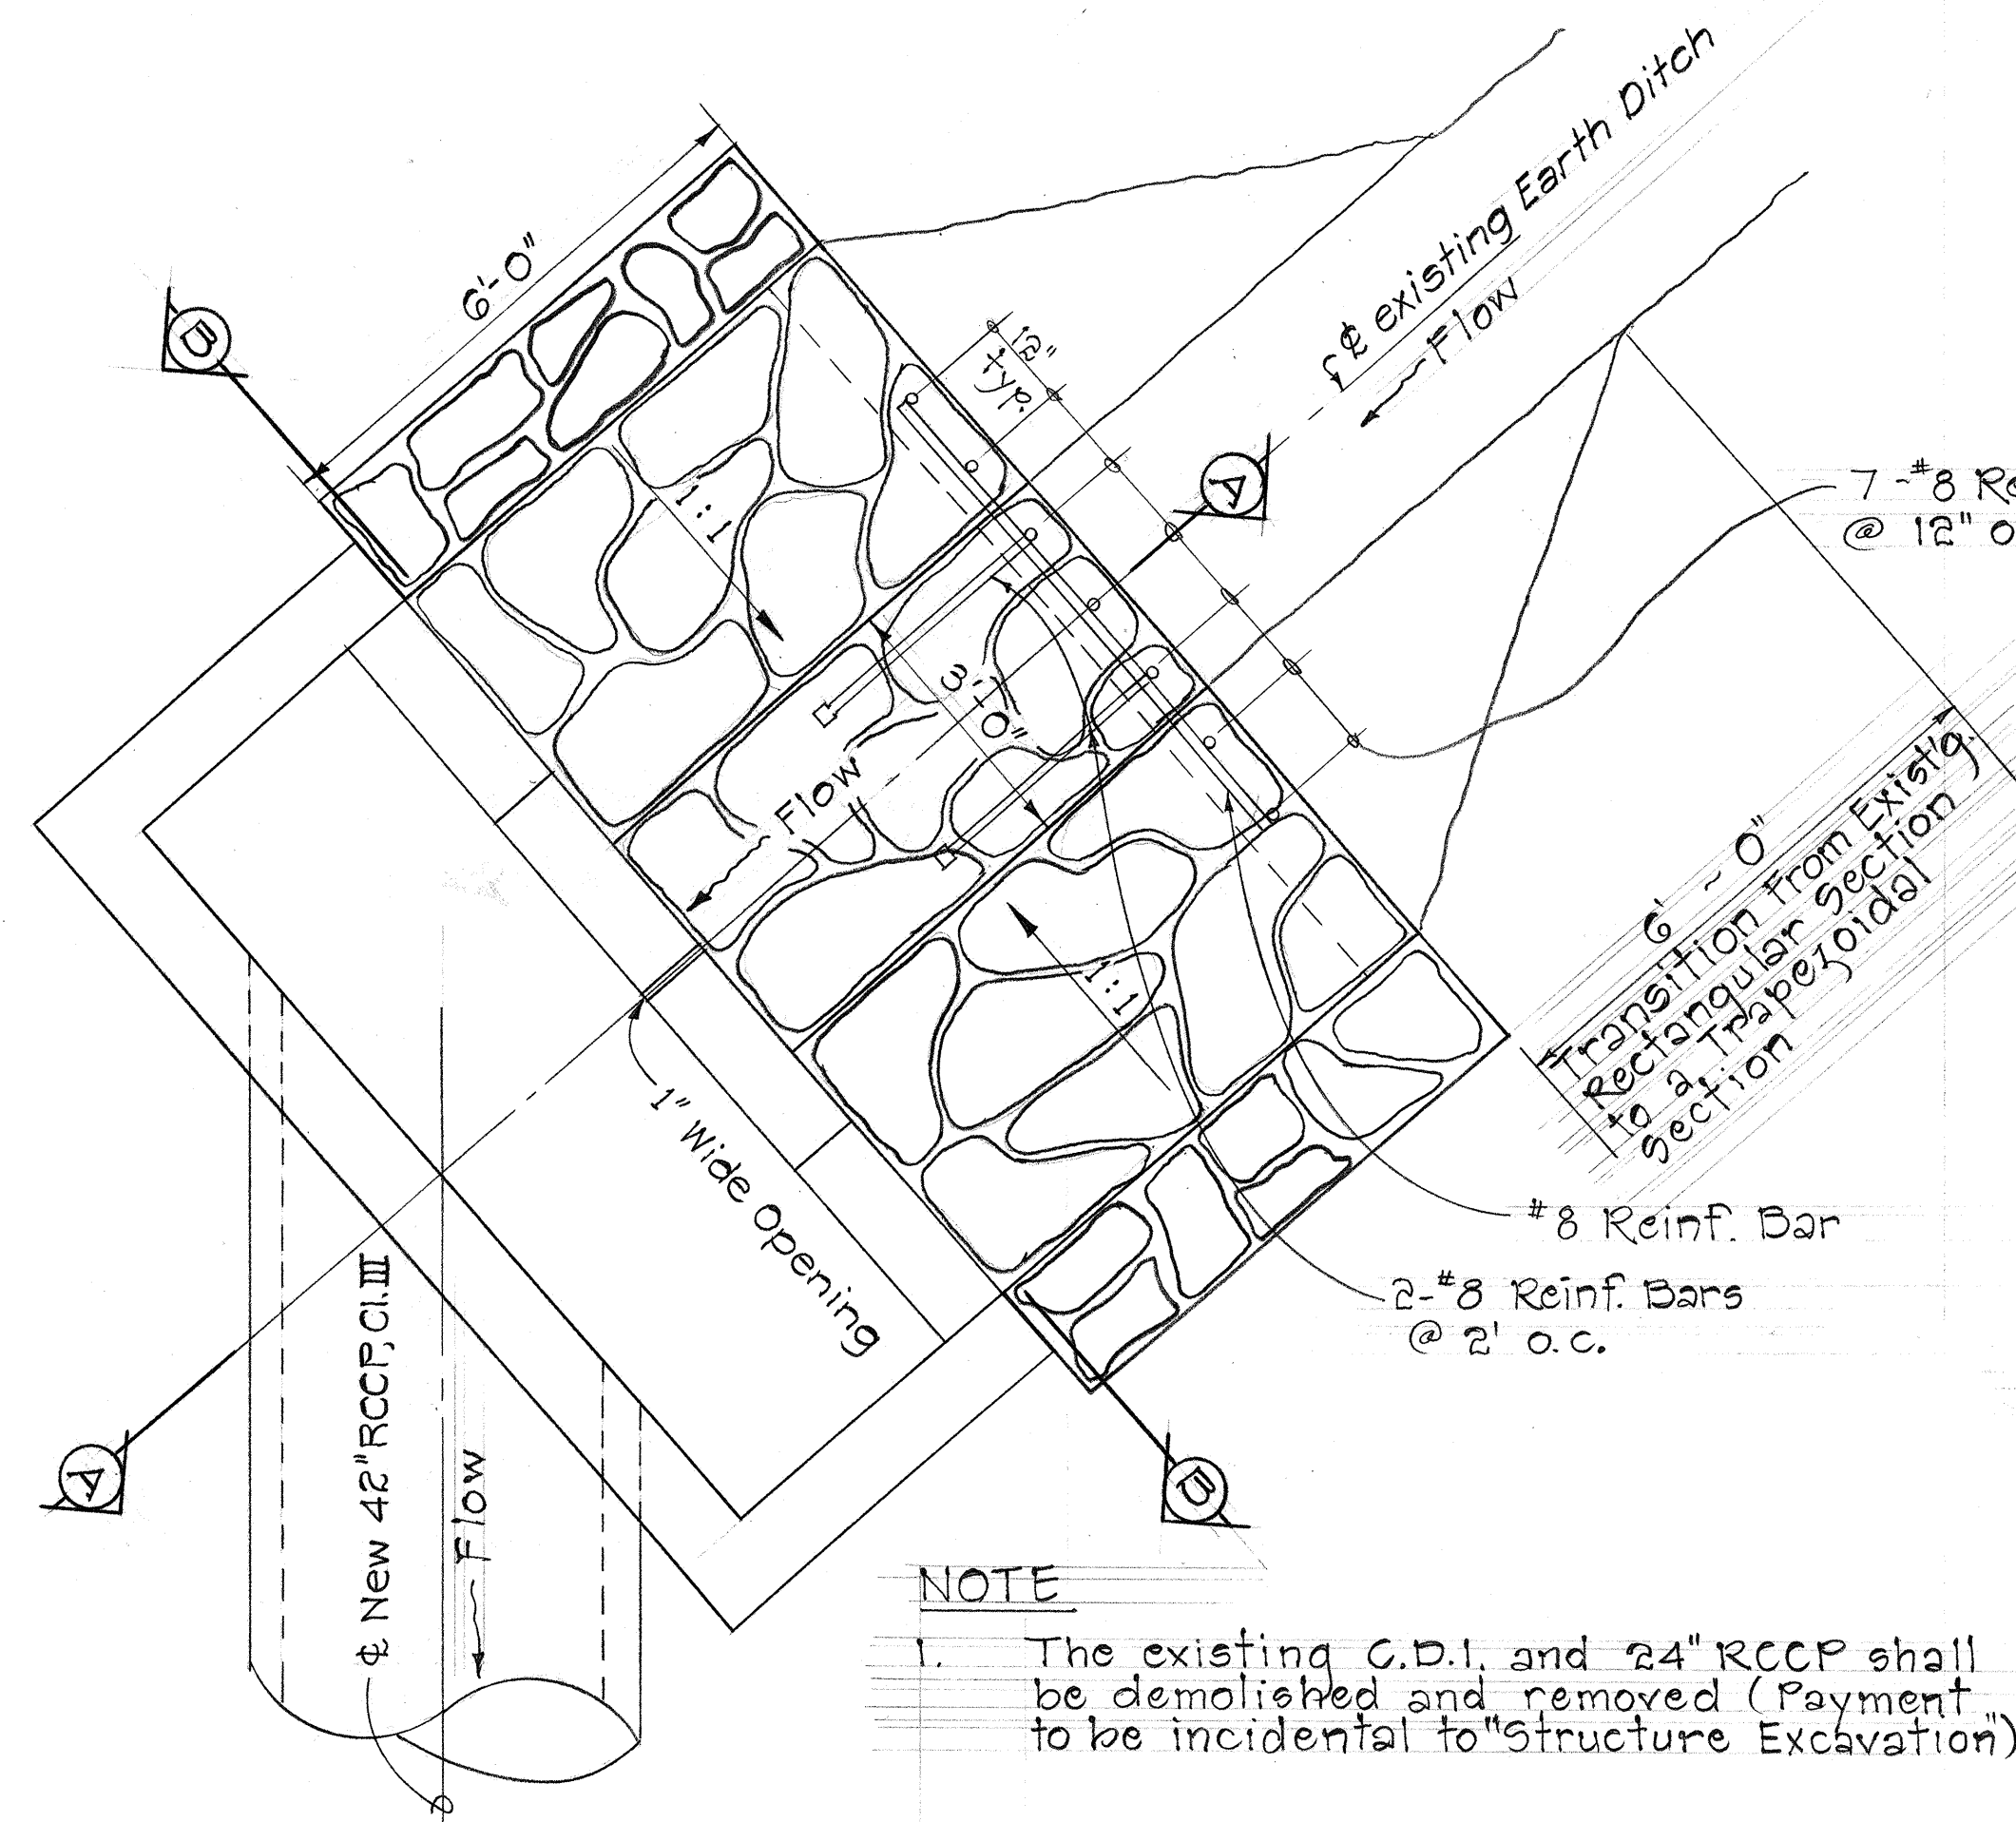

NEW TYPE "F" CATCH BASIN STA. 88+00, 45' 9/16 LT.
Scale: 1/2" = 1'-0"

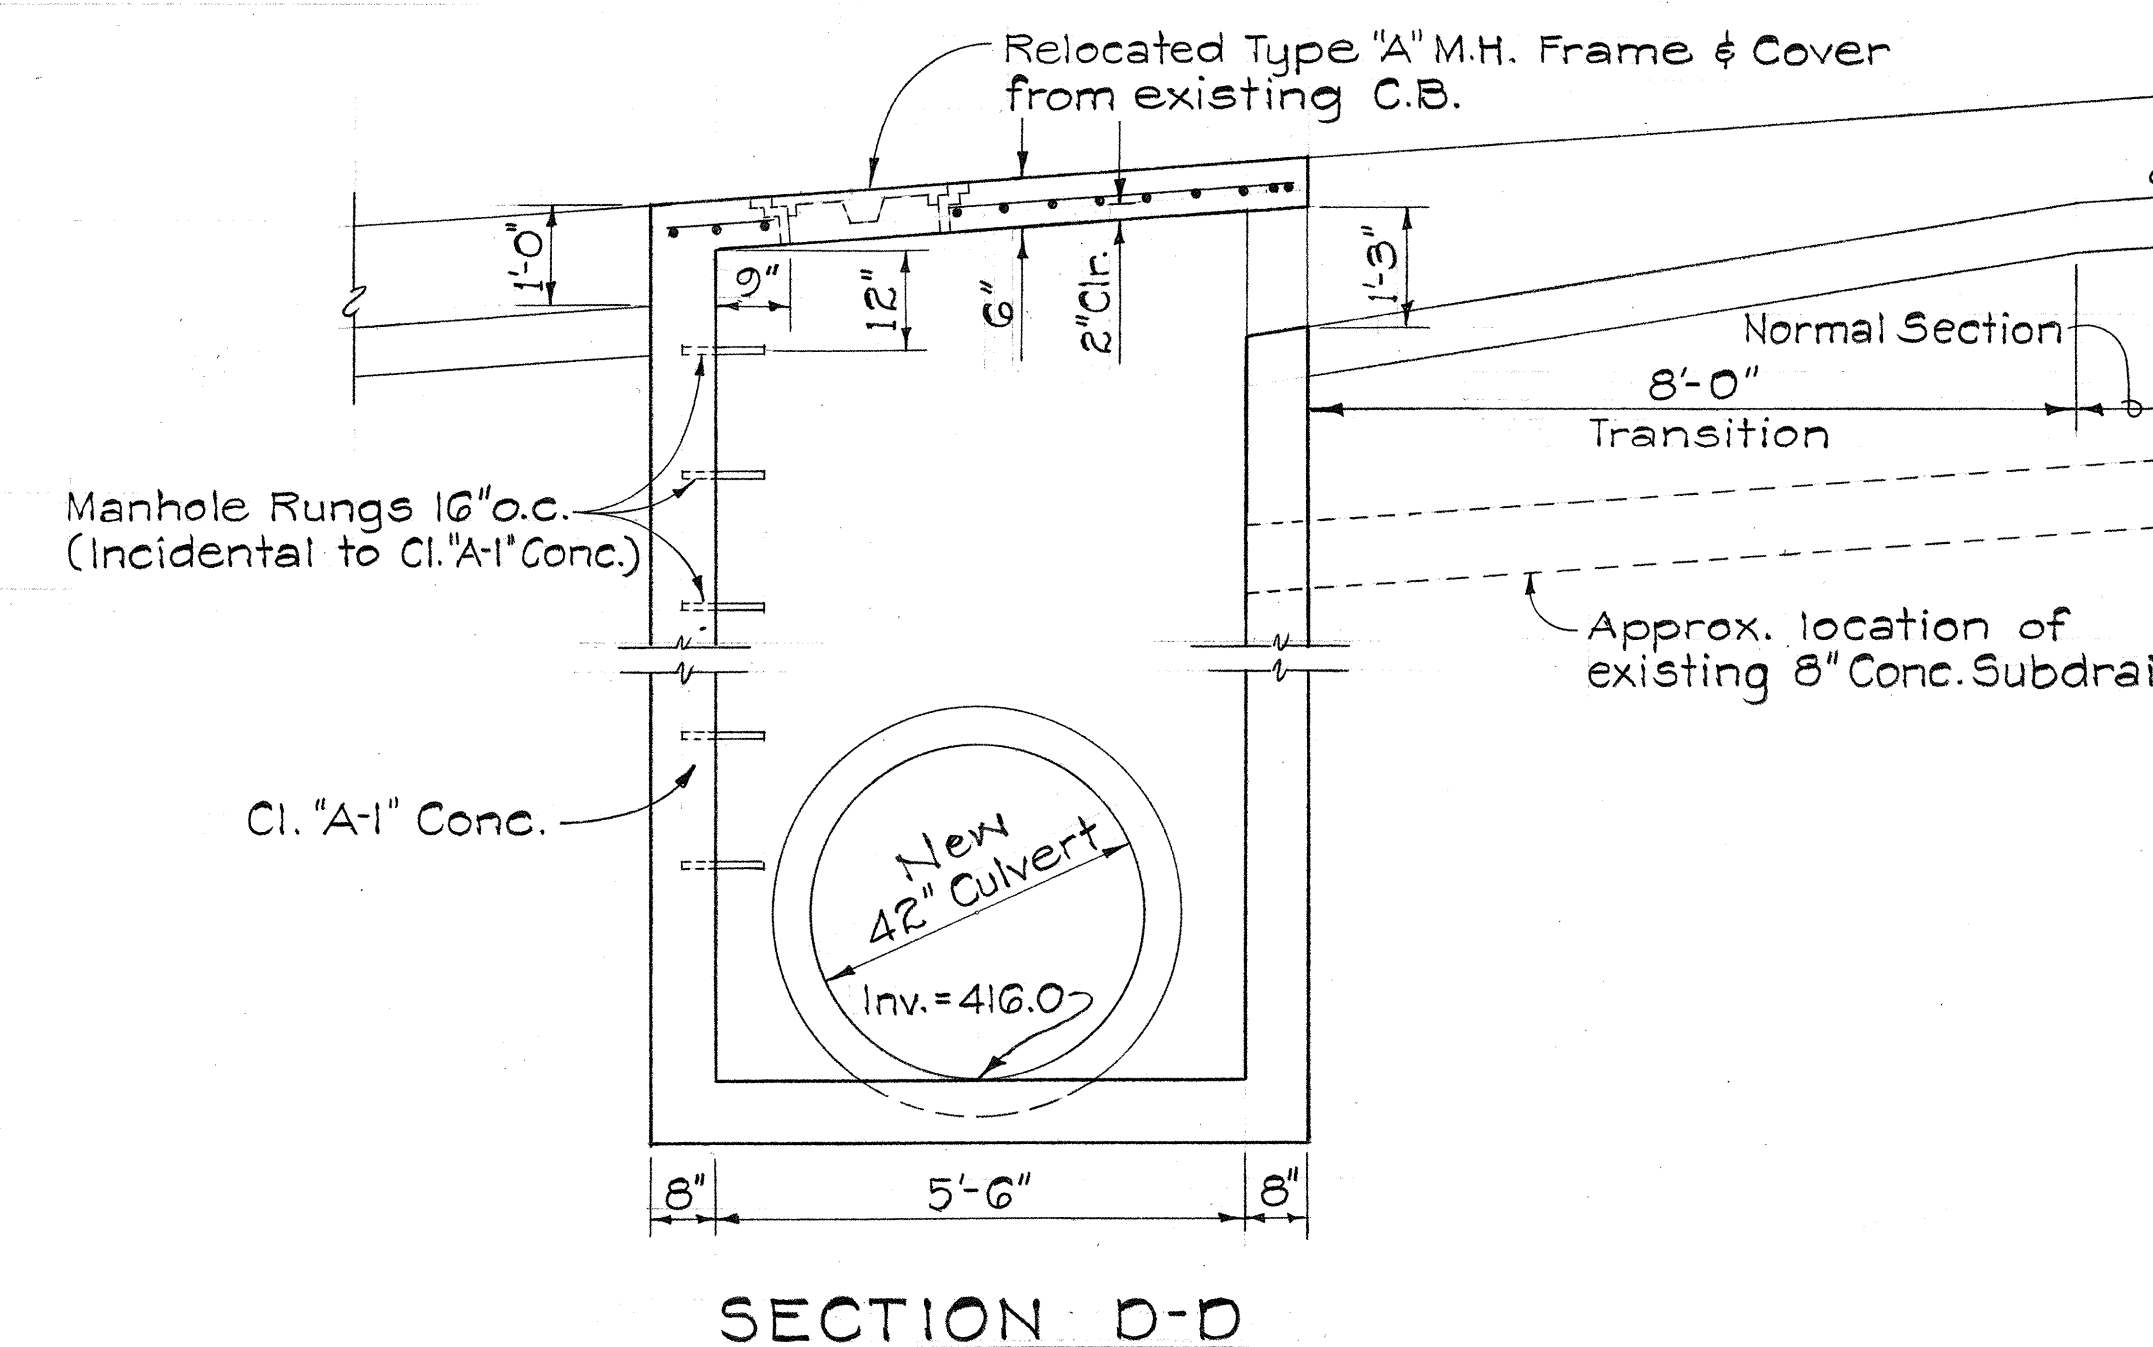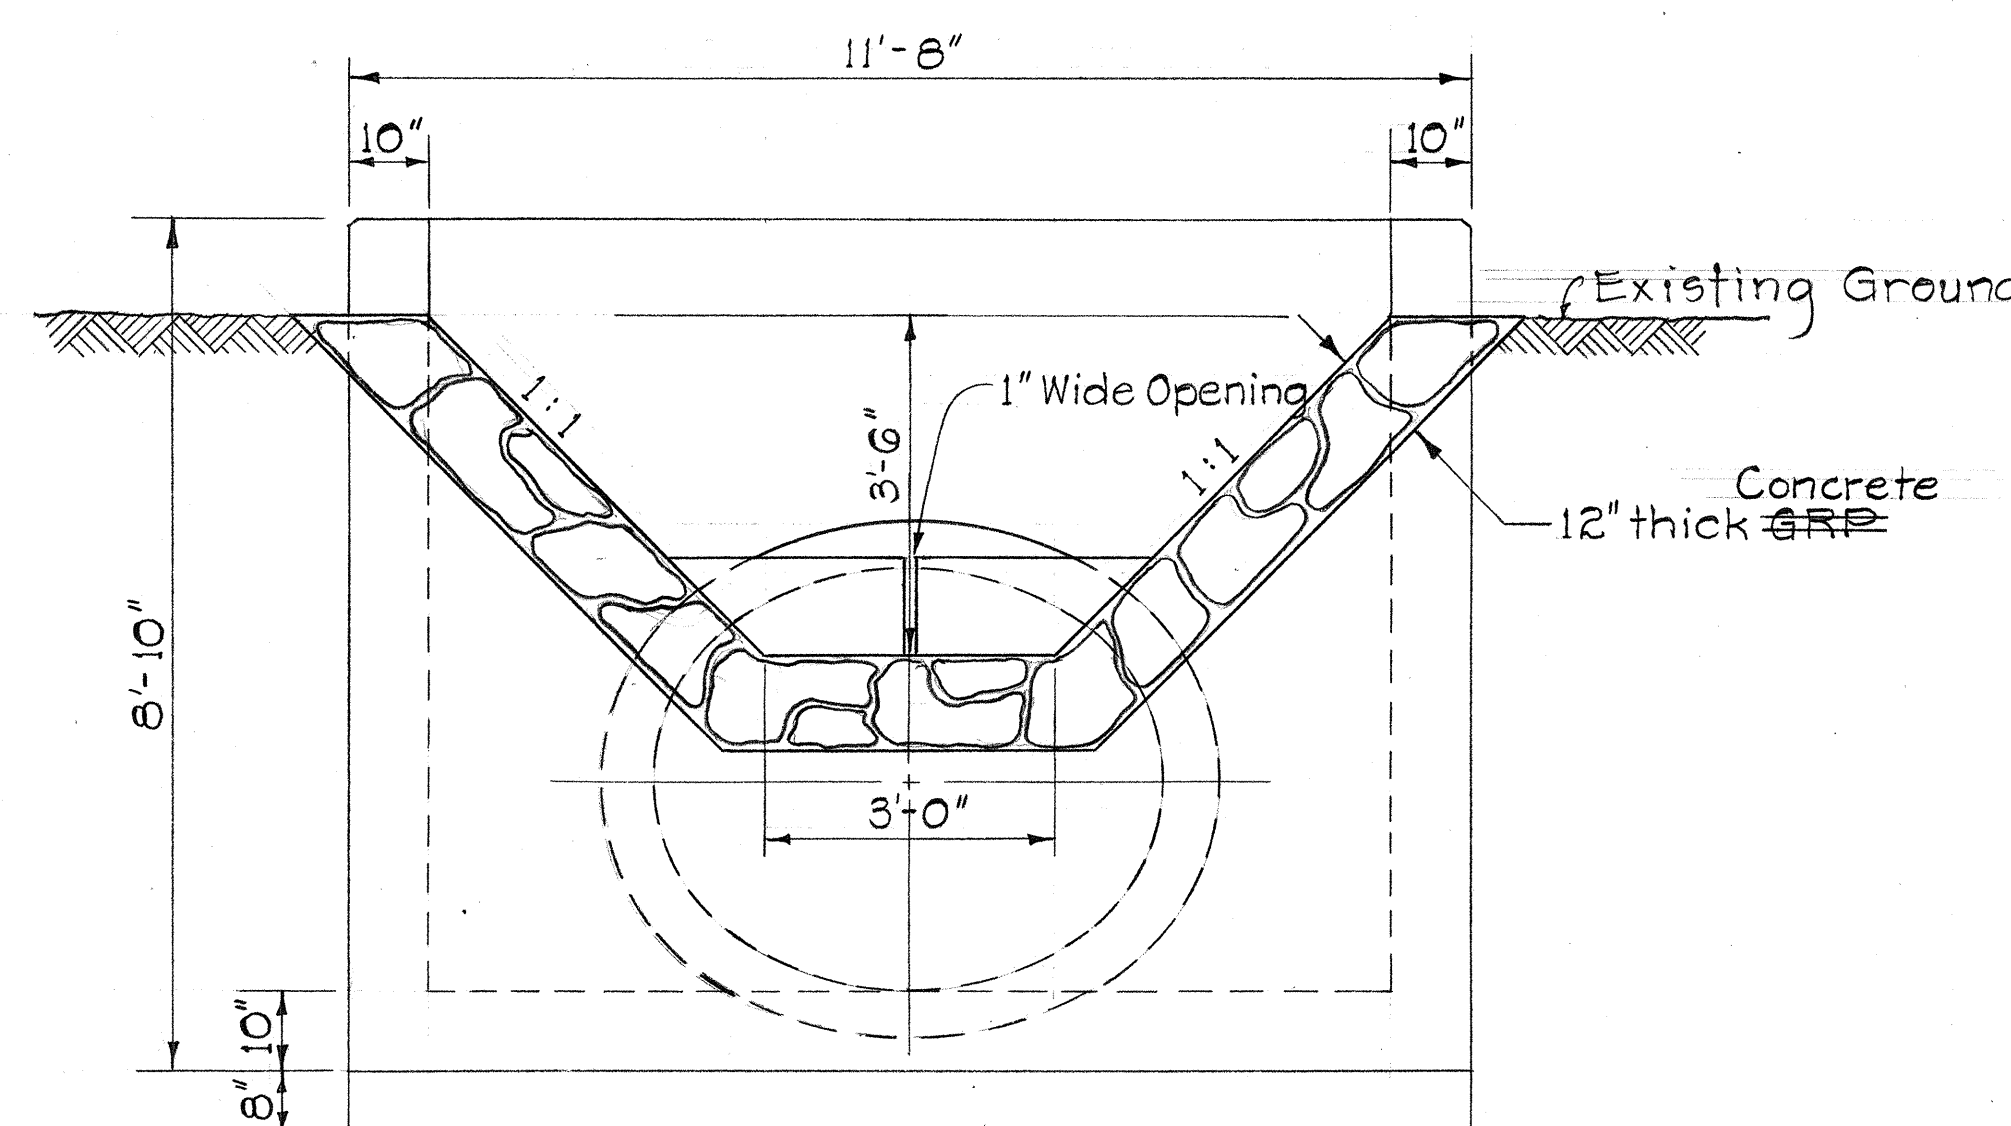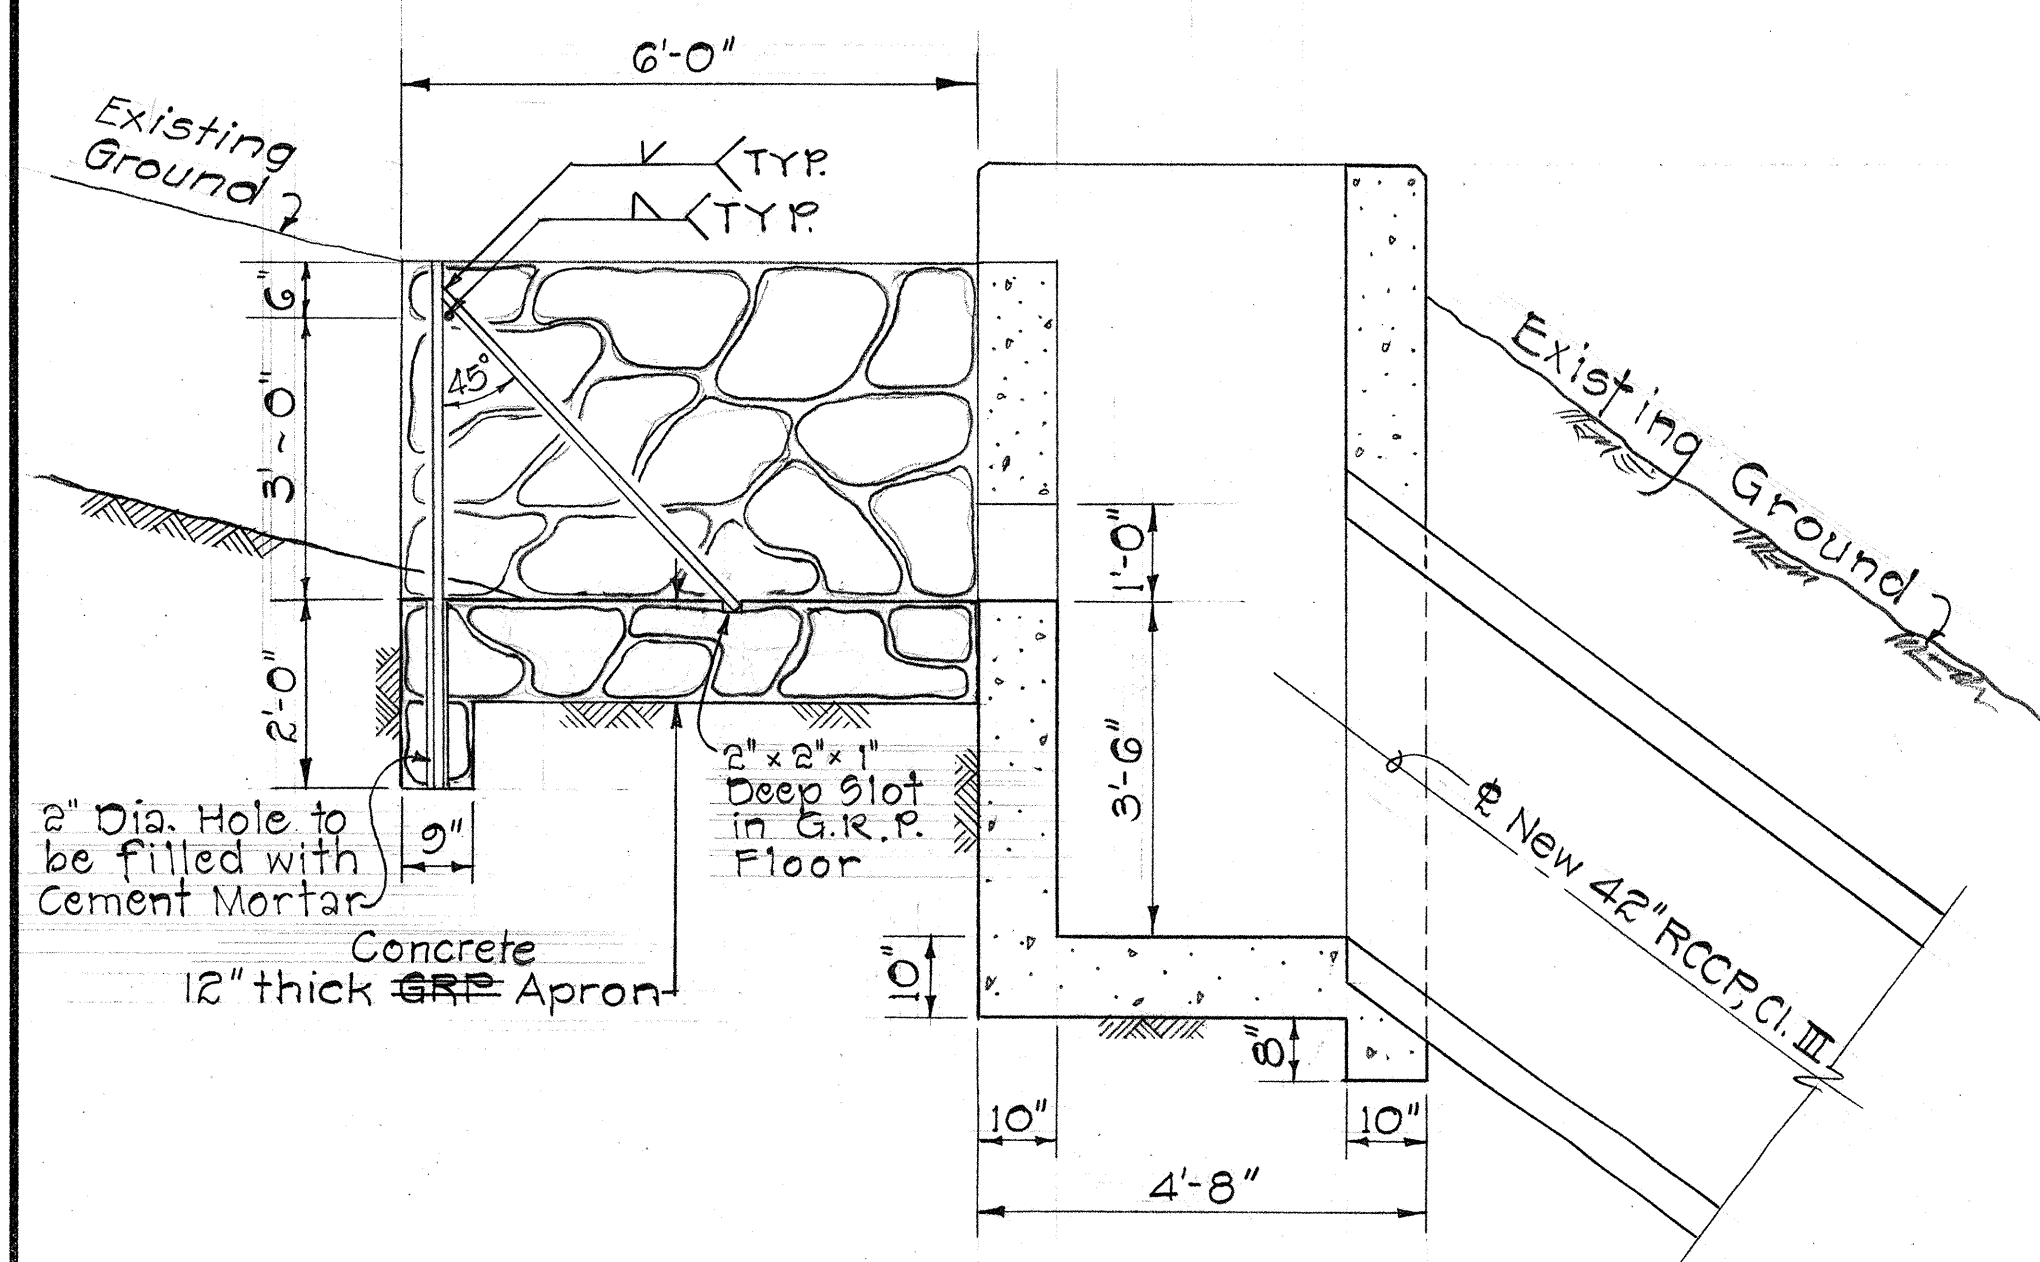

CONC. DROP INTAKE WITH GRP APRON STA. 88+00, 80' 9/16 LT.
Scale: 1/2" = 1'-0"

STATE OF HAWAII
DEPARTMENT OF TRANSPORTATION
HIGHWAYS DIVISION
DRAINAGE DETAILS
LIKELIKE HIGHWAY
PROJ. NO. 63A-06-69
Scale: 1/2" = 1'-0" Date: Oct. 1968
SHEET No. 6 OF 12 SHEETS

FED ROAD DIST. NO.	STATE	PROJ. NO.	FISCAL YEAR	SHEET NO	TOTAL SHEETS
HAWAII	HAW.	G3A-06-69	1969	7	12

Revised: June 1965
Revised: August 1967

DATA FOR OUTLET DITCH			
D	W	H	T=H+H
18"	24"	2'-0"	4'-0"
24"	30"	2'-0"	4'-6"
30"	30"	2'-6"	5'-0"
36"	36"	3'-0"	6'-0"

DETAIL OF OUTLET DITCH


Scale: 1/2" = 1' - 0"

DATA FOR MASONRY DROP INTAKE				Where Variables Equal
D	D	L=D+G	Cu. Yds.	Cu. Yds.
23"	18"	2'-5"	3.02	4'-6"
30"	24"	3'-0"	3.61	5'-0"
37"	30"	3'-7"	4.21	5'-6"
44"	36"	4'-2"	4.85	6'-0"


NOTE:

Dimension "X" is assumed as 2'-4" in figuring the above quantities.

DATA - MASONRY HEADWALL		CRM For RCCP	CRM For CGMP
D	H	Cu. Yds.	Cu. Yds.
18"	4'-6"	1.24	1.29
24"	5'-0"	1.83	1.92
30"	5'-6"	2.56	2.70
36"	6'-0"	3.45	3.66

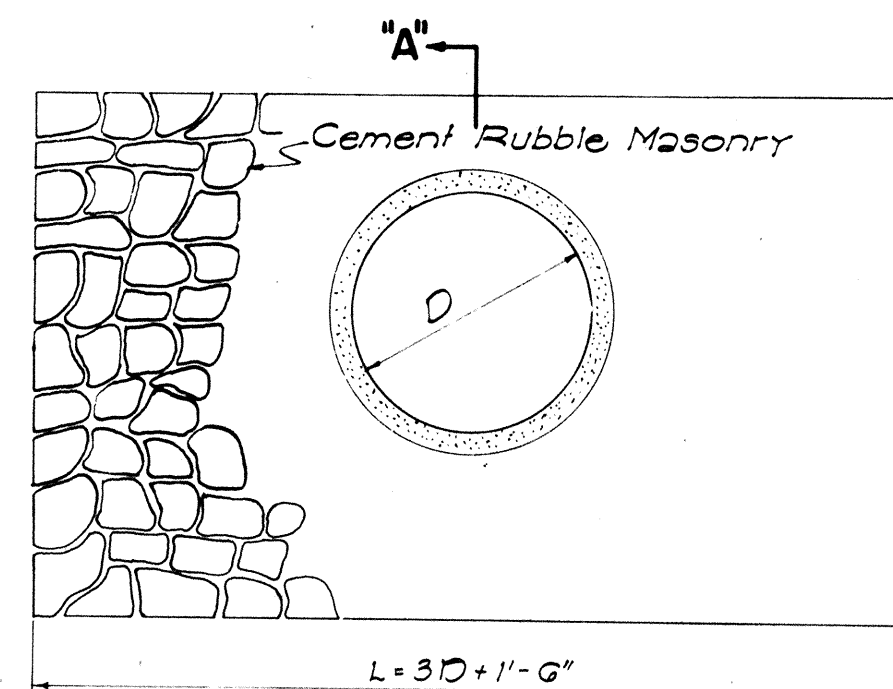


ELEVATION

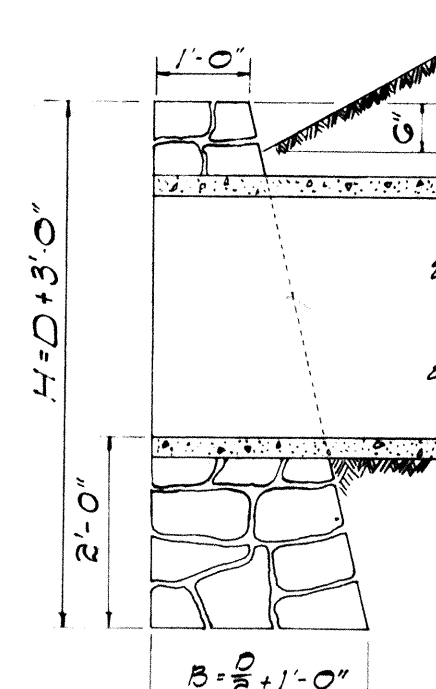

SECTION "A-A"

DETAIL OF MASONRY HEADWALL

Scale: 1/2" = 1' - 0"

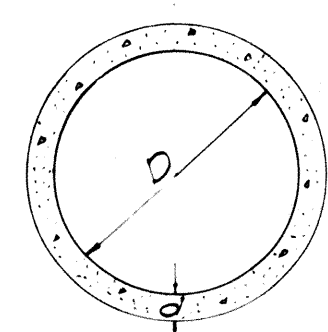


SECTION

CONC. PIPE CULVERT



NOTE:

Thickness 'd', reinforcing, and concrete used, are to conform with the approved design as provided by the Specifications.

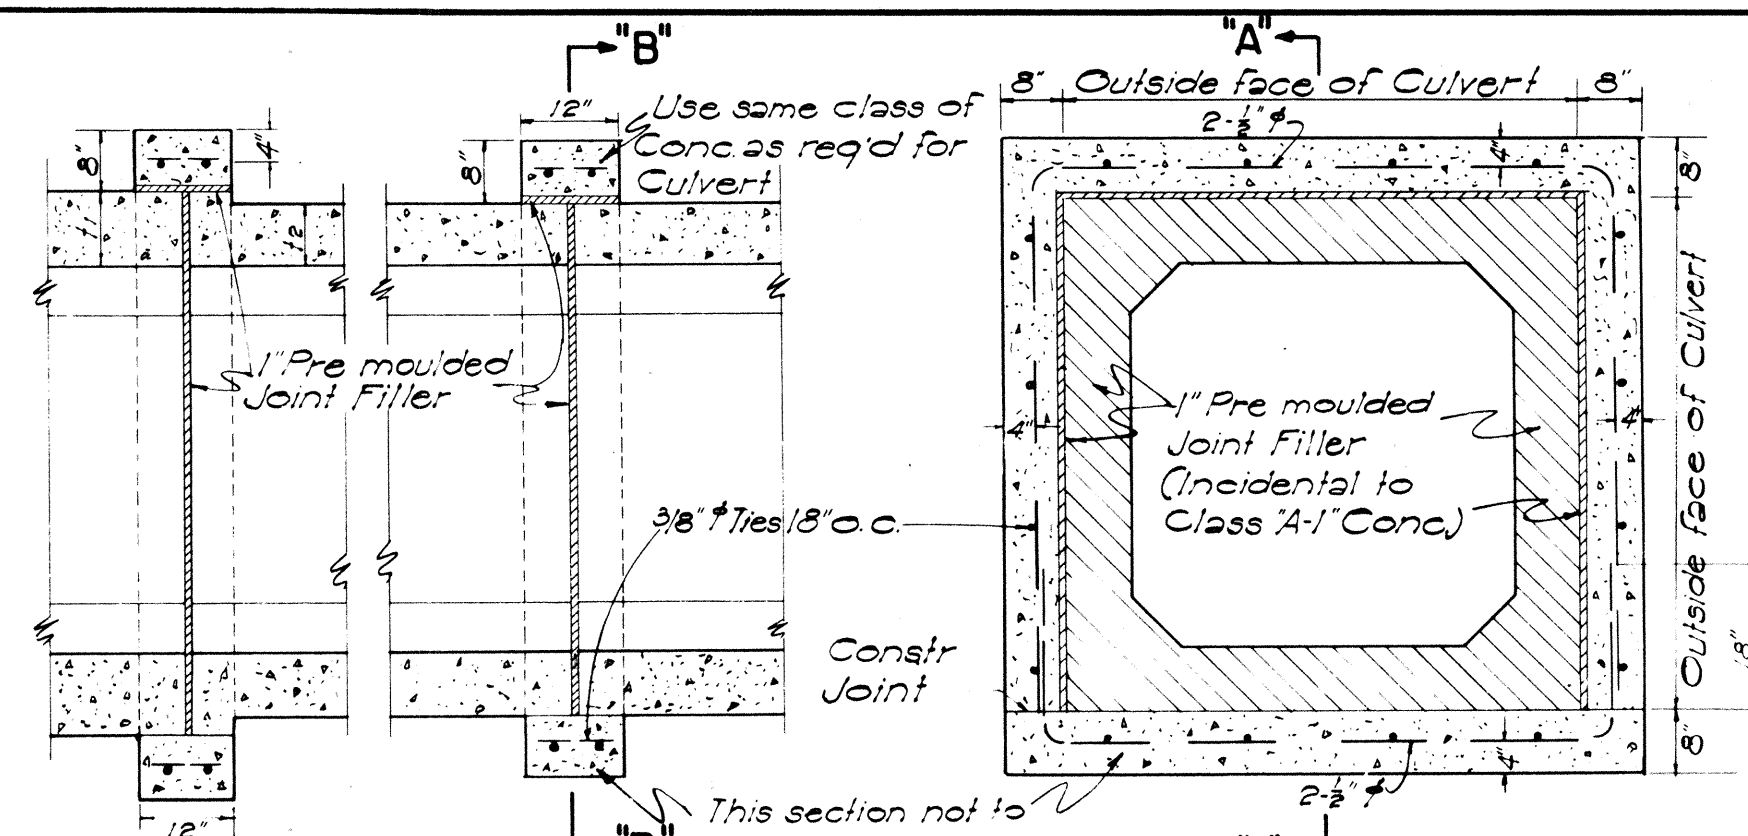


SECTION "A-A" SECTION "B-B" CONC. COLLAR FOR CONC. BOX CULVERT

Scale: 1/2" = 1' - 0"

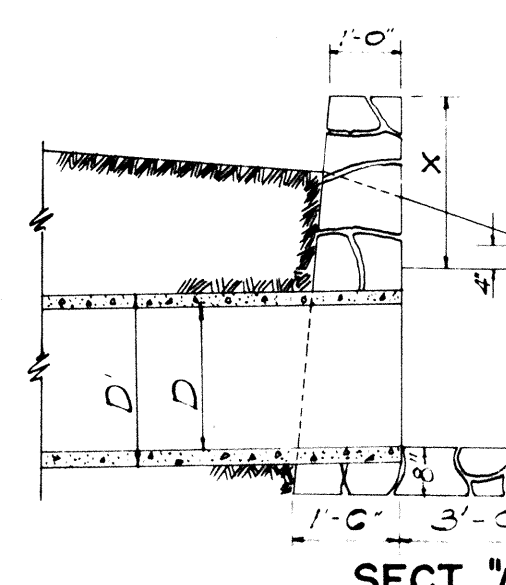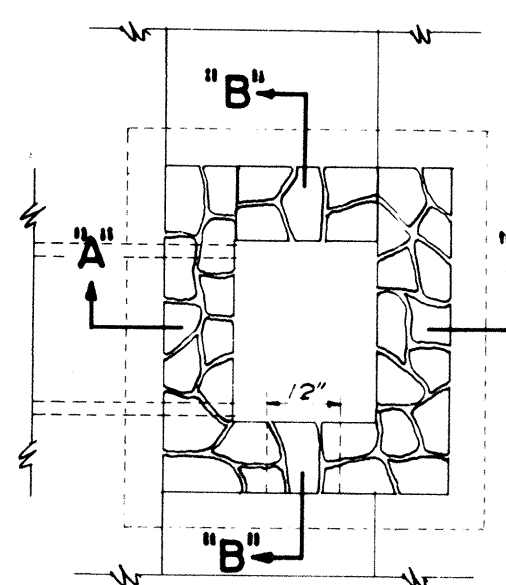


SECT. "A-A"

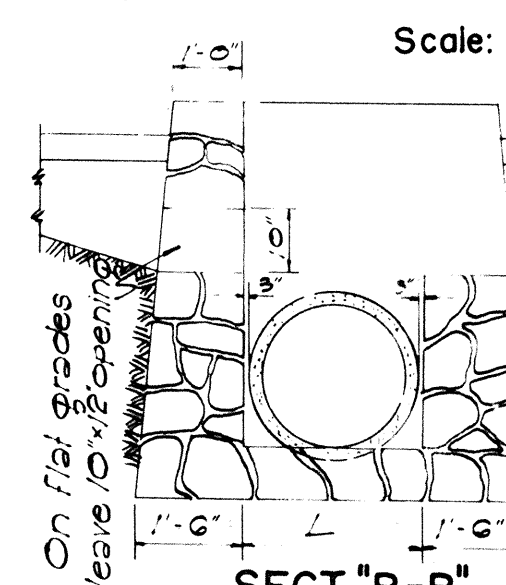

SECT. "B-B"

DETAIL OF MASONRY DROP INTAKE


Scale: 3/8" = 1' - 0"

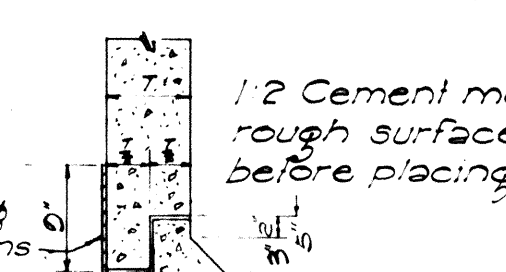

CONSTR. JOINT DETAILS

NOTE: Construction joints may only be used where indicated by the plans or permitted in writing by the Engineer.

Note: When subgrade is below top of jacket, it shall be fully compacted to this line and then re-excavated (struck) to proper subgrade. This surface shall be rolled again.

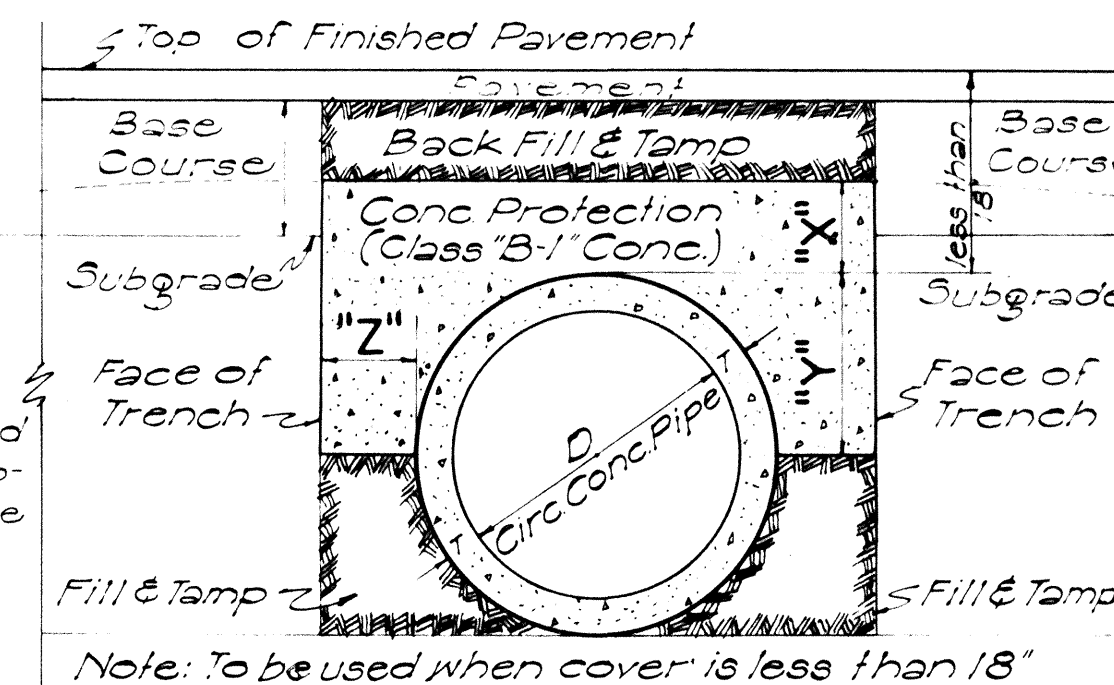

Note: To be used when cover is less than 18"

DATA FOR CONCRETE PROTECTION OVER CULVERTS			
X	Y	Z	
6" for 18"D		Z must be from pipe to face of trench	
7" " 24"D			
8" " 30"D			
9" " 36"D			
10" " 42"D			
11" " 48"D			
12" " 54"D			


SECT. OF CULVERT WITH CONC. PROTECTION

Scale: 1" = 1' - 0"


DATA FOR CONC. HEADWALL		CRM For RCCP	CRM For CGMP	Steel For One Headwall
D	H	Cu. Yds.	Cu. Yds.	No. of Bars Size Length Lbs.
18"	4'-6"	1.24	1.29	4 3/4" 7'-0" 33
24"	5'-0"	1.83	1.92	4 3/4" 7'-0" 42
30"	5'-6"	2.56	2.70	4 3/4" 8'-0" 51
36"	6'-0"	3.45	3.66	4 3/4" 10'-0" 60
42"	6'-6"	4.10	4.47	4 3/4" 11'-0" 69
48"	7'-0"	5.01	5.36	4 3/4" 13'-0" 78

DETAIL OF CONCRETE HEADWALL

Scale: 1/2" = 1' - 0"

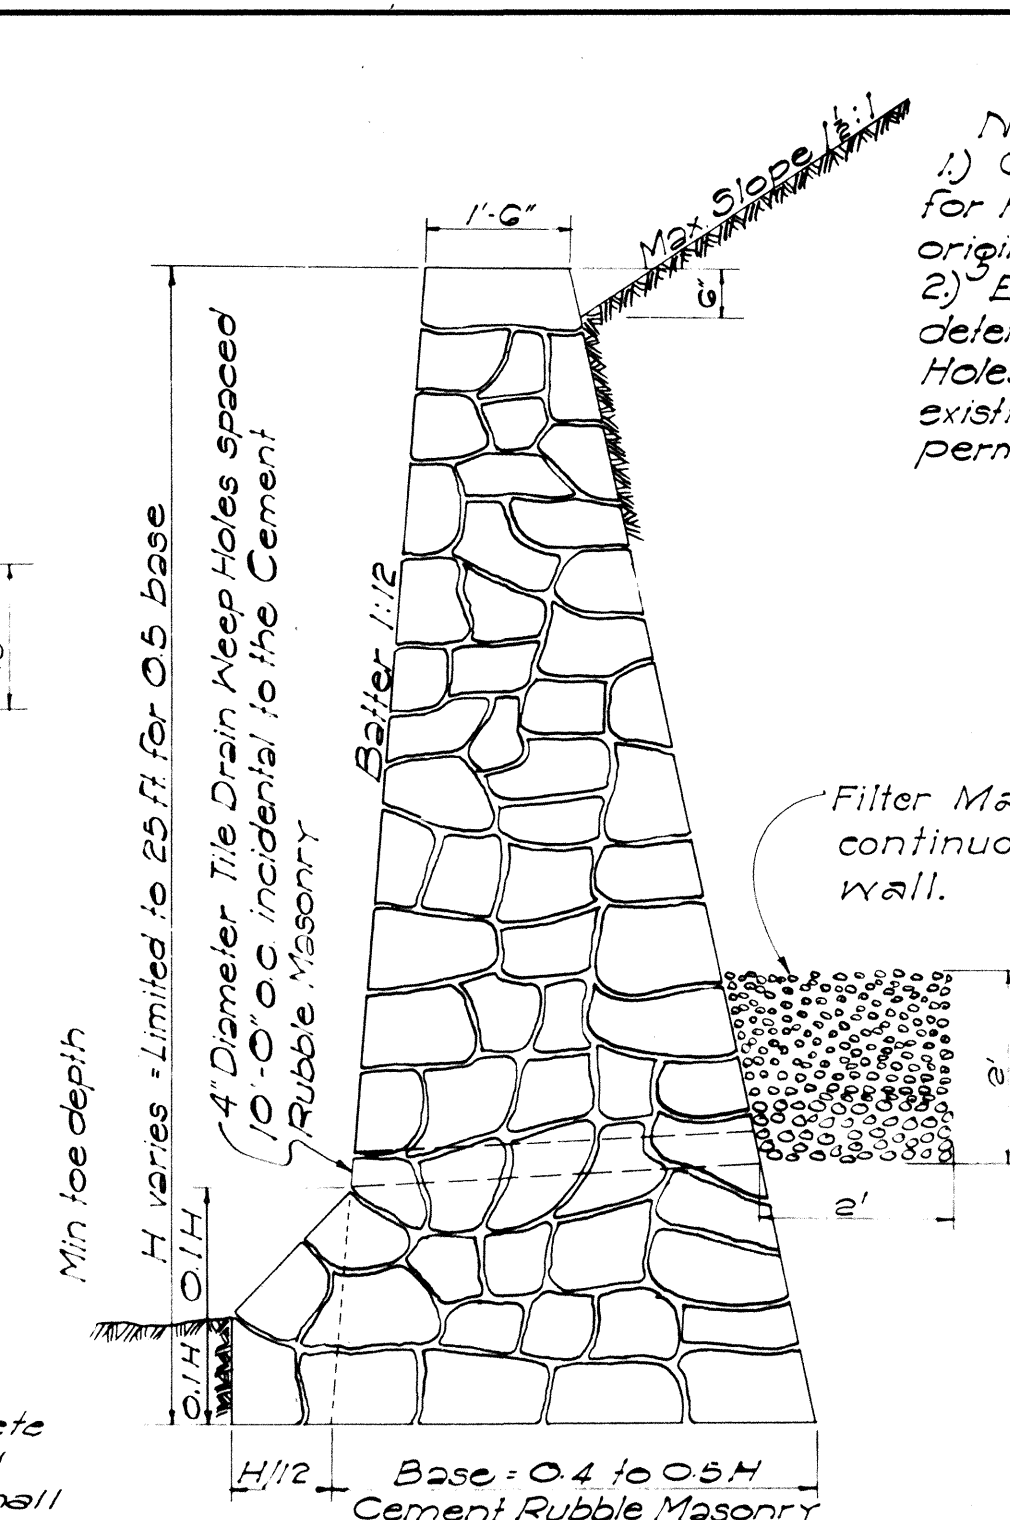

SECTION OF HIGH CEMENT RUBBLE MASONRY RETAINING WALL OR SEAWALL

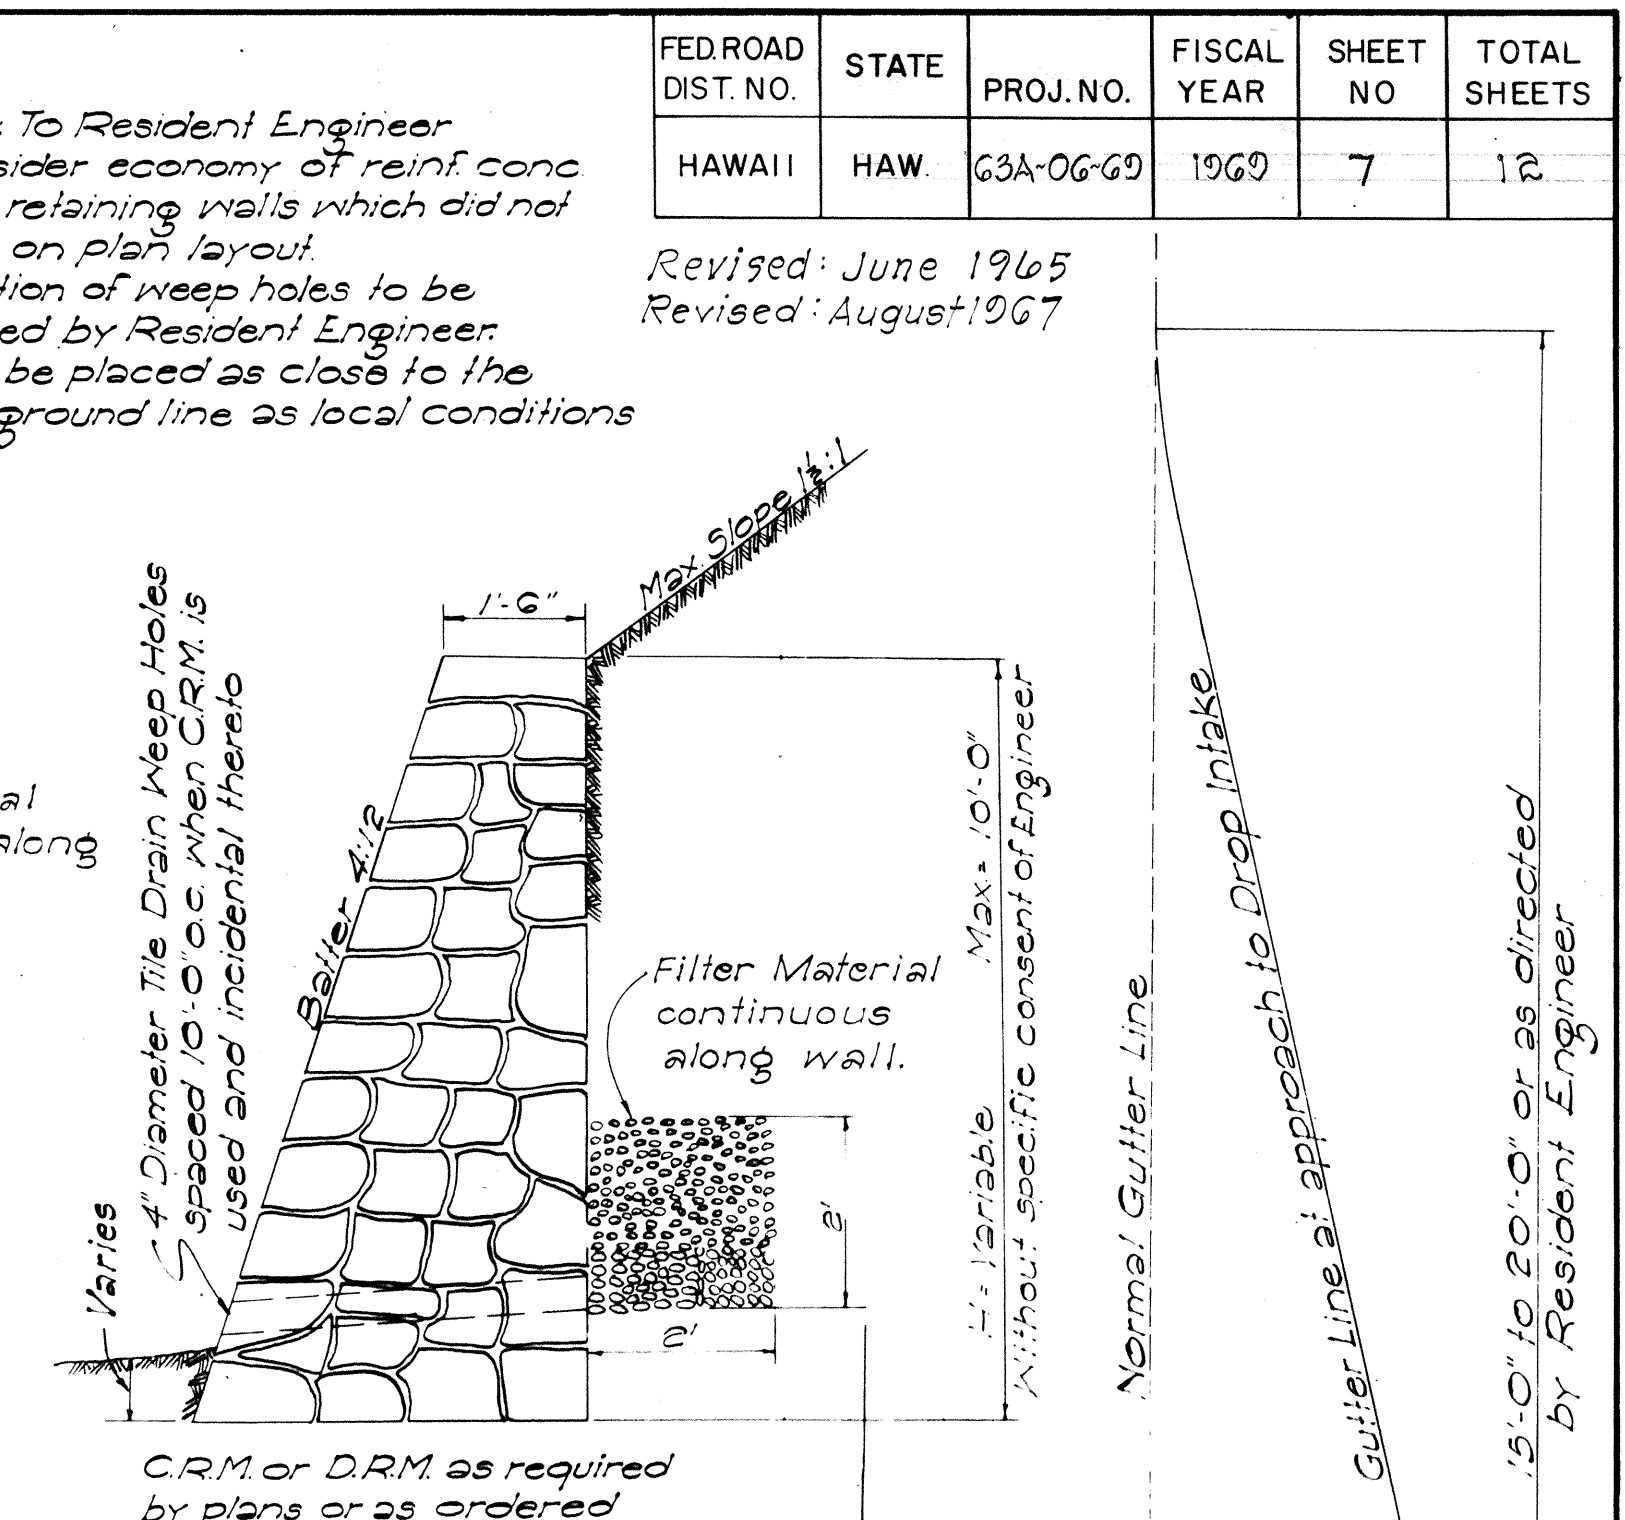

SECTION OF LOW MASONRY RETAINING WALL OR SEAWALL

DATA - CONC. DROP INTAKE				Where Variables Equal
D	D	L=D+G	Cu. Yds.	Cu. Yds.
23"	18"	2'-5"	1.41	4'-6"
30"	24"	3'-0"	1.72	5'-0"
37"	30"	3'-7"	2.32	5'-6"
44"	36"	4'-2"	2.73	6'-0"
51"	42"	4'-9"	3.54	6'-6"
58"	48"	5'-4"	4.01	7'-0"


Note: Dimension "X" is assumed as 2'-4" in figuring the above quantities.

Note: This type of structure shall also be used for the Drop Intakes of Siphons connected with Irrigation Ditches or Flumes with appropriate changes to dimensions. In this case all joints must be made water tight.


Where drainage comes from both sides lower this wall to same elevation as shown for opposite wall.

Excavate recess in roadway excavation slope for inlet to dimensions and form designated by Engineer. This is Unclassified Excavation.

Top limits of structure excavation other than at bridges.

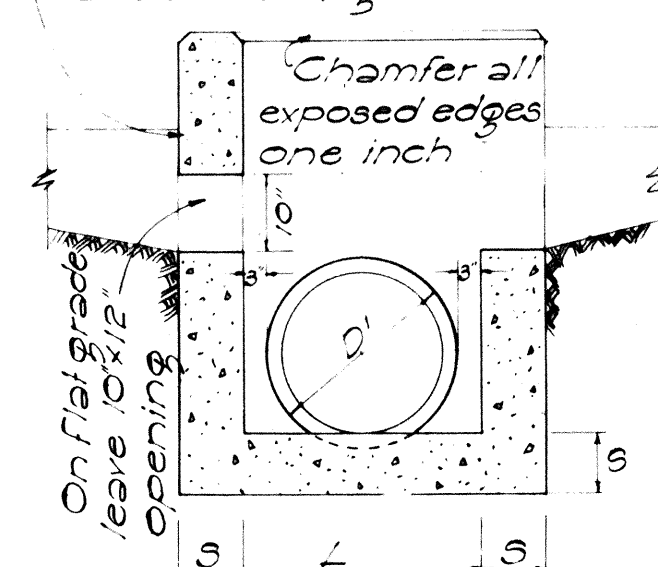

SECTION "B-B"

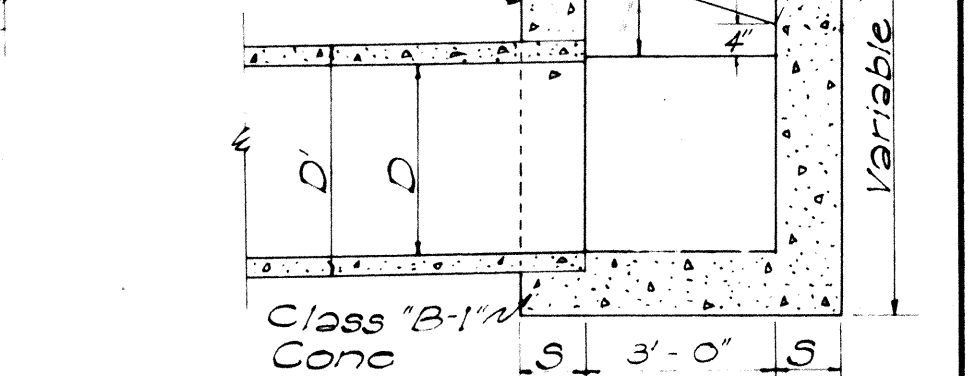

SECTION "A-A"

DETAIL OF CONCRETE DROP INTAKE

Scale: 1/2" = 1' - 0"

STATE OF HAWAII DEPARTMENT OF TRANSPORTATION HIGHWAYS DIVISION			
STANDARD DETAILS			
DROP INTAKES, RETAINING WALLS, HEADWALLS, CONSTRUCTION JOINTS			
SCALES AS NOTED			

SHEET NO 7 OF 12 SHEETS

ORIGINAL PLAN	SURVEY PLOTTED BY..... DESIGNED BY <i>J. M.</i> DRAWN BY <i>C. Y.</i>	DATE.....
NOTE BOOK	TRACED BY..... QUANTITIES BY.....	
No.	CHECKED BY.....	


STATE OF HAWAII
DEPARTMENT OF TRANSPORTATION
HIGHWAYS DIVISION
STANDARD DETAILS
CATCH BASINS

SCALES AS NOTED
SHEET NO 8 OF 12 SHEETS


Revised: Jan. 25, 1967

NOTE:


1. All welds $\frac{3}{8}$ " unless otherwise noted.
2. All steel shall be structural grade.
3. Grates and Frame shall be hot dip galvanized after fabrication in accordance with Section 44(H) of the Standard Specifications.
4. Detail of Types "A-1" and "A-2" Steel Frame and Grates are identical except for the thickness of end spacers and number of grate bars. See Table of End Spacer Thickness.

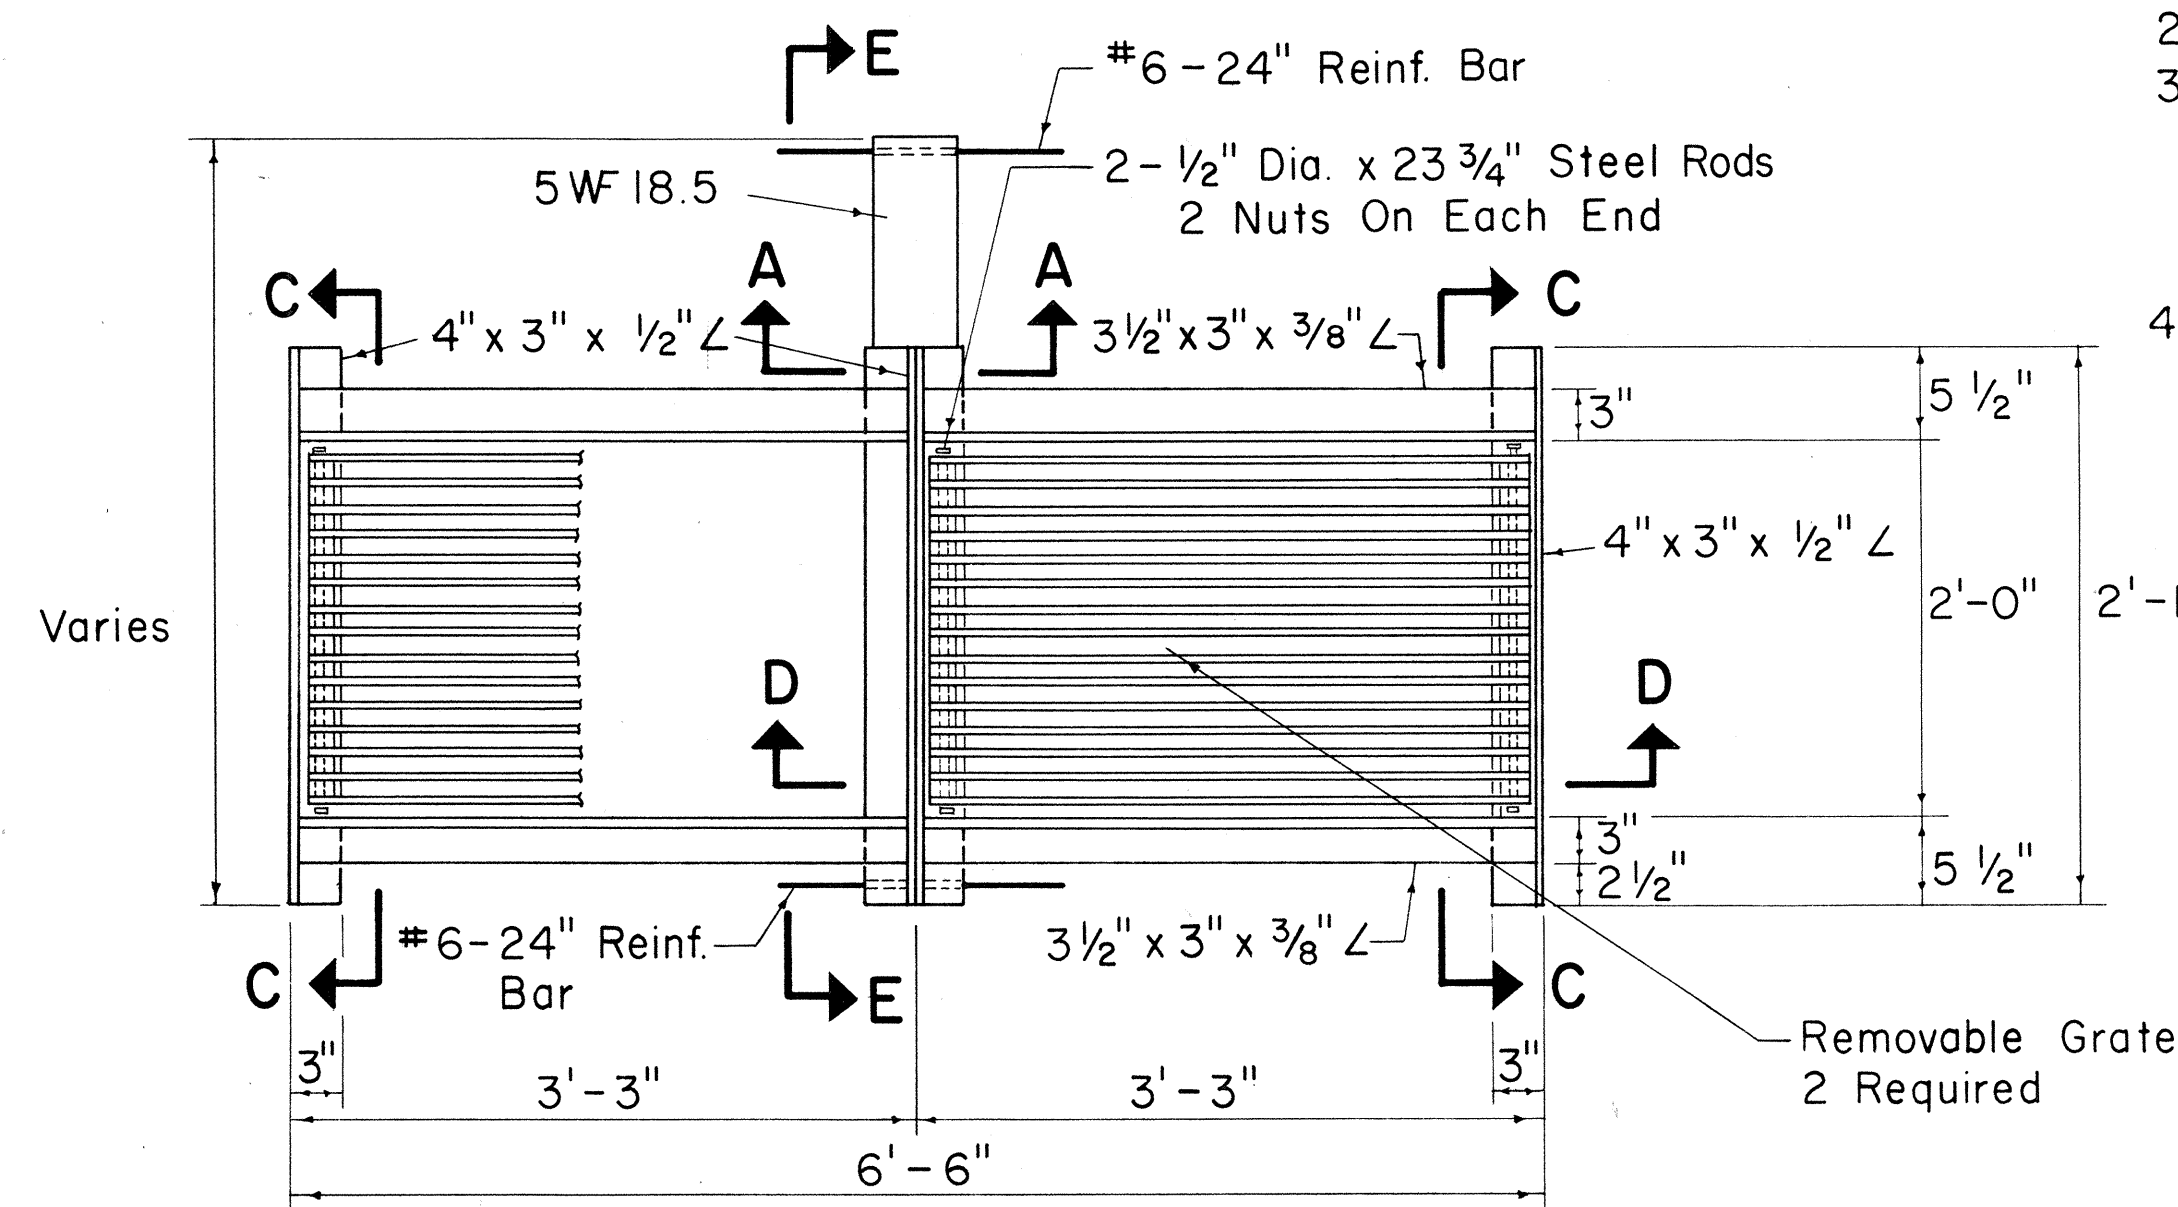

PLAN

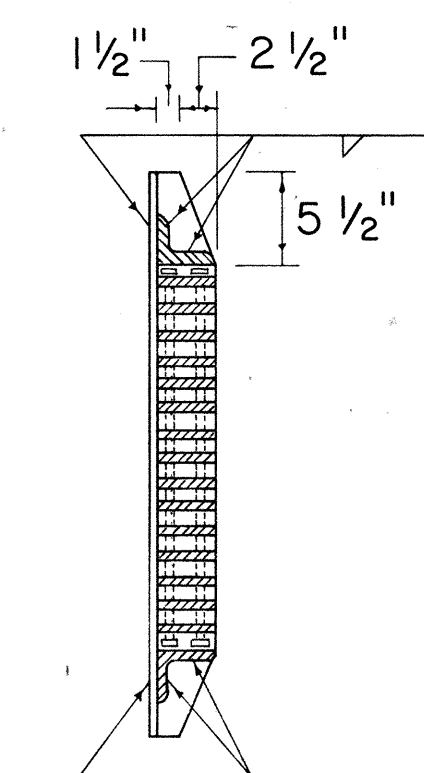

SECTION C-C

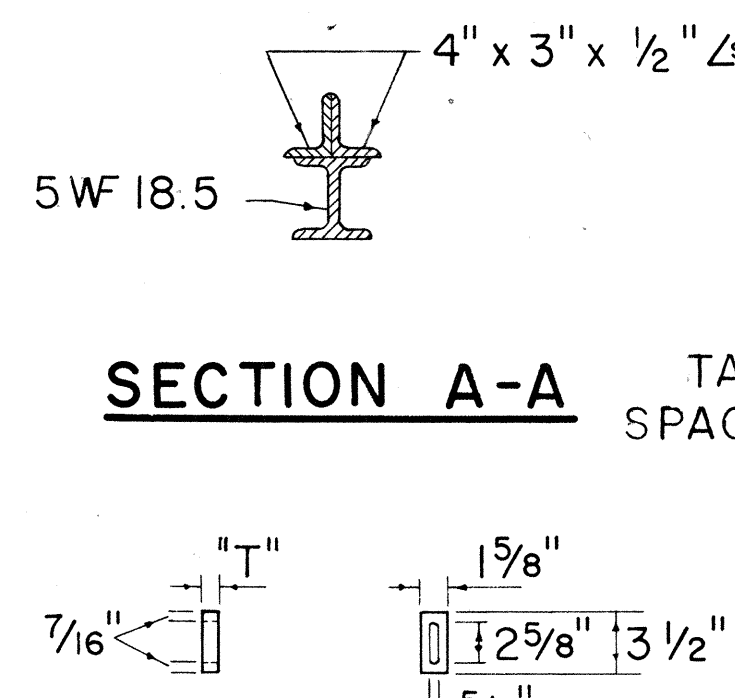


SECTION A-A


END SPACER

TABLE OF END SPACER THICKNESS


TYPE FRAME & GRATES	"T" (in.)
A - 1	1
A - 2	1 3/8

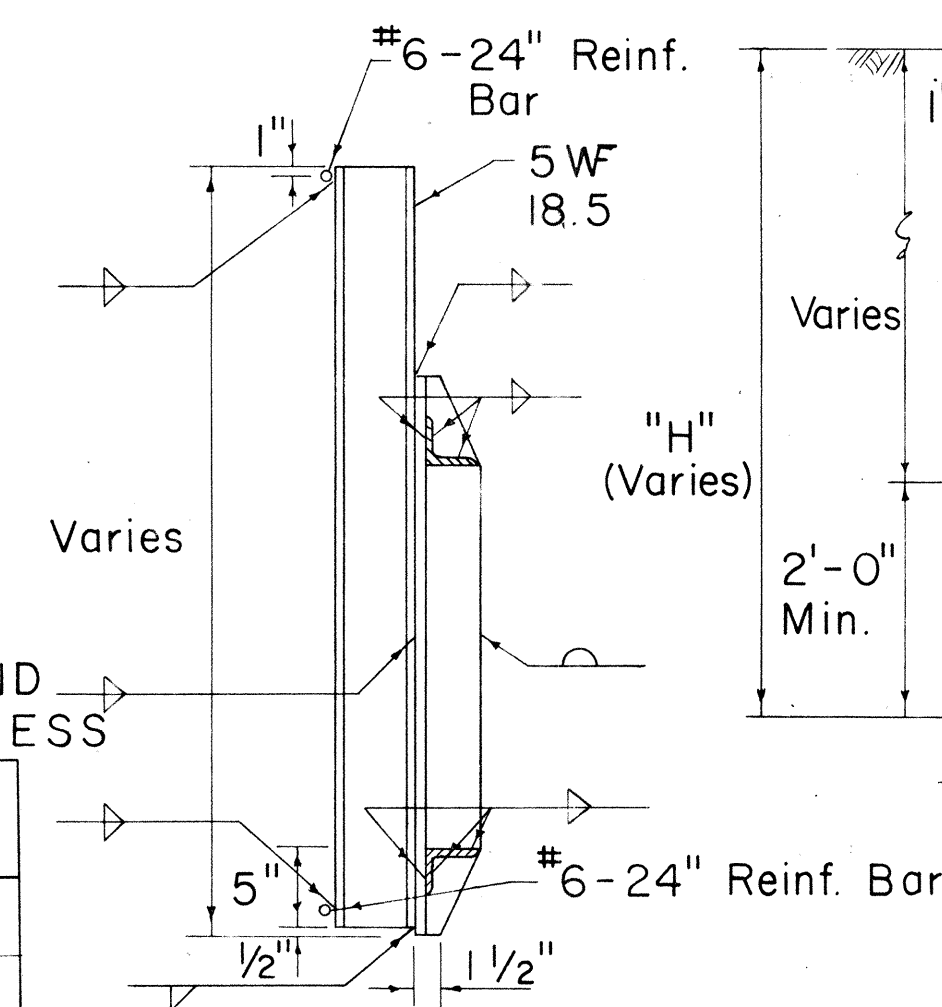


SECTION E-E

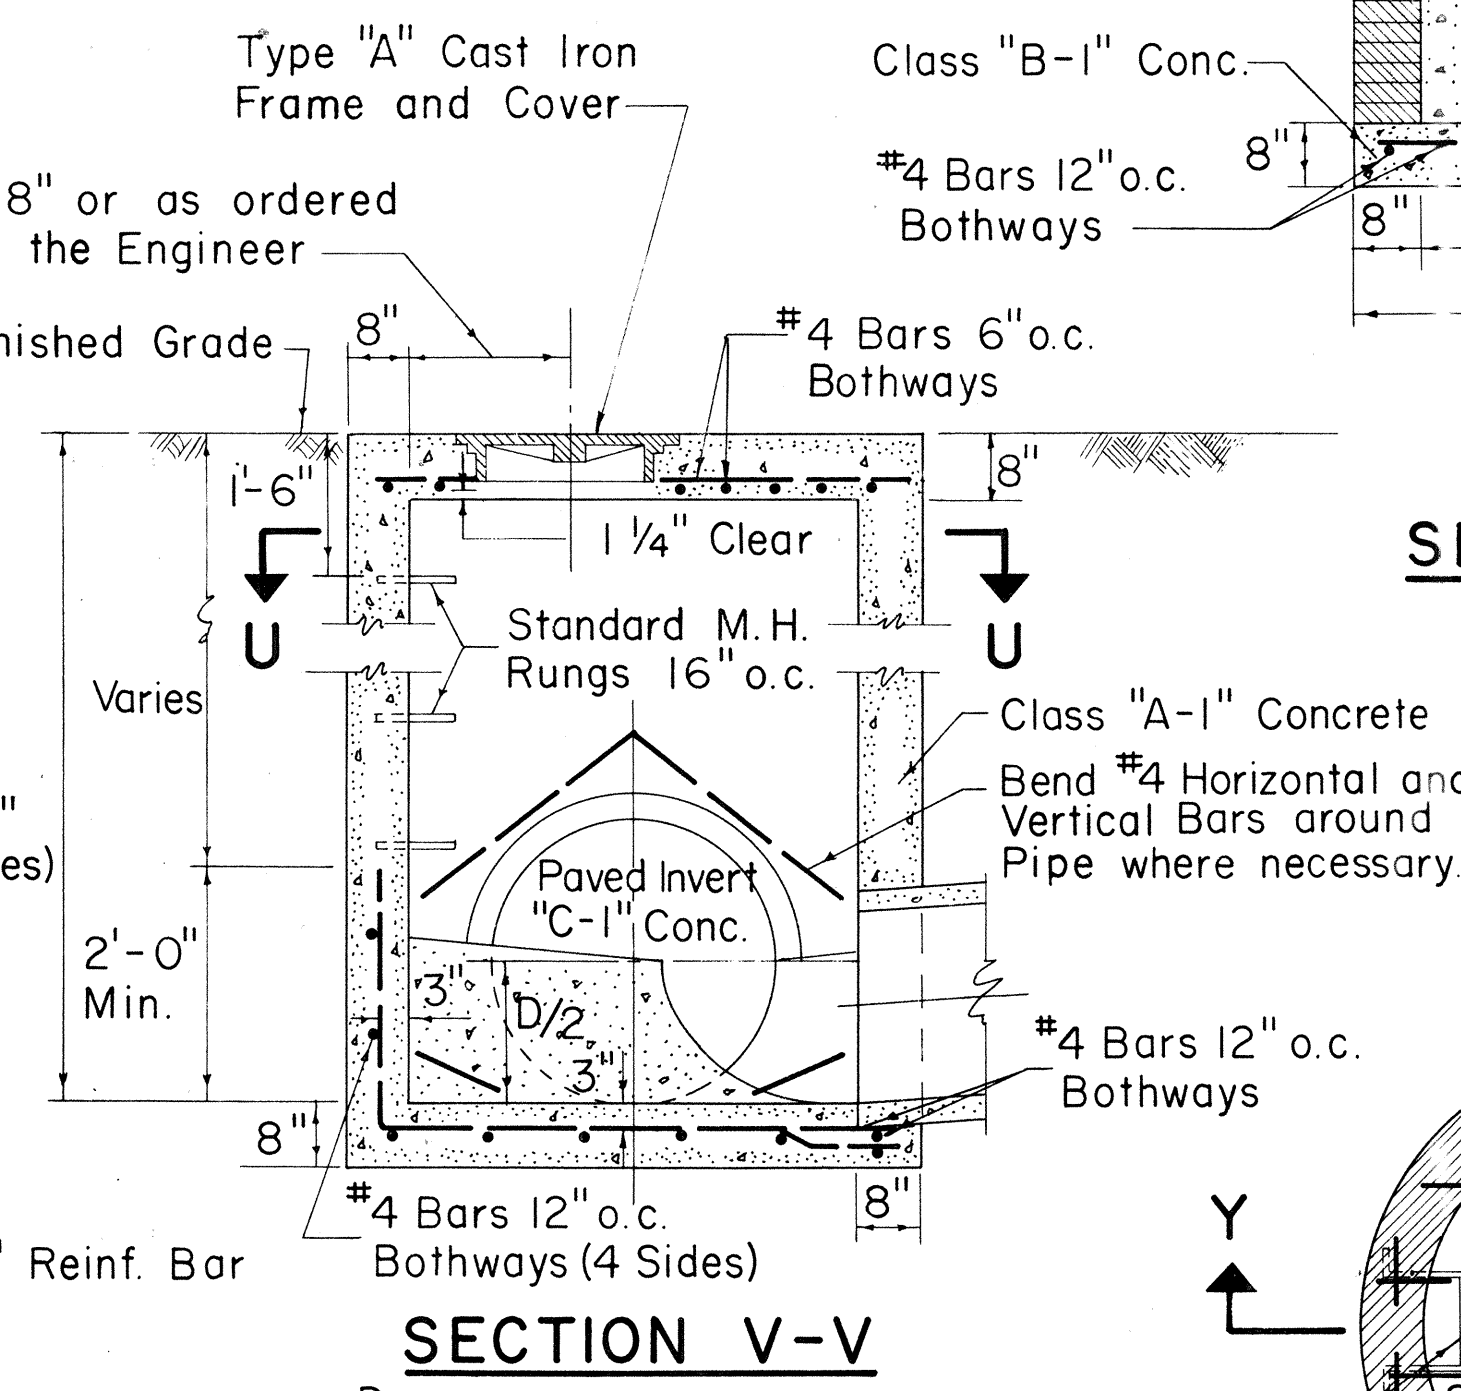

SECTION V-V

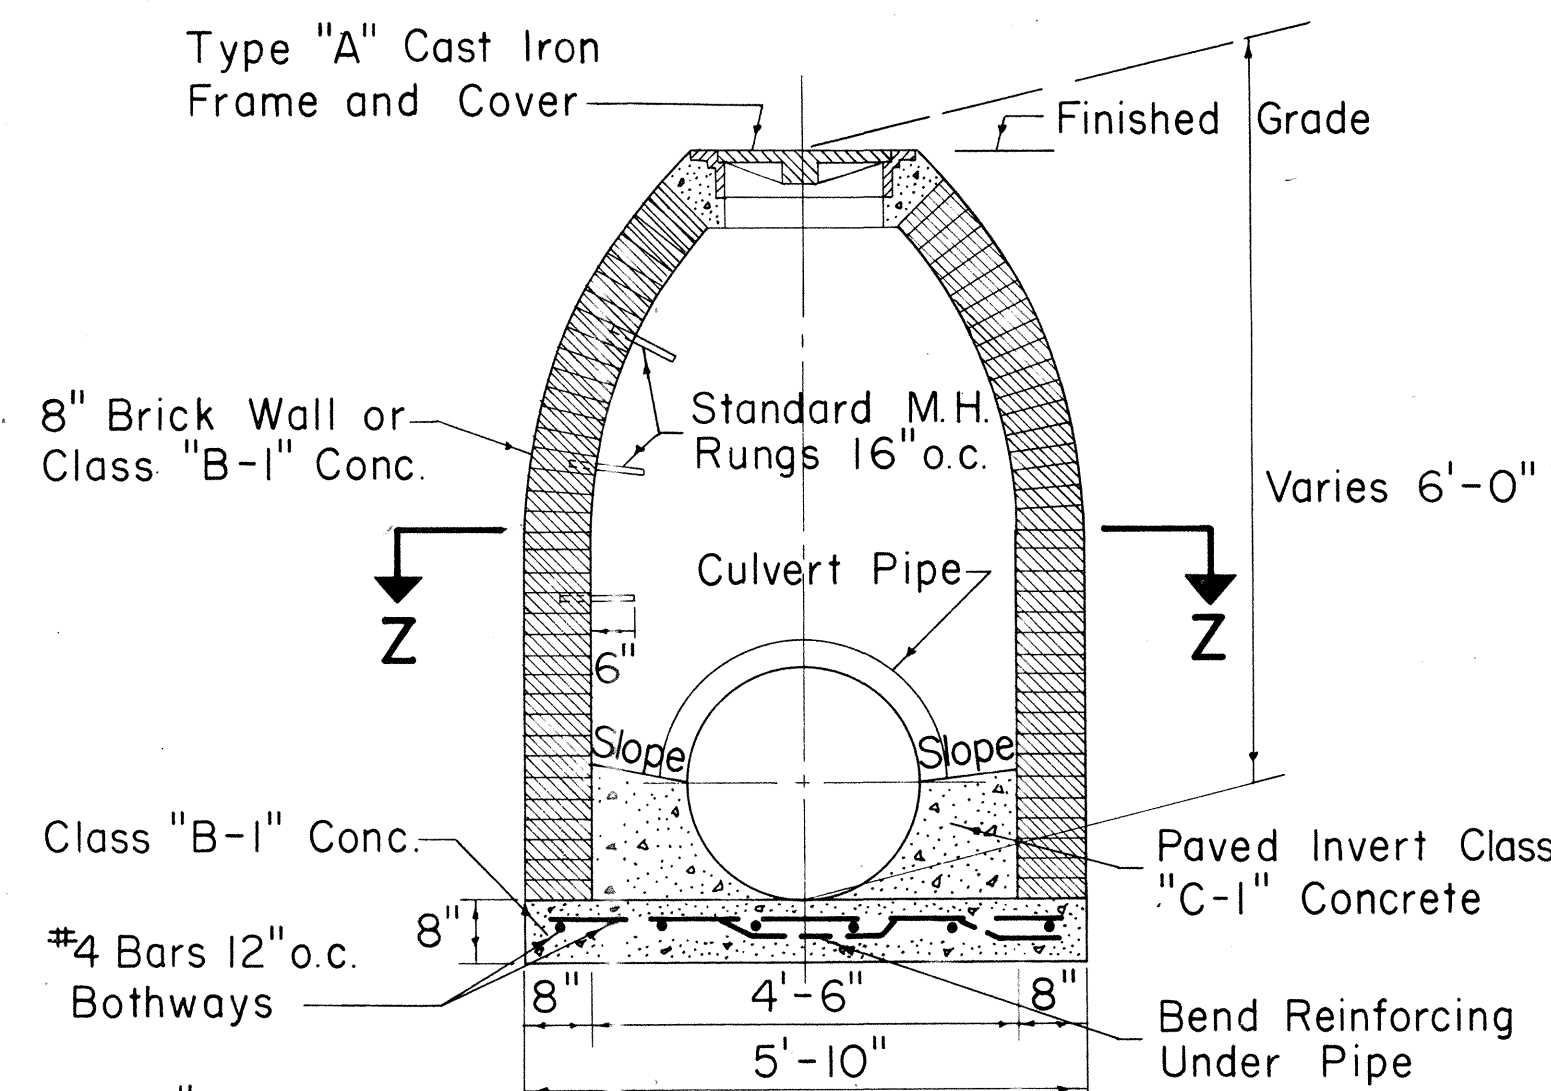


SECTION Y-Y

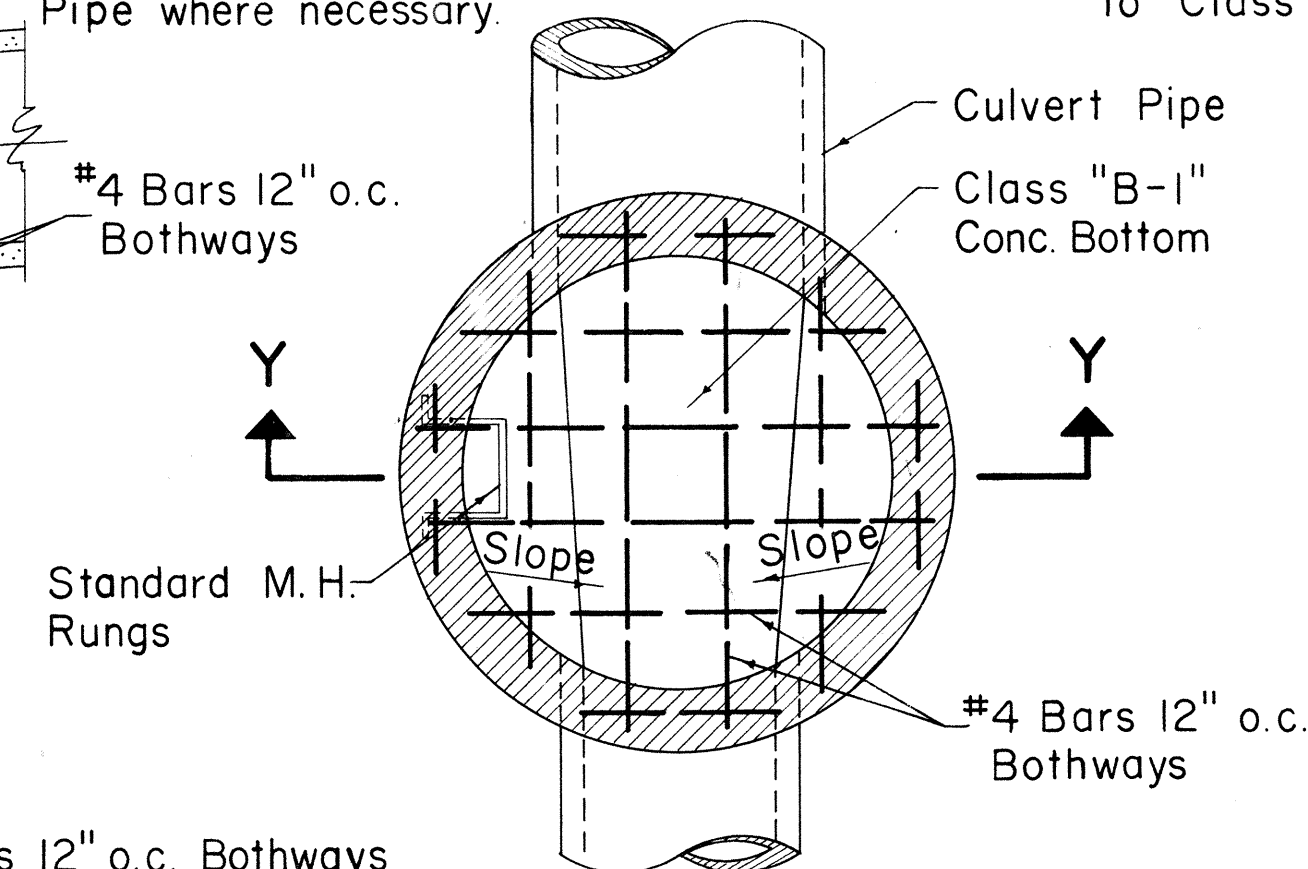


SECTION Z-Z

TYPE "D" STORM DRAIN MANHOLE

Scale: 1/2" = 1'-0"

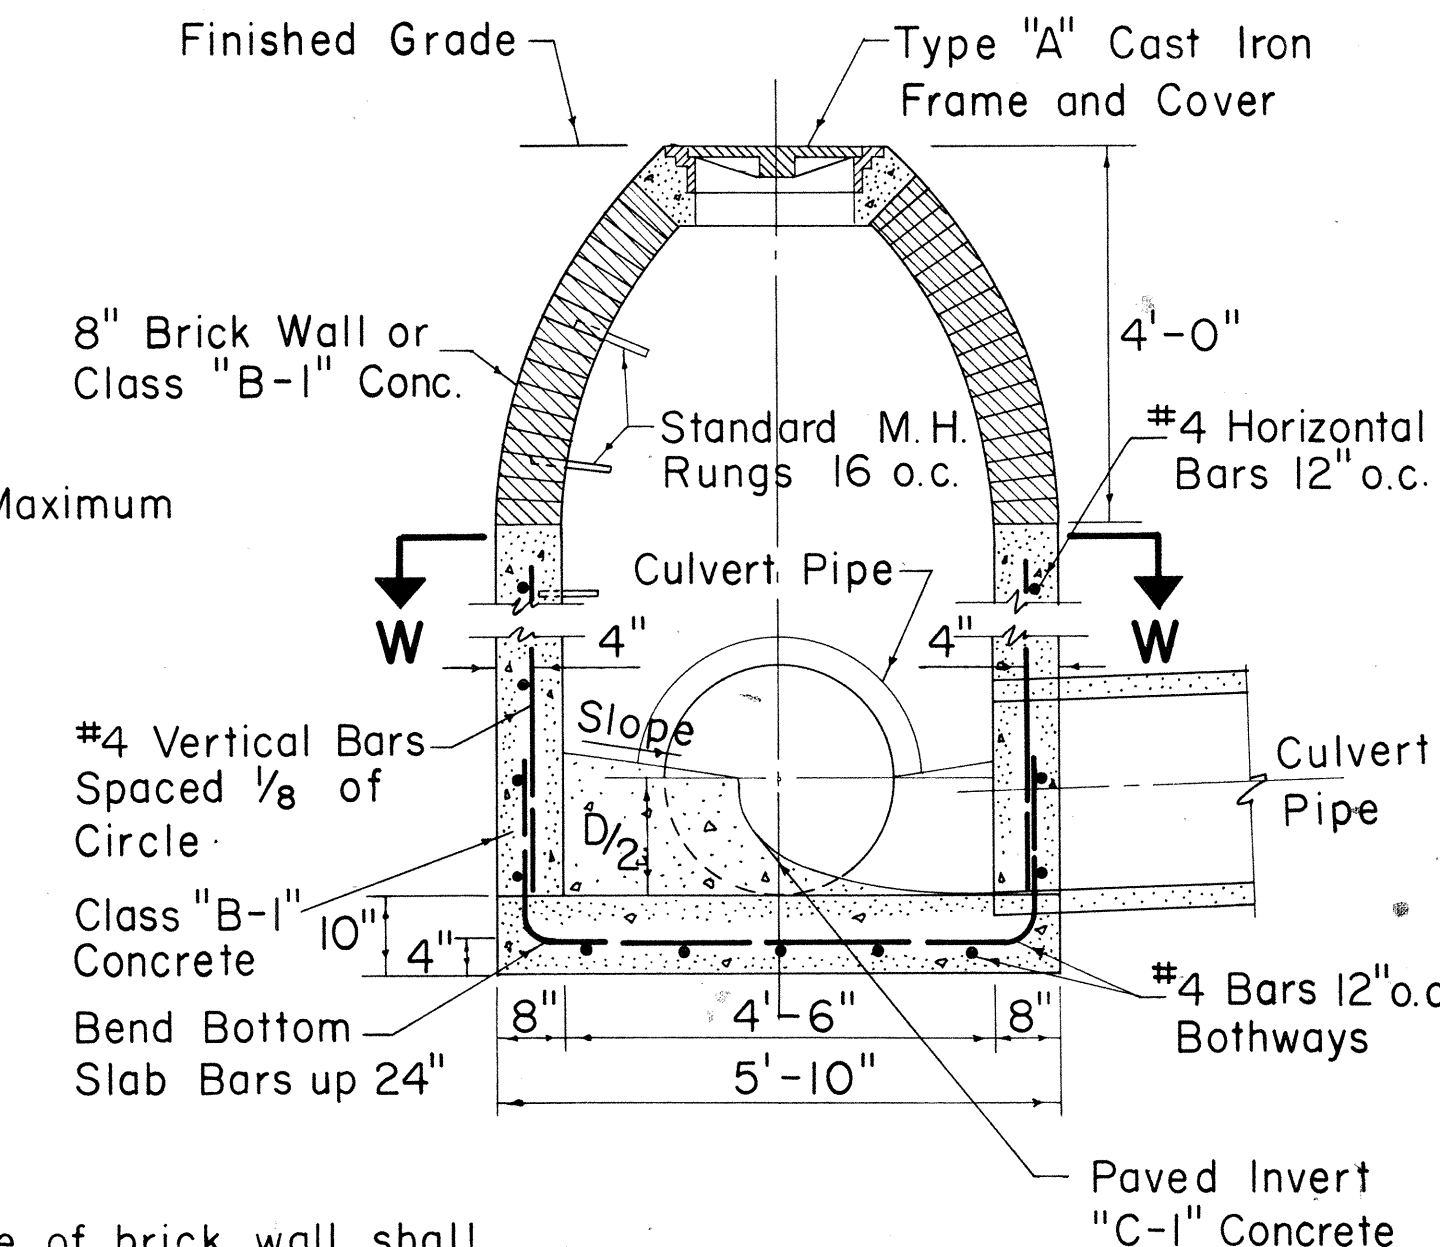

SECTION X-X

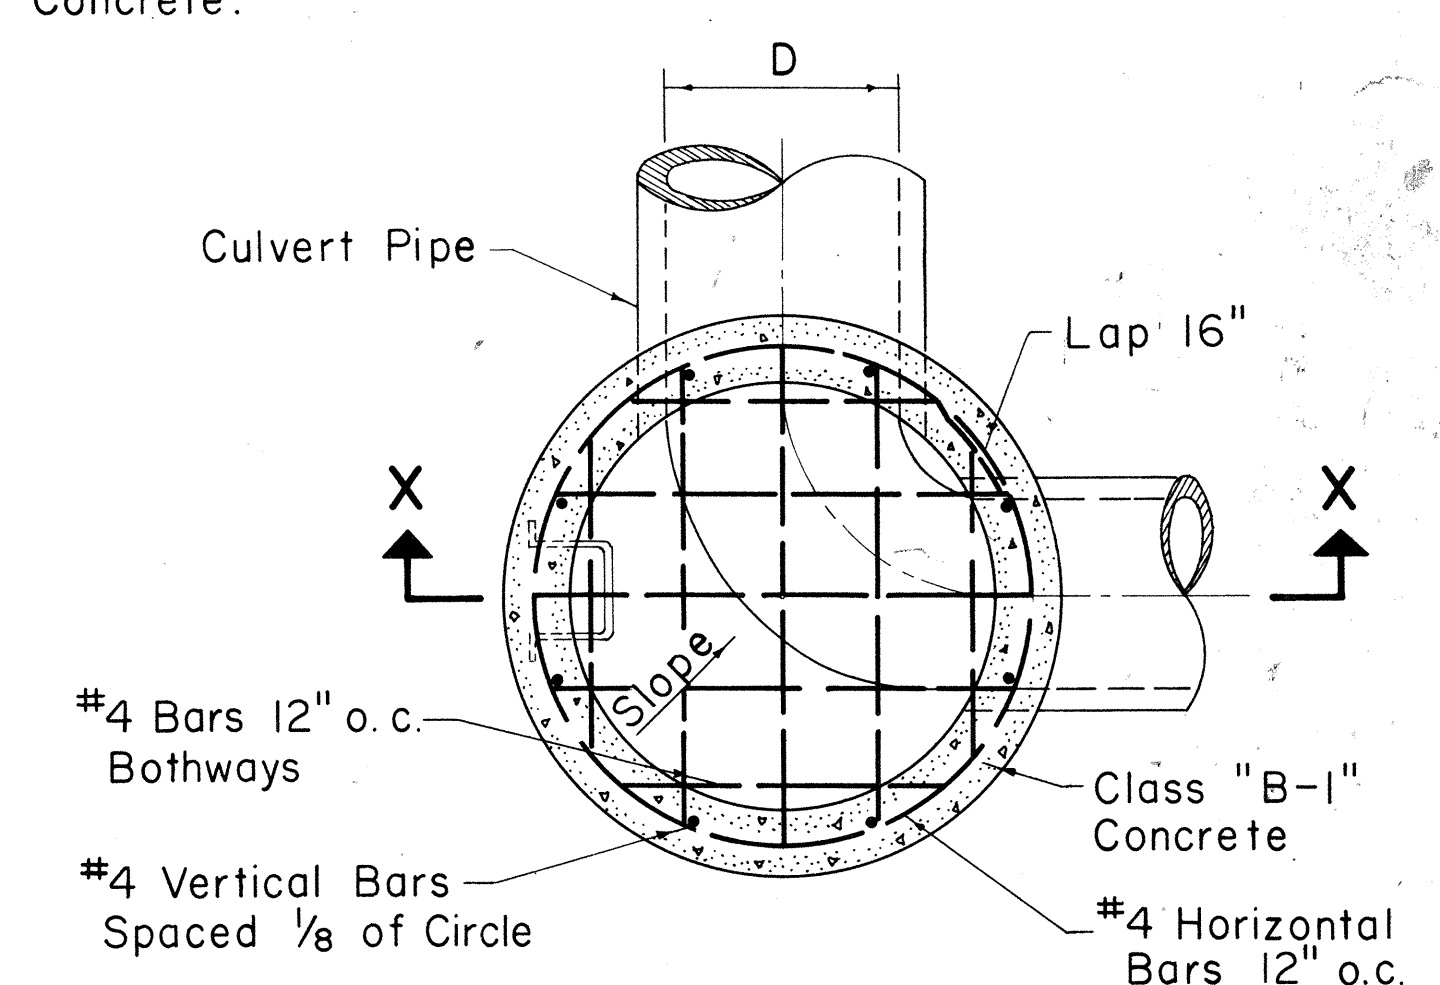


SECTION W-W

TYPE "E" STORM DRAIN MANHOLE

Scale: 1/2" = 1'-0"


GRATE BARS

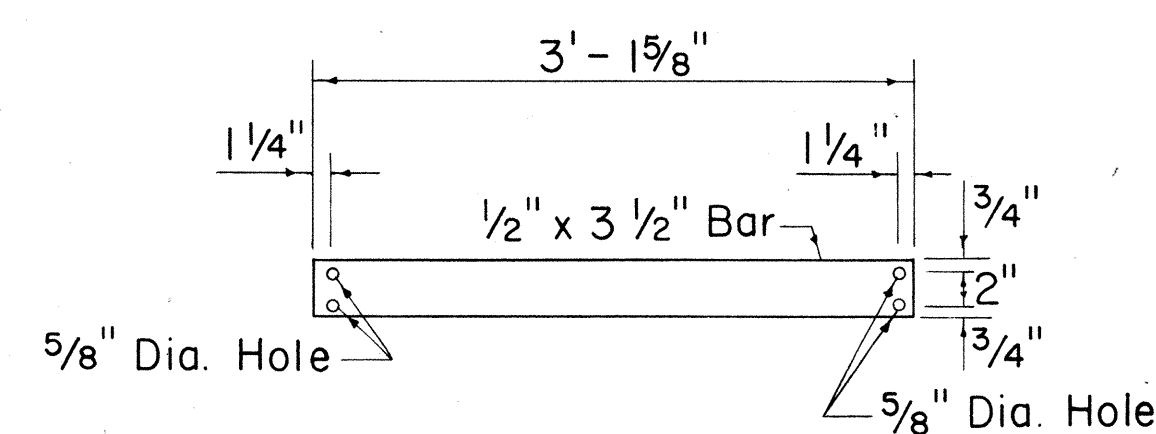

DETAIL OF TYPE "A-1" & "A-2" STEEL FRAME AND GRATES

Scale: 1" = 1'-0"

SECTION D-D

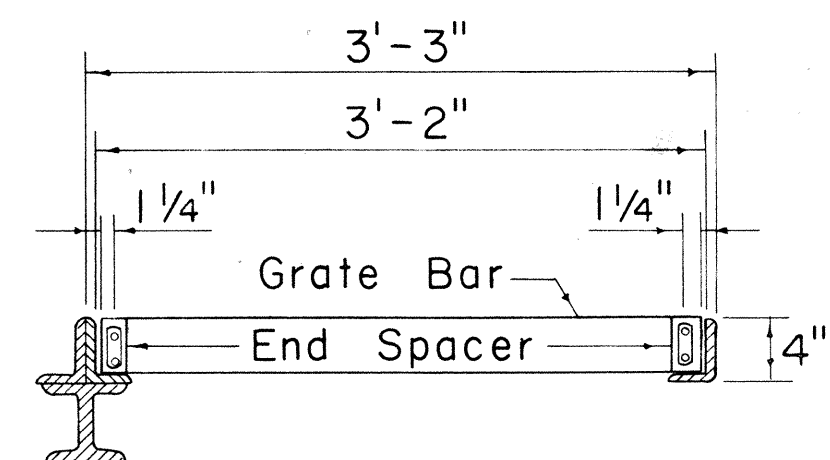

SECTION U-U

TYPE "A", "B", & "C"

S.D.M.H.

Scale: 1/2" = 1'-0"

APPROVED:

DIRECTOR OF TRANSPORTATION DATE

STATE OF HAWAII DEPARTMENT OF TRANSPORTATION HIGHWAYS DIVISION	
STANDARD DETAILS	
STEEL FRAME AND GRATES AND STORM DRAIN MANHOLES	
Scales: As Noted	Date
SHEET NO. 9 OF 12 SHEETS	

ORIGINAL PLAN	SURVEY PLOTTED BY.....	DATE.....
NOTE BOOK	DESIGNED BY.....	" "
	DRAWN BY.....	" "
	TRACED BY <i>A. Calaisiro</i>	" "
	QUANTITIES BY.....	" "
	CHECKED BY.....	" "
No.....		

A circular logo with concentric rings. The word 'SANTARYA' is arched across the top and 'SEWER' is arched across the bottom. In the center is a crosshair. At the bottom right, the text 'Cast Iron' is written with an arrow pointing to the outer ring.

[illegible]

Cast Iron

8 Ribs spaced equally

The diagram shows a circular cross-section of a flange. It features a central circular hole with a crosshair indicating the center. Surrounding the hole is a thick ring. This ring is divided into eight equal segments by radial lines, representing ribs. The outermost layer of the ring is labeled 'Cast Iron'. A note on the right side of the diagram states '8 Ribs spaced equally'.

Technical drawing of a mechanical part, likely a bracket or support, showing dimensions in inches. The drawing includes a top view and a side view. The top view shows a rectangular base with a central slot. The side view shows the profile of the part, including a vertical support and a horizontal base. Dimensions are labeled with fractions and mixed numbers.

Dimensions shown in the drawing:

- Top view (horizontal dimensions):
 - Overall width: $30\frac{3}{8}"$
 - Slot width: $24\frac{1}{2}"$
 - Slot depth (from outer edge): $4"$
 - Slot depth (from centerline): $22"$
- Side view (vertical dimensions):
 - Overall height: $5"$
 - Base thickness: $1\frac{1}{8}"$

Technical drawing of a rectangular plate with the following dimensions and tolerances:

- Overall length: 24 ± 0.05 inches
- Overall width: 4 ± 0.05 inches
- Distance from left edge to first hole center: 3 ± 0.05 inches
- Distance between hole centers: 23 ± 0.05 inches
- Distance from right edge to last hole center: 3 ± 0.05 inches
- Hole diameter: 1.2 ± 0.05 inches
- Plate thickness: 1 ± 0.05 inches
- Bottom flange thickness: 2 ± 0.05 inches

A circular diagram of a 12-sided die. The top half of the circle contains the word "STORM" in a stylized font, with the letters integrated into the grid pattern. The bottom half contains the word "DRAIN" in a similar font. The die is divided into 12 triangular faces, each containing a small circle representing a hole. A label "1" Dia. Hole" with an arrow points to one of these holes in the bottom right quadrant.

Hand-drawn cross-section of a beam with dimensions: total width $24\frac{1}{2}''$, top flange thickness $1''$, web thickness $\frac{3}{4}''$, and bottom flange thickness $2''$.

Technical drawing of a shaft with a keyway. The drawing shows a cross-section of the shaft with a keyway cut into it. The keyway is 4 inches wide and 1 inch deep. The shaft has a total length of 6 inches. The diameters are specified as follows: 27 1/4" Dia. at the top, 21 3/8" Dia. in the middle, and 20" Dia. at the bottom. The keyway is 4 inches wide and 1 inch deep. The shaft has a total length of 6 inches. The diameters are specified as follows: 27 1/4" Dia. at the top, 21 3/8" Dia. in the middle, and 20" Dia. at the bottom.

Technical drawing of a mechanical part, likely a bracket or support, showing dimensions and features. The part has a 2 1/4 inch diameter hole. Dimensions include 3 1/16 inch, 1 inch, 3/8 inch, 3 1/16 inch, 1/2 inch, 1/2 inch, 3 1/2 inch, and 1/2 inch. The part is shown in a cross-sectional view with hatching.

NOTE: Stock Pattern From Novelty Foundry

Technical drawing of a rectangular frame. The drawing shows a perspective view of a frame with a double-line border. The text "Frame Cast Iron" is written inside the frame. A point "A" is marked on the right side of the frame. Dimensions are given in feet and inches:

- Top horizontal dimension: $2'-1\frac{1}{2}"$
- Bottom horizontal dimension: $2'-8"$
- Right vertical dimension: $2'$
- Left vertical dimension: $2'-\frac{1}{2}"$
- Inner horizontal dimension: $0'-2"$
- Inner vertical dimension: $2'-5'-2"$

A technical drawing of a circular object, likely a lens or a mirror, showing concentric circles. The word "WATER" is written in the center. A dimension line indicates a radius of $\frac{7}{8}$ inch. The drawing is a top-down view of a circular component with concentric circles and a central point.

Technical drawing of a 20" Dia. manhole with a 2 1/2" Dia. cover. The drawing shows a cross-section of the manhole structure. The cover is 2 1/2" Dia. and 1 1/2" thick. The manhole body is 20" Dia. and 4" thick. The total height of the manhole is 6". The drawing includes dimensions for the cover, the manhole body, and the overall structure.

SHEET No 10 OF 12 SHEETS