INDEX TO DRAWINGS	
SHEET NO.	DESCRIPTION
	TITLE SHEET
2 - 3	PLAN
4 - 10	DRAINAGE DETAILS
11-12	CROSS SECTIONS
· · · · · · · · · · · · · · · · · · ·	·
	82%
	1
,	*
	v
	:
-	

STATE OF HAWAII

DEPARTMENT OF TRANSPORTATION
HIGHWAYS DIVISION

HONOLULU, HAWAII

"AS BUILT"

DRAINAGE IMPROVEMENTS


FOR

LIKELIKE HIGHWAY

VICINITY OF VALLEY VIEW DR.

PROJECT NO. 63A-06-69

ISLAND OF OAHU

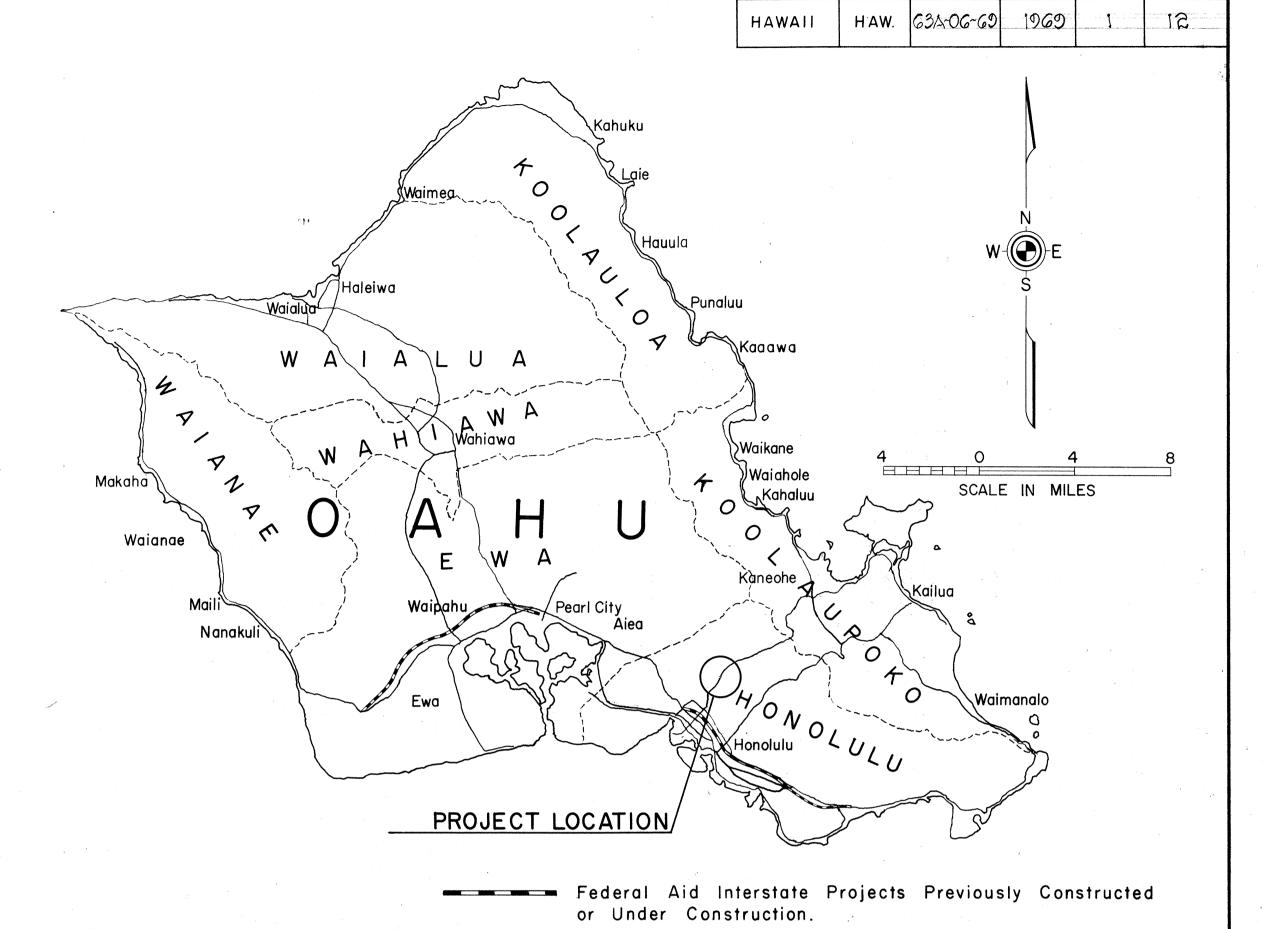


NOTE:

ALL CHANGES MADE DURING CONSTRUCTION HAVE BEEN NOTED IN RED ON THESE TRACINGS AND CHECKED BY

R-T. Janki 7-3-73

PROJECT ENGINEER DATE

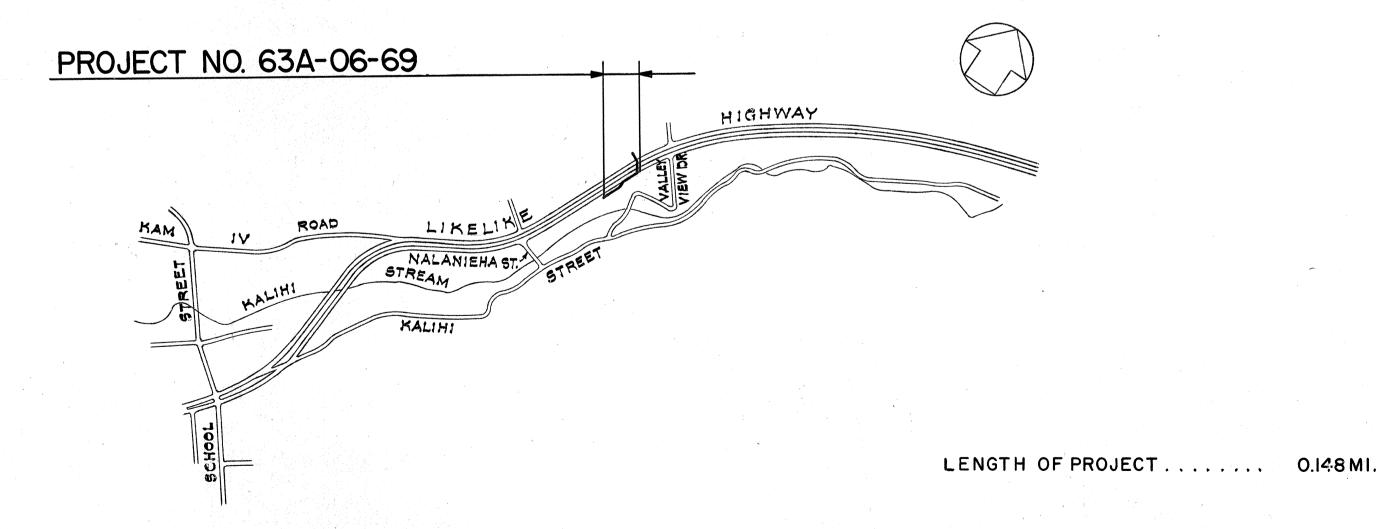

LAYOUT PLAN

DEPARTMENT OF TRANSPORTATION
STATE OF HAWAII

APPROVED:

C. Queen Manual 12/19/6.

4-1