
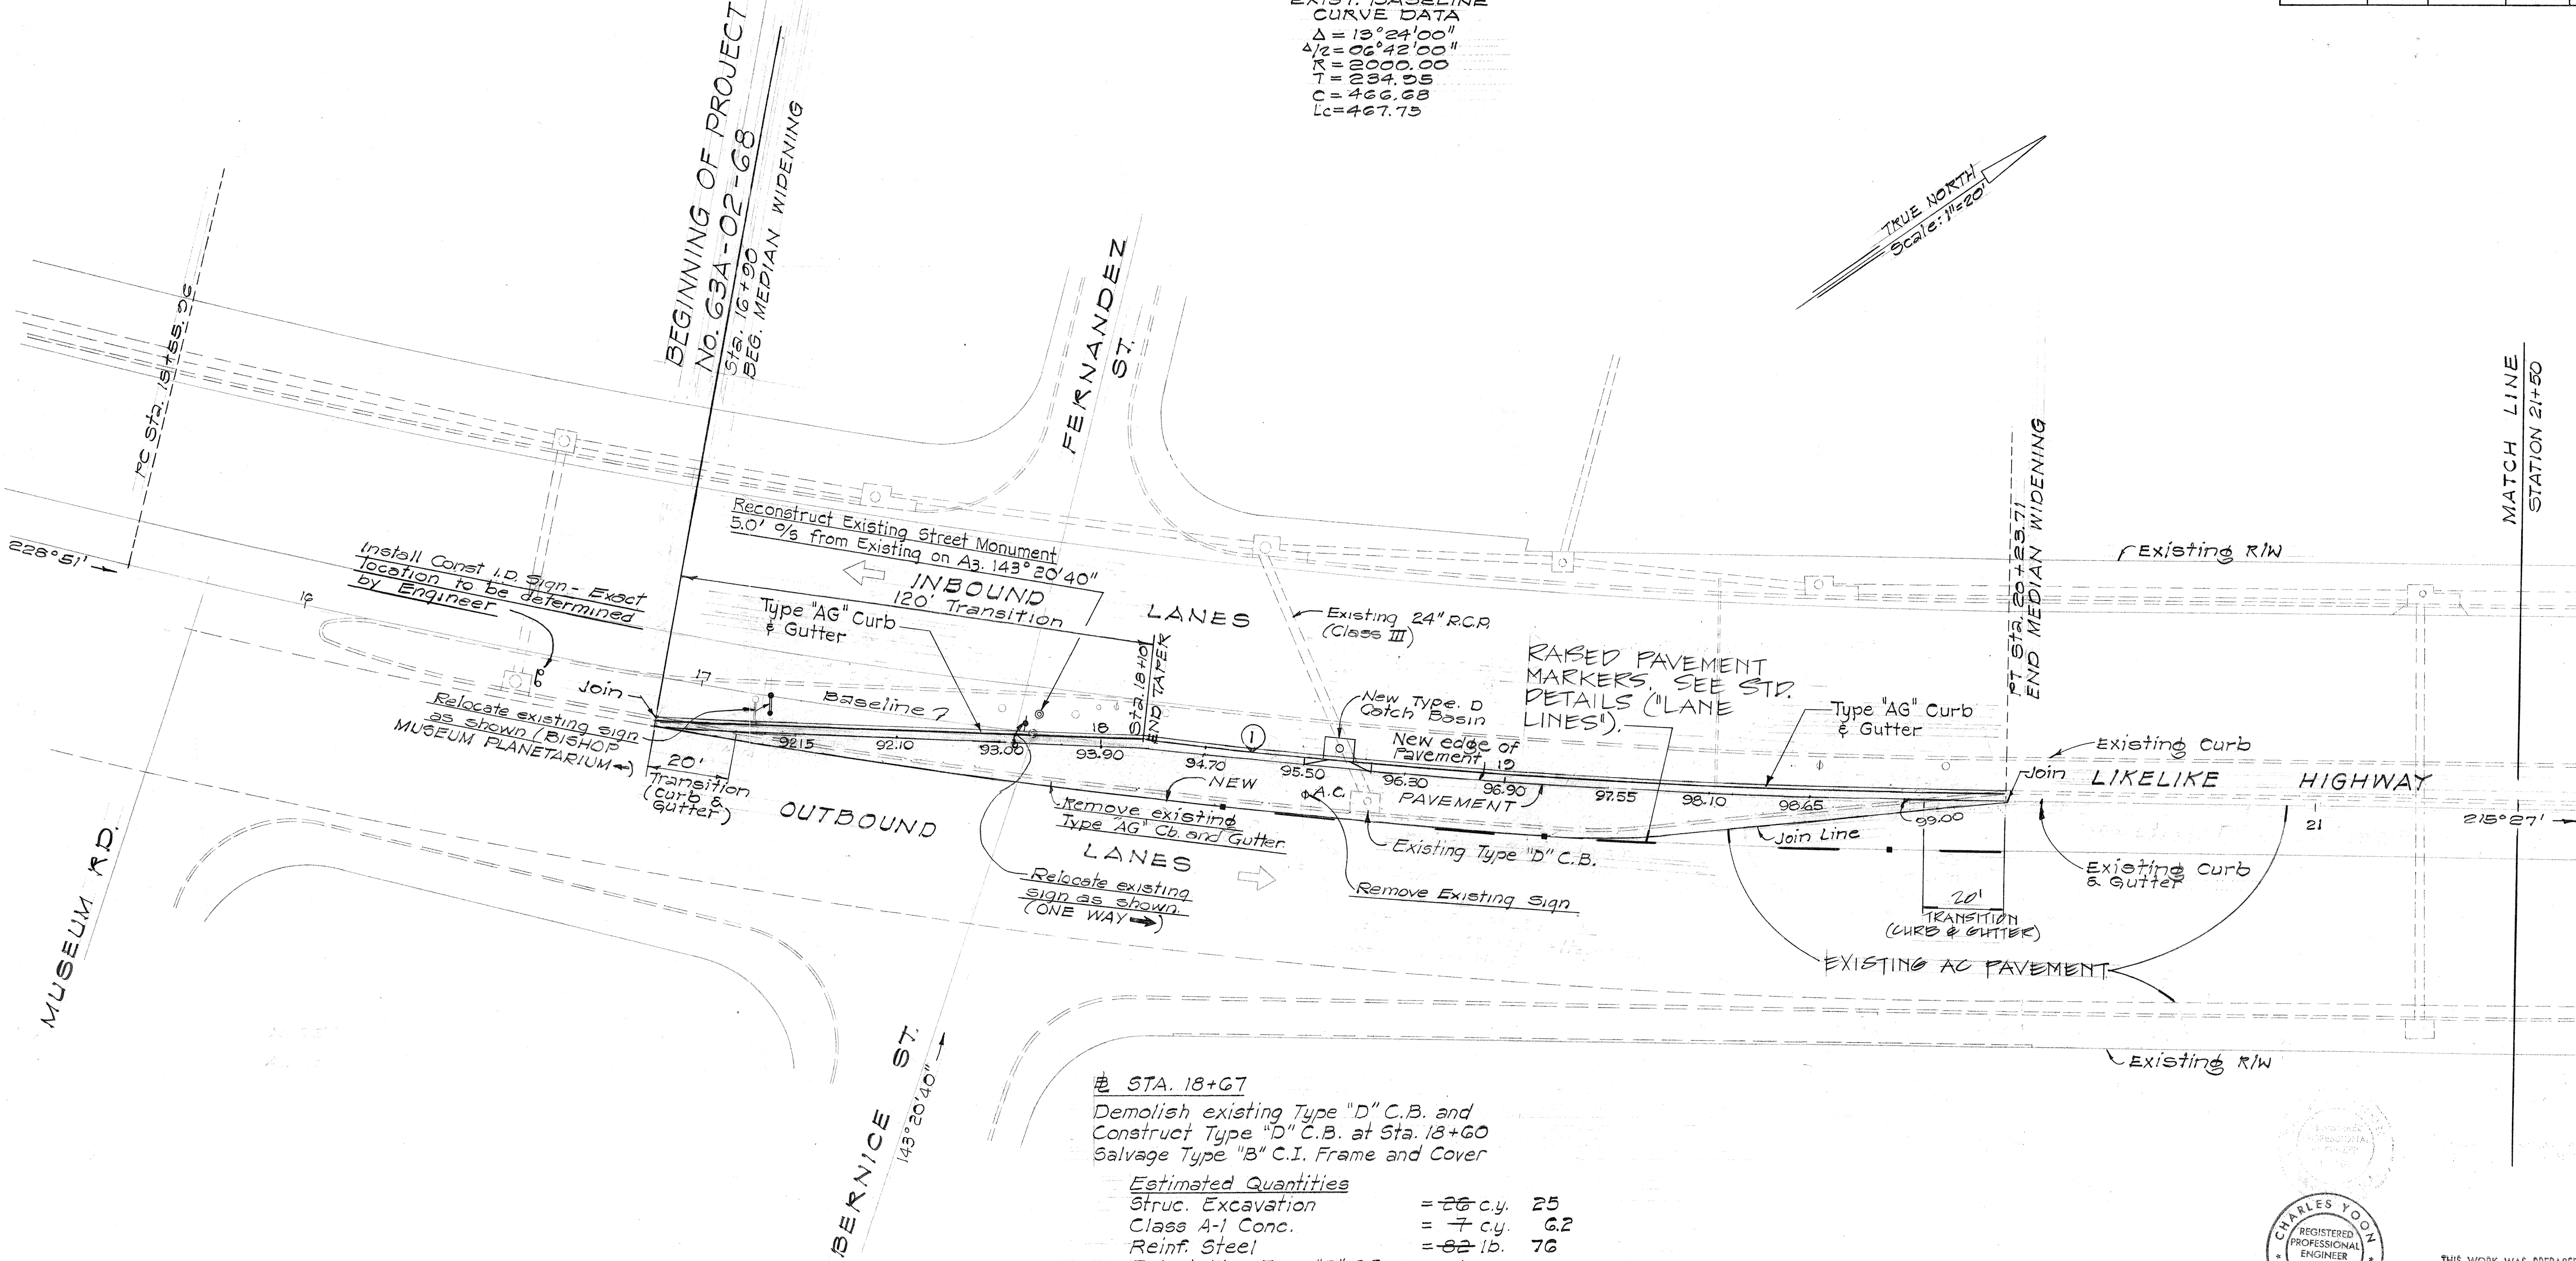


FED. ROAD DIST. NO.	STATE	PROJ. NO.	FISCAL YEAR	SHEET NO.	TOTAL SHEETS
HAWAII	HAW.	63A-02-68	1968	3	31


①
EXIST. BASELINE
CURVE DATA
Δ = 13°24'00"
Δ/2 = 06°42'00"
K = 2000.00
T = 234.95
C = 466.68
Lc = 467.75

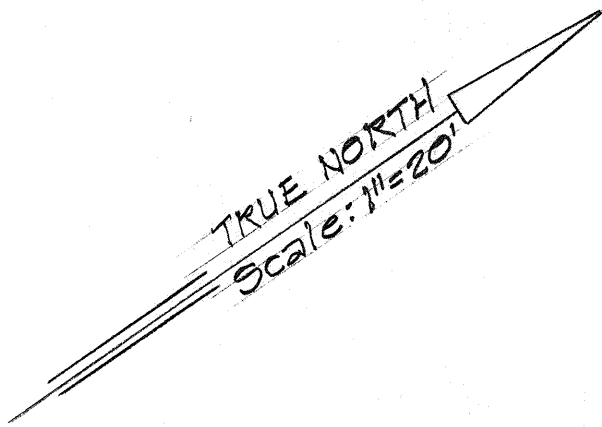

② STA. 18+67
Demolish existing Type "D" C.B. and
Construct Type "D" C.B. at Sta. 18+60
Salvage Type "B" C.I. Frame and Cover

Estimated Quantities

Struc. Excavation	= 26 c.y.	25
Class A-1 Conc.	= 7 c.y.	6.2
Reinf. Steel	= 82 lb.	76
Reinstalling Type "B" C.I. Frame and Cover	= 1 ea.	

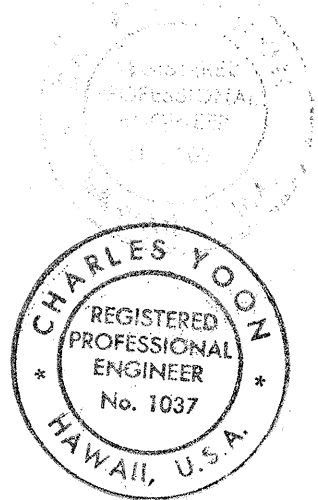


THIS WORK WAS PREPARED BY
ME OR UNDER MY SUPERVISION
Charles Yoon

STATE OF HAWAII
DEPARTMENT OF TRANSPORTATION
HIGHWAYS DIVISION
DETAIL PLAN OF ROADWAY
ADDITIONAL LANES ON LIKELIKE
HIGHWAY, SCHOOL STREET TO KALIHI
STREET, OAHU

Proj. No. 63 A-02-68
Scale: 1" = 20'
August, 1968
SHEET No. 1 OF 3 SHEETS

DATE	_____
SURVEY PLOTTED BY	_____
DESIGNED BY	_____
NOTED BY	_____
CHECKED BY	_____
ORIGINAL PLAN	_____
NOTE BOOK	_____
No.	_____

FED. ROAD DIST. NO.	STATE	PROJ. NO.	FISCAL YEAR	SHEET NO.	TOTAL SHEETS
HAWAII	HAW.	63A-02-68	1968	4	31

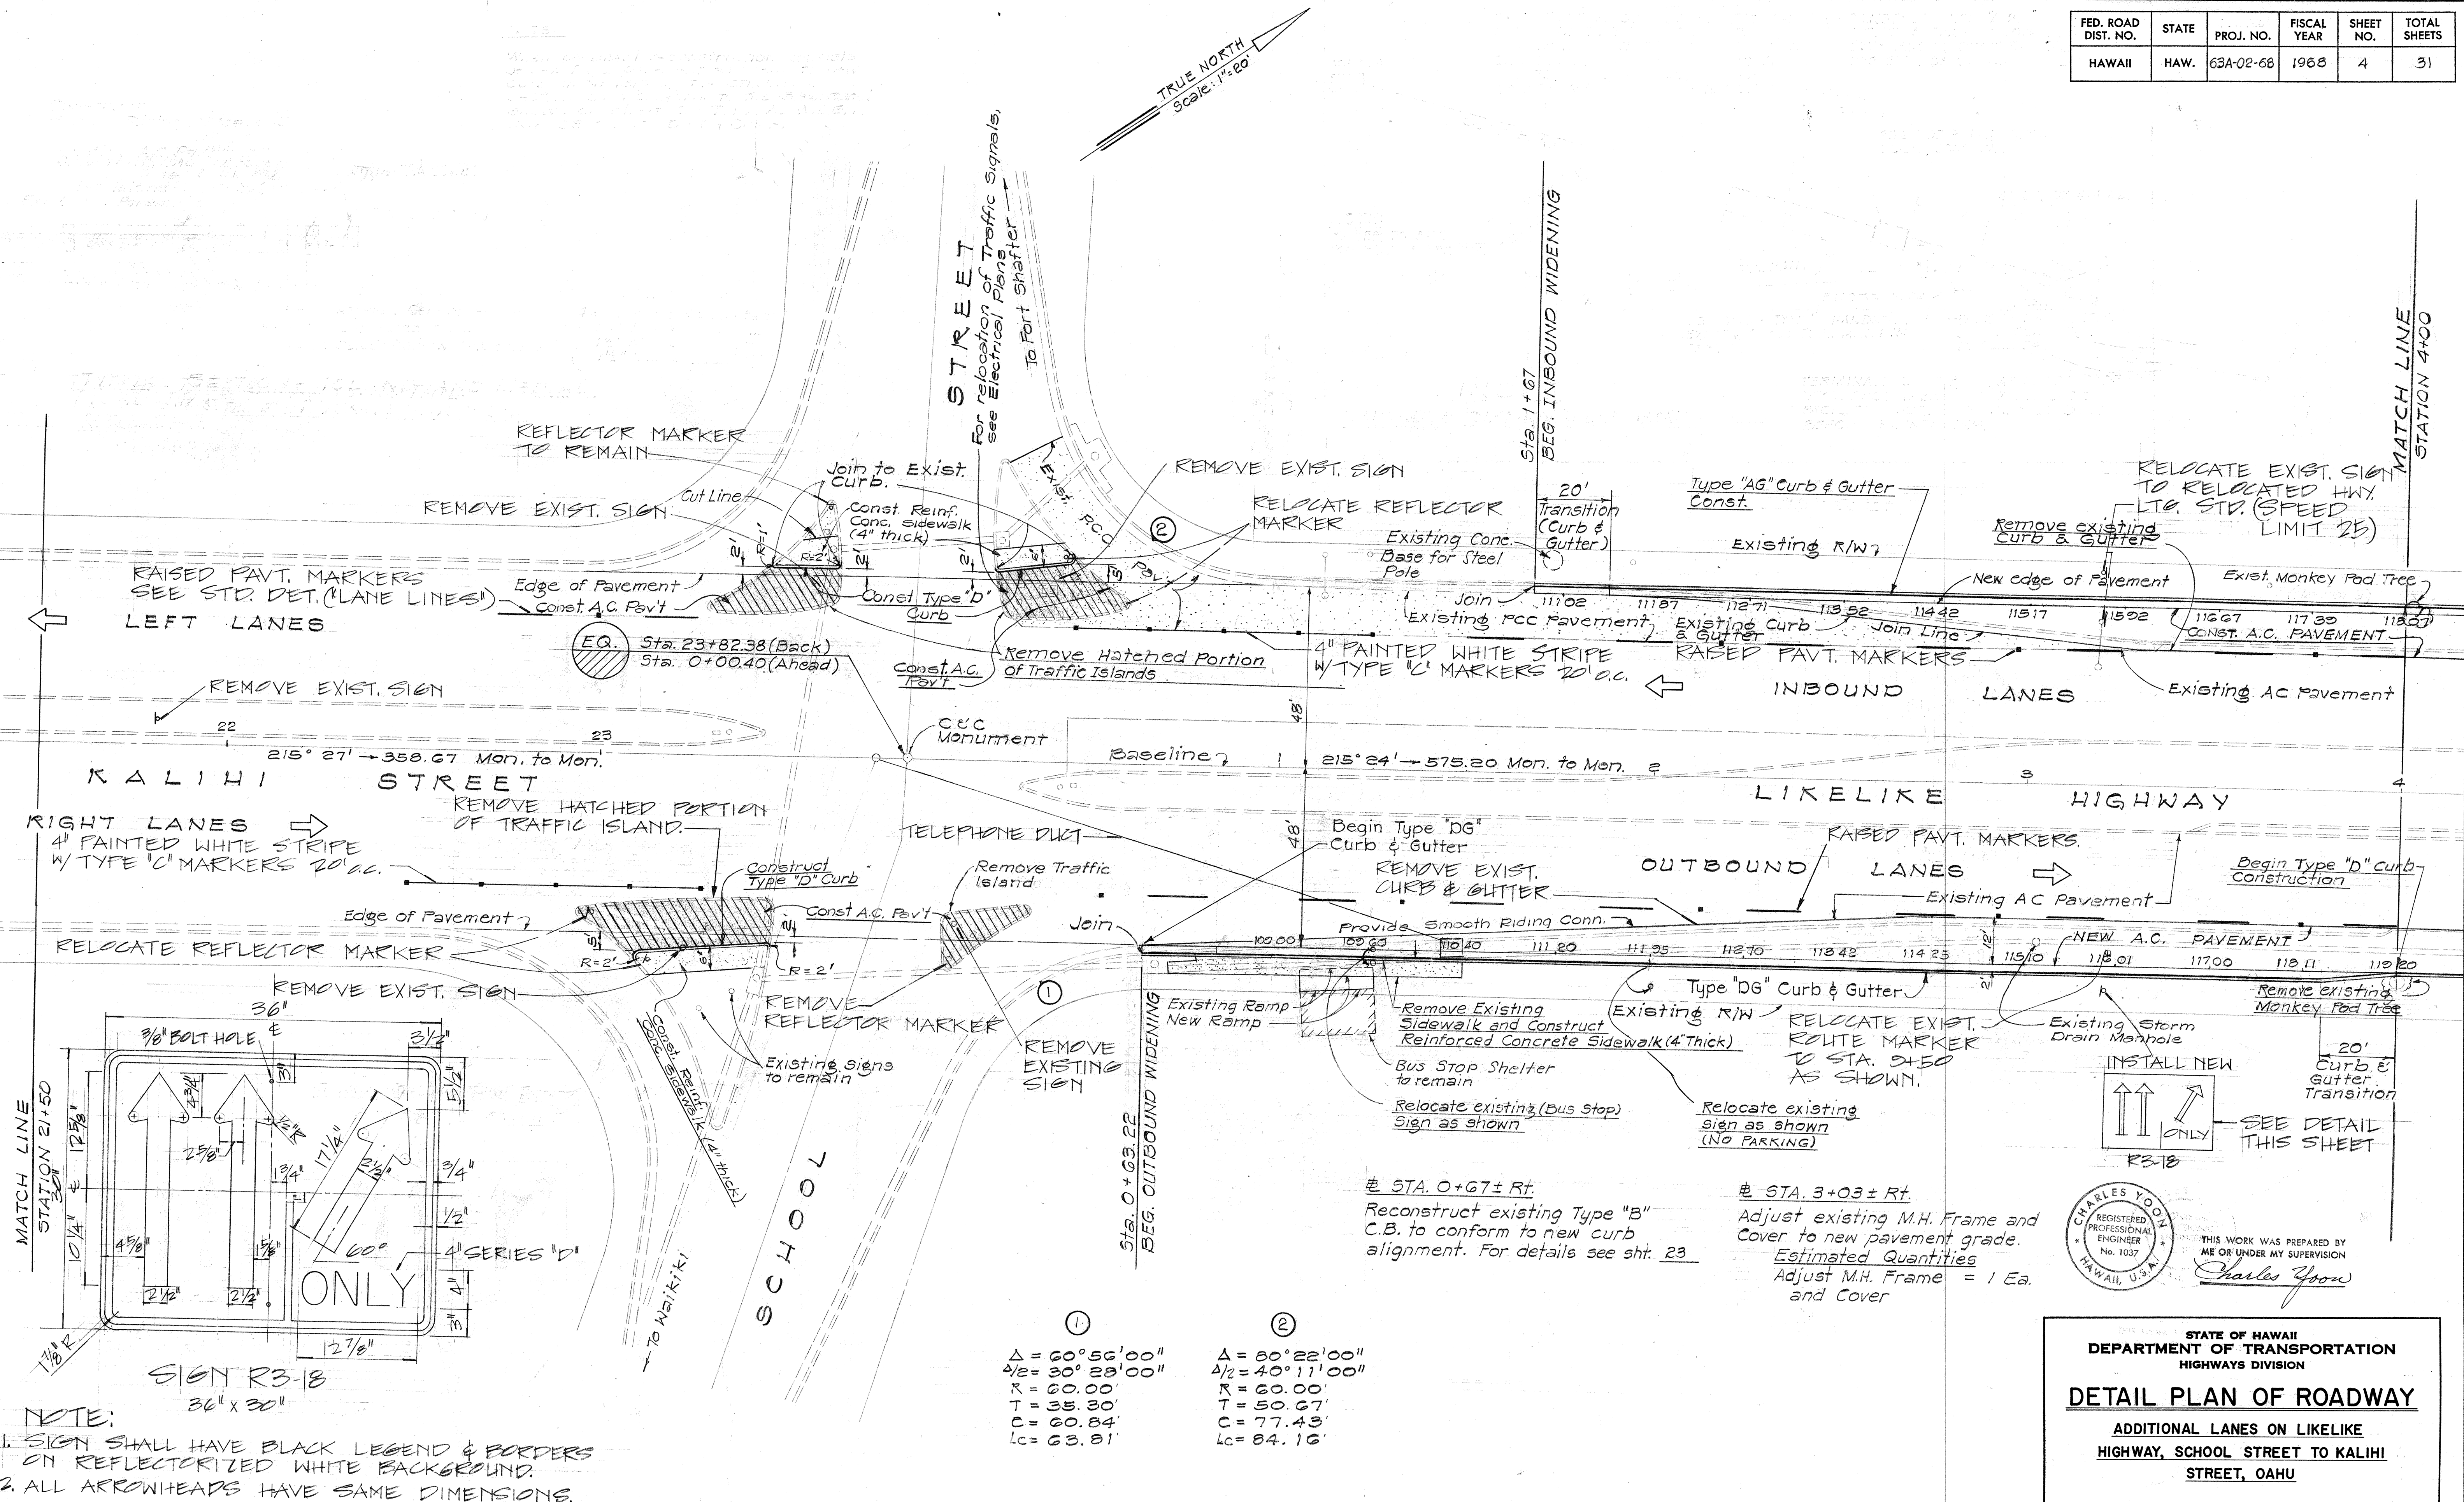

PLAN	DRAWN BY _____	44
	TRACED BY _____	45
NOTE BOOK	DESIGNED BY _____	46
	QUANTITIES BY _____	47
No. _____	CHECKED BY _____	48
		49

PRINTED ON NO. 1000M CLEARPRINT

Proj. No. 63 A-02-68
Scale: As Shown
August, 1968

SHEET No. 2 OF 3 SHEETS

