



[illegible]

FED ROAD DIST. NO	STATE	PROJ. NO.	FISCAL YEAR	SHEET NO.	TOTAL SHEETS
HAWAII	HAW.	63A-02-G8	1968	1	31

STATE OF HAWAII
DEPARTMENT OF TRANSPORTATION
HIGHWAYS DIVISION
HONOLULU, HAWAII
AS BUILT
PLANS FOR
CONSTRUCTION OF
ADDITIONAL LANES
ON LIKELIKE HIGHWAY
(SCHOOL STREET TO KALIHI STREET)
PROJECT No. 63A-02-68
DISTRICT OF HONOLULU
ISLAND OF OAHU

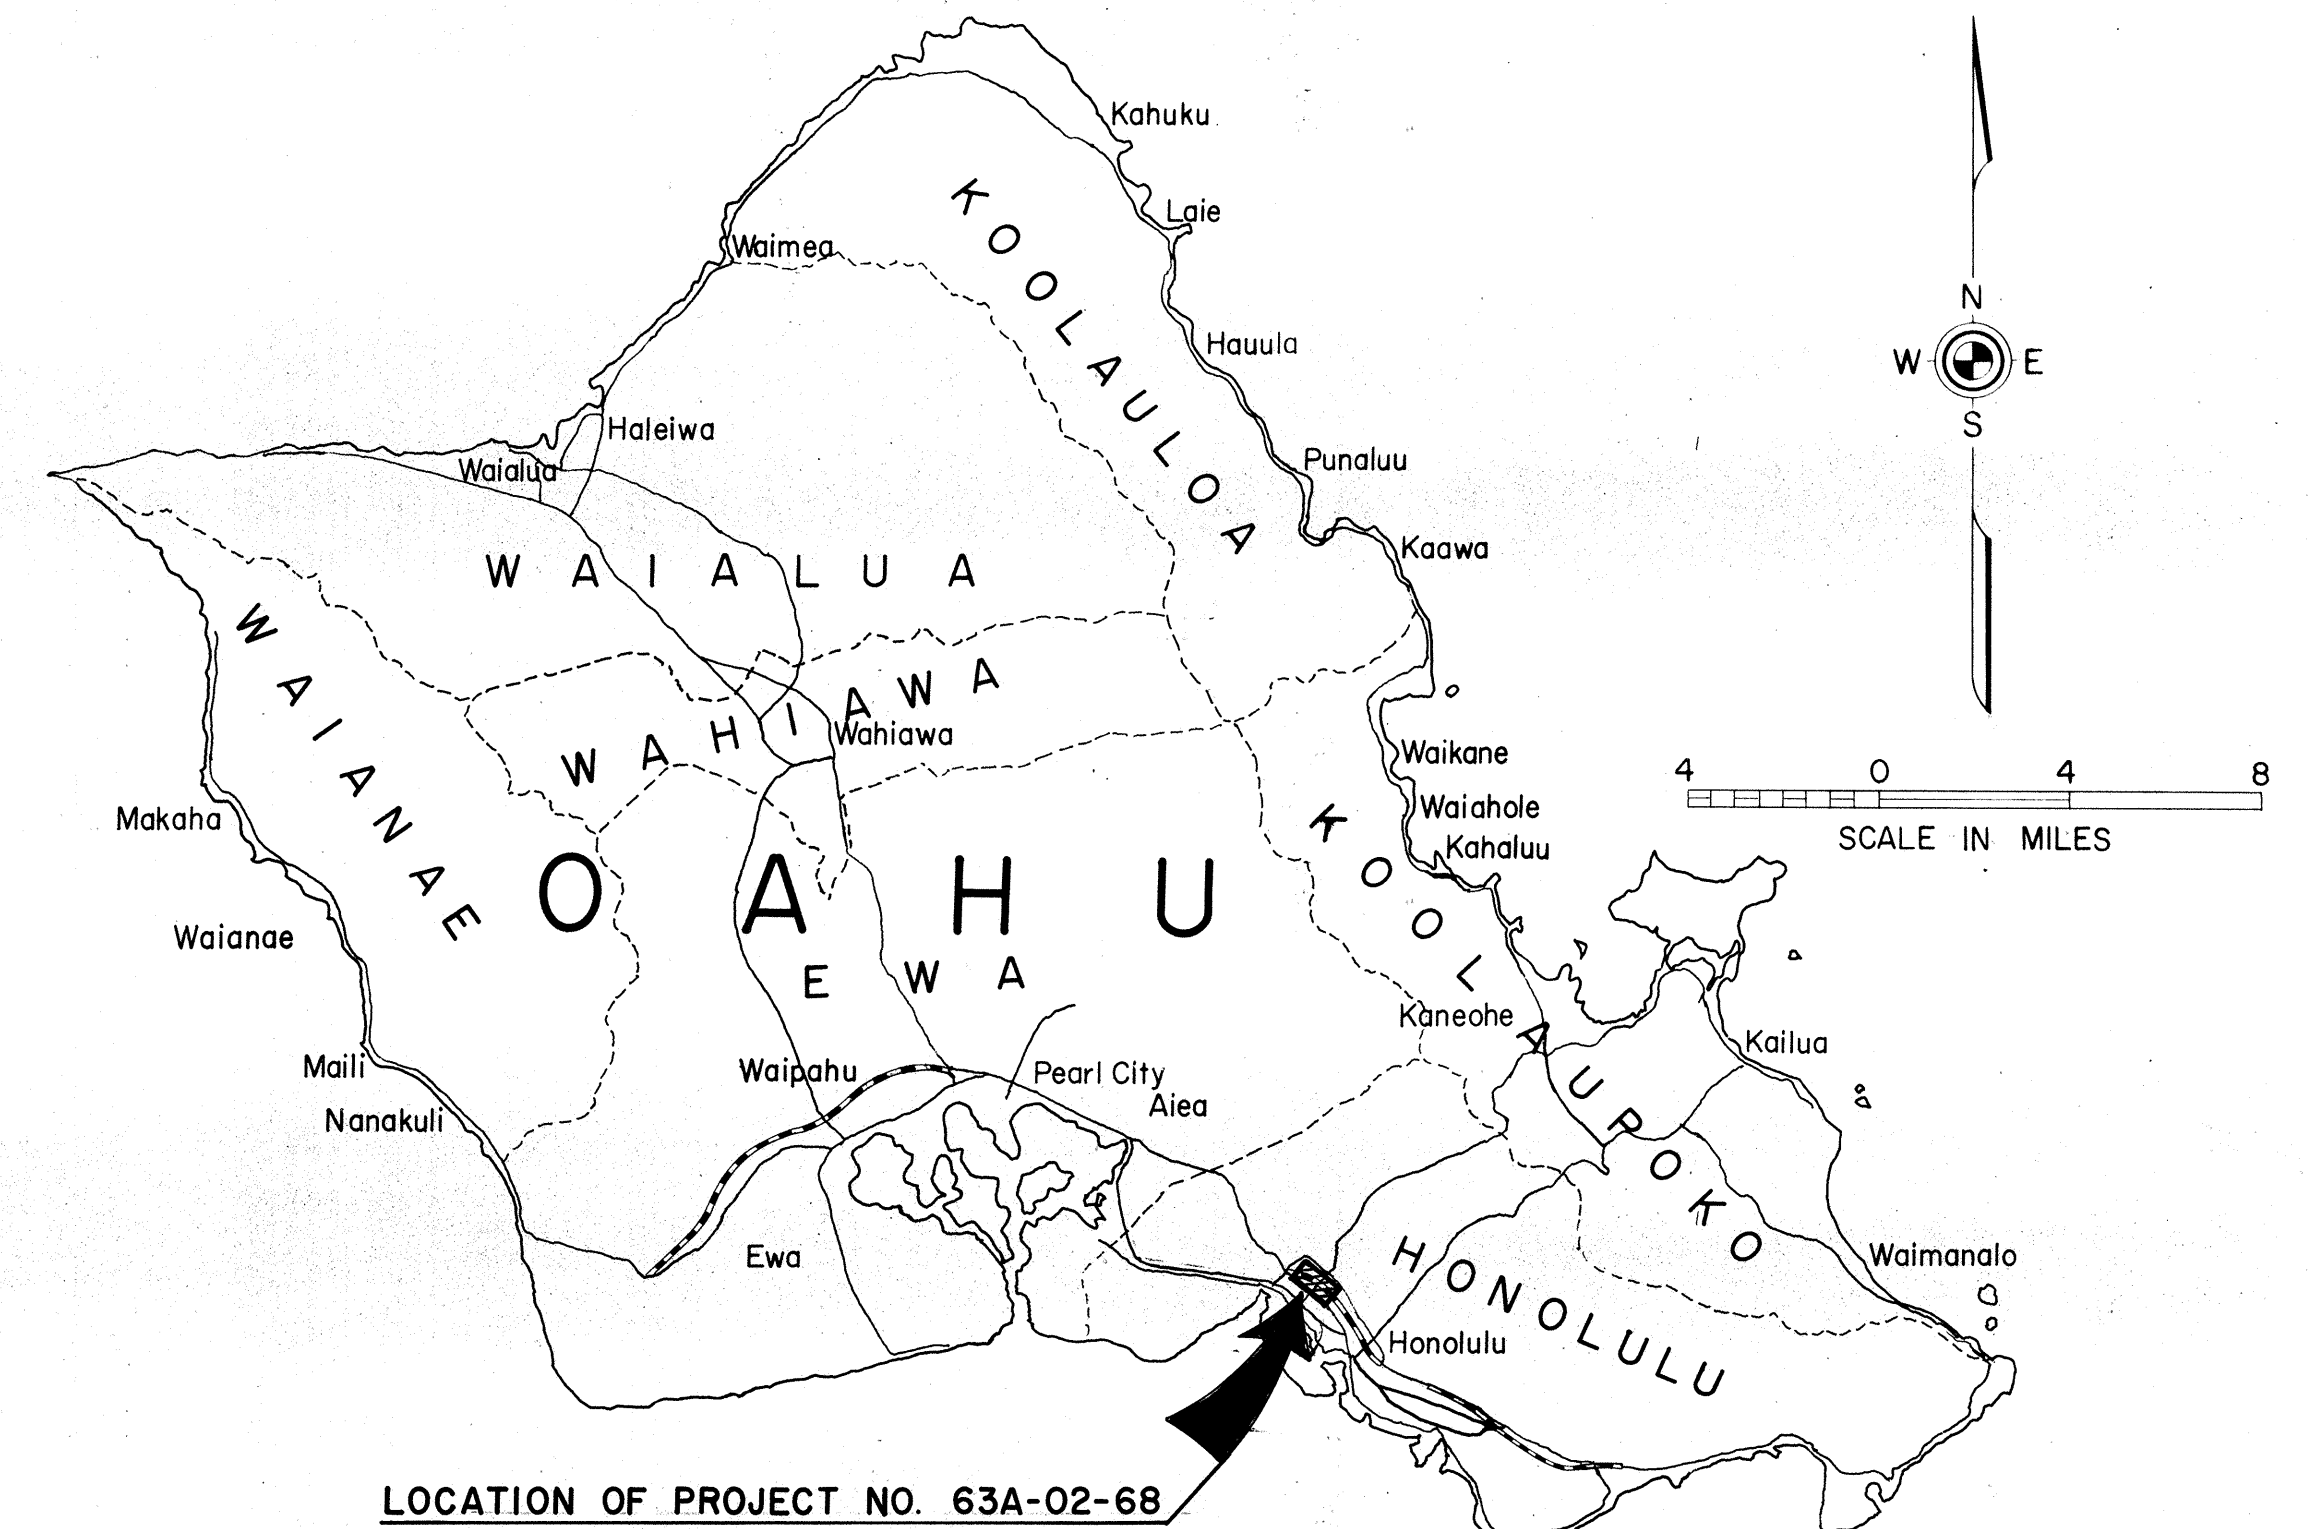


 Federal Aid Interstate Projects Previously Constructed or Under Construction.

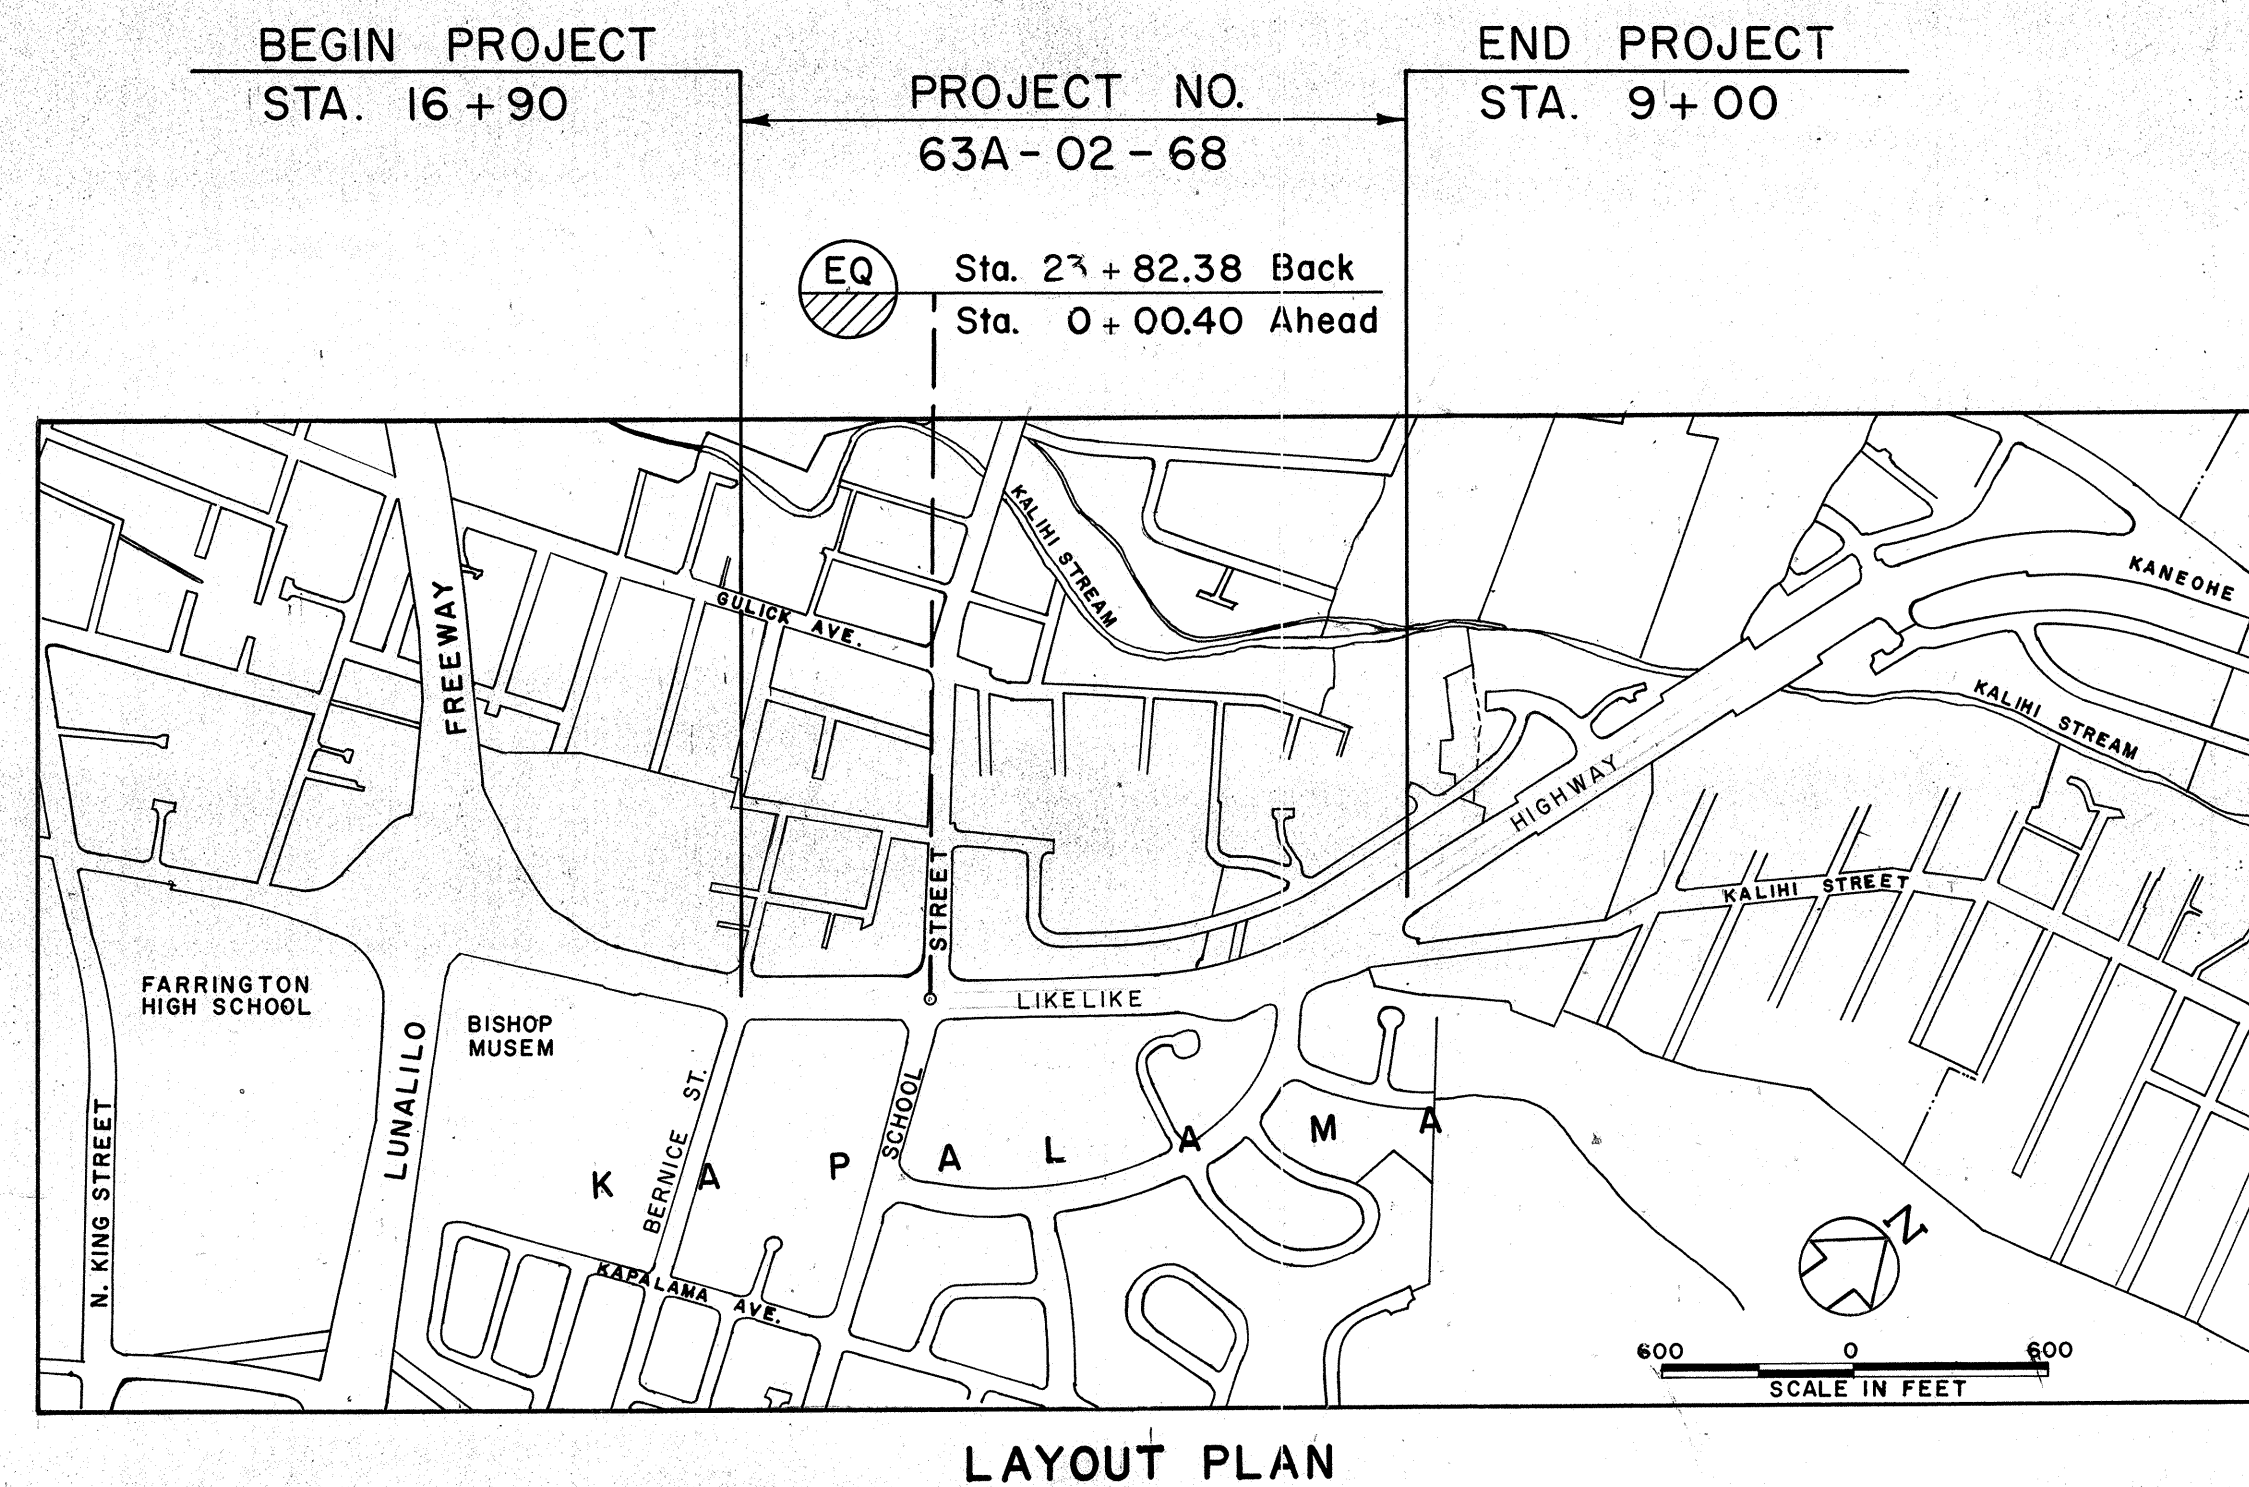

LAYOUT PLAN

NOTE:
ALL CHANGES MADE DURING
CONSTRUCTION HAVE BEEN
NOTED IN THESE TRACINGS IN
RED AND CHECKED BY

George C. Knauff
RESIDENT ENGINEER
12/30/70
DATE

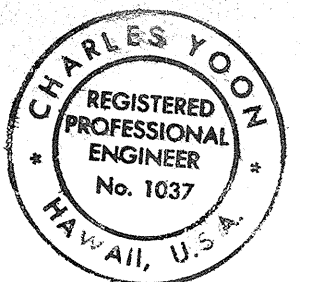

THIS WORK WAS PREPARED BY
ME OR UNDER MY SUPERVISION

Charles Yoon

LENGTH OF PROJECT 0.302 Mi.

CURRENT ADT. (1967) 24,620

DEPARTMENT OF TRANSPORTATION STATE OF HAWAII	
APPROVED: <i>E. Alvey Knight</i> 4/11/69	
DIR. OF TRANSPORTATION	DATE

DESIGNED BY: Charles Yoon & Assoc., Inc.
P. S. & E. BY: M. Miura
PHONE 548-2211 Local 301