



FED. ROAD DIST. NO.	STATE	FED. AID PROJ. NO.	FISCAL YEAR	SHEET NO.	TOTAL SHEETS
HAWAII	HAW.	F-063-1(9)	1969	2	15

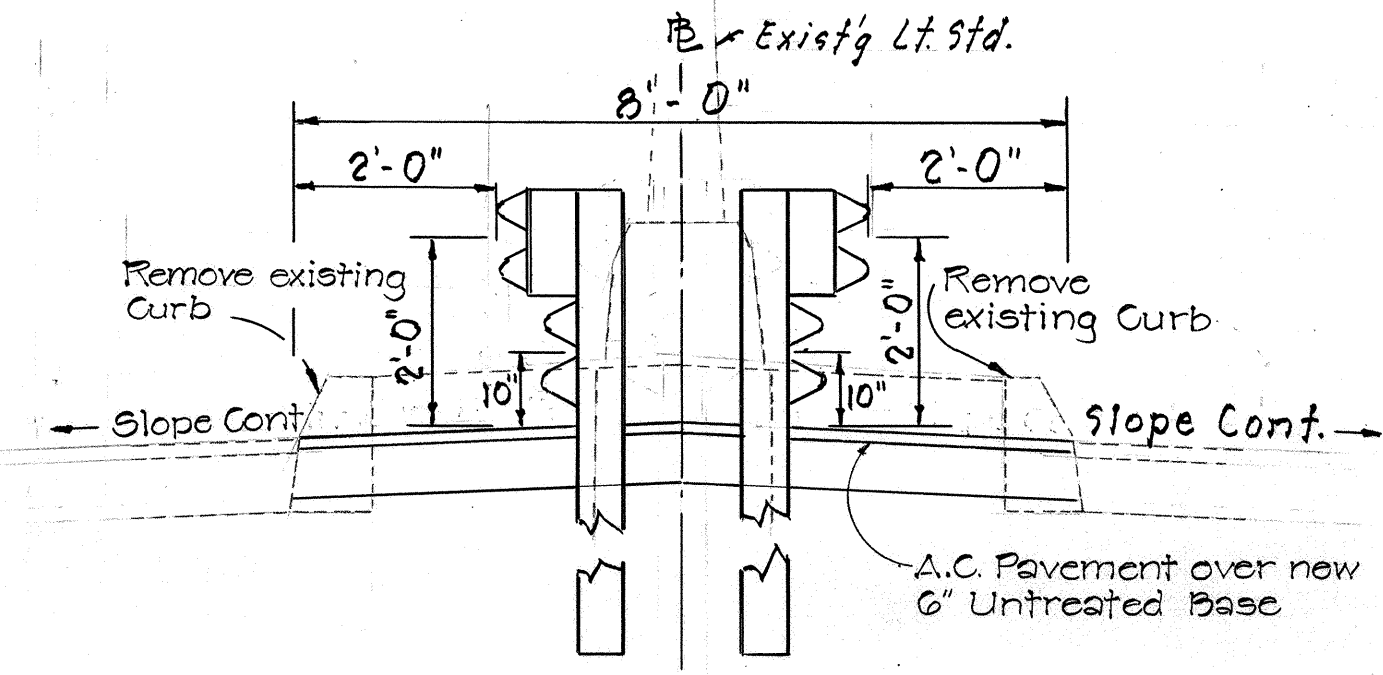


SECTION "A"

Scale: 1/8" = 1'-0"

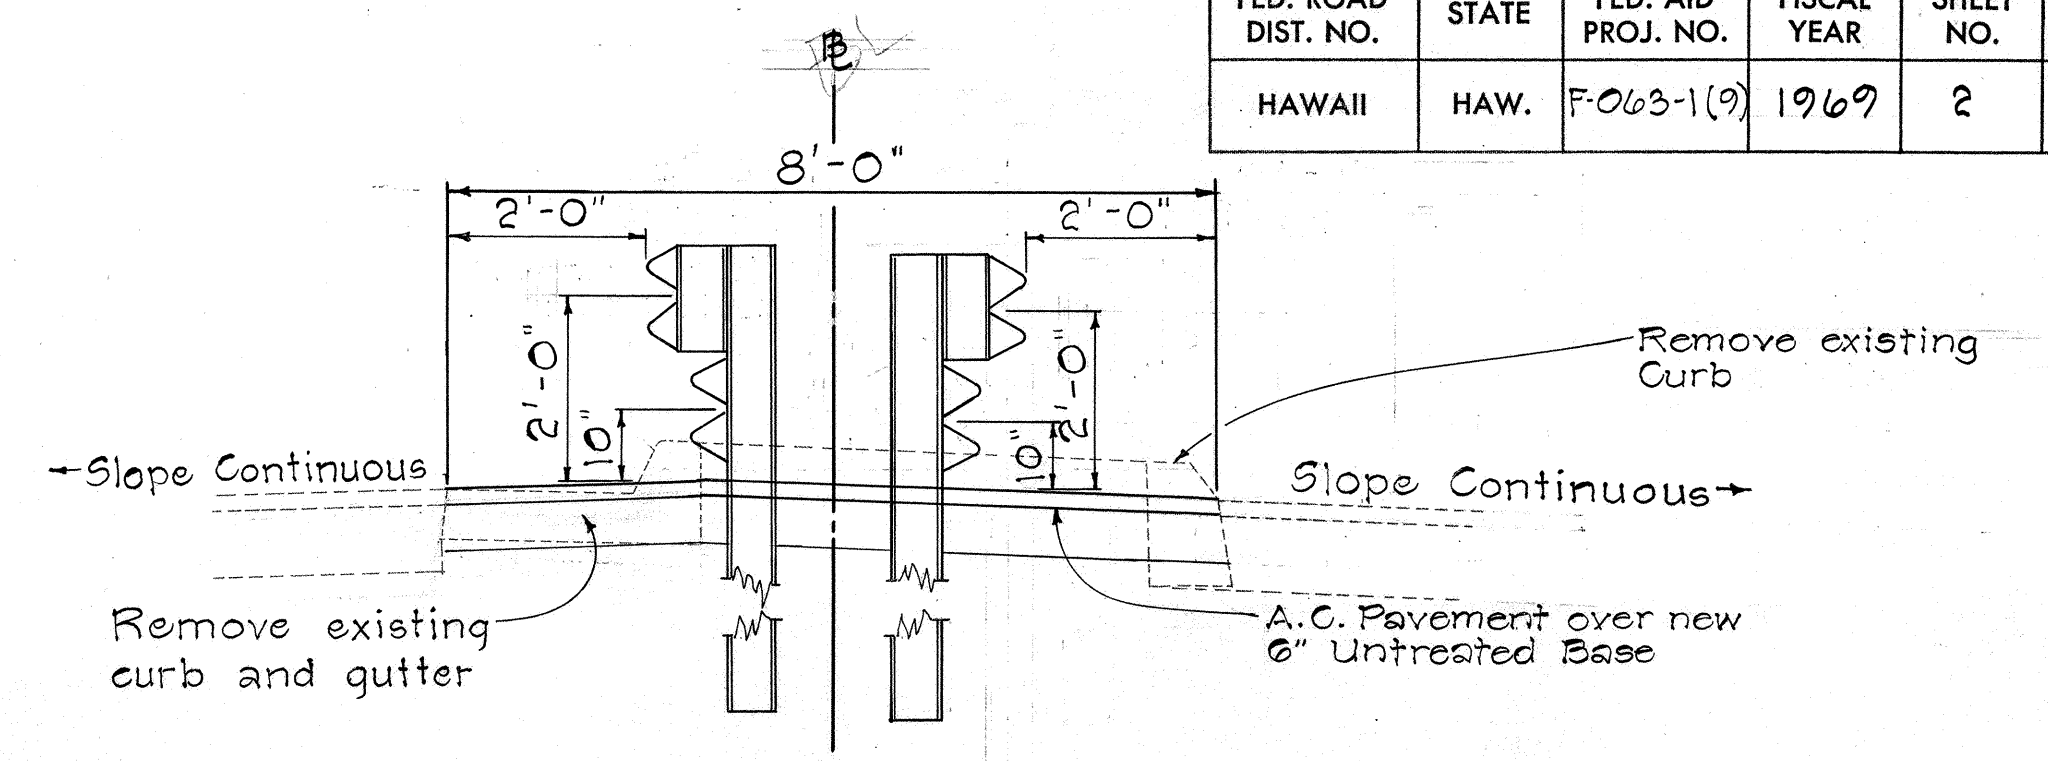


SECTION "E"

Scale: 1/8" = 1'-0"

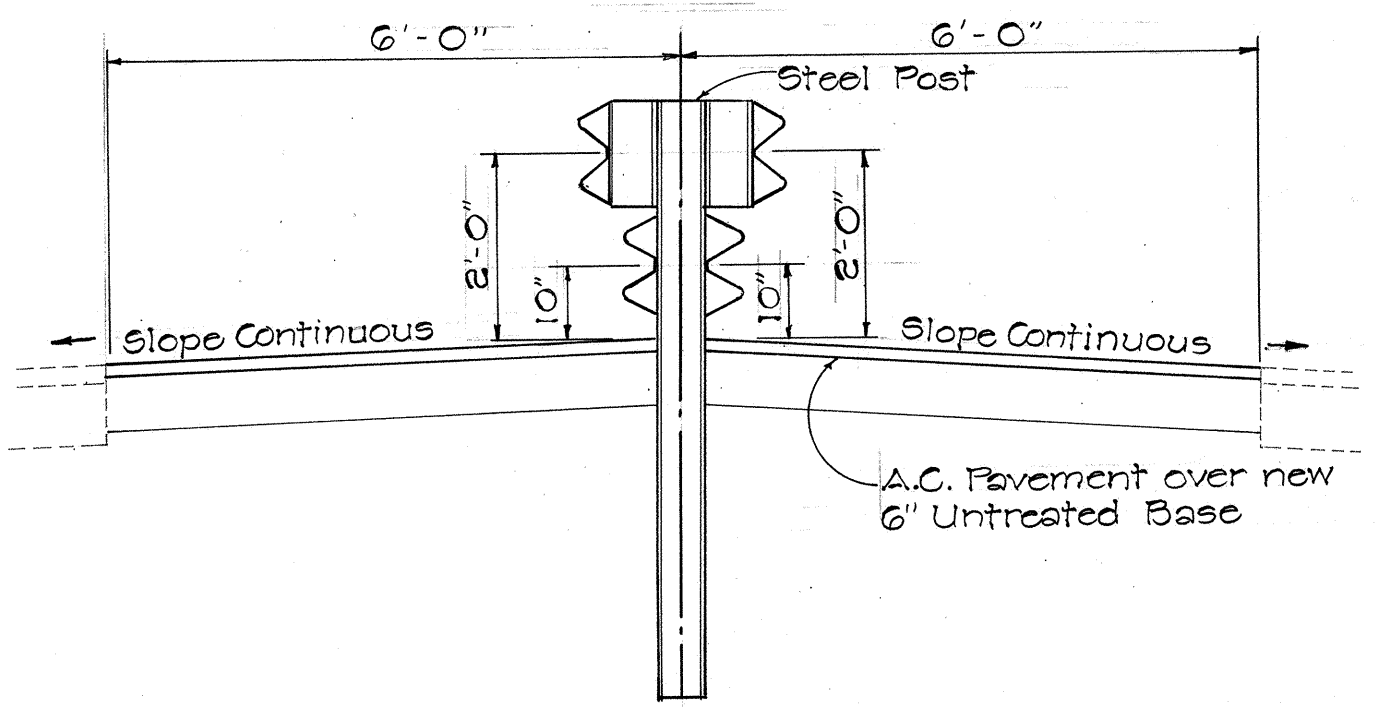

SECTION "C"

Scale: 1/8" = 1'-0"

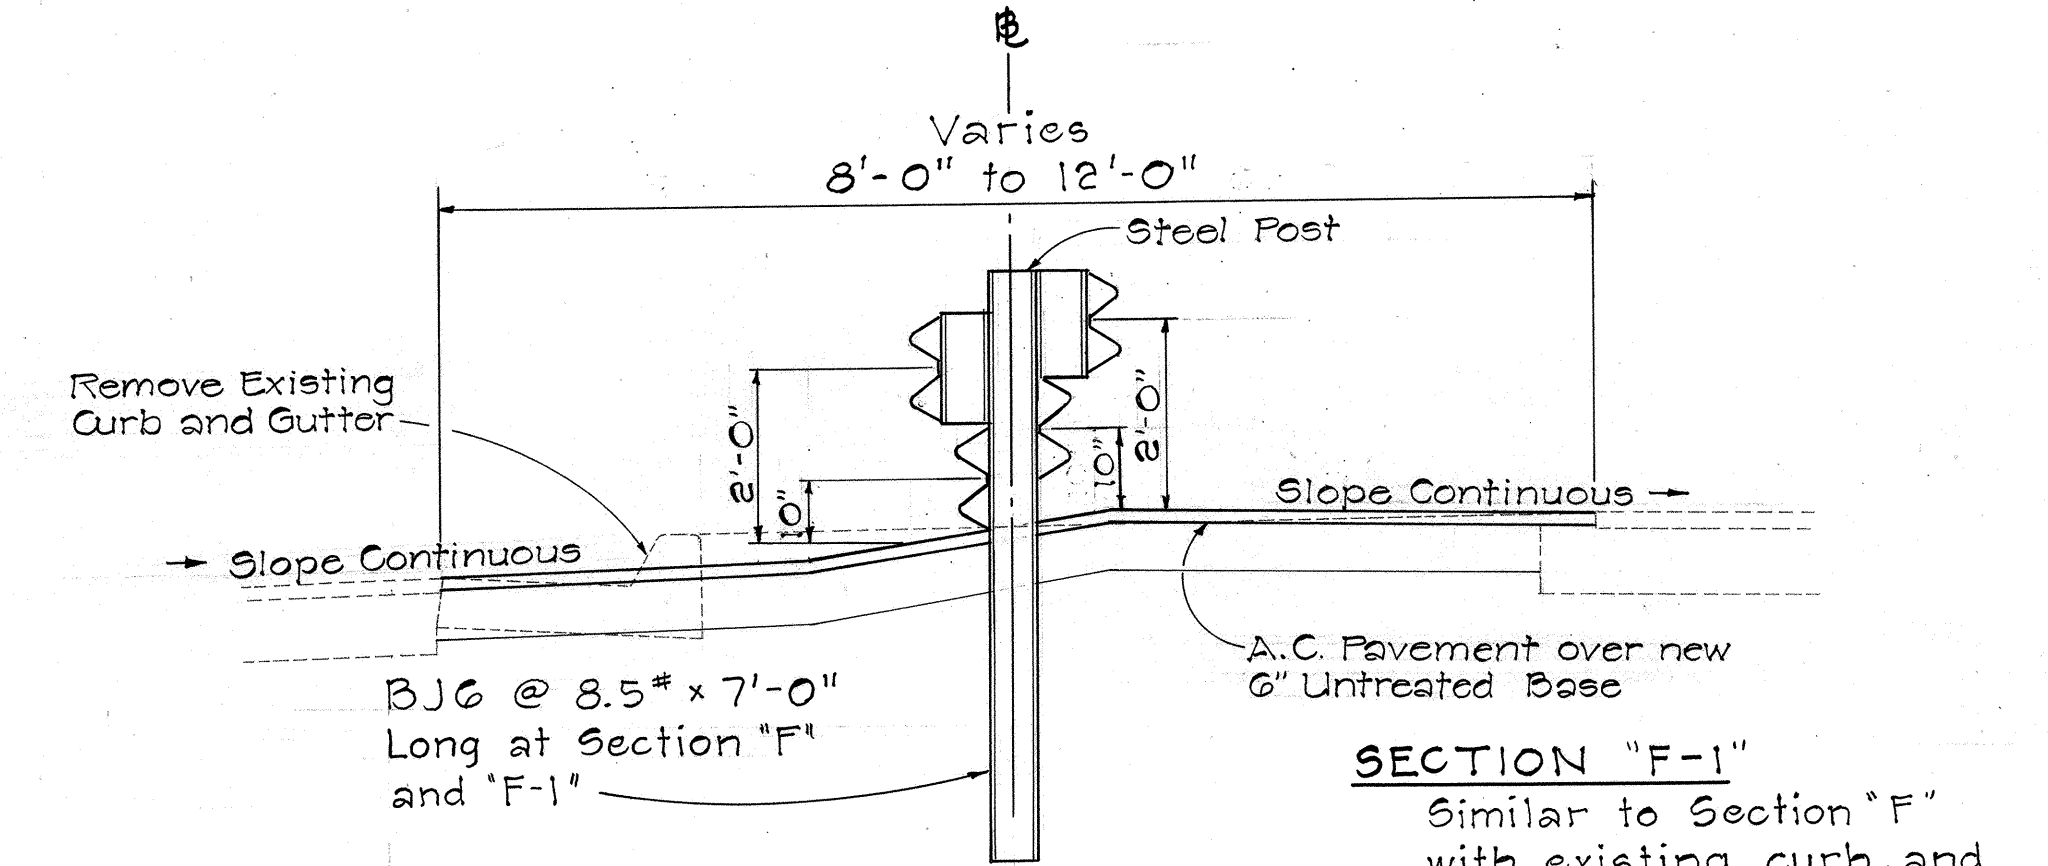


SECTION "F-1"

Similar to Section "F" with existing curb and gutter on right side.


SECTION "F"

Scale: 1/8" = 1'-0"

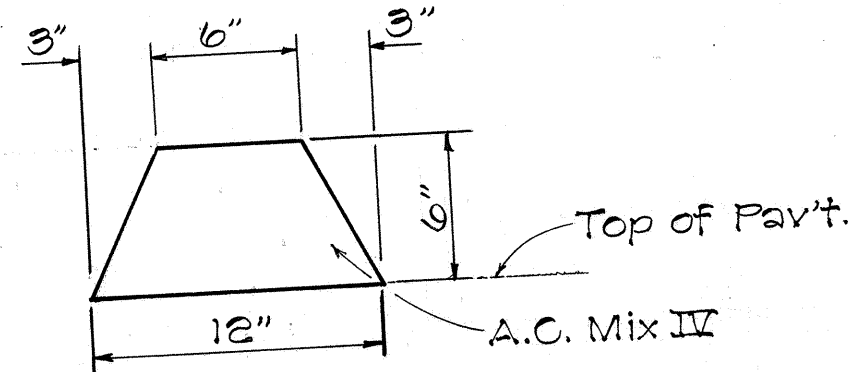


A.C. CURB

Scale: 1/8" = 1'-0"

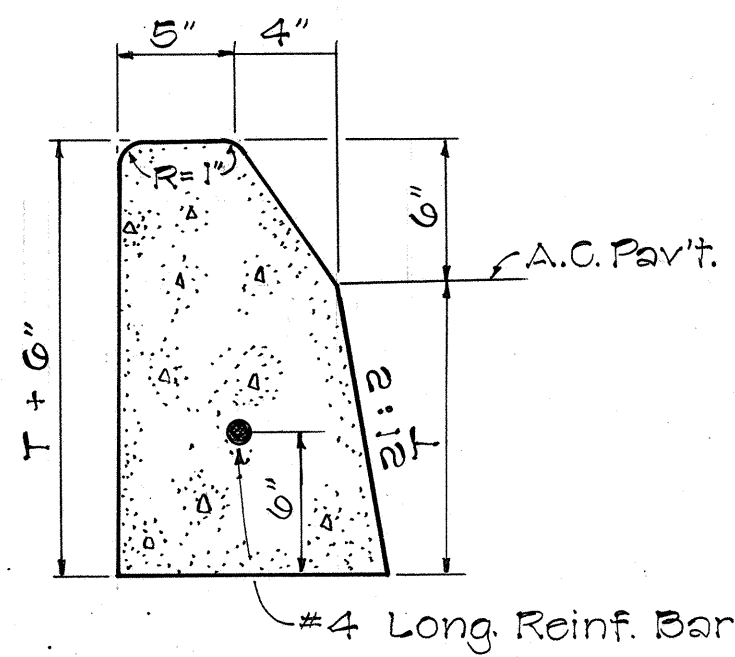


TYPE "A" CURB

Scale: 1/8" = 1'-0"

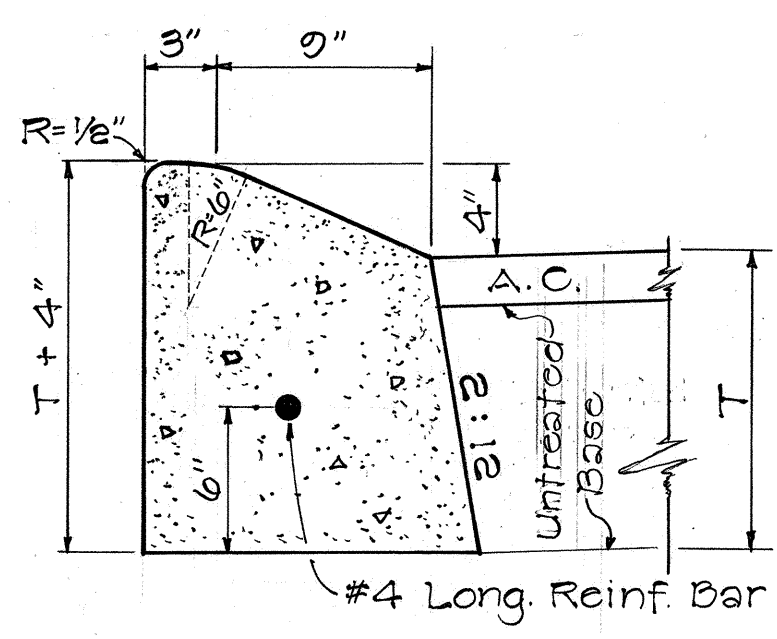


TYPE "E" CURB

Scale: 1/8" = 1'-0"

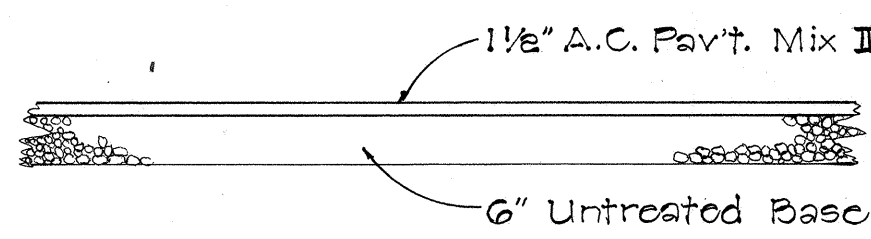

TYPICAL SECTION

Scale: 1/8" = 1'-0"

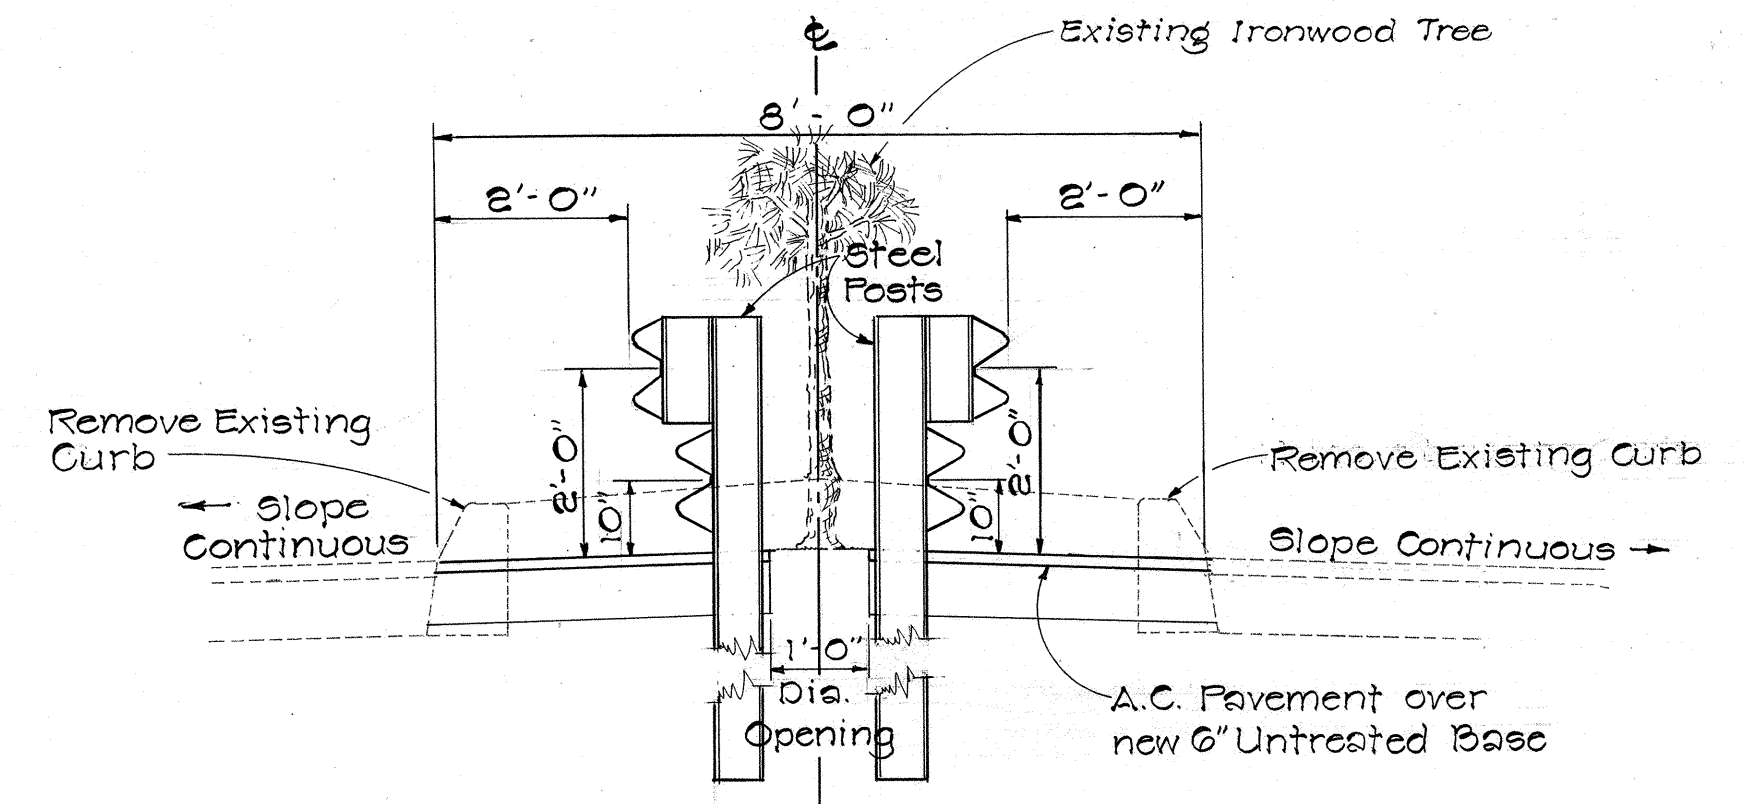

SECTION "G"

Scale: 1/8" = 1'-0"

STATE OF HAWAII
DEPARTMENT OF TRANSPORTATION
HIGHWAYS DIVISION

TYPICAL SECTIONS

F.A. PROJ. NO. F-063-1(9)

Scale: As Noted Date: March 1969

SHEET No. 1 OF 1 SHEETS

DATE	
DESIGNED BY	
TRACED BY	
NOTE BOOK	
CHECKED BY	