INDEX TO DRAWINGS	
SHEET NO.	DESCRIPTION
1	TITLE SHEET
	PROJECT No. F - 063 - 1(9)
2	TYPICAL SECTIONS
3-5	GUARDRAIL LAYOUT
6	CATCH BASIN RECONSTRUCTION
1.00	PROJECT No. U-063-1(7)
7	ROADWAY PLAN
8	MEDIAN GUARDRAIL RELOCATION
9-15	STANDARD DETAILS
1 3	

STATE OF HAWAII

DEPARTMENT OF TRANSPORTATION
HIGHWAYS DIVISION

HONOLULU, HAWAII

"AS BUILT"

PLANS FOR


INSTALLATION OF MEDIAN GUARDRAIL
ON LIKELIKE HIGHWAY


VALLEY VIEW DRIVE TO WILSON TUNNEL FEDERAL AID PROJECT NO. F-063-1(9)

AND

LIKELIKE HIGHWAY IMPROVEMENTS AT KULA KOLEA DRIVE FEDERAL AID URBAN PROJECT NO. U-063-I(7)

DISTRICT OF HONOLULU ISLAND OF OAHU

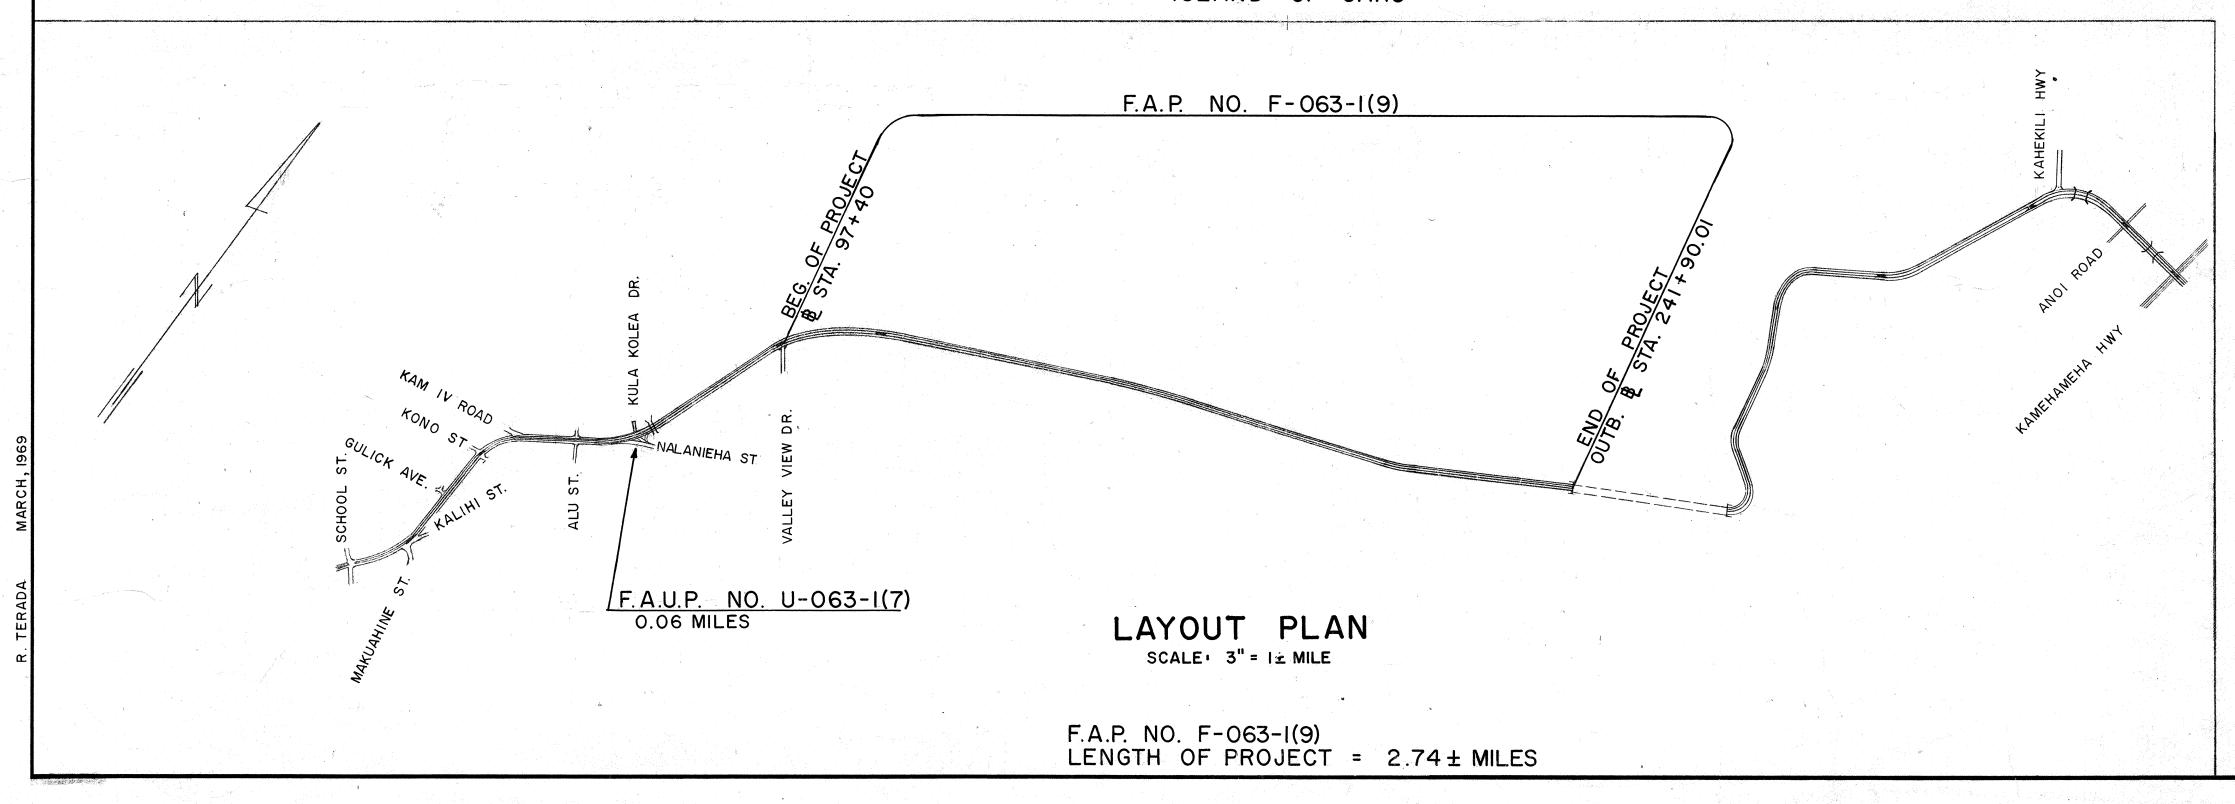

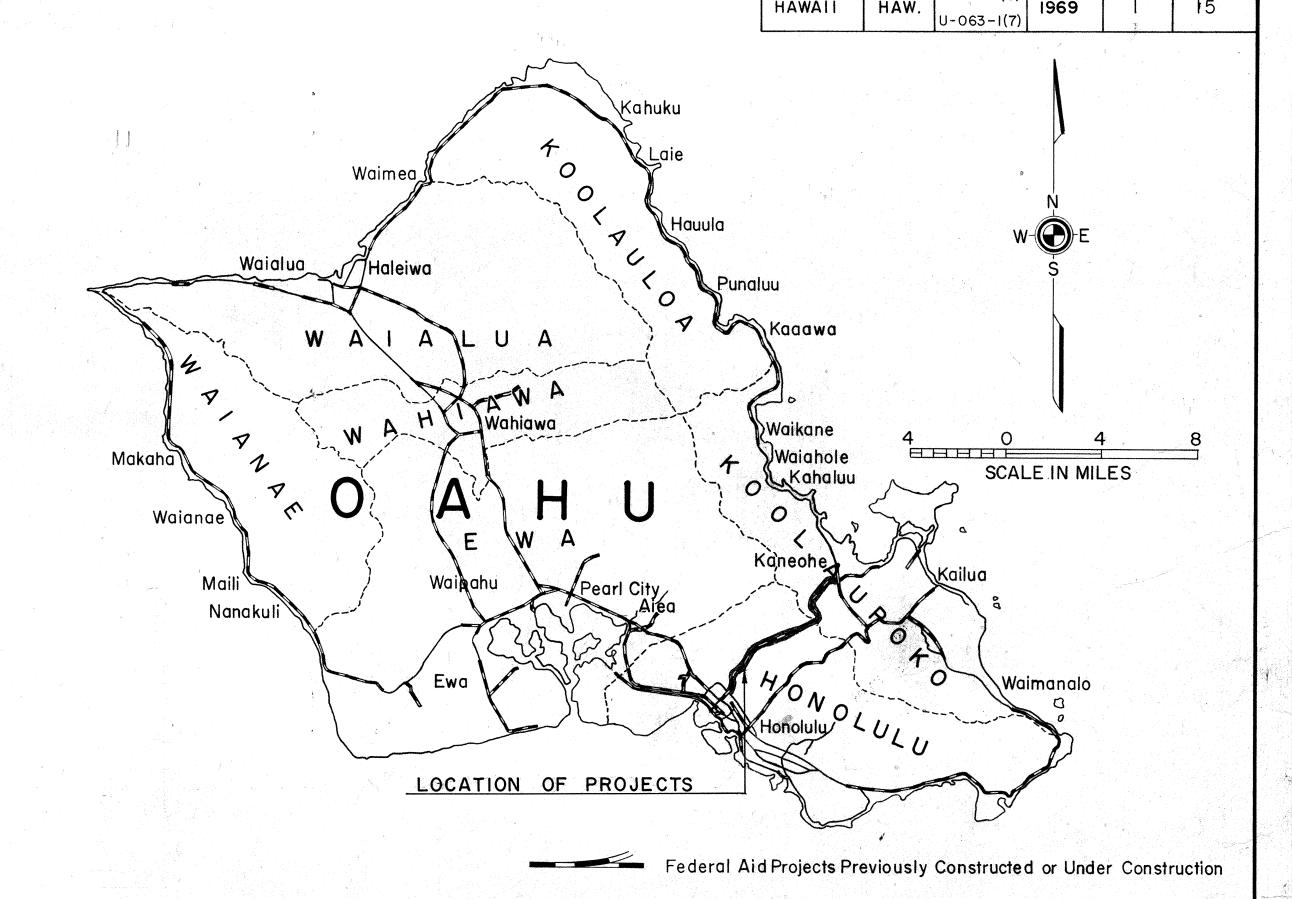

NO CHANGE WAS MADE DURING CONSTRUCTION OF THIS PROJECT.

STATE FED. AID FISCAL PROJ. NO. YEAR

P.T. Same paresident Engineer

11-10-81 DATE

DEPARTMENT OF TRANSPORTATION
BUREAU OF PUBLIC ROADS

APPROVED:

Med Dulstings 5369
DIVISION ENGINEER DATE

DEPARTMENT OF TRANSPORTATION
STATE OF HAWAII

APPROVED:

DIR. OF TRANSPORTATION DATE

j