


FED. ROAD DIST. NO.	STATE	FED. AID PROJ. NO.	FISCAL YEAR	SHEET NO.	TOTAL SHEETS
HAWAII	HAW.	U-063-1(7)	1963	8	15


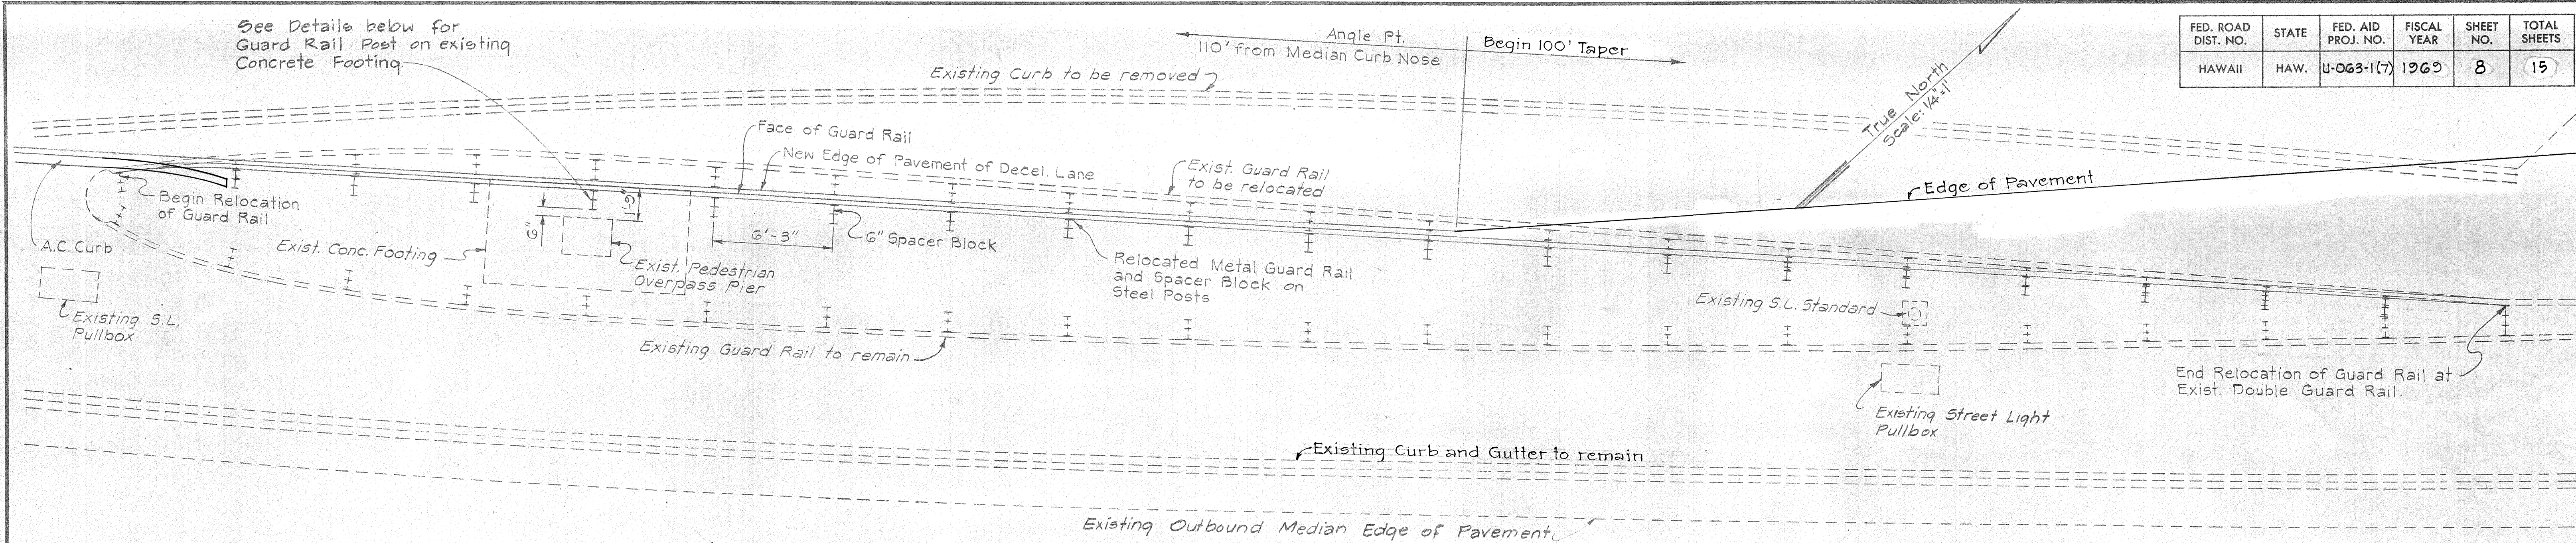


MEDIAN GUARD RAIL PLAN

Scale: 1/4" = 1'-0"

NOTES FOR RECONSTRUCTING GUARD RAILS

1. It is intended that the Contractor shall make use of all posts, rails, spacer blocks and fittings salvaged from the existing guard rail that have not deteriorated, in the Engineers opinion, to an extent precluding their use in the reconstructed guard rail.
2. If existing posts are found to be damaged or deformed upon removal, the State will furnish replacement posts to be installed by the Contractor. However, any salvable materials damaged through the Contractor's negligence, shall be replaced at his own expense.
3. The cost of constructing and installing the metal guard rail post on the existing concrete footing, including all new materials required shall be considered as included in the payment for "Reconstructed Guard Rail" Contract Item No. 81.03 and no additional compensation shall be made thereof.

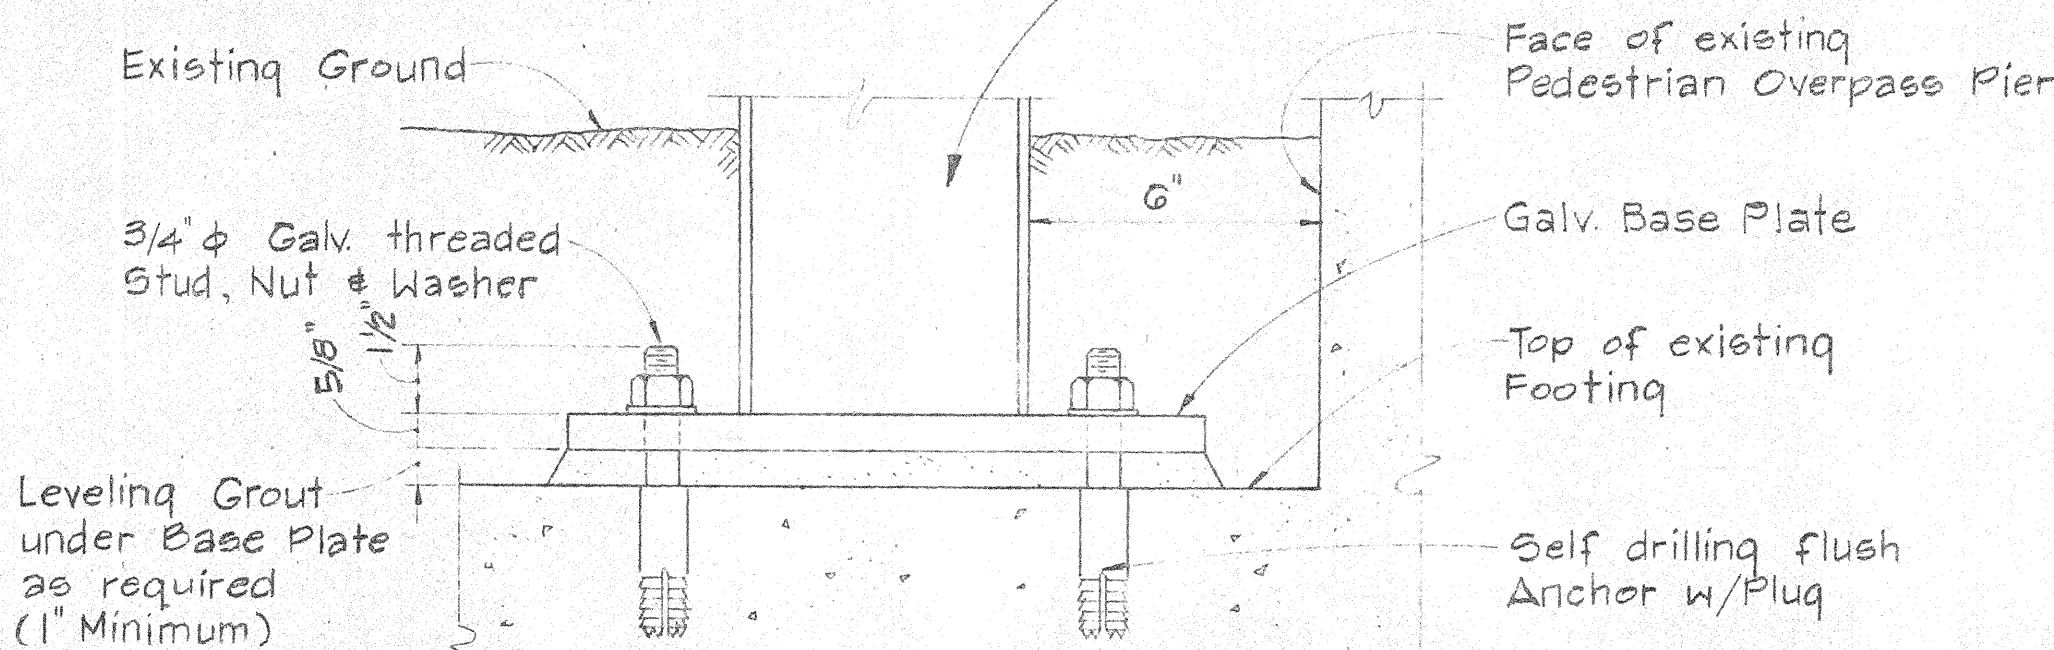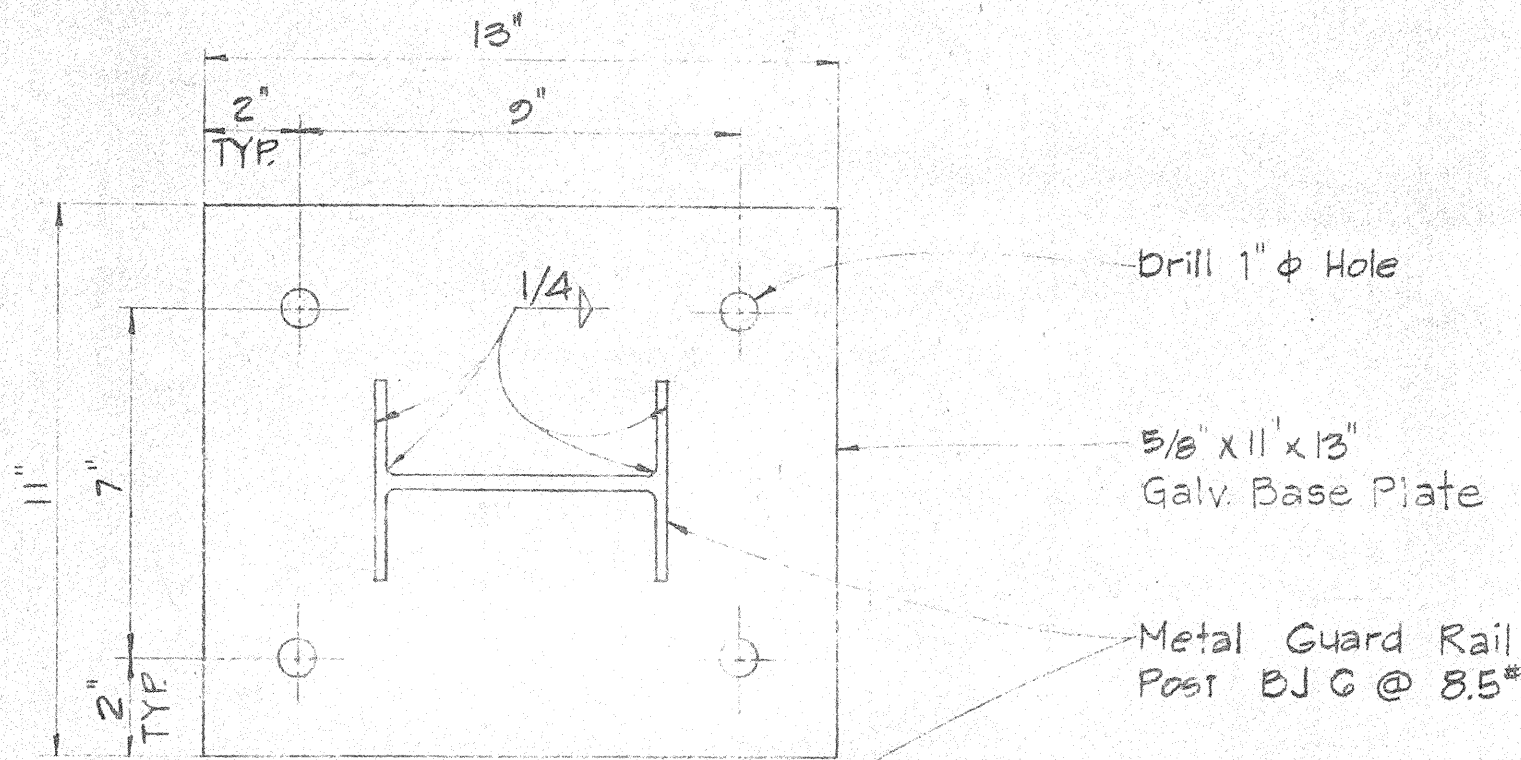

BASE PLATE DETAIL AT TOP OF FOOTING

DETAILS FOR INSTALLING GUARD RAIL POST ON EXISTING CONCRETE FOOTING

Scale: 3" = 1'-0"

STATE OF HAWAII
DEPARTMENT OF TRANSPORTATION
HIGHWAYS DIVISION
MEDIAN GUARD RAIL
RELOCATION PLAN
KULA KOLEA DRIVE

F.A.U. Proj. No. U-063-1(7)

Scale: As Shown

Date: Mar. 1963

SHEET No. 2 OF 2 SHEETS.