


SCALE IN MILES

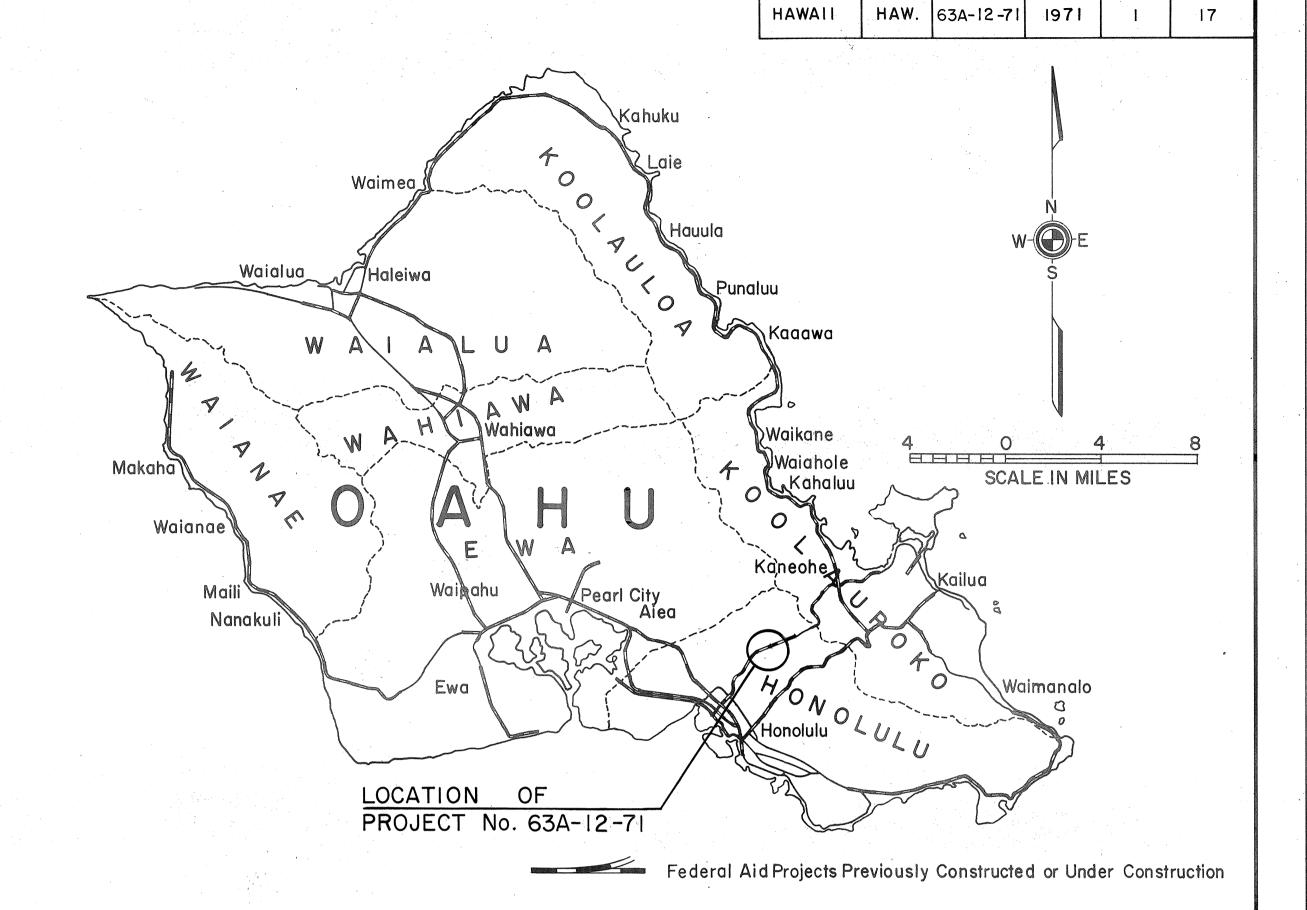

NOTE:

ALL CHANGES MADE DURING CONSTRUCTION HAVE BEEN INCORPORATED ON THESE PLANS EXCEPT CHANGES IN THE ORIGINAL THEORETICAL QUANTITIES. FOR ACTUAL QUANTITIES REFER TO THE PROJECT LEDGER AND/OR PROJECT MEASUREMENT BOOK.

FED. ROAD STATE

FISCAL YEAR

PROJ. NO.

SHEET NO.

PROJECT ENGINEER

7-24-73 DATE

LAYOUT PLAN

LENGTH OF PROJECT. .3.244 MILES

DEPARTMENT OF TRANSPORTATION
STATE OF HAWAII

APPROVED:

3/3/21

. 15ev

1