


INDEX TO DRAWINGS	
SHEET NO.	DESCRIPTION
1	TITLE SHEET
2-3	DETAIL PLAN
4-6	MISCELLANEOUS ROADWAY DETAILS
7-8	MISC. & STANDARD DRAINAGE DETAILS
9	PROJECT INFORMATION SIGN


STATE OF HAWAII
DEPARTMENT OF TRANSPORTATION
HIGHWAYS DIVISION
HONOLULU, HAWAII
"AS-BUILT"
PLANS FOR
CONSTRUCTION OF
FOOTPATH ALONG LIKELIKE HIGHWAY
KALIHI STREET TO GULICK AVENUE
PROJECT NO. 63A-09-70

DISTRICT OF HONOLULU
ISLAND OF OAHU

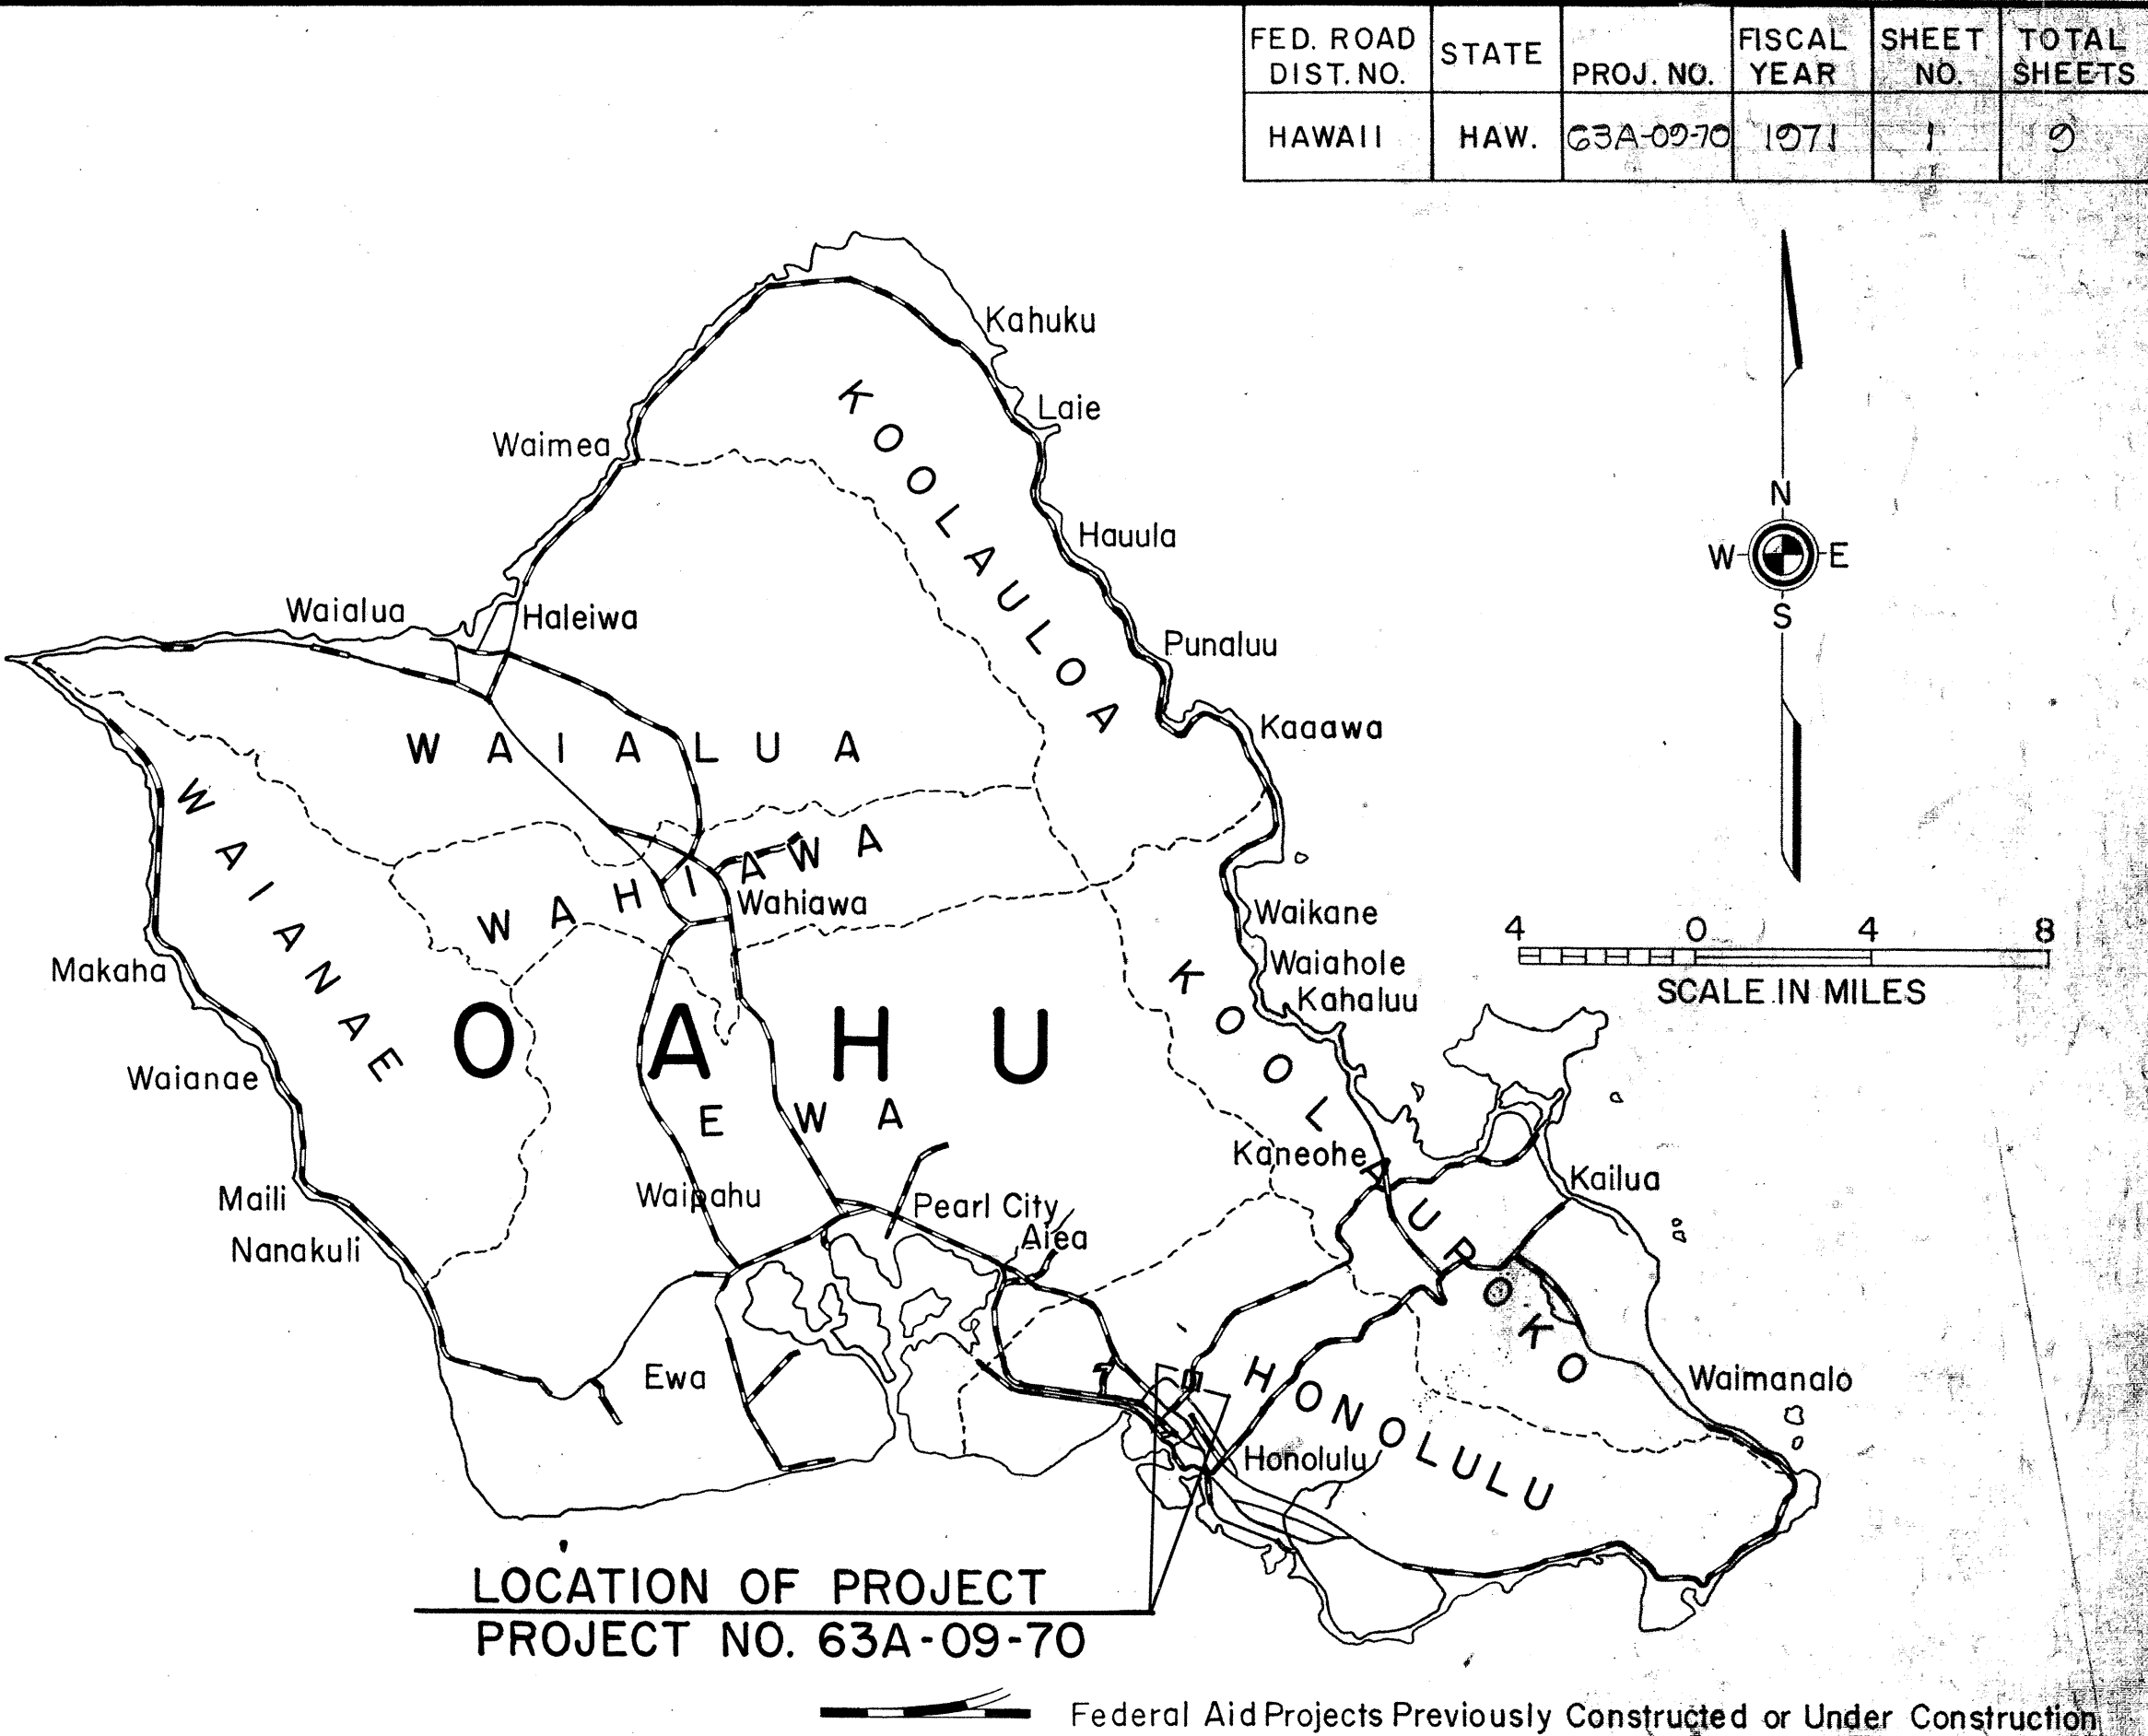

BEG. PROJ. No. 63A-09-70

END PROJ. No. 63A-09-70

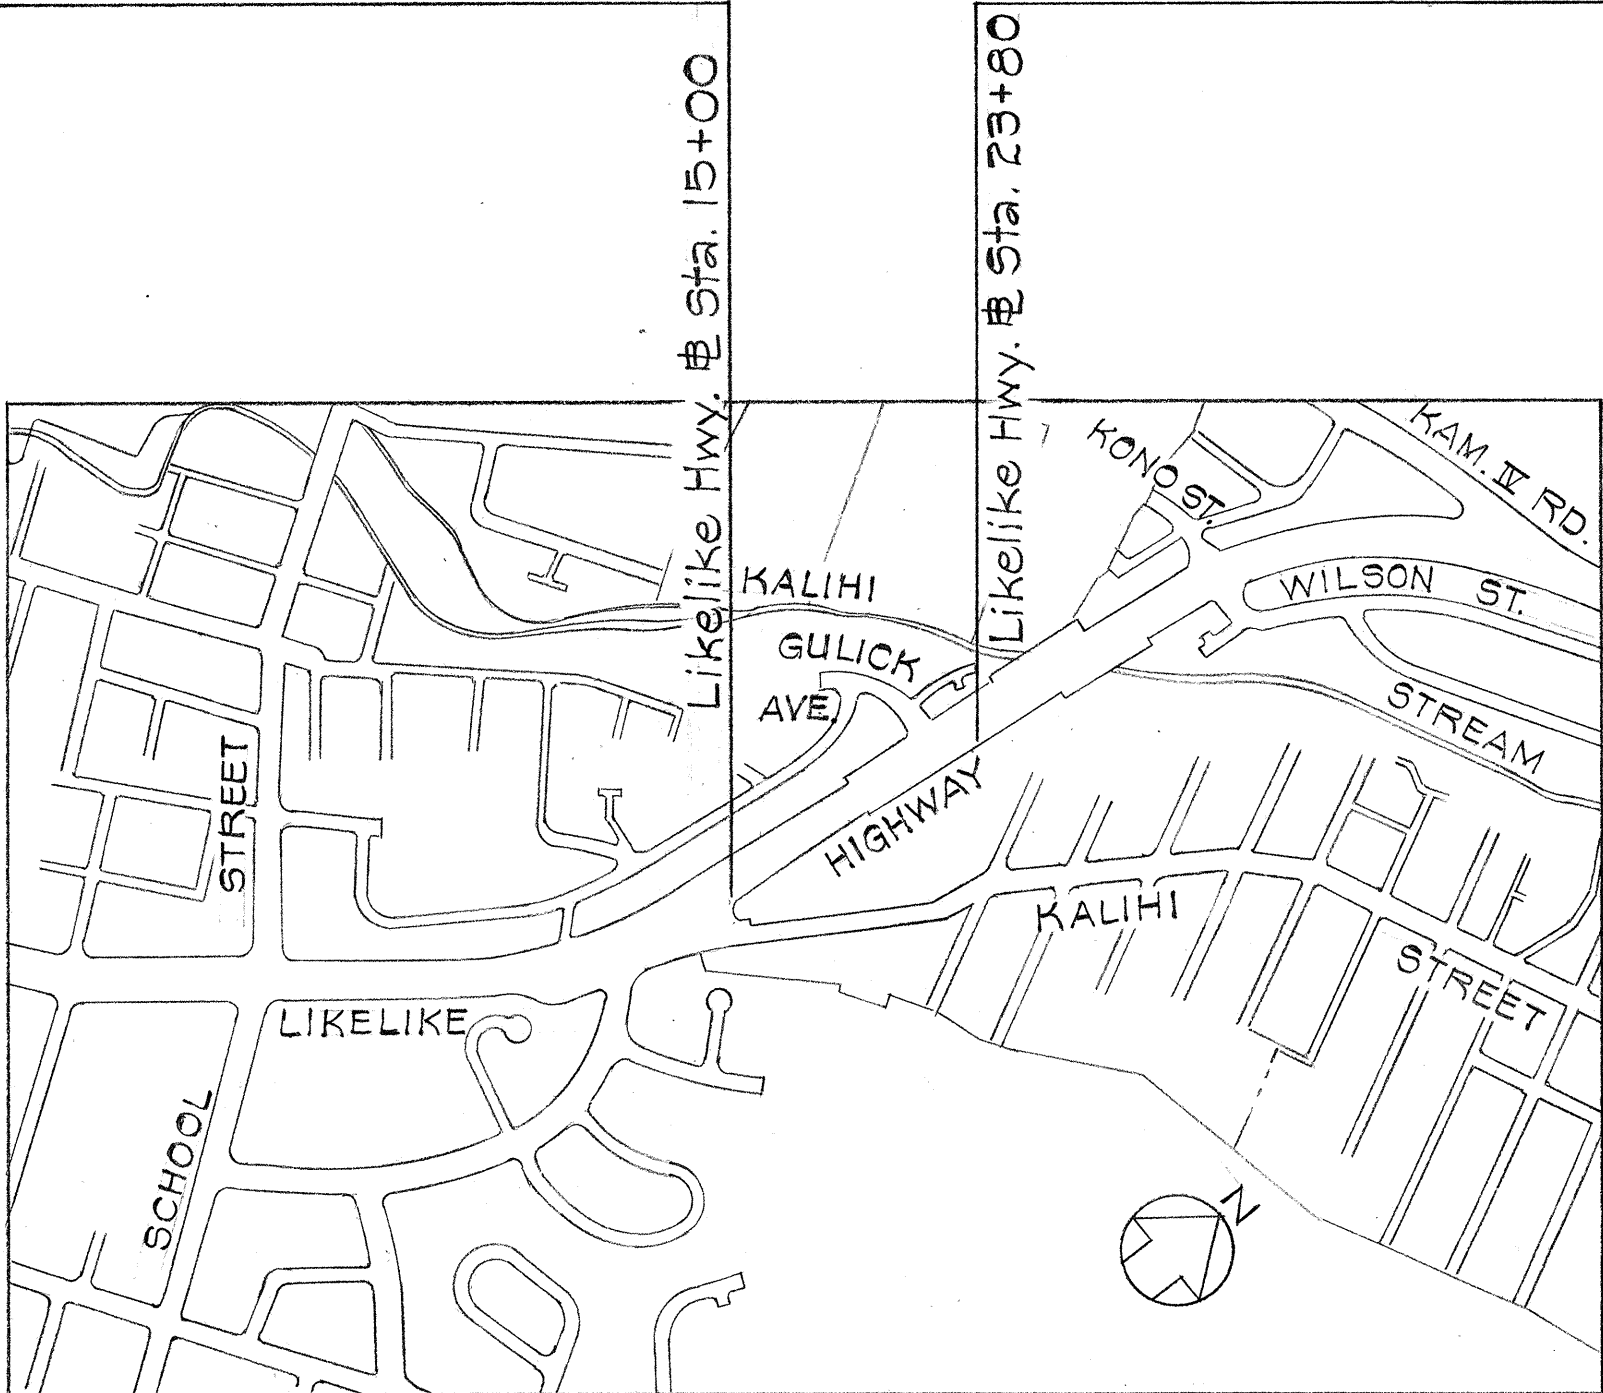

LAYOUT PLAN
1200 600 0 600 1200
SCALE IN FEET

NOTE:
ALL CHANGES MADE DURING CONSTRUCTION
HAVE BEEN NOTED IN RED ON THESE
TRACINGS AND CHECKED BY:

G. Cabana

PROJECT ENGINEER

Jan 6, 1972

DATE

DEPARTMENT OF TRANSPORTATION
STATE OF HAWAII
APPROVED:

G. Alvey Hingst

 5/11/91
DIR. OF TRANSPORTATION DATE

Mike Miura

DESIGNED BY:

C

HIGHWAY DESIGN UNIT

548-7420

PHONE

Feb. 1971

DATE