


GENERAL TELEPHONE NOTES

The location of HTOC Ducts are approximate only. The Contractor shall contact HTOC's Division Construction Supervisor, George Stender at 8308-225 for toning 48 hours prior to start of construction. Any damage to existing ducts shall be repaired at the expense of the Contractor.

NOTE:

B.M. (Top pin C&C Mon.
Jennie St. & Wilson St.)
Elevation = 223.57
State Elev. = 228.22
Diff. in Elev. @ B.M. = 4.63

LIKELIKE HIGHWAY

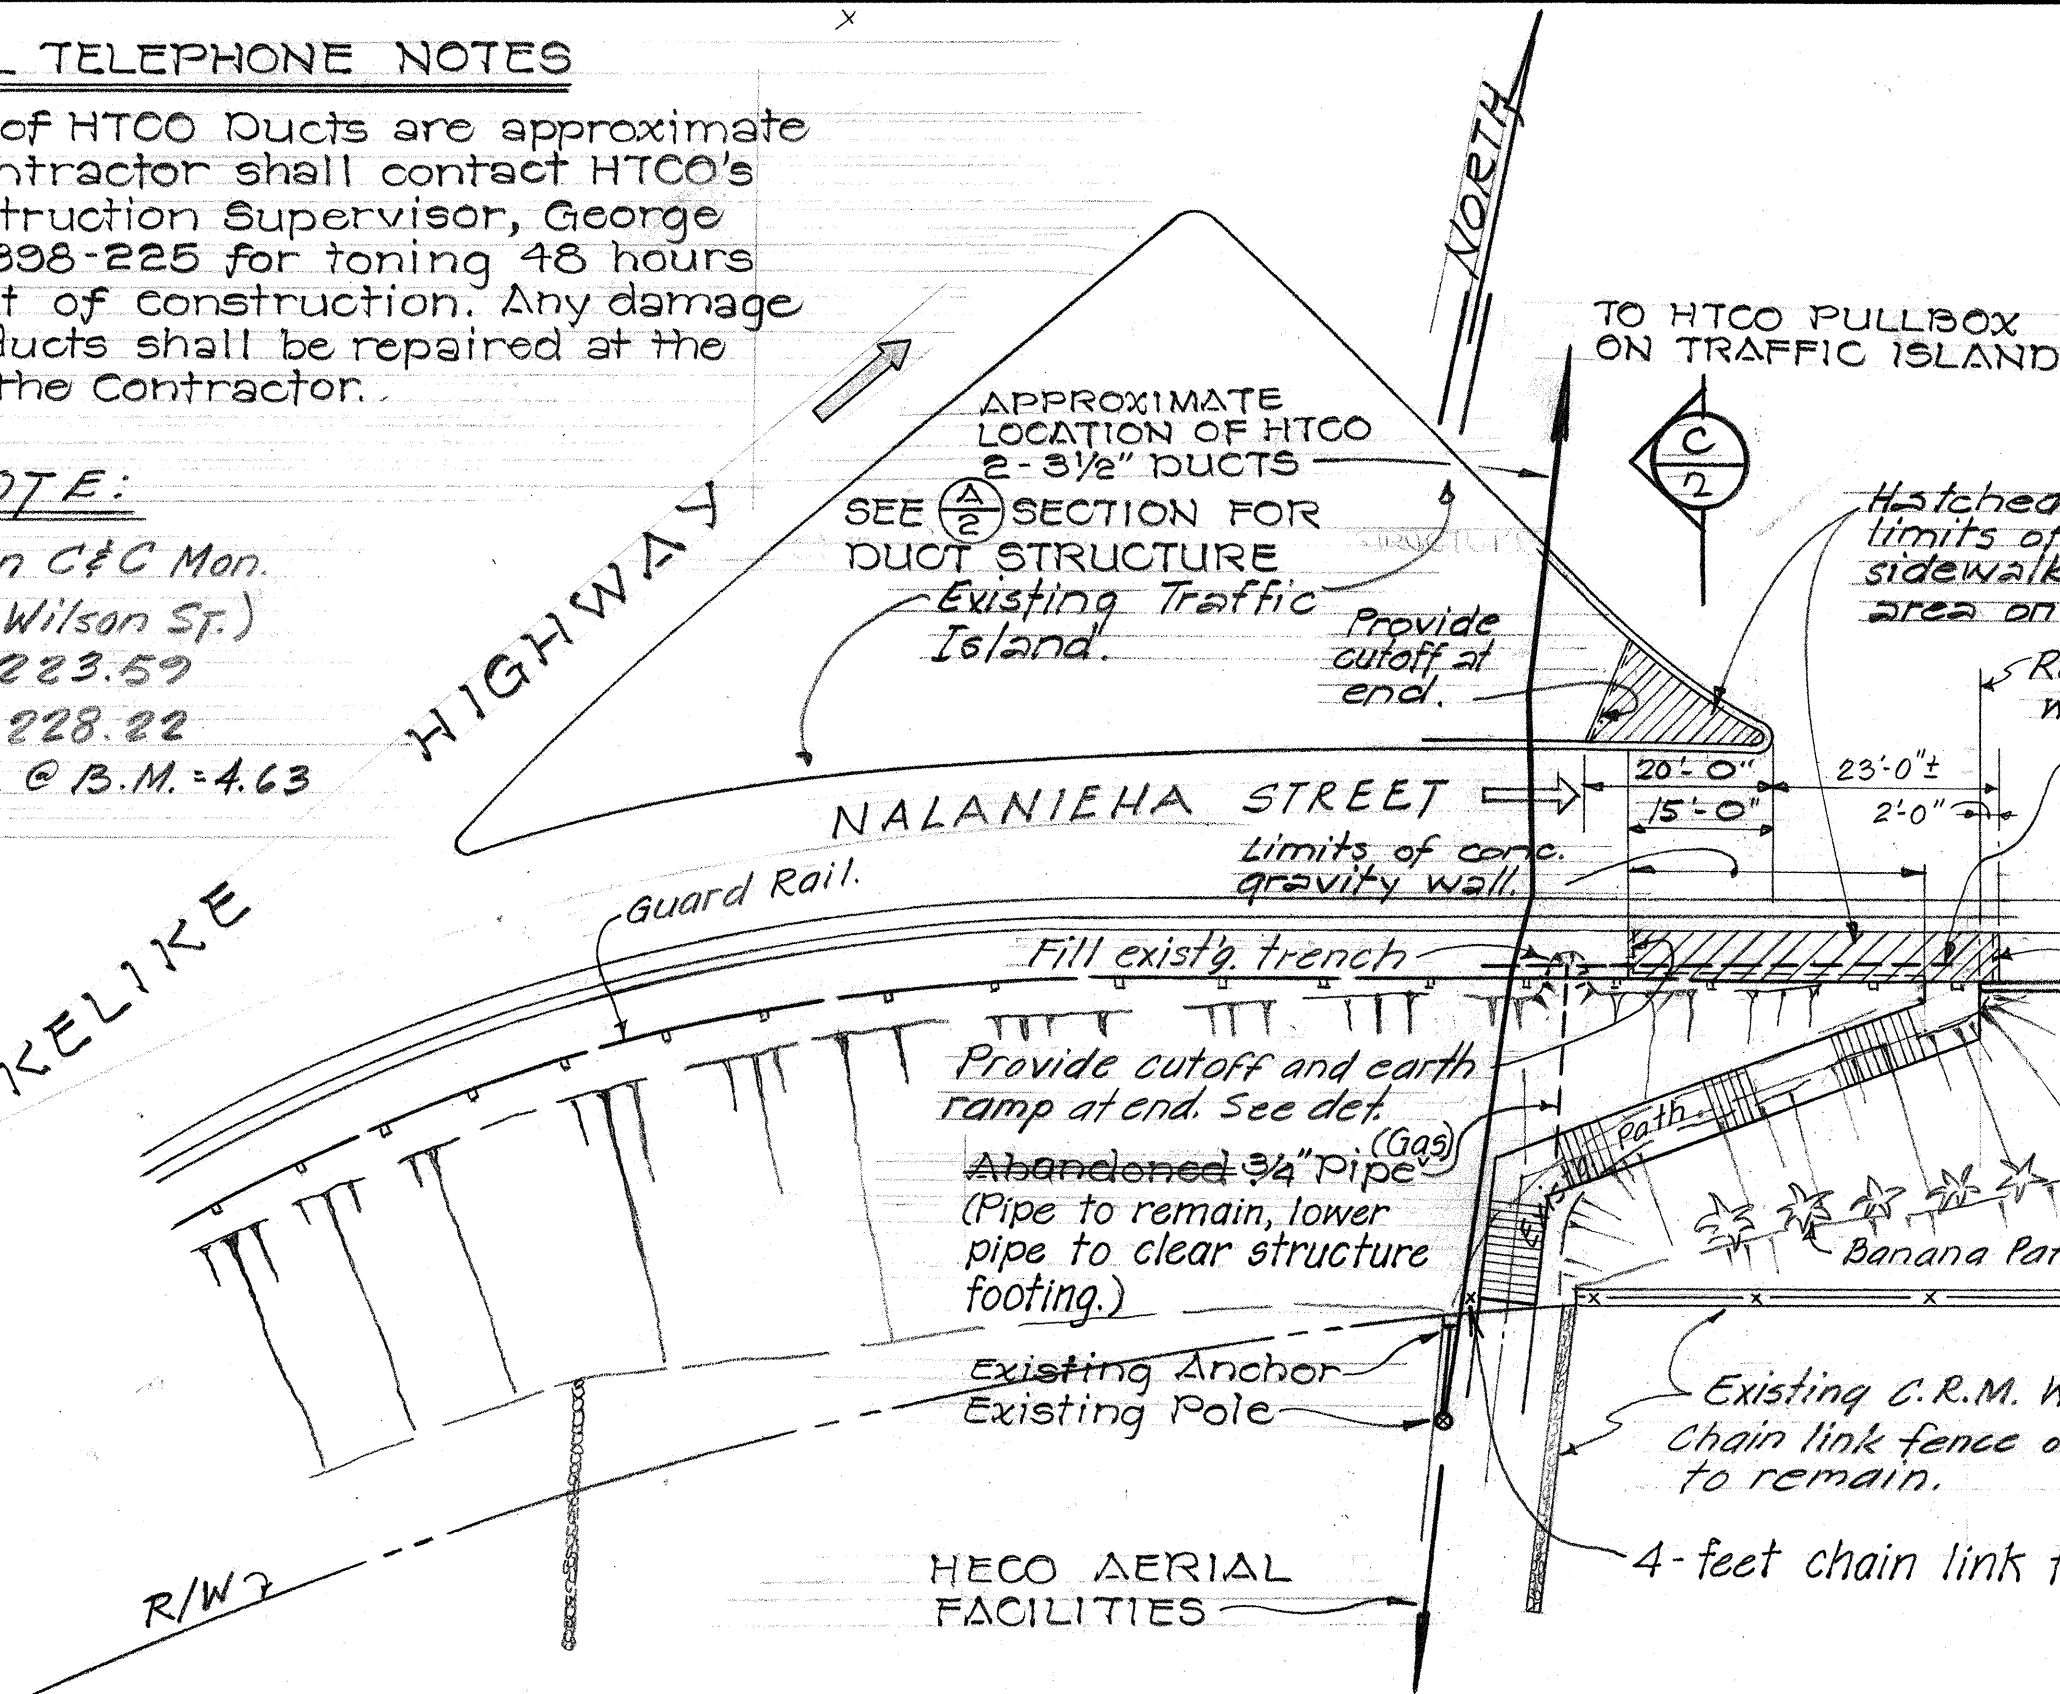

LAYOUT PLAN


SCALE: 1" = 20'-0"

ESTIMATED QUANTITIES

CONCRETE	(41.0 c.y.)	LUMP SUM
REINFORCING STEEL	(4,000 lbs)	LUMP SUM
STRUCTURE EXCAVATION	60.0 C.Y.	
METAL RAILING	68.0 L.F.	
HANDRAIL	67.0 L.F.	
G.R.P.	26.0 C.Y.	

CUT-OFF DETAIL

SCALE: 1/2" = 1'-0"

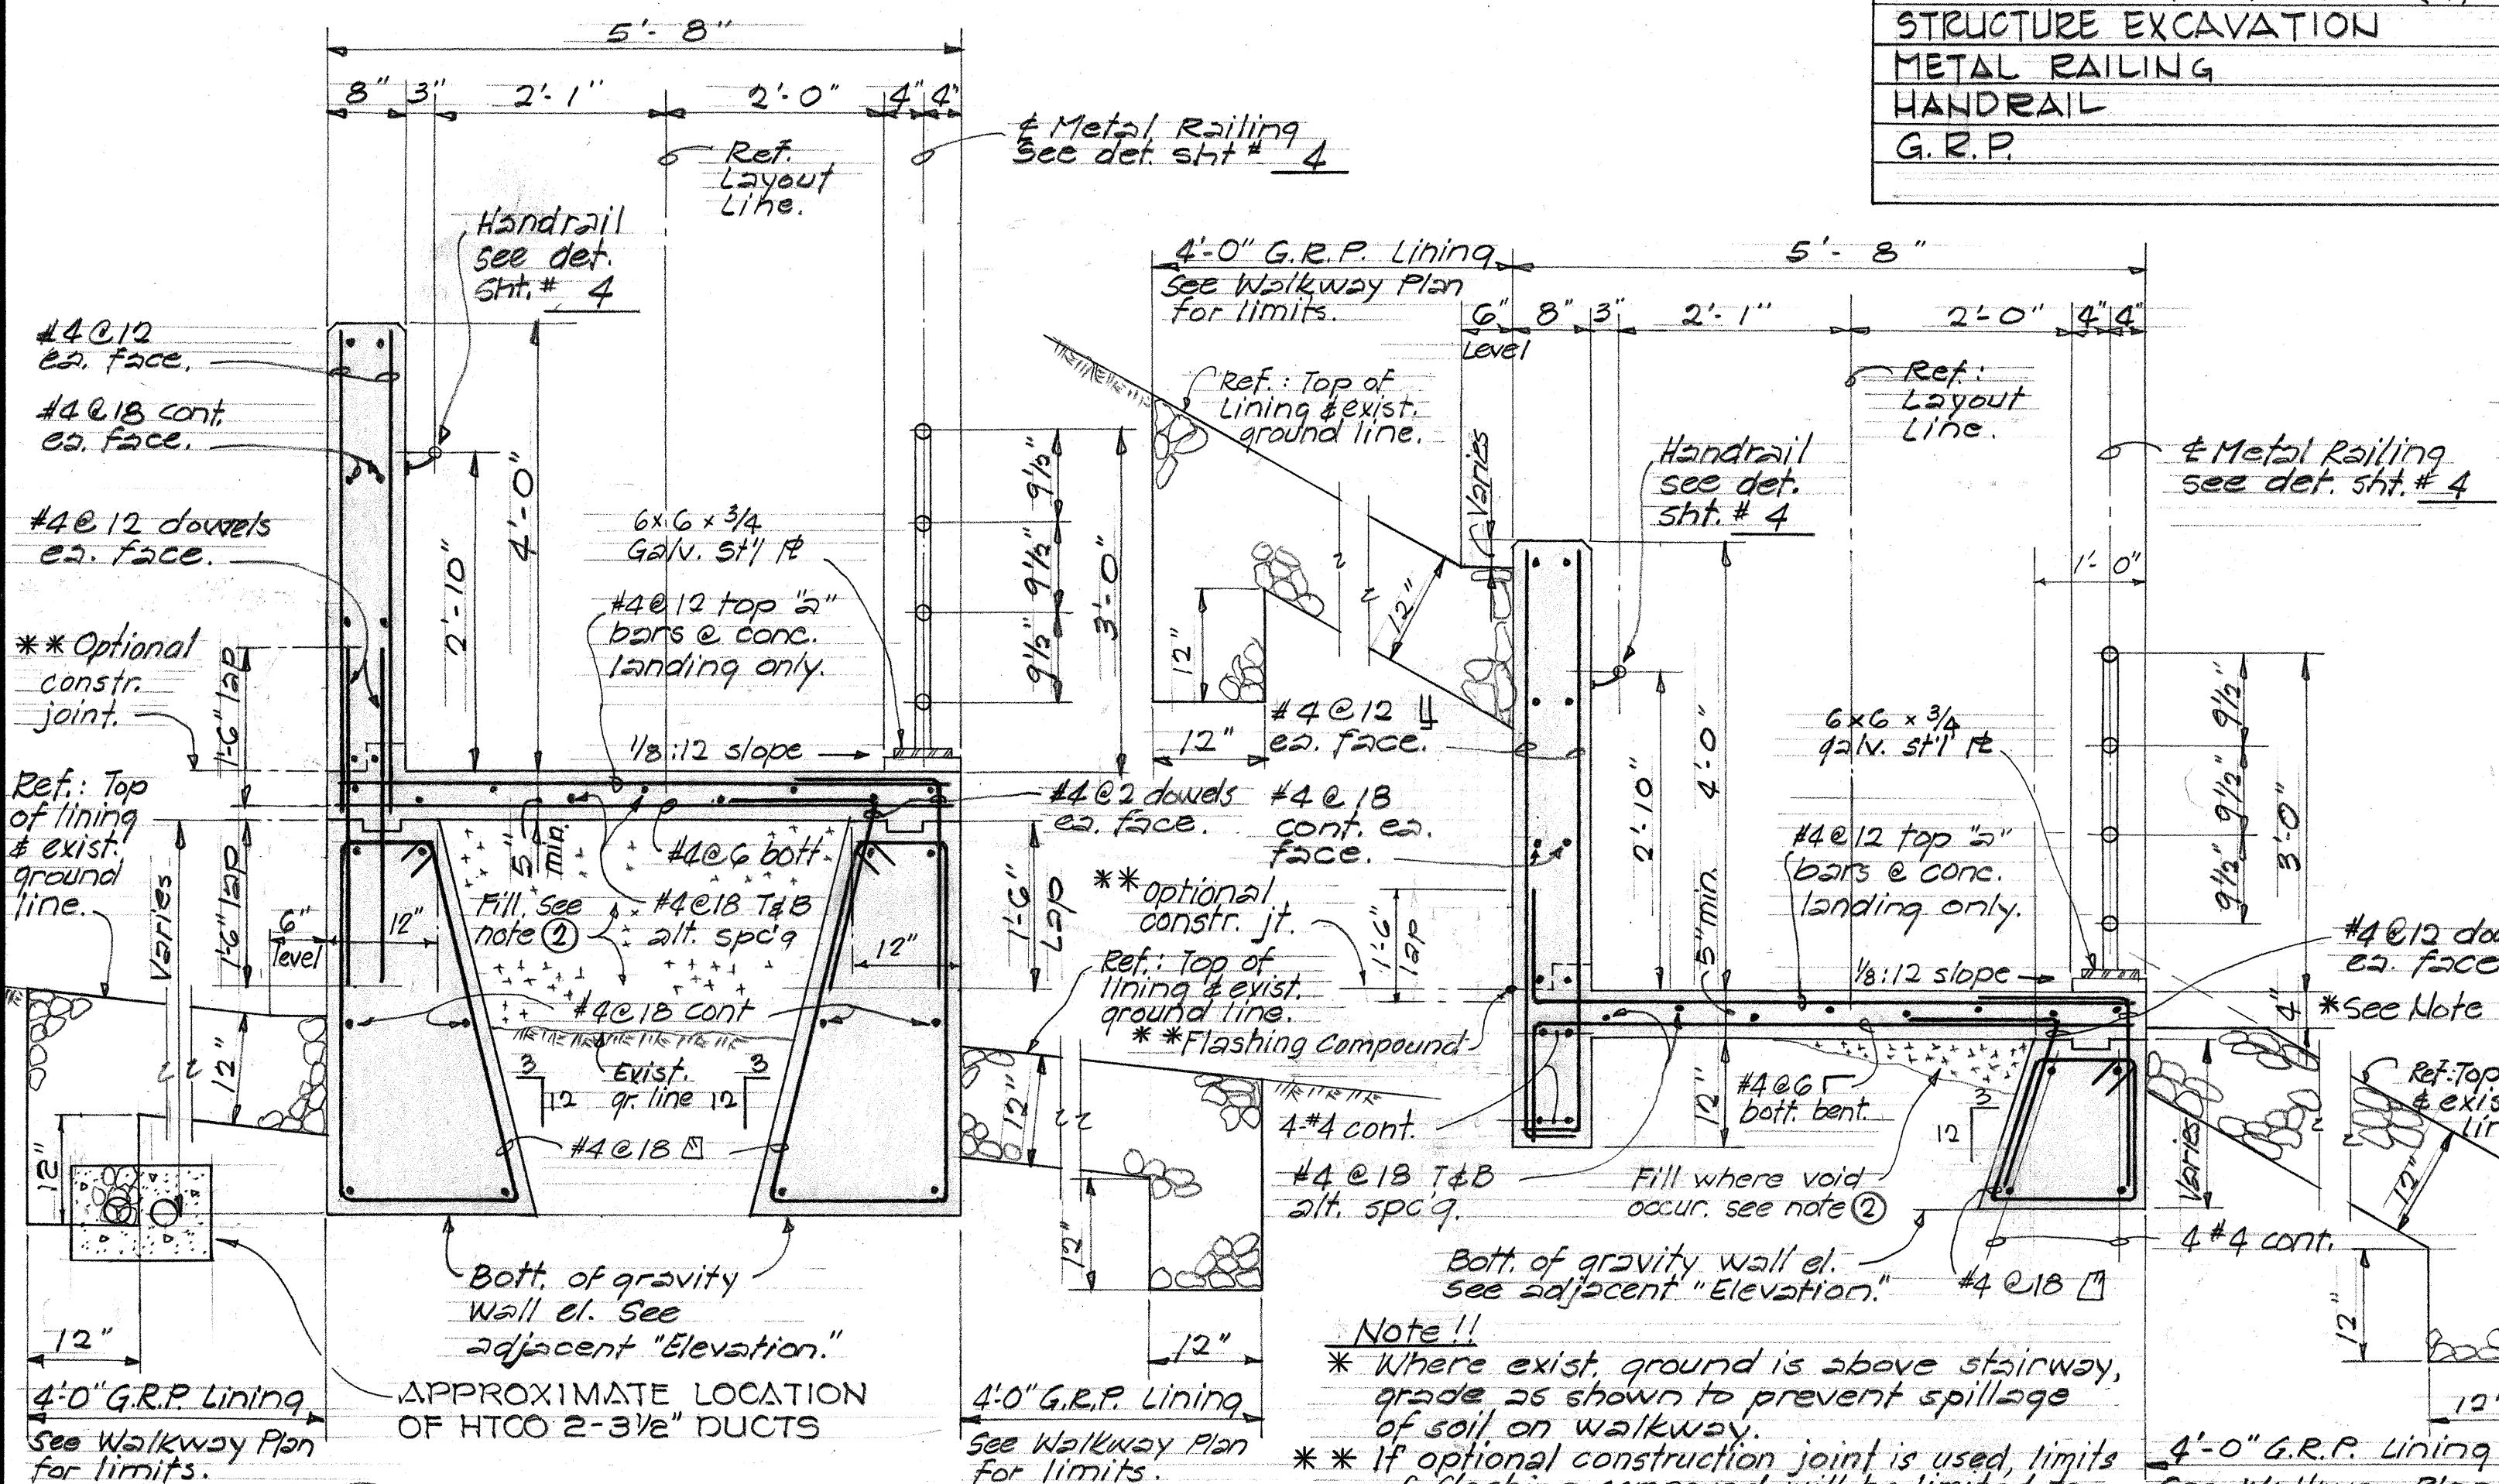


SECTION A

SCALE: 3/4" = 1'-0"

SECTION B

SCALE: 3/4" = 1'-0"

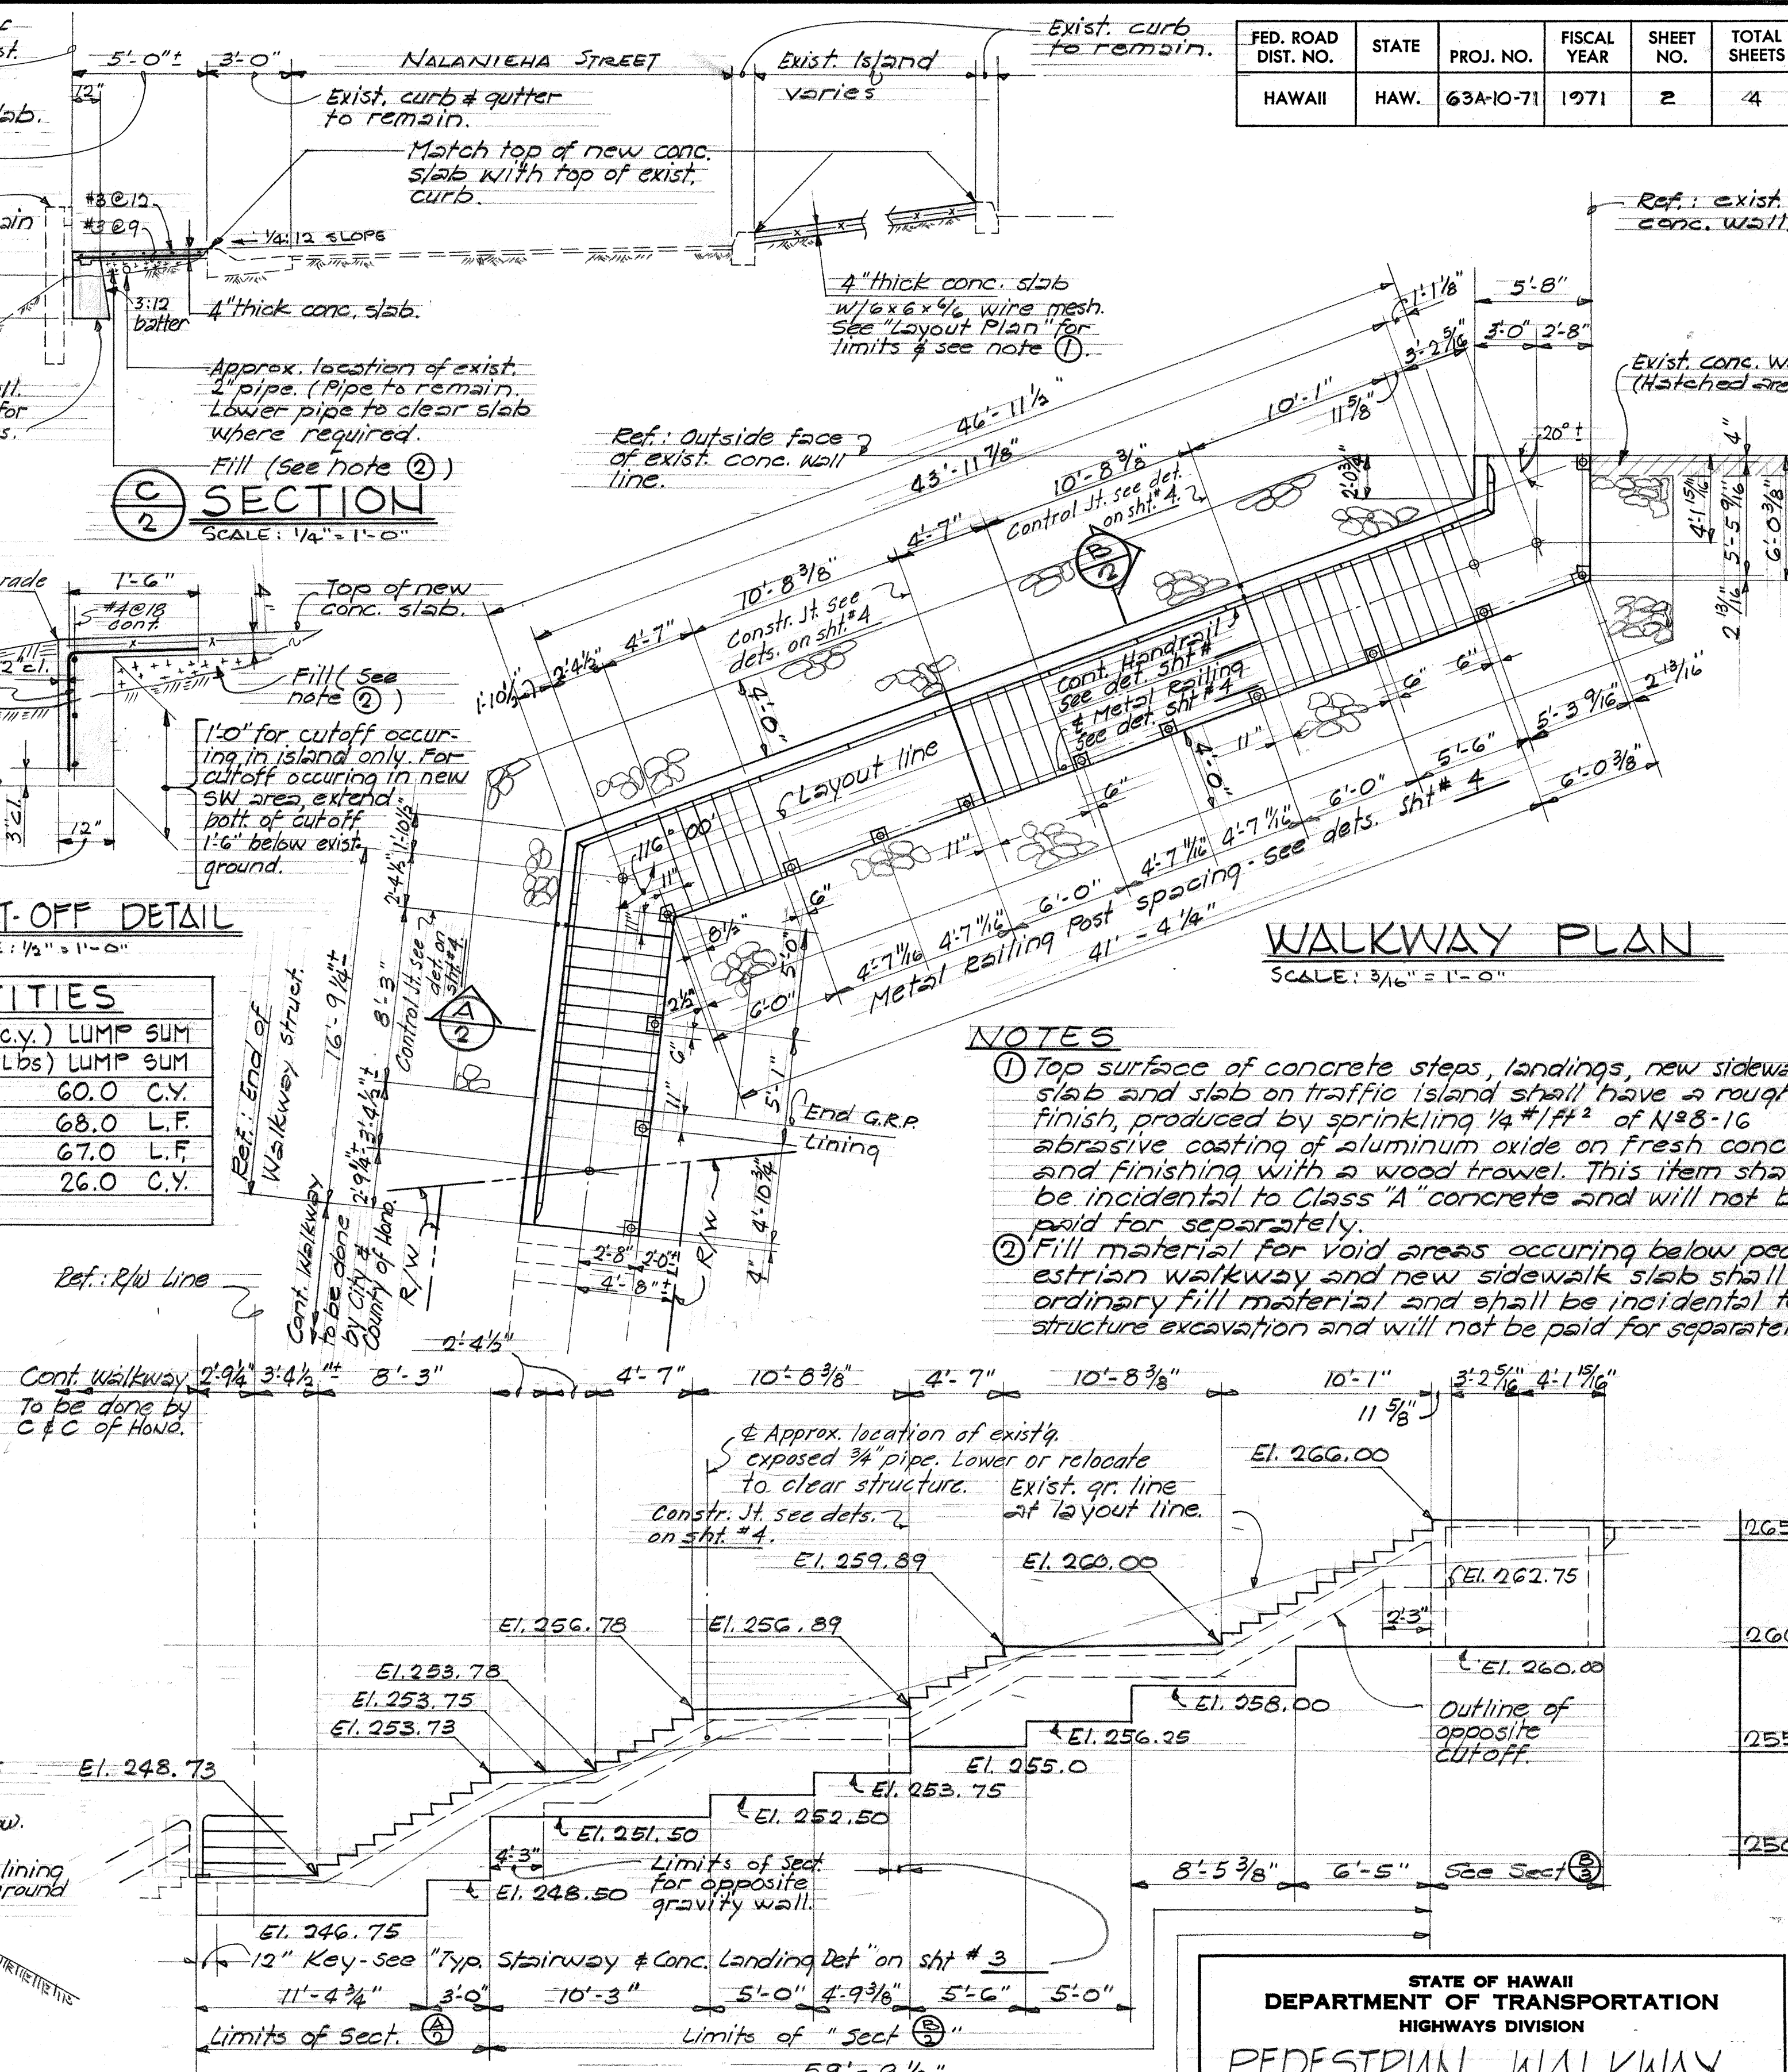

WALKWAY PLAN

SCALE: 3/16" = 1'-0"

NOTES

- Top surface of concrete steps, landings, new sidewalk slab and slab on traffic island shall have a rough finish, produced by sprinkling 1/4 #1/ft² of N#8-16 abrasive coating of aluminum oxide on fresh conc. and finishing with a wood trowel. This item shall be incidental to Class "A" concrete and will not be paid for separately.
- Fill material for void areas occurring below pedestrian walkway and new sidewalk slabs shall be ordinary fill material and shall be incidental to structure excavation and will not be paid for separately.

ELEVATION

SCALE: 3/16" = 1'-0"

STATE OF HAWAII
DEPARTMENT OF TRANSPORTATION
HIGHWAYS DIVISION

PEDESTRIAN WALKWAY
NEAR LIKELIKE HWY BETWEEN
NALANIEHA ST. & WILSON ST
Proj. No. G3A-10-71

DATE: OCT. 1970
SHEET No. 2 OF 4 SHEETS

DATE	...
SURVEY PLANNED BY	...
DESIGNED BY	...
QUANTITIES BY	...
CHECKED BY	...