
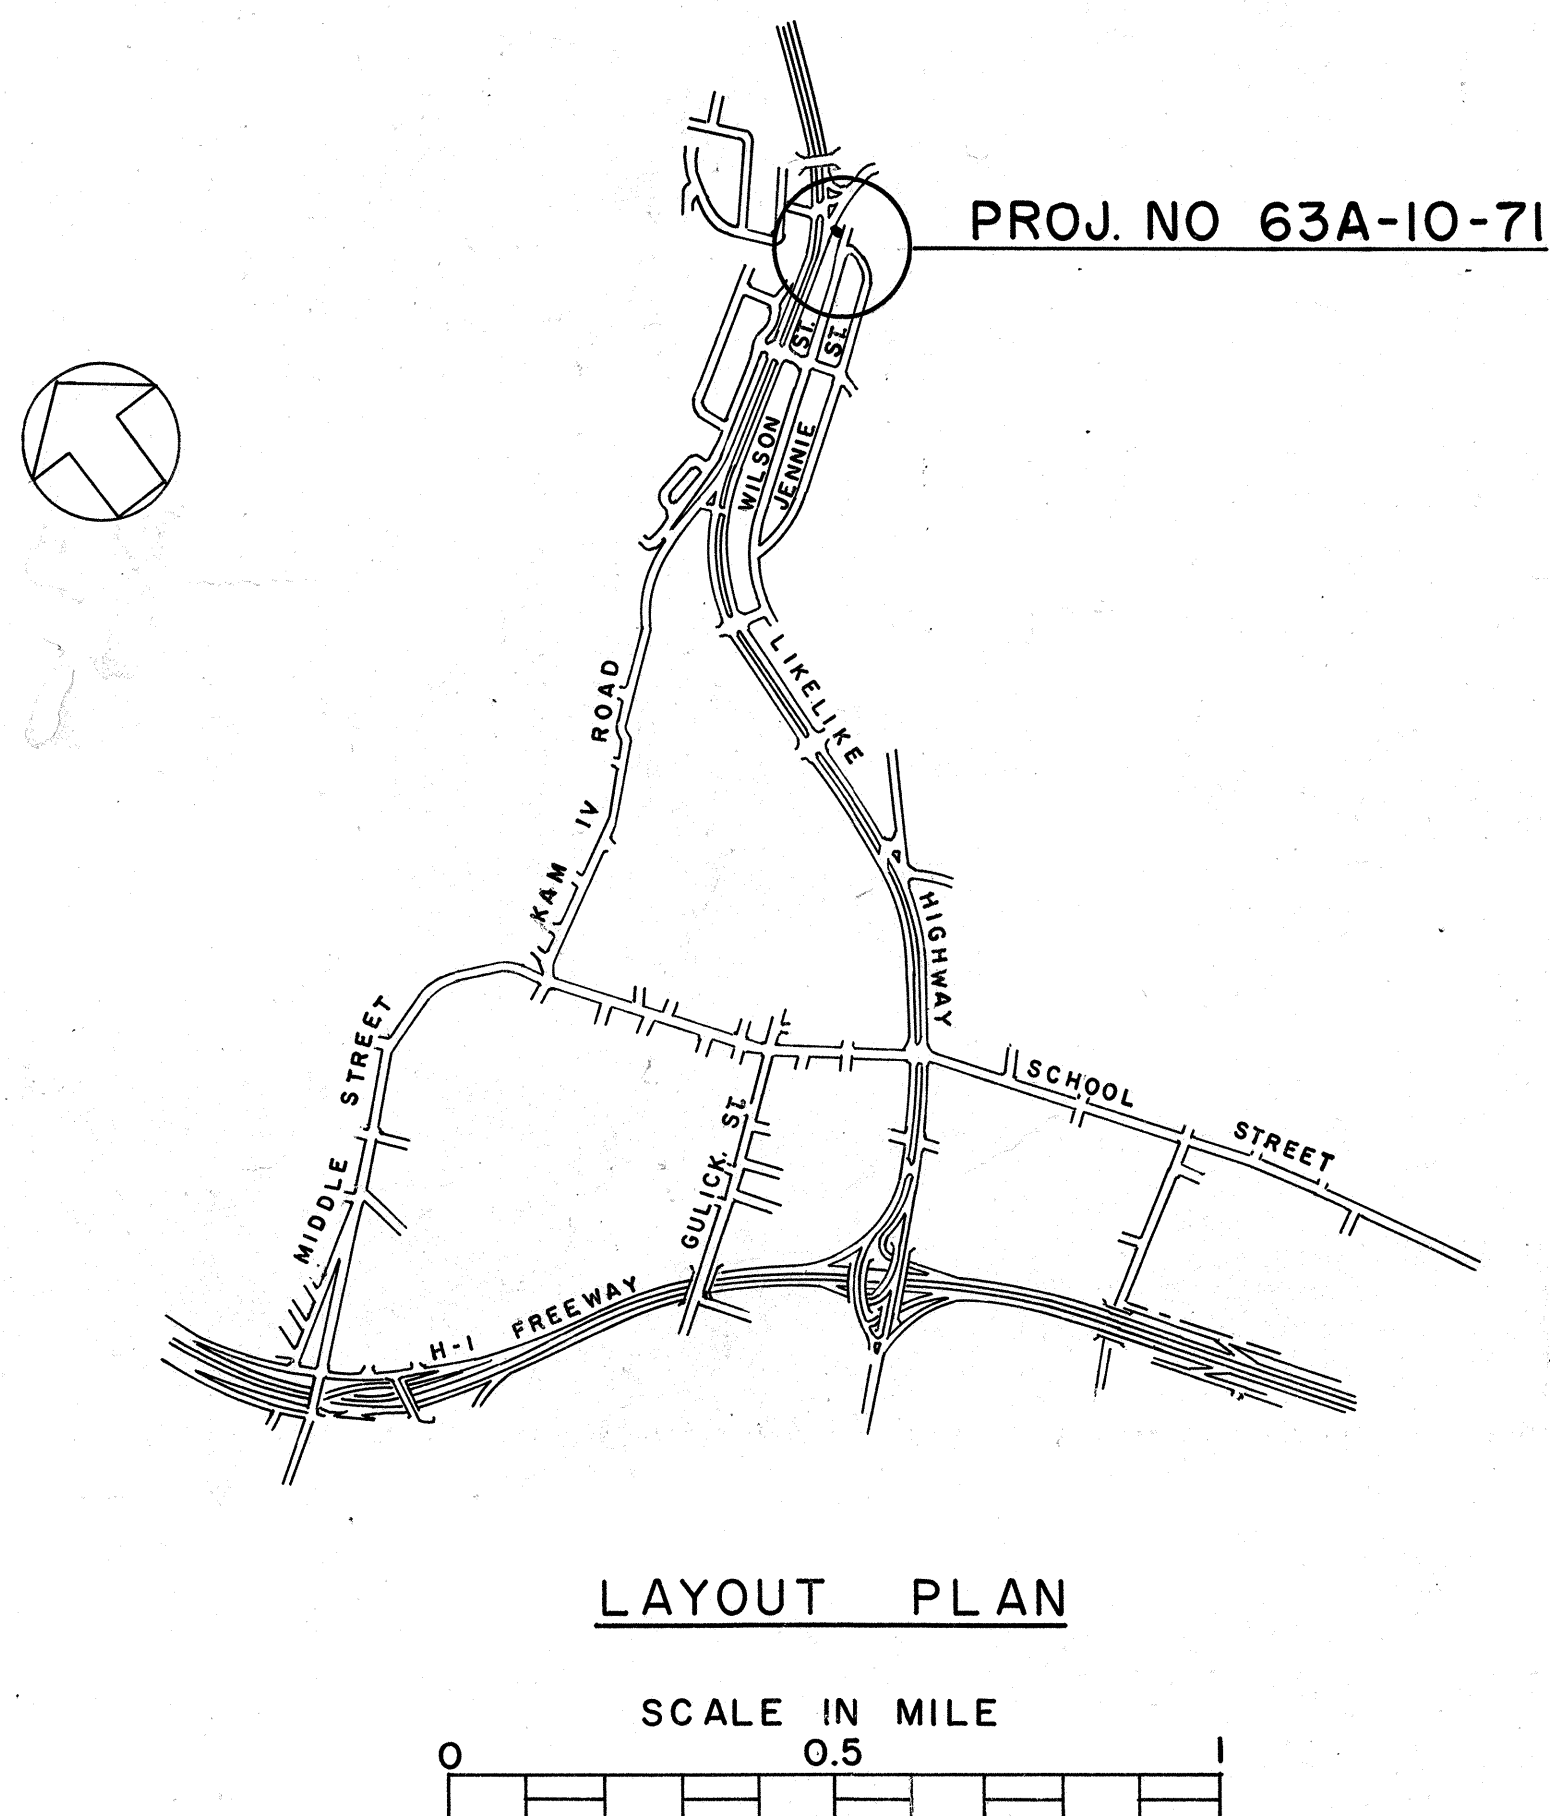


INDEX TO DRAWINGS	
SHEET NO.	DESCRIPTION
1	TITLE SHEET
2	PLAN, PROFILE & TYP. SECTION
3	DETAILS
4	METAL RAILINGS & HANDRAIL DET.

STATE OF HAWAII
DEPARTMENT OF TRANSPORTATION
HIGHWAYS DIVISION
HONOLULU, HAWAII
"AS-BUILT"
PLANS FOR
CONSTRUCTION OF
PEDESTRIAN WALKWAY
(NEAR LIKELIKE HIGHWAY BETWEEN NALANIEHA ST. & WILSON ST.)
PROJECT NO. 63A-10-71
DISTRICT OF HONOLULU
ISLAND OF OAHU

FED. ROAD DIST. NO.	STATE	PROJ. NO.	FISCAL YEAR	SHEET NO.	TOTAL SHEETS
HAWAII	HAW.	63A-10-71	1971	1	4

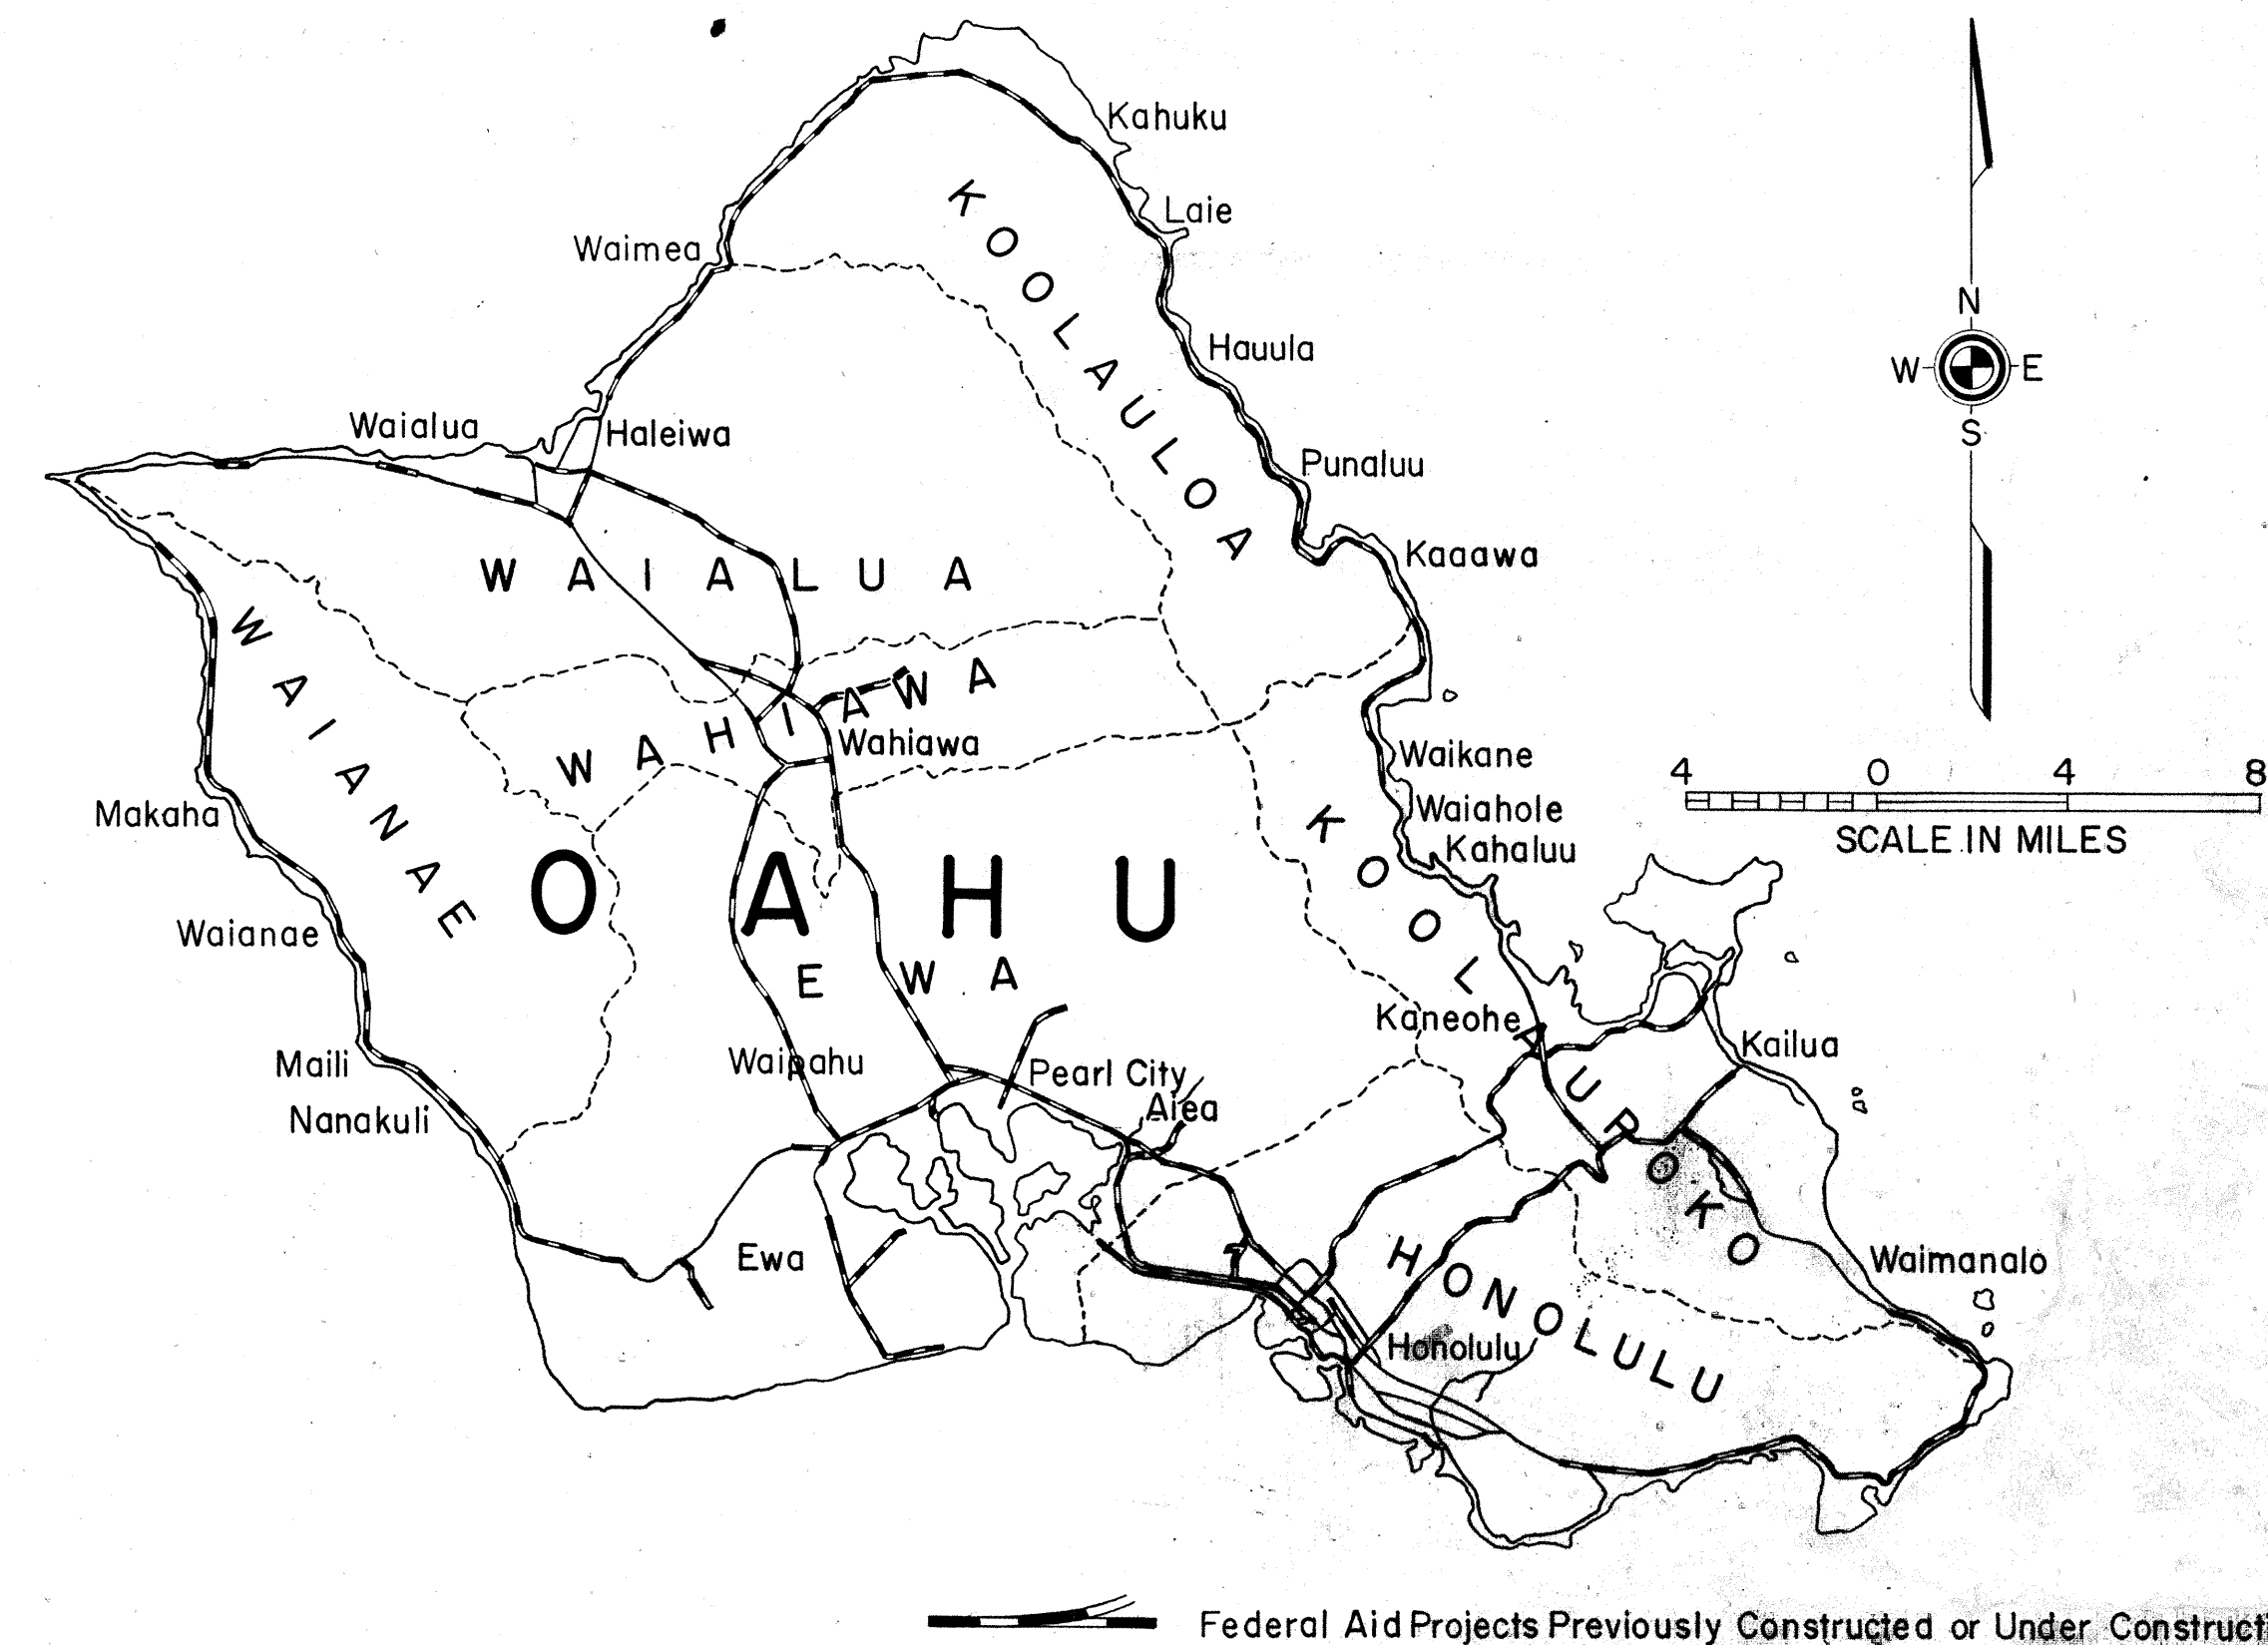

NOTE:

ALL CHANGES MADE DURING CONSTRUCTION HAVE BEEN NOTED IN RED ON THESE TRACINGS AND CHECKED BY:

R. T. Sarachi
for PROJECT ENGINEER
9-21-73
DATE

DEPARTMENT OF TRANSPORTATION STATE OF HAWAII	
APPROVED:	
<i>G. Avery Knight</i> DIR. OF TRANSPORTATION	6/15/71 DATE