


FED. ROAD DIST. NO.	STATE	FED. AID TOPICS PROJ. NO.	FISCAL YEAR	SHEET NO.	TOTAL SHEETS
HAWAII	HAW.	EHS-T-9001(9)	72	2	5

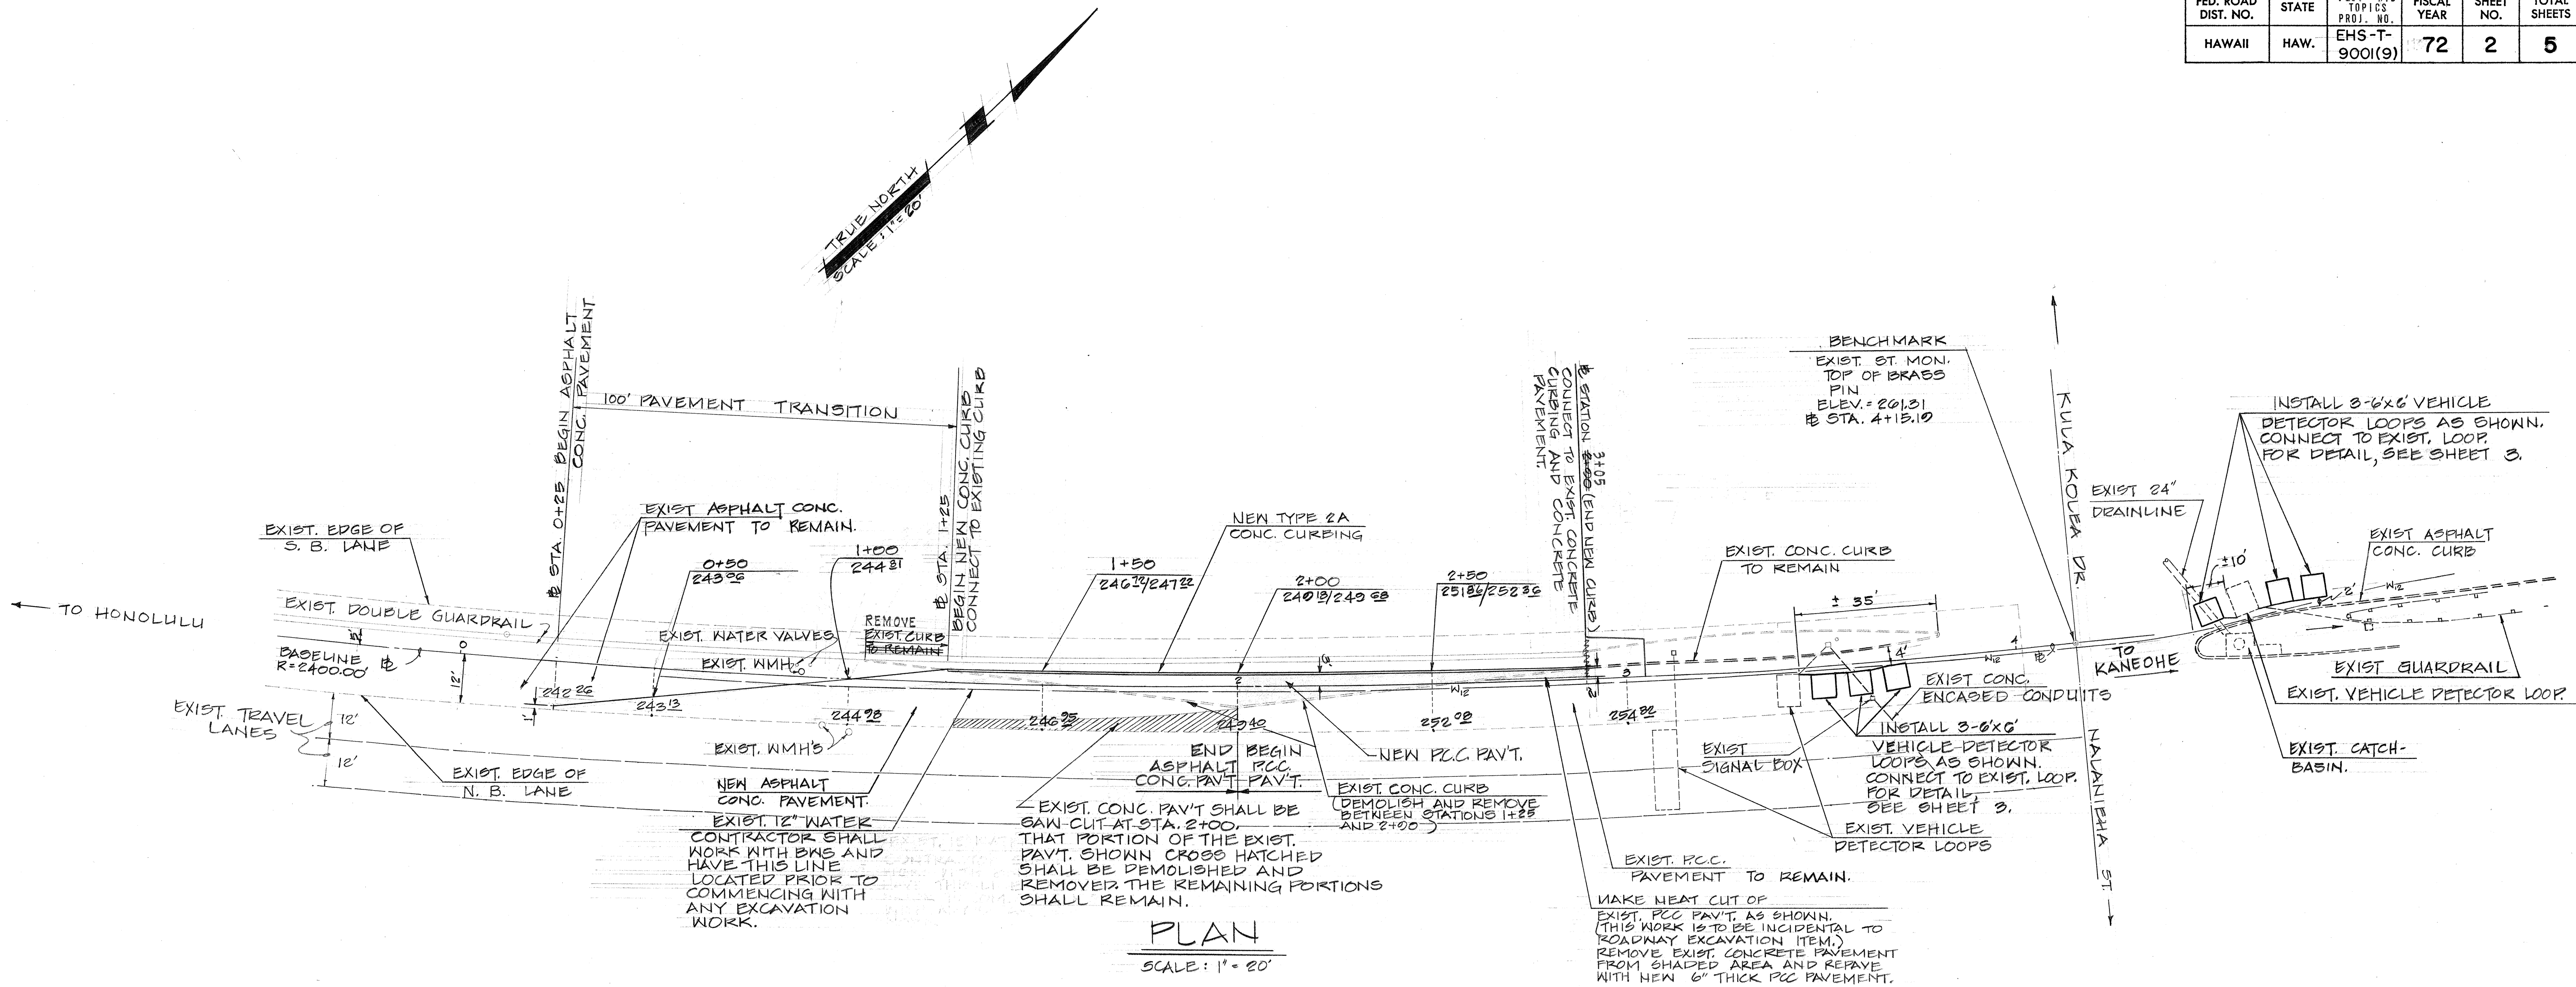

SURVEY PLOTTED BY	DATE
DRAWN BY	*****
DESIGNED BY	
QUANTITIES BY	
CHECKED BY	
ORIGINAL PLAN	
NOTE BOOK	
No.	

LEGEND


250.00 DENOTES EXISTING GRADE AT EXIST. EDGE OF N. B. LANE.

2+50 278.19/278.60 DENOTES: 2+50 BASE LINE STA. 278.10 PROPOSED PAV'T. ELEV.

278.60 PROPOSED TOP OF NEW CURB ELEV.

0+50 243.00 DENOTES: 0+50 BASELINE STATION 243.00 PROPOSED PAV'T. ELEV.

- CONSTRUCTION NOTES**
1. ALL PAVEMENT MARKINGS BY STATE HIGHWAY DIVISION. (NOT IN CONTRACT.)
 2. MAINTENANCE OF TRAFFIC SHALL BE INCIDENTAL TO ALL CONSTRUCTION ITEMS.
 3. THE CONTRACTOR SHALL VERIFY THE LOCATIONS OF ALL EXISTING CONDUITS AND UTILITIES IN THE FIELD PRIOR TO COMMENCING WITH ANY CONSTRUCTION WORK.

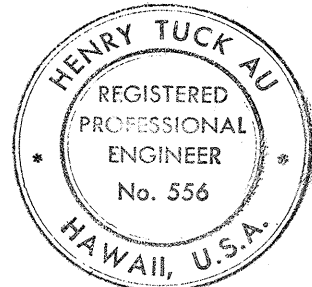

THIS WORK WAS PREPARED BY
ME OR UNDER MY SUPERVISION
Henry Tuck
356-E
May 10, 1972

STATE OF HAWAII
DEPARTMENT OF TRANSPORTATION
HIGHWAYS DIVISION

PLAN

EXTEND NORTHBOUND LEFT TURN LANE
LIKEHI HWY. AT KULA KOLEA DR
AND NALANIEHA ST.
FED. AID TOPICS PROJ. NO. EHS-T-9001(9)
SCALE AS SHOWN.

SHEET No. 2 OF 5 SHEETS