11	NDEX TO DRAWINGS
SHEET NO.	DESCRIPTION
1	TITLE SHEET
2	PLAN
3	TYPICAL RD. SECTIONS AND
	MISCELLANEOUS DETAILS
4-5	STANDARD DETAILS
	And the state of t
· · · · · · · · · · · · · · · · · · ·	
	·

Henry Tuck Au Designed BY



STATE OF HAWAII



DEPARTMENT OF TRANSPORTATION HIGHWAYS DIVISION

HONOLULU, HAWAII


"AS BUILT" PLANS TO


EXTEND NORTHBOUND LEFT TURN LANE

on LIKELIKE HWY. at KULA KOLEA DR. and NALANIEHA ST.

FEDERAL AID TOPICS PROJECT NO. EHS-T-9001(9)

DISTRICT OF HONOLULU
ISLAND OF OAHU

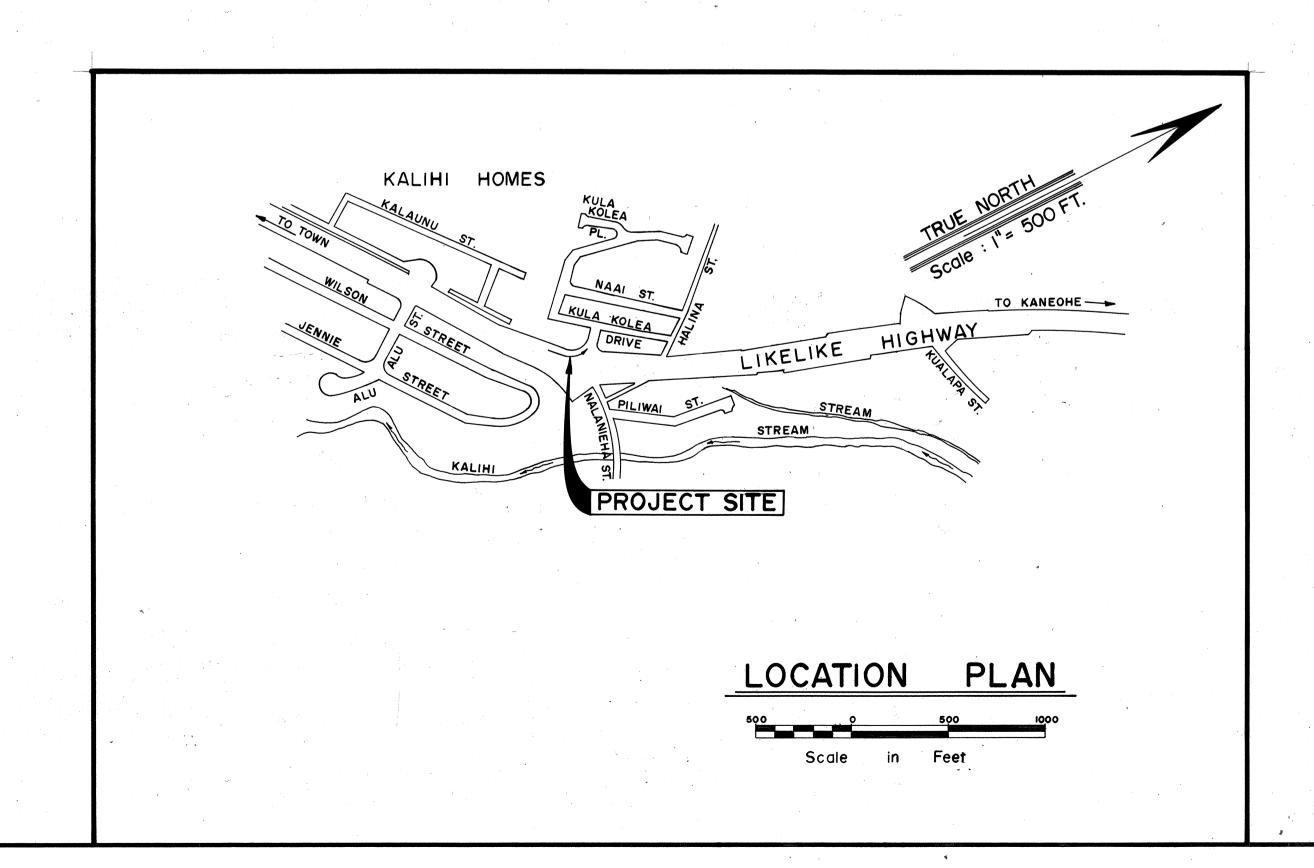

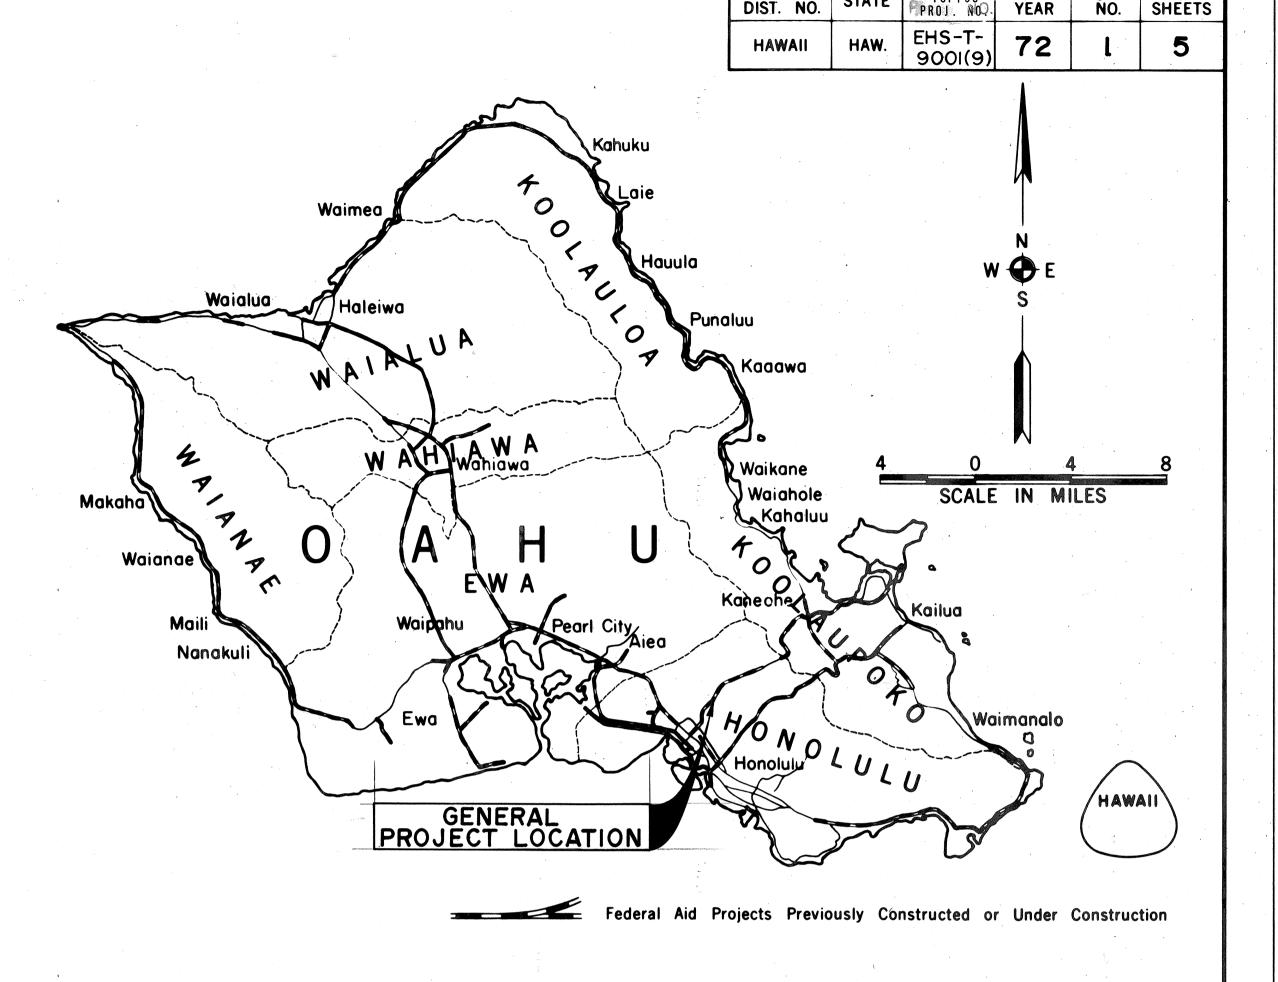

NOTE:


ALL CHANGES MADE DURING CONSTRUCTION HAVE BEEN NOTED IN RED ON THESE TRACINGS AND CHECKED BY:

H. Hasuite
PROJECT ENGINEER

6-24-73

DATE

FOR ACTUAL QUANTITIES, REFER TO PROJECT LEDGER AND/OR COMPUTATION BOOK.

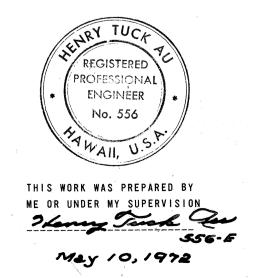

DEPARTMENT OF T	RANSPORTATION
FEDERAL HIGHWAY	
APPROVED:	2
11/12 BB	6-29-71
DIVISION ENGINEER	DATE

N
0/72
TE
_