
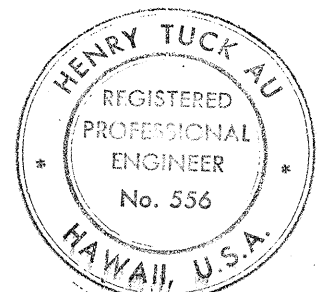
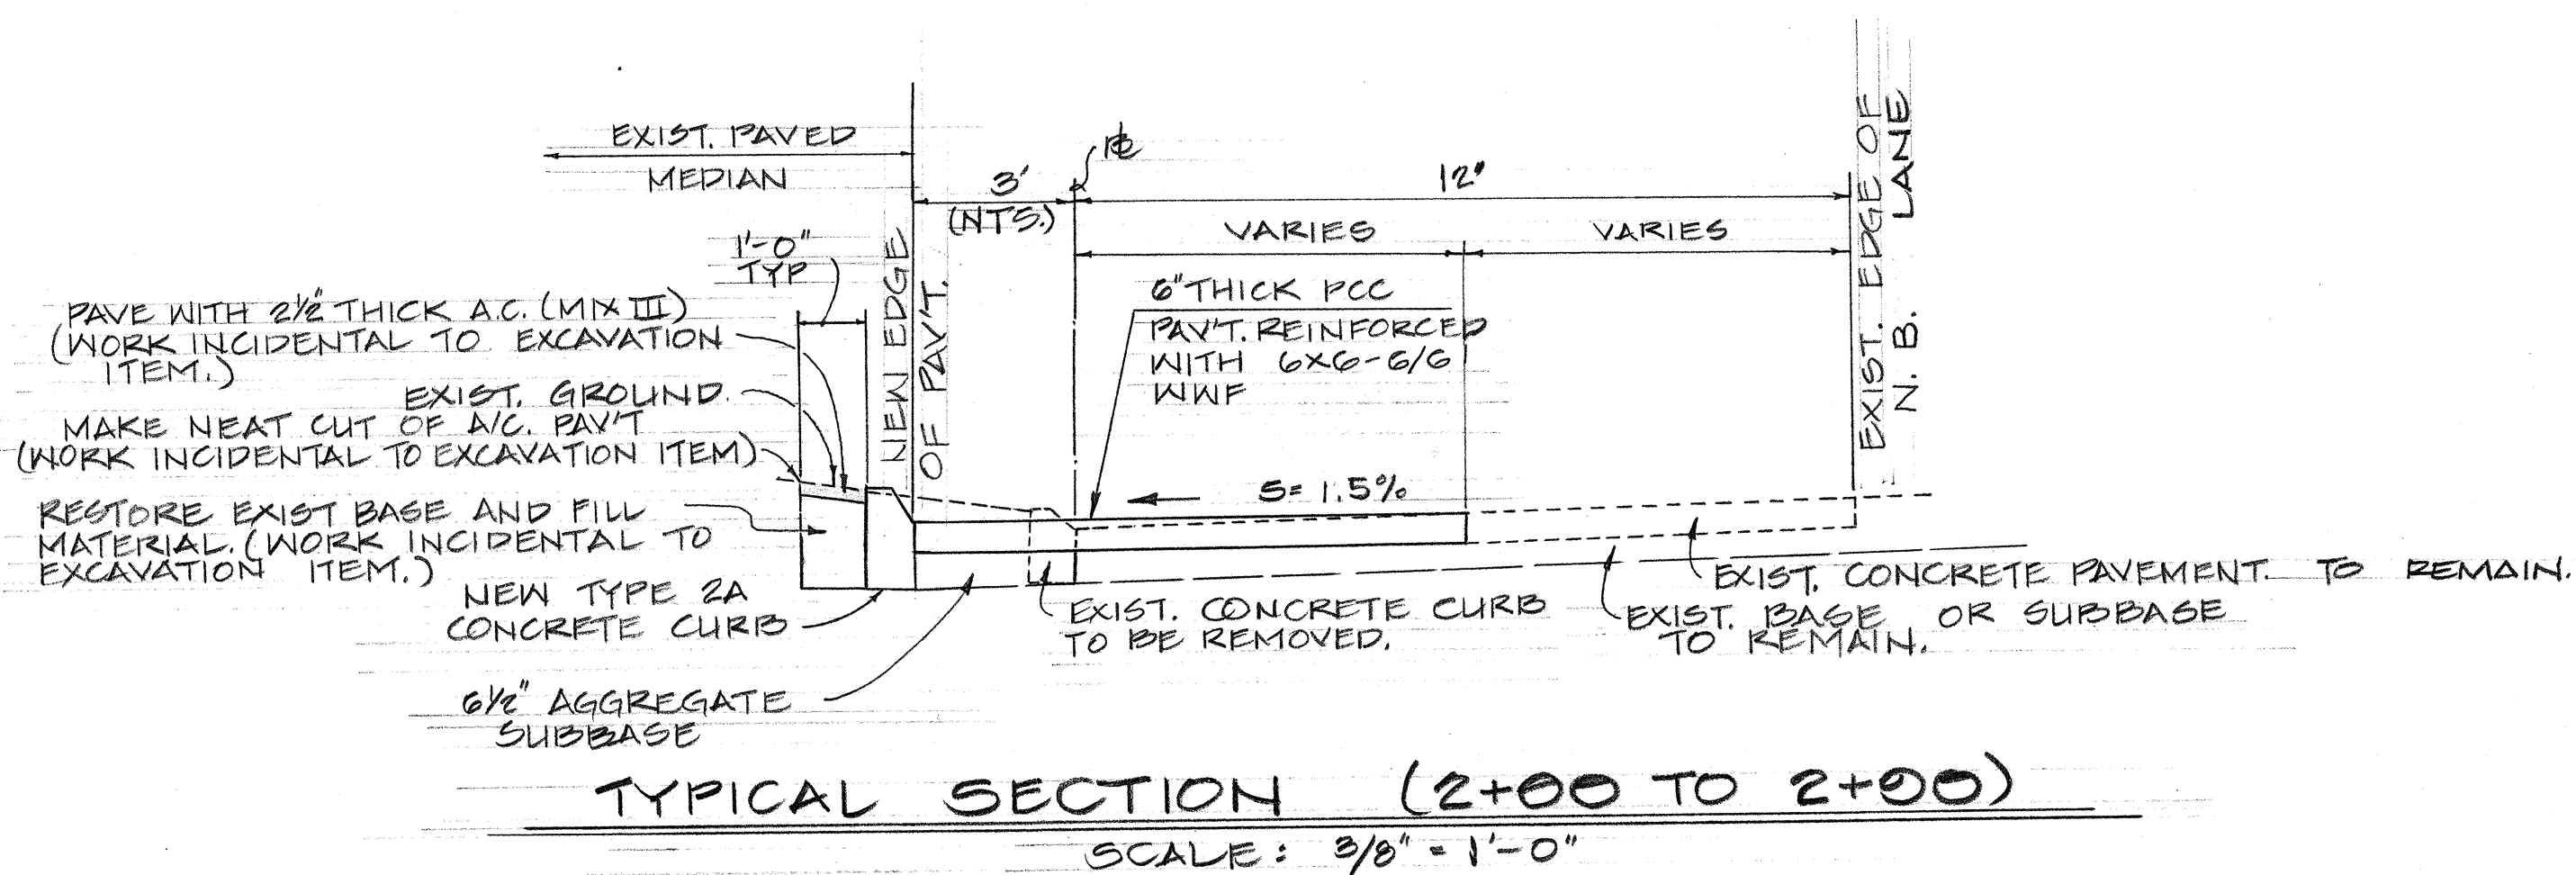
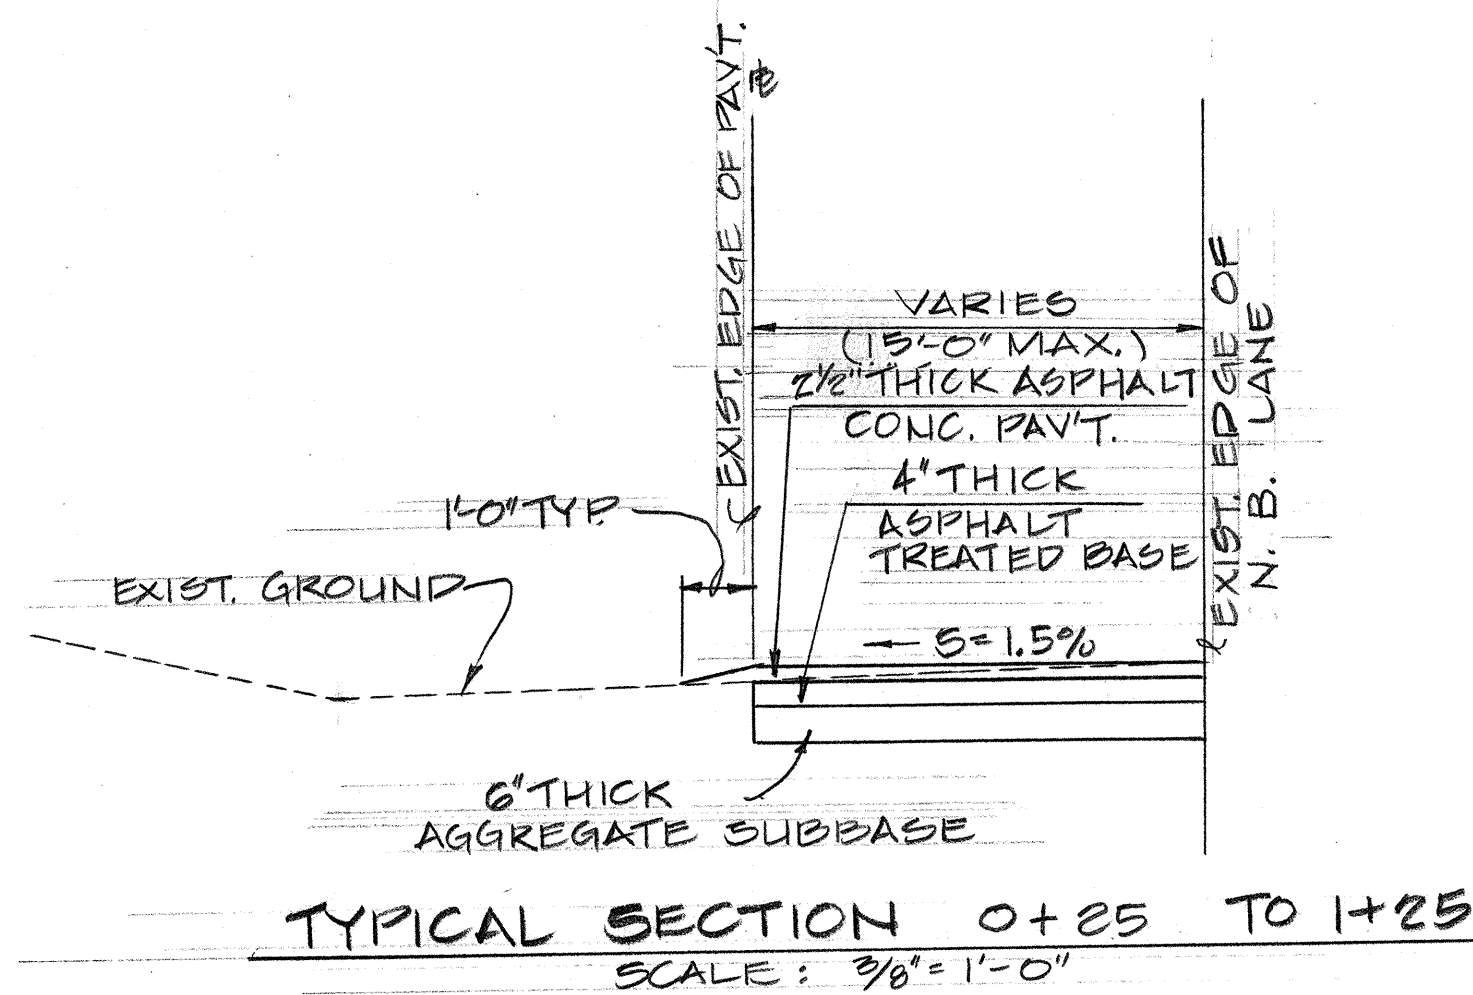
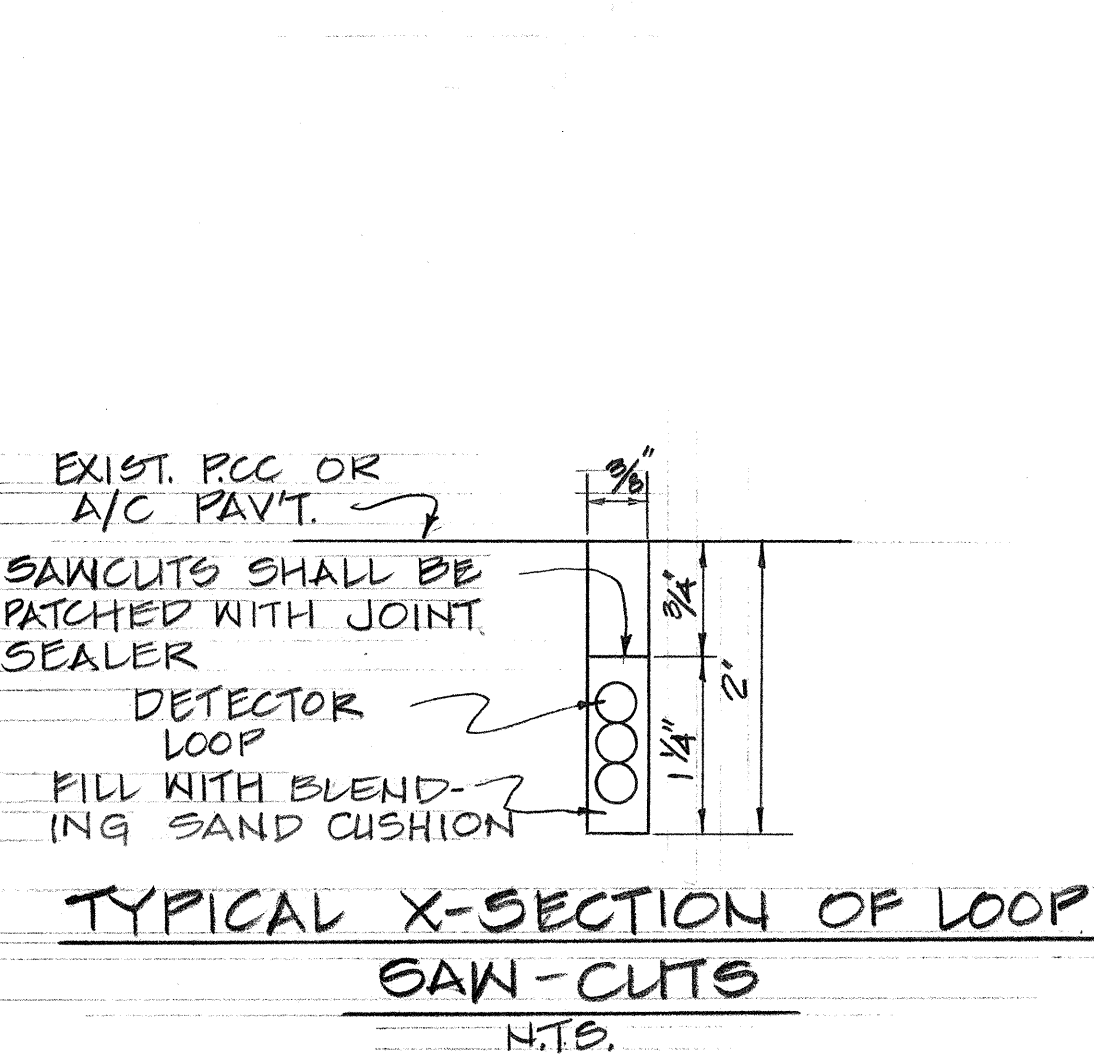
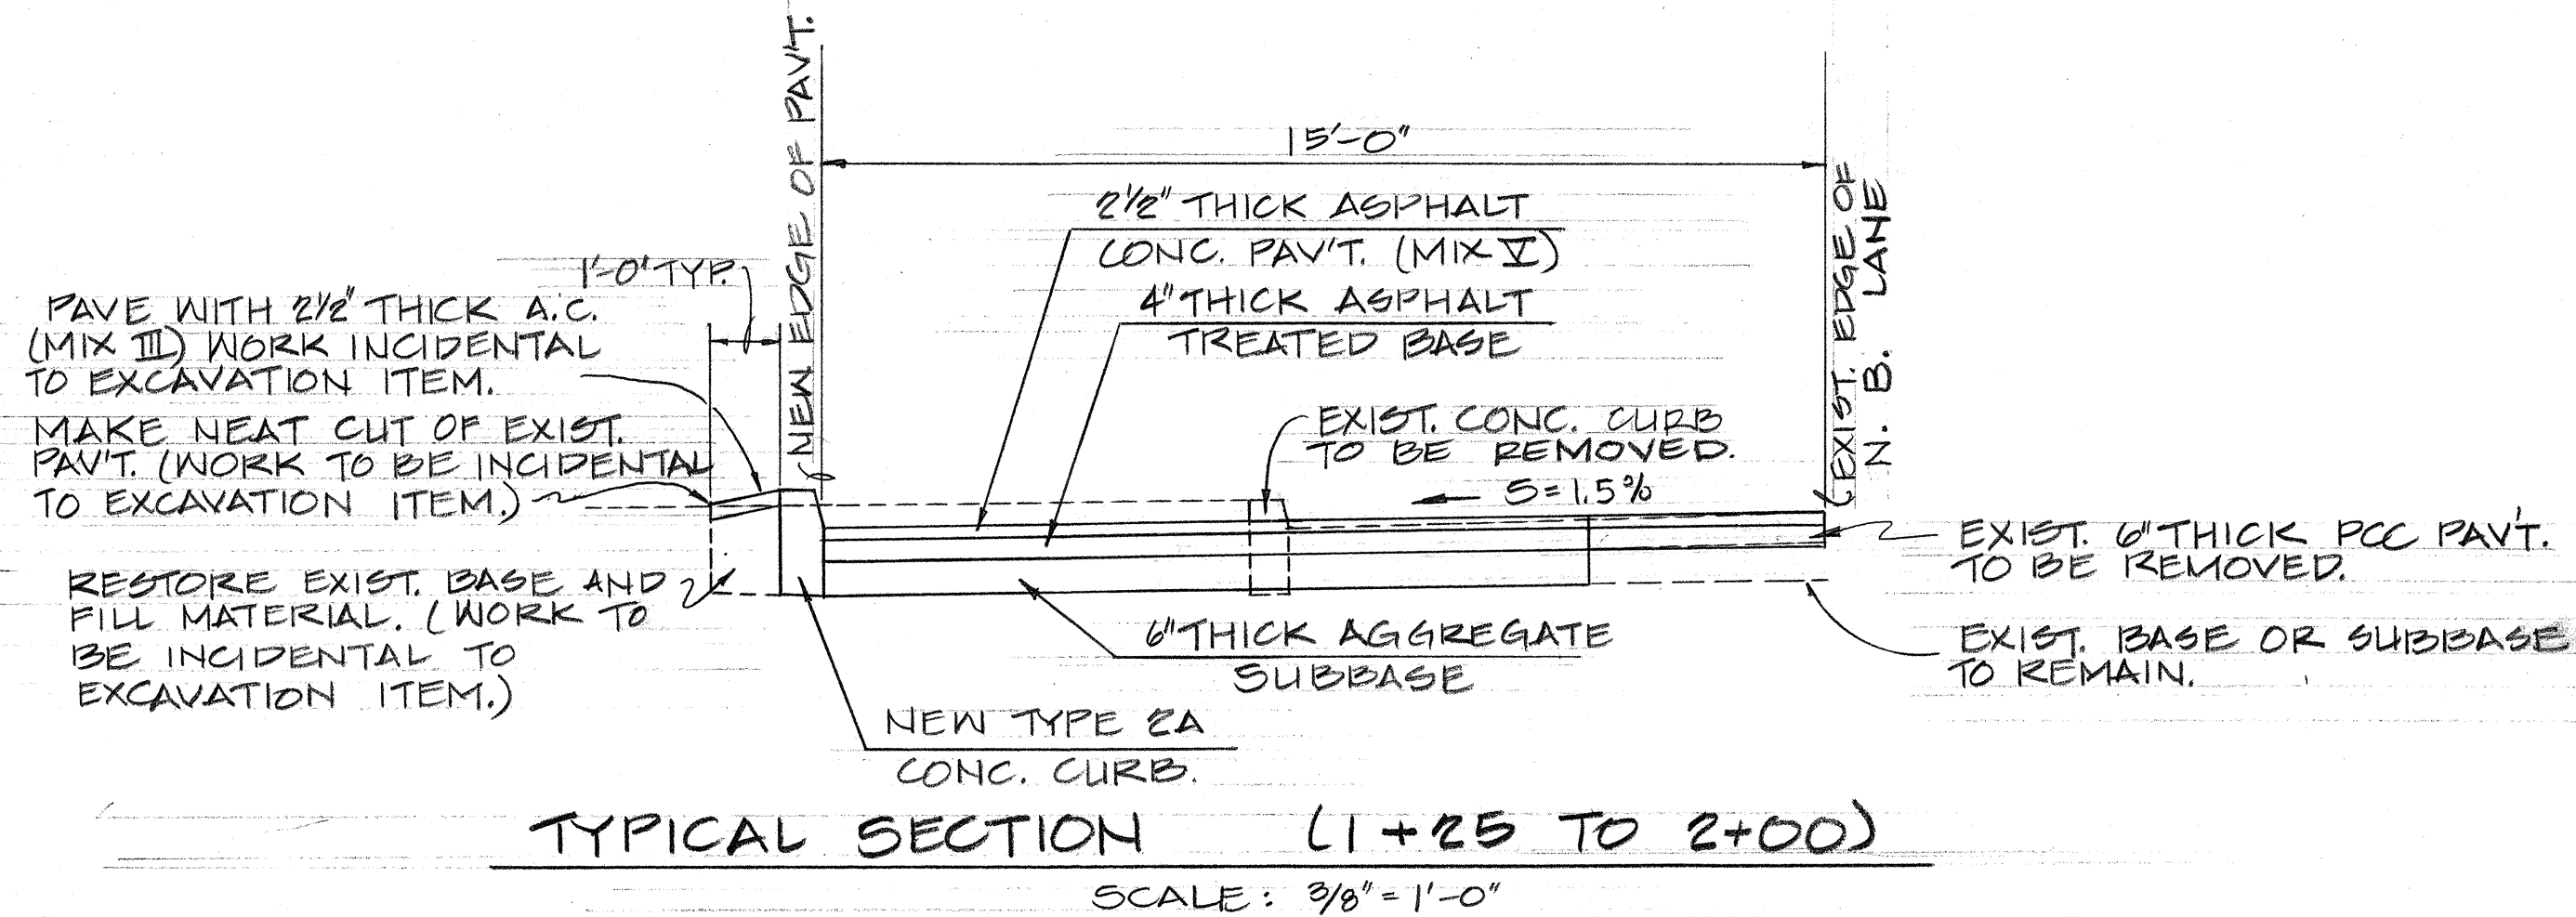


FED. ROAD DIST. NO.	STATE	FED. AID TOPICS PROJ. NO.	FISCAL YEAR	SHEET NO.	TOTAL SHEETS
HAWAII	HAW.	EHS-T-9001(9)	72	3	5

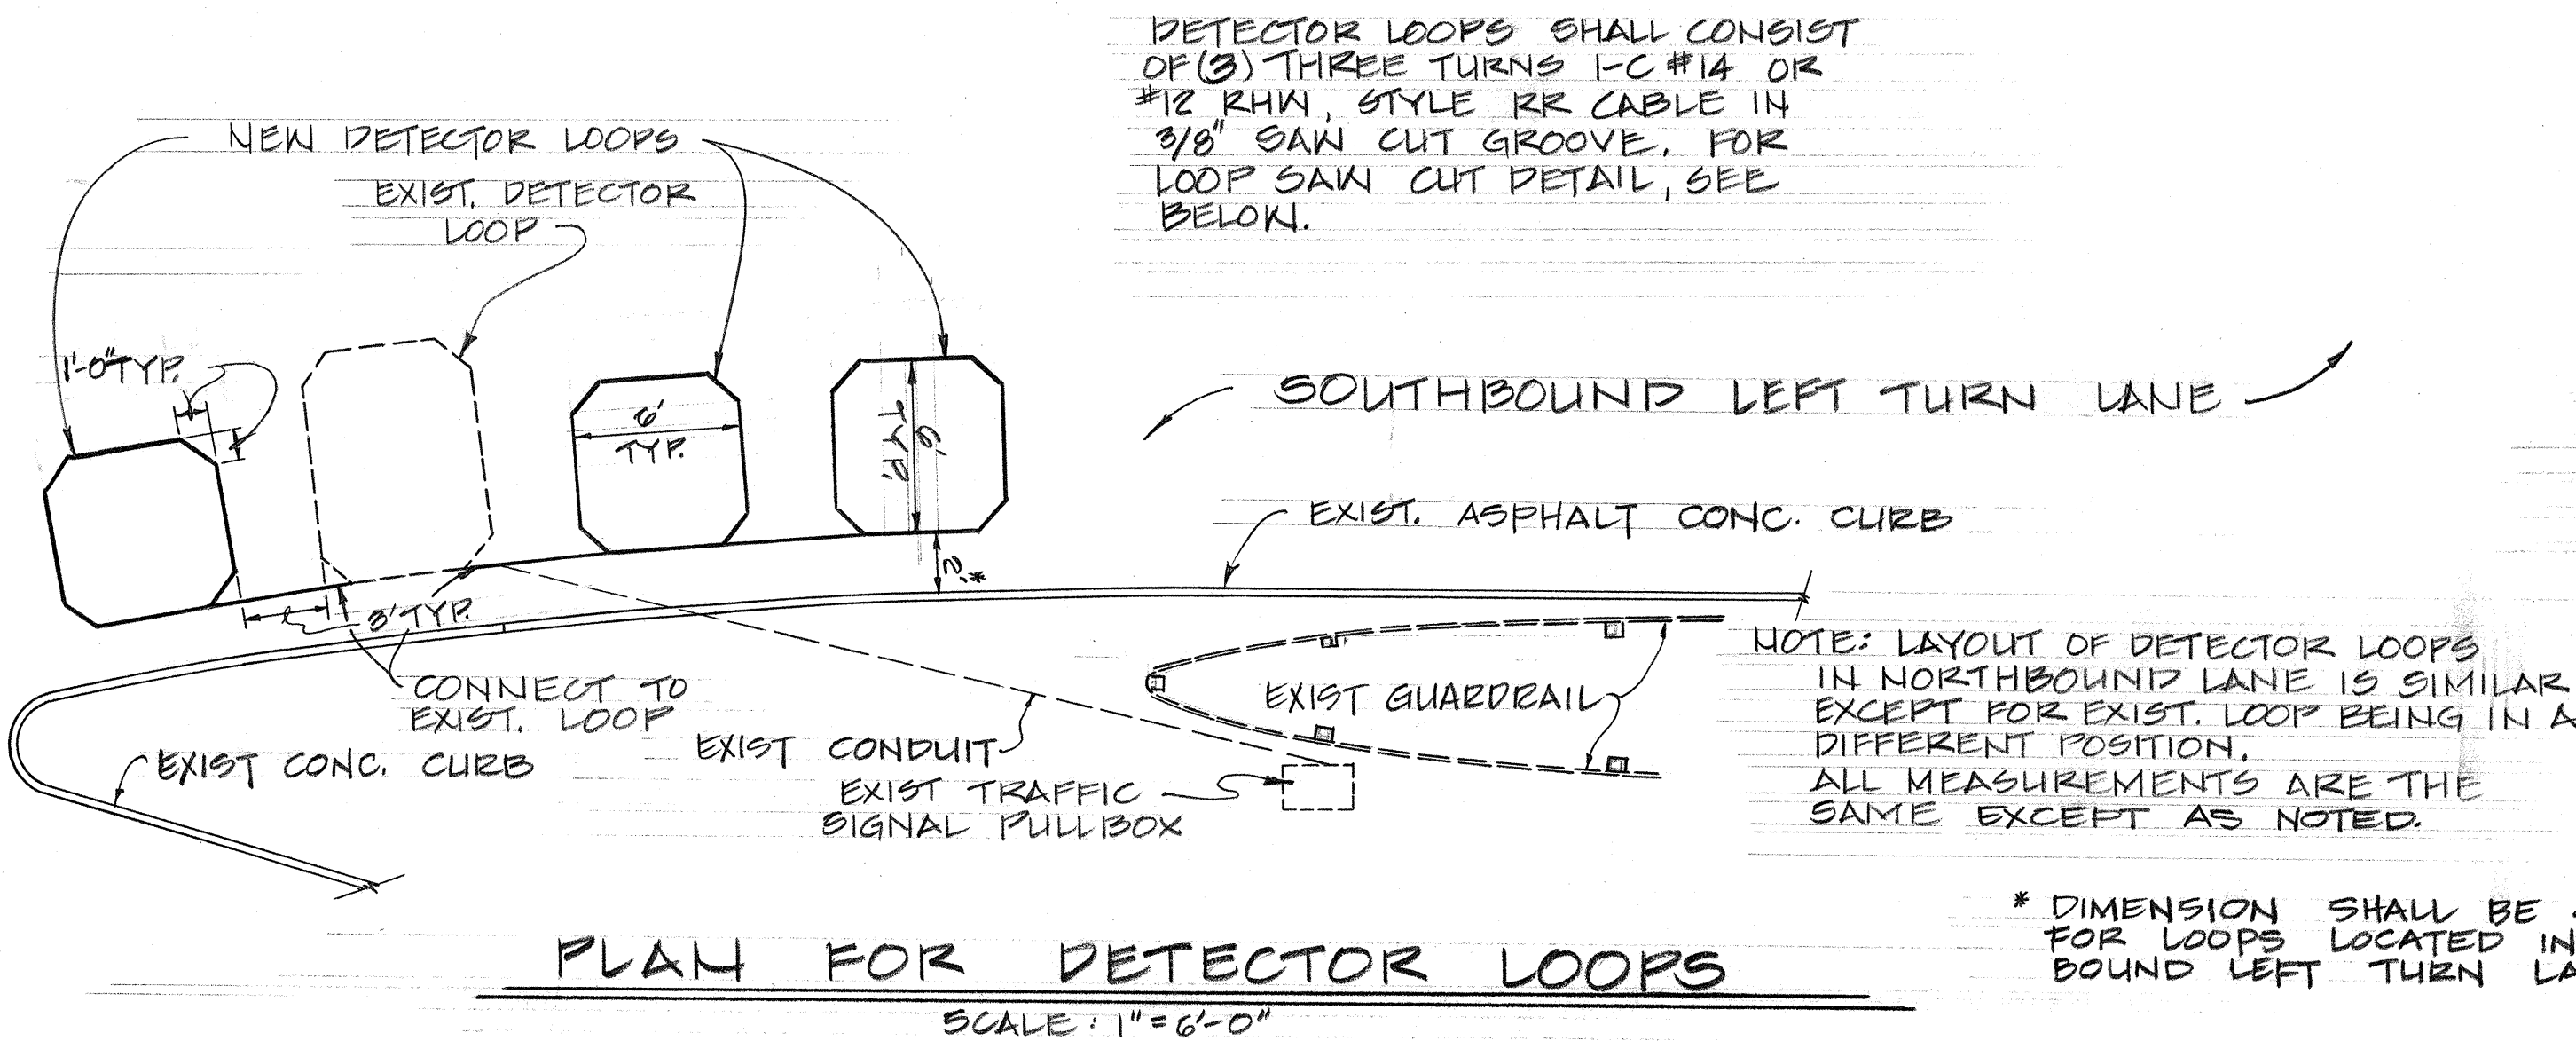

THIS WORK WAS PREPARED BY
ME OR UNDER MY SUPERVISION
Henry Tuck, Jr.
556-5
May 10, 1972

STATE OF HAWAII
DEPARTMENT OF TRANSPORTATION
HIGHWAYS DIVISION

TYPICAL ROAD SECTIONS &
MISCELLANEOUS DETAILS
EXTEND NORTHBOUND
LEFT TURN LANE

LIKELIKE HWY. AT KULA KOLEA DR.
AND NALANIEHA ST.
FED. AID TOPICS PROJ. NO. EHS-T-9001 (9)
SCALE AS SHOWN.

SHEET No. 3 OF 5 SHEETS