

| | | | |
|-------------|---------------|----------|------------|
| DESIGNED BY | R. Mikami | 548-7534 | July, 1972 |
| | P. S. & E. BY | PHONE | DATE |



HONOLULU, HAWAII
"AS BUILT"
PLANS FOR

PROJECT NO. 63A-02-72


DISTRICT OF KOOLAUPOKO
ISLAND OF OAHU

 Federal Aid Projects Previously Constructed or Under Construction

ALL CHANGES MADE DURING CONSTRUCTION
HAVE BEEN NOTED IN RED ON THESE TRACINGS
AND CHECKED BY:

H. Hamaiko
PROJECT ENGINEER
11/12/73
DATE

FOR ACTUAL QUANTITIES, REFER
PROJECT LEDGER AND/OR
COMPUTATION BOOK

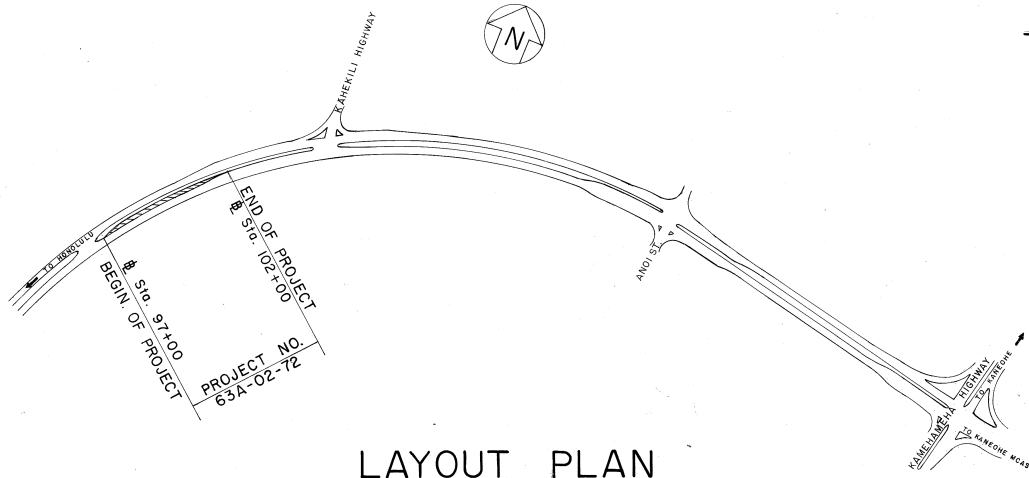

SCALE : 1" = 200'

LENGTH OF PROJECT 0.095 MILE

| | |
|---|----------------|
| DEPARTMENT OF TRANSPORTATION STATE OF HAWAII | |
| APPROVED: | |
| <i>Murray Lee</i> | <i>7/14/72</i> |
| FOR DIR. OF TRANSPORTATION | DATE |