
INDEX TO DRAWINGS	
SHEET NO.	DESCRIPTION
	TITLE SHEET
2	PLAN-LANDSCAPING
3-10	SPRINKLER SYSTEM
11	PROJECT INFORMATION SIG
,	



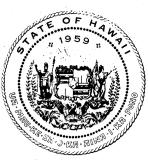

STATE OF HAWAII

TRANSPORTATION DEPARTMENT OF HIGHWAYS DIVISION

HONOLULU, HAWAII


"AS BUILT"

PLANS FOR


KALIHI INTERCHANGE LANDSCAPING AND SPRINKLER SYSTEM

PROJECT NO. 63A-03-72

DISTRICT OF HONOLULU ISLAND OF OAHU

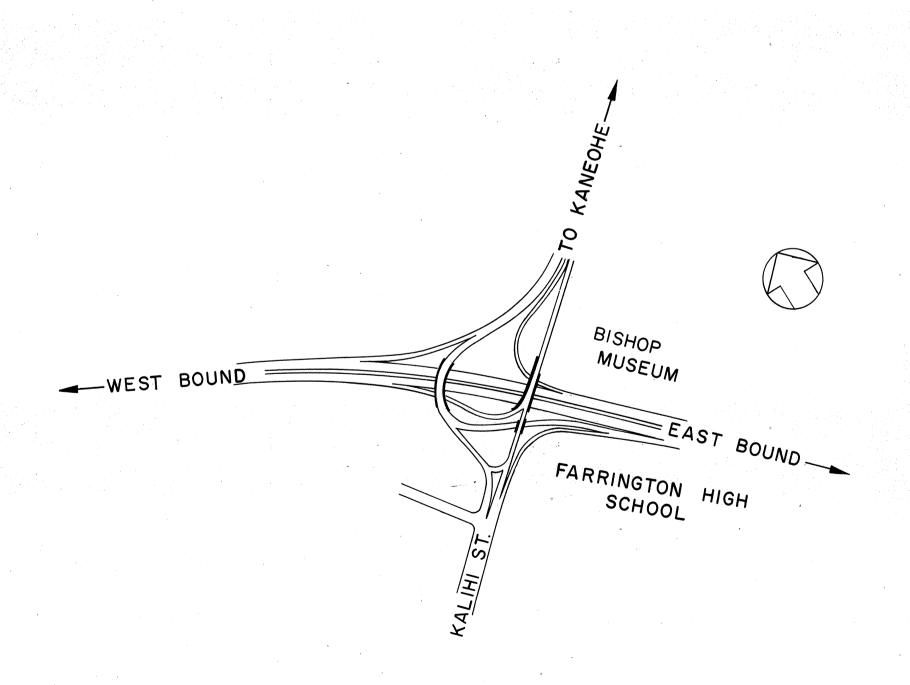

LAYOUT PLAN SCALE: I" = 400'

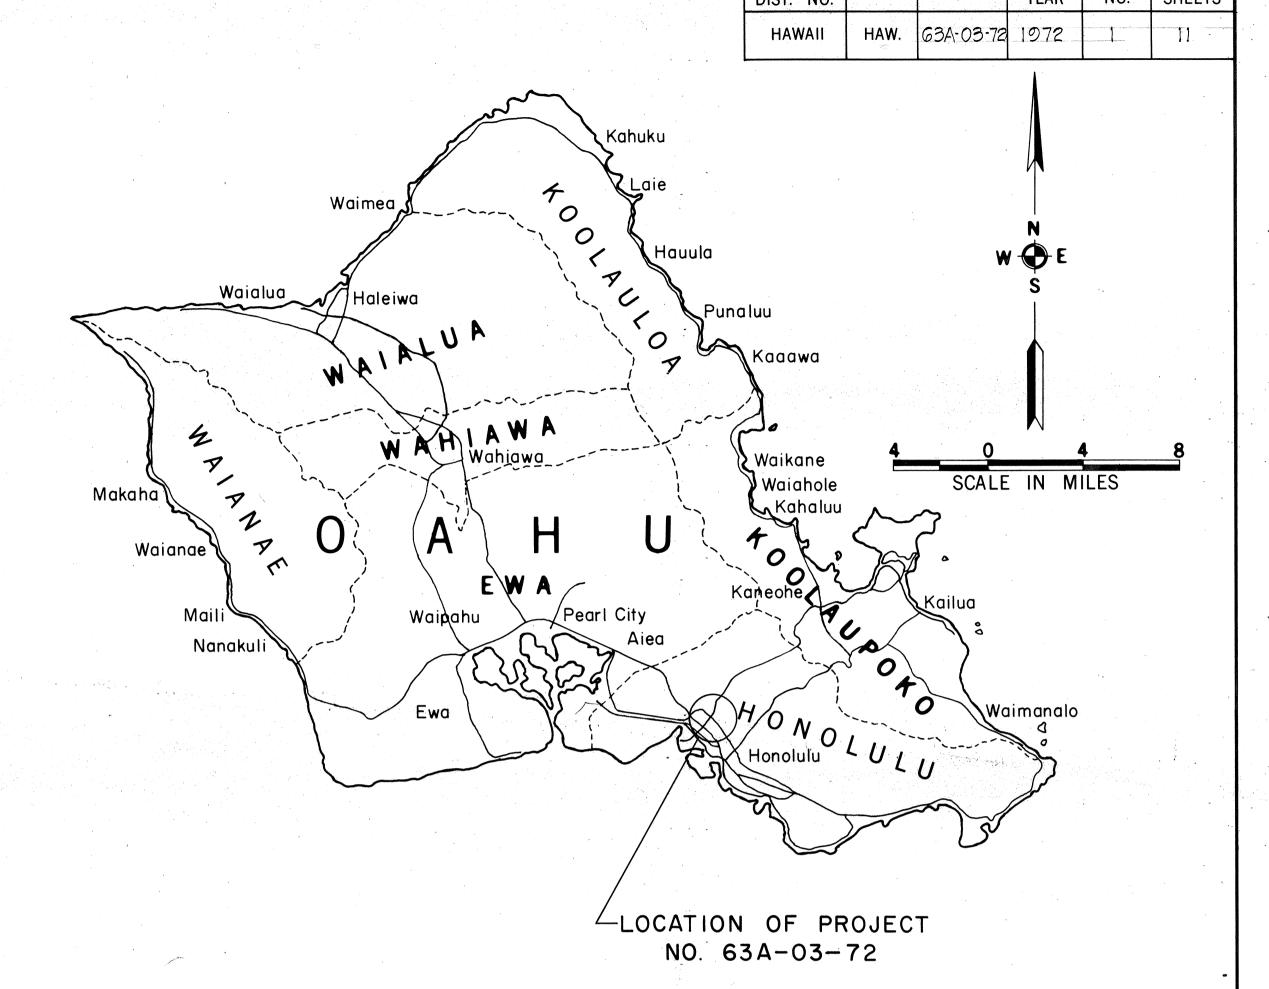

"All changes made during construction have been incorporated on these plans except changes in the original theoretical quantities."

NOTE:

ALL CHANGES MADE DURING CONSTRUCTION HAVE BEEN NOTED IN RED ON THESE TRACINGS AND CHECKED BY:

PROJECT ENGINEER

1-9-75 DATE

