		NDEX TO DRAWINGS	
	SHEET NO.		
l		TITLE SHEET	:
1	2	TYPICAL SECTION	
	3-4	PLAN	
	5-7	PAVEMENT MARKINGS AND TYPICAL DETAILS	
1			
l			
l			
ŀ			
ŀ			
-			

			-

D-4-1



STATE OF HAWAII

DEPARTMENT OF TRANSPORTATION HIGHWAYS DIVISION


HONOLULU, HAWAII


PLANS FOR

KALIHI STREET, RESURFACING H-I TO NIMITZ HIGHWAY

PROJECT NO 63A-01-74

DISTRICT OF HONOLULU ISLAND OF OAHU

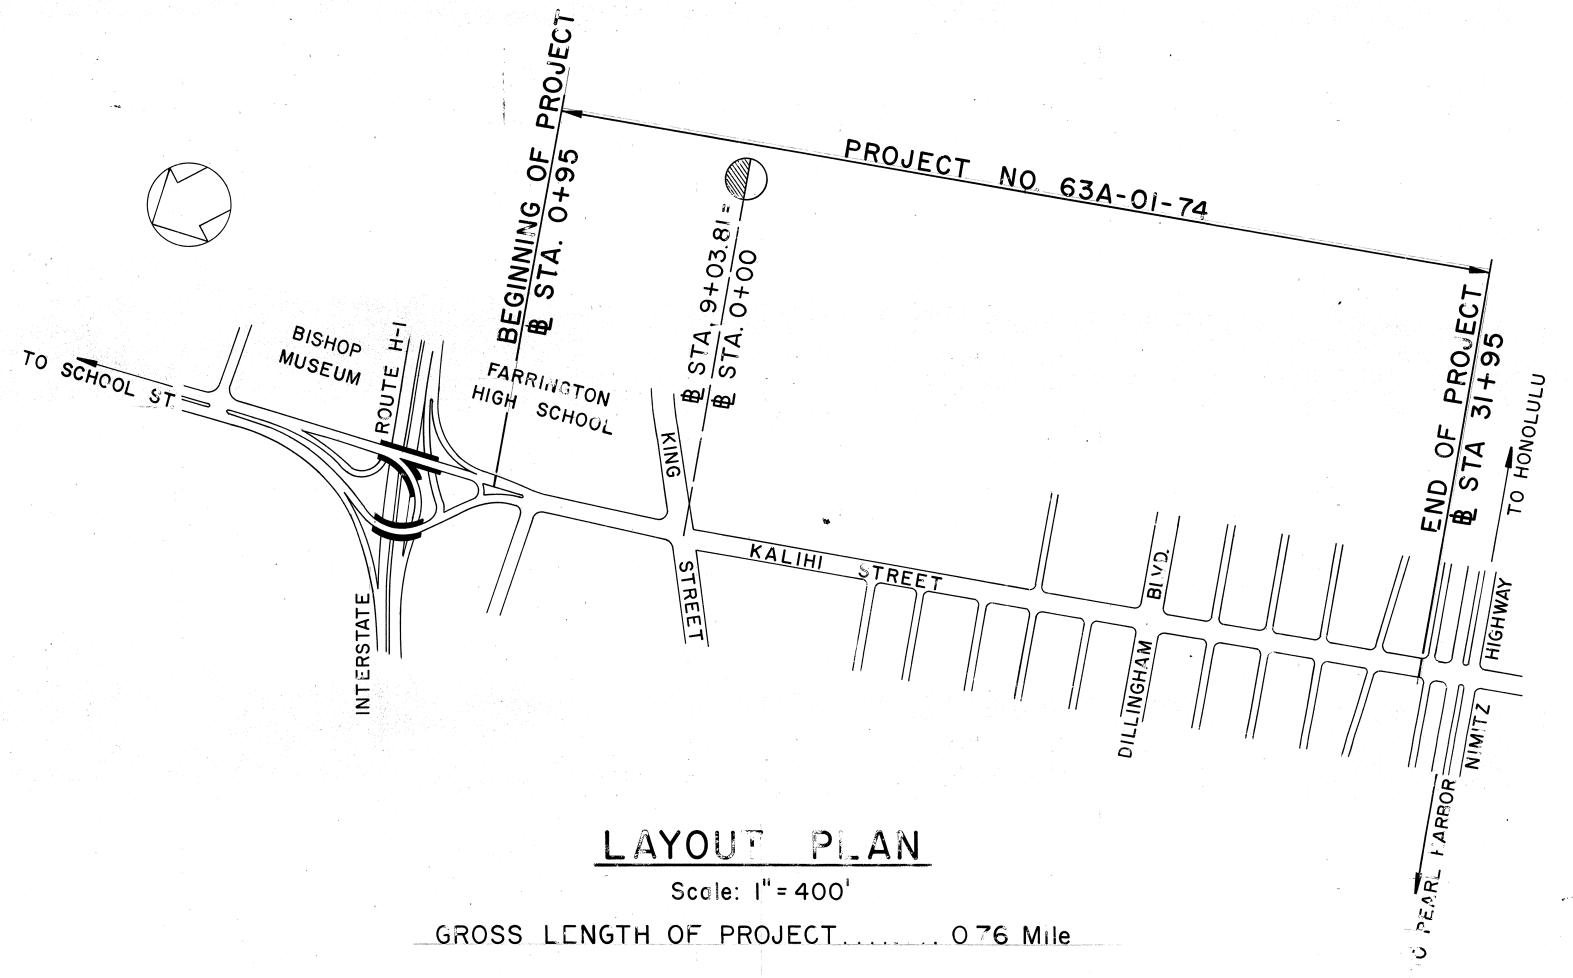

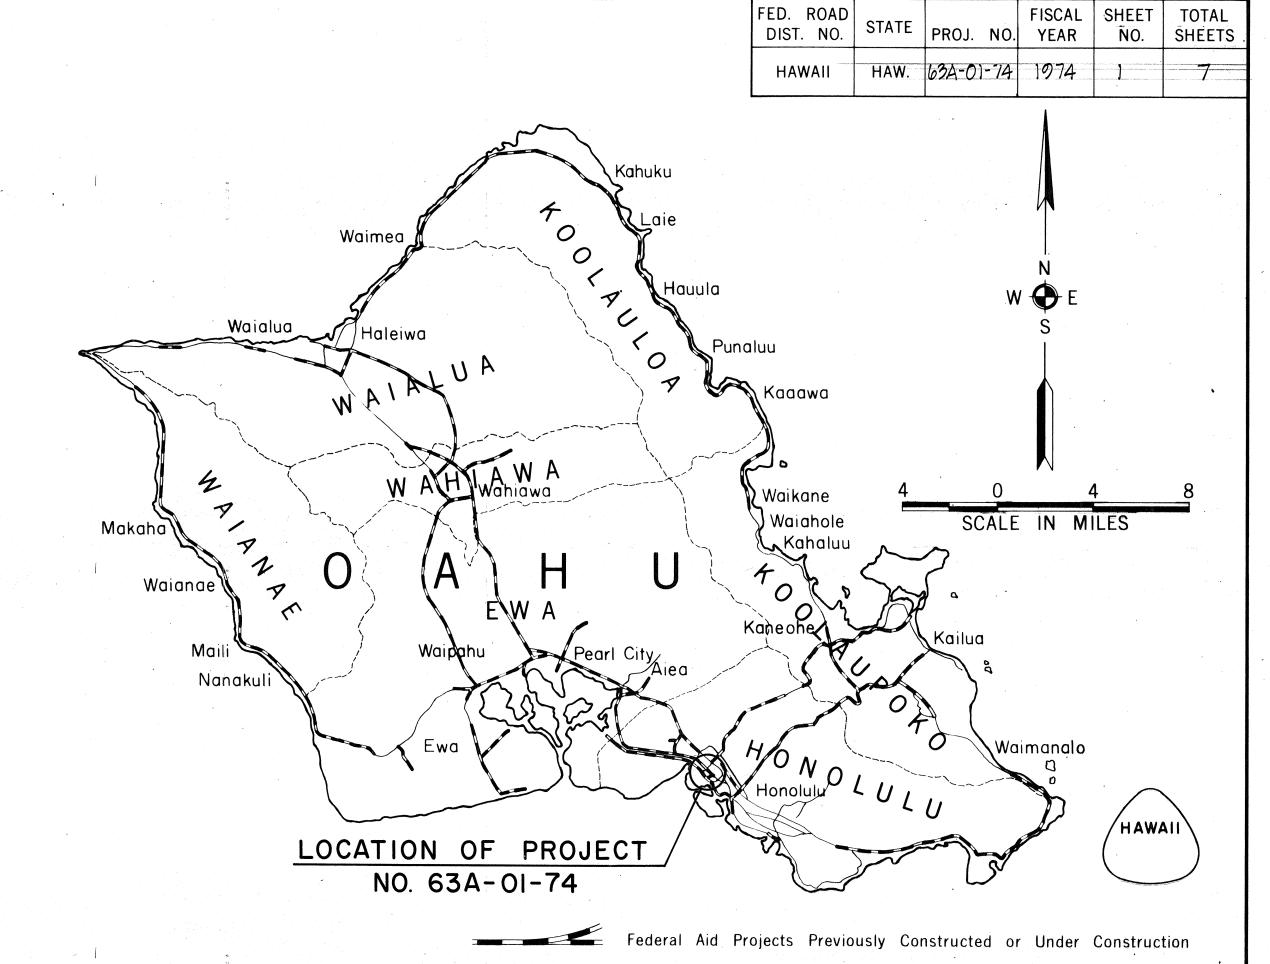

DEPARTMENT OF TRANSPORTATION

STATE OF HAWAII

APPROVED:

Munny Lee 12/18/73

5