
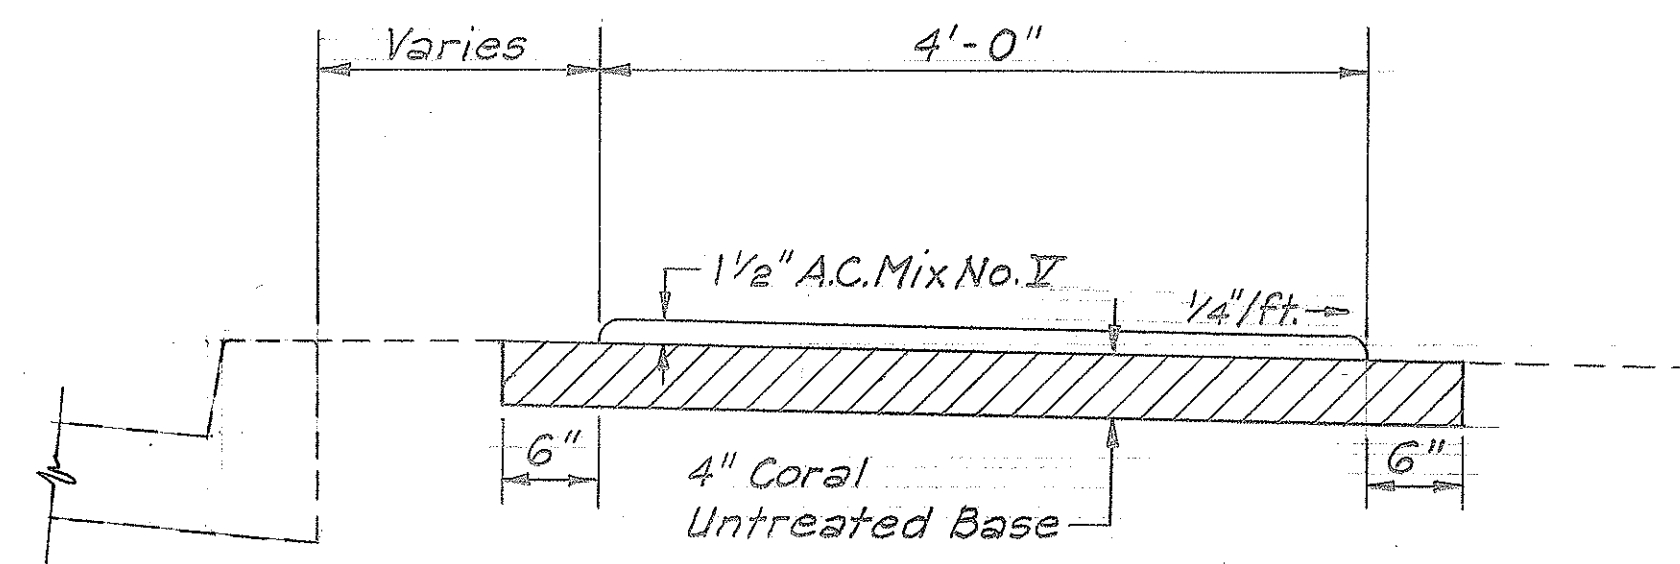
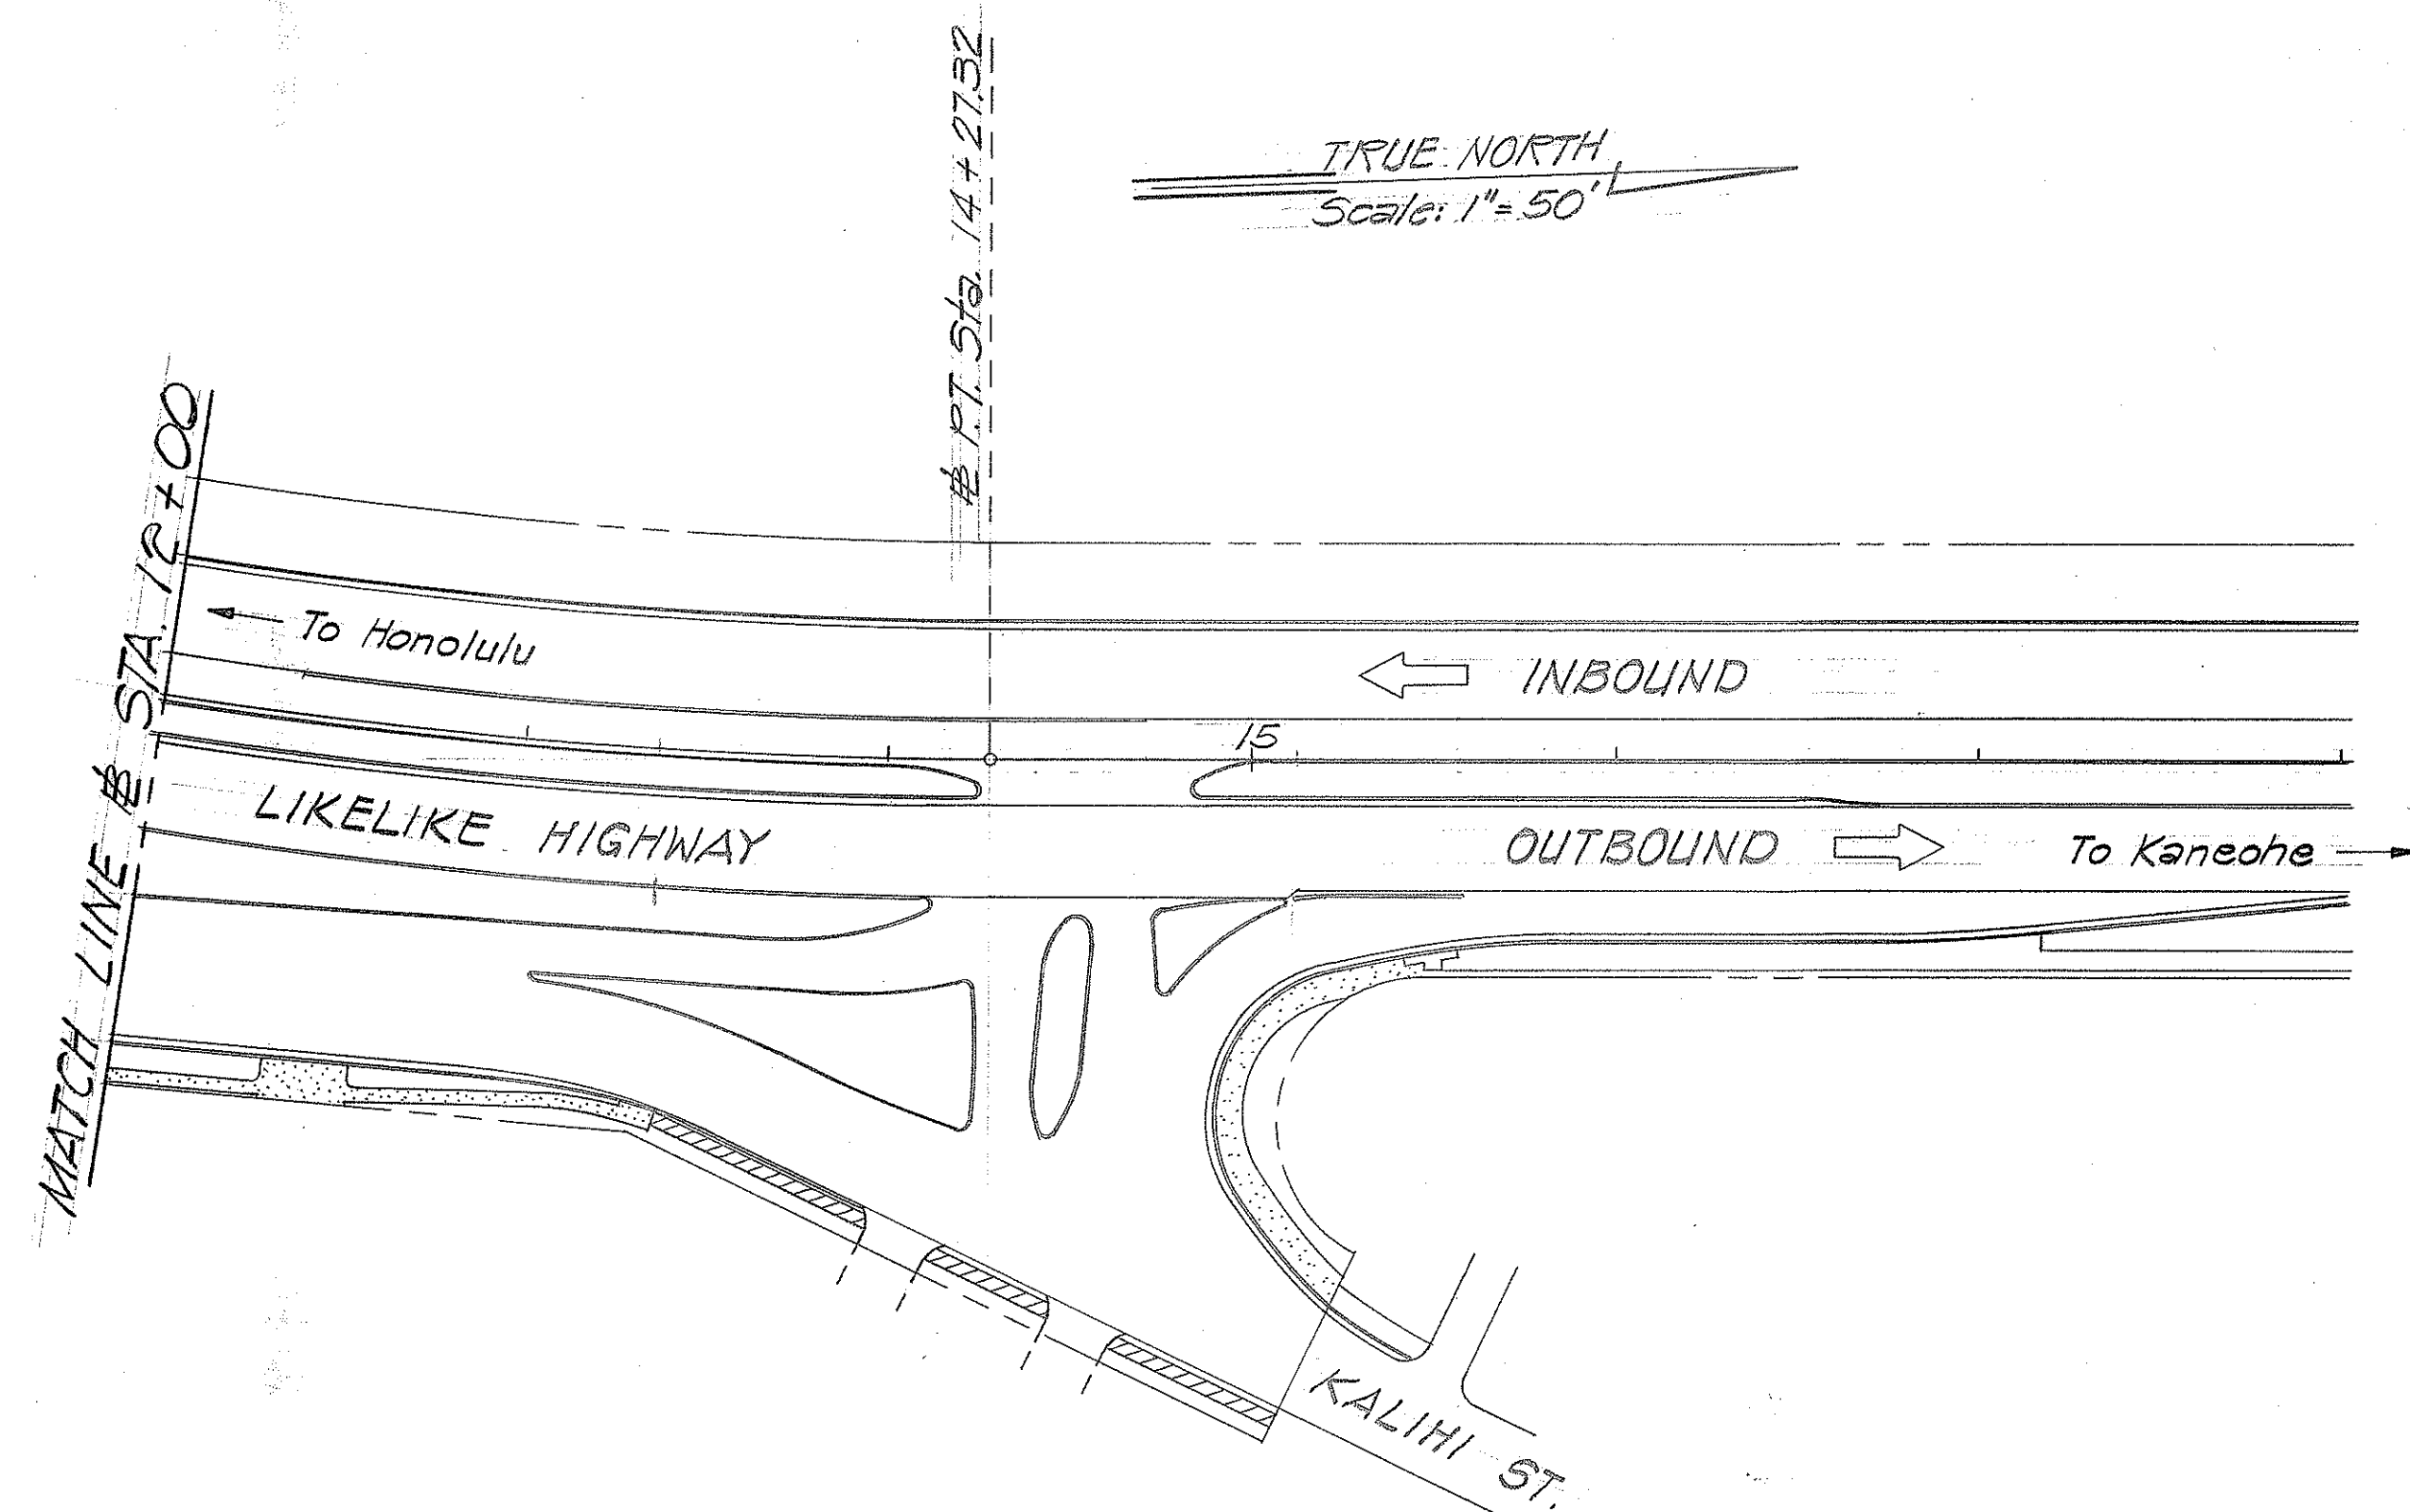


FED. ROAD DIST. NO.	STATE	PROJ. NO.	FISCAL YEAR	SHEET NO.	TOTAL SHEETS
HAWAII	HAW.	63A-01-73	1973	2	2

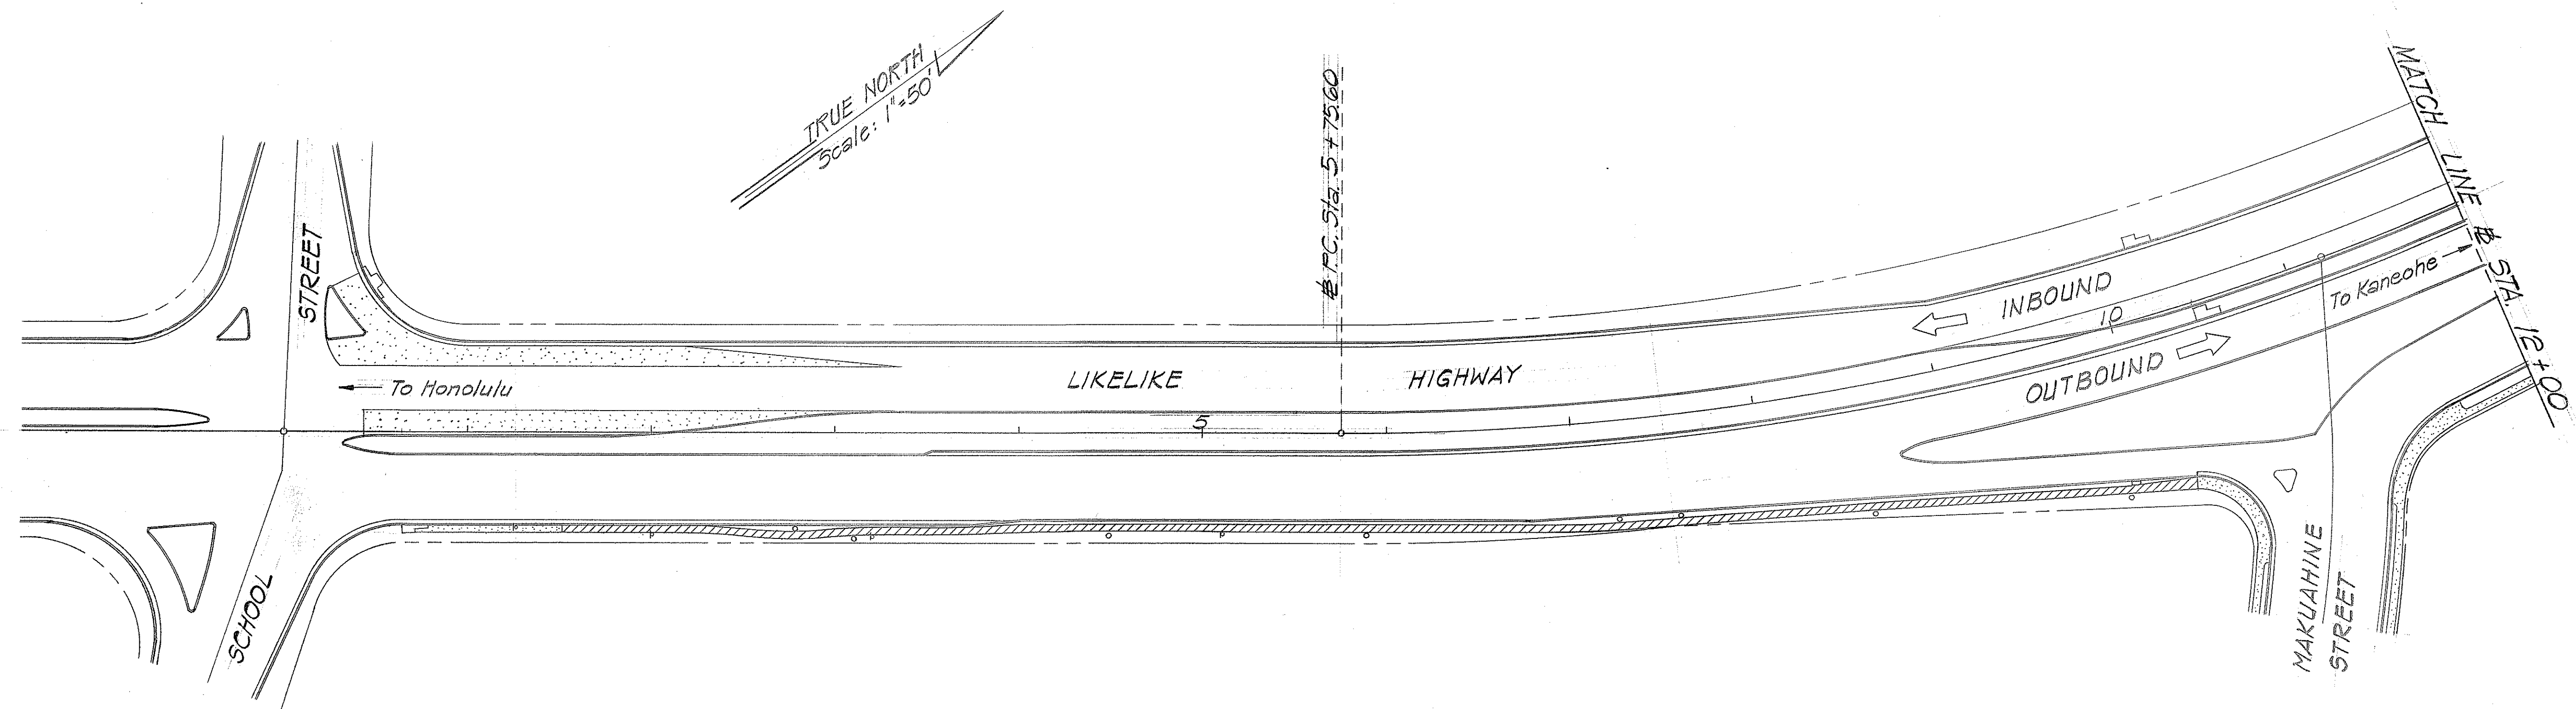

TYPICAL SECTION
Scale: 1" = 1'-0"

ORIGINAL PLAN	DATE
SURVEY PLOTTED BY	
DRAWN BY	
DESIGNED BY	
QUANTITIES BY	
CHECKED BY	

STATE OF HAWAII
DEPARTMENT OF TRANSPORTATION
HIGHWAYS DIVISION

PLAN AND TYPICAL SECTION

LIKELIKE HIGHWAY PEDESTRIAN WALKWAY
School Street to Kalih Street
Proj. No. 63A-01-73

Scale: As Shown Date: Nov, 1973

SHEET No. 1 OF 1 SHEETS