IN	DEX	ТО	DRAV	VINGS		
SHEET NO.		DESCRIPTION				
1	TITL	E SHE	ET			
2	PLAN	1 & T	YPICAL	SECTION		
		2.				
			• •			
	***************************************			***************************************		
		,				



STATE OF HAWAII


DEPARTMENT OF TRANSPORTATION HIGHWAYS DIVISION


"AS BUILT"
PLANS FOR
CONSTRUCTION OF

LIKELIKE HIGHWAY PEDESTRIAN WALKWAY SCHOOL STREET TO KALIHI STREET

PROJECT NO. 63A - 01 - 73

DISTRICT OF HONOLULU ISLAND OF OAHU

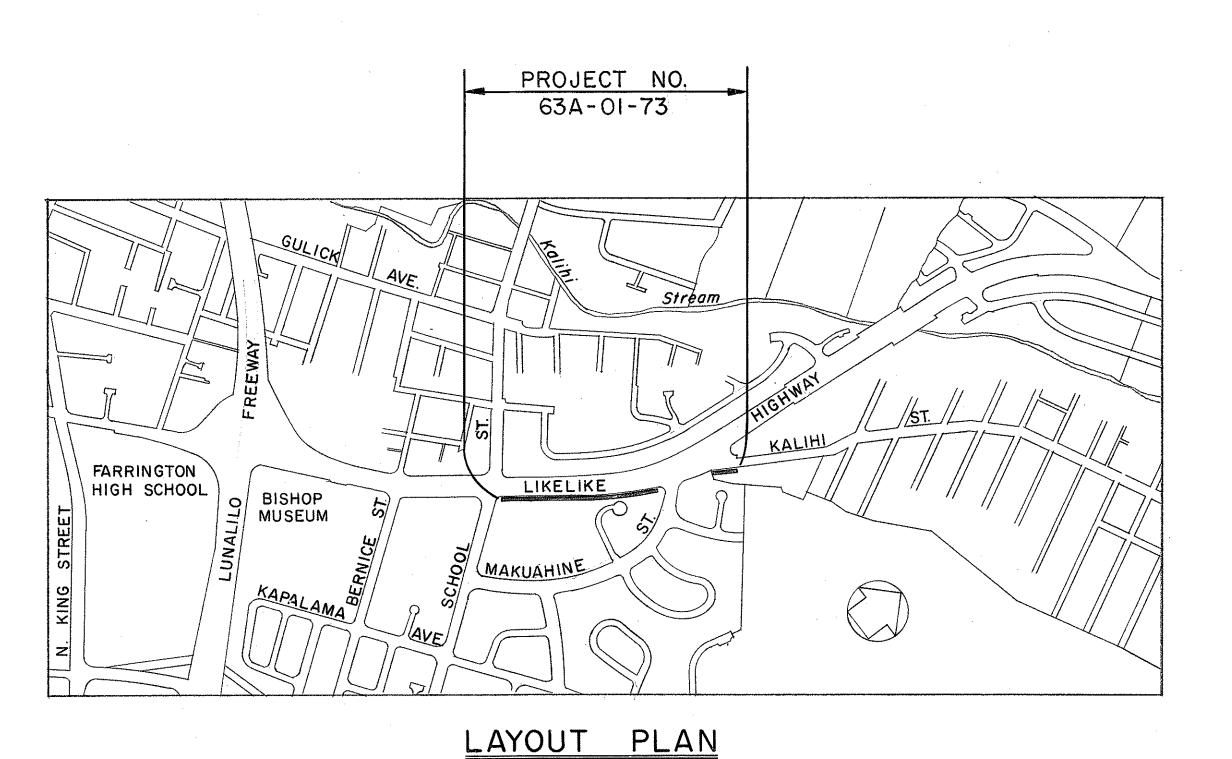

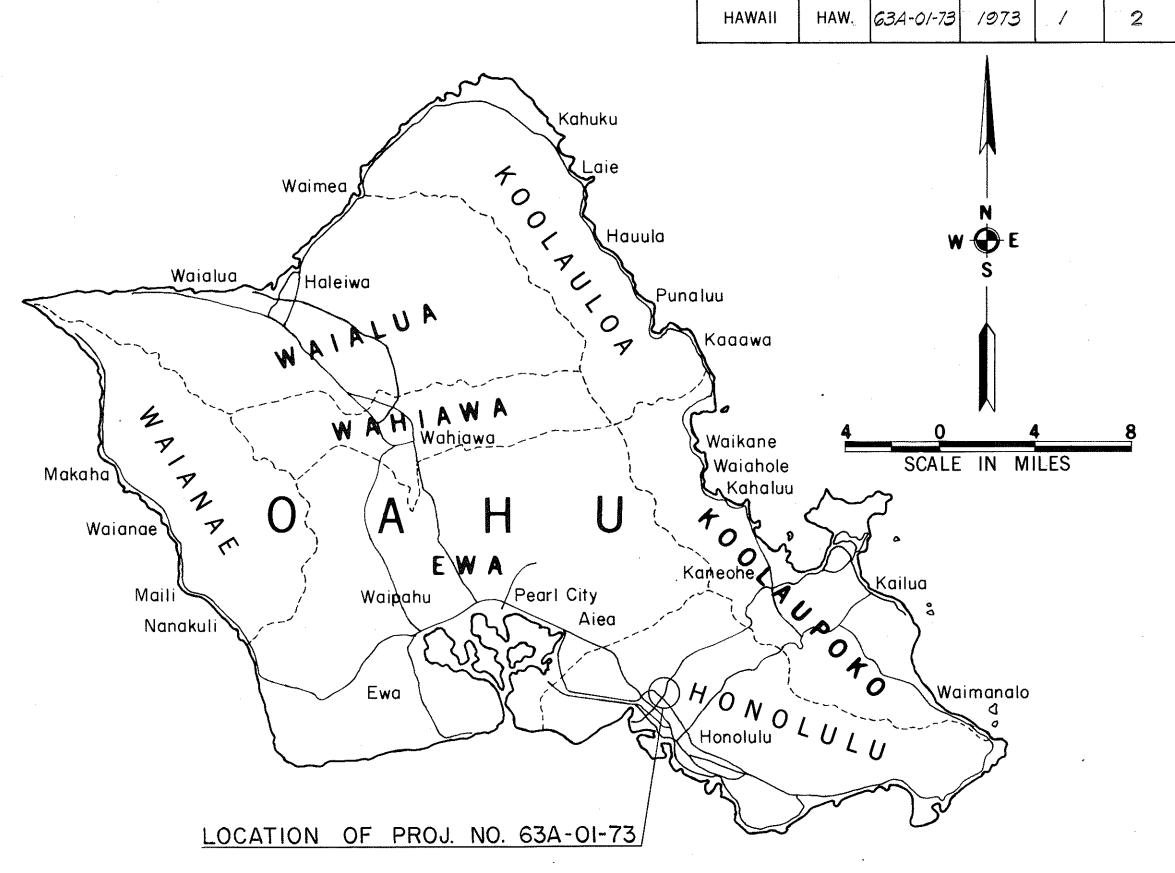

NOTE: No "As Built" Changes

·	DEPARTMENT OF TRANSPOR STATE OF HAWAII	TATION
•	APPROVED:	
	munny Lee	4/19/74
Fo	R DIR. OF TRANSPORTATION	DATE

FISCAL SHEET YEAR NO.