IN	NDEX TO DRAWINGS
SHEET NO.	DESCRIPTION
į.	TITLE SHEET
2	TYP. TURNOUT SECTION
3-4	PLAN AND PROFILE
5-6*	CULVERTS AND DETAIL
0 17	SIGN DETAILS
8-13	STANDARD DETAILS
14 - 15	CROSS SECTIONS
*C05S-1	WALL & DRAINAGE CULVERT
C.O. 3 3 1	DETAILS
	n <sub>Pro-1</sub> ,
. 1	
WINDOWS	
·'.	
William 11 11 11 11 11 11 11 11 11 11 11 11 11	· · · · · · · · · · · · · · · · · · ·
,	
	× \o^{\dagger}
	4/12
4.	E/Z
-6932 June, 1974 HONE DATE	50 74 (F. 1400) 1 1 1 1 1 1 1 1 1 1 1 1 1 1 1 1 1 1
A G	
<i>€</i>   □	· ///



STATE OF HAWAII

DEPARTMENT OF TRANSPORTATION HIGHWAYS DIVISION

HONOLULU, HAWAII

"AS-BUILT"

PLANS FOR

CONSTRUCTION OF

## EMERGENCY TRUCK TURNOUTS ON LIKELIKE HIGHWAY

FEDERAL AID PROJECT NO. F-063-1(5)
DISTRICTS OF HONOLULU AND KOOLAUPOKO
ISLAND OF OAHU

## SCALES:

PLAN & PROFILE

VER. I" = 10'

HOR. I" = 50'

VER. I" = 10'


VER.

KANEOHE SITE

LAYOUT PLAN

LENGTH OF PROJECT . . . . O.16 MILE 0 400 800 1200

SCALE IN FEET

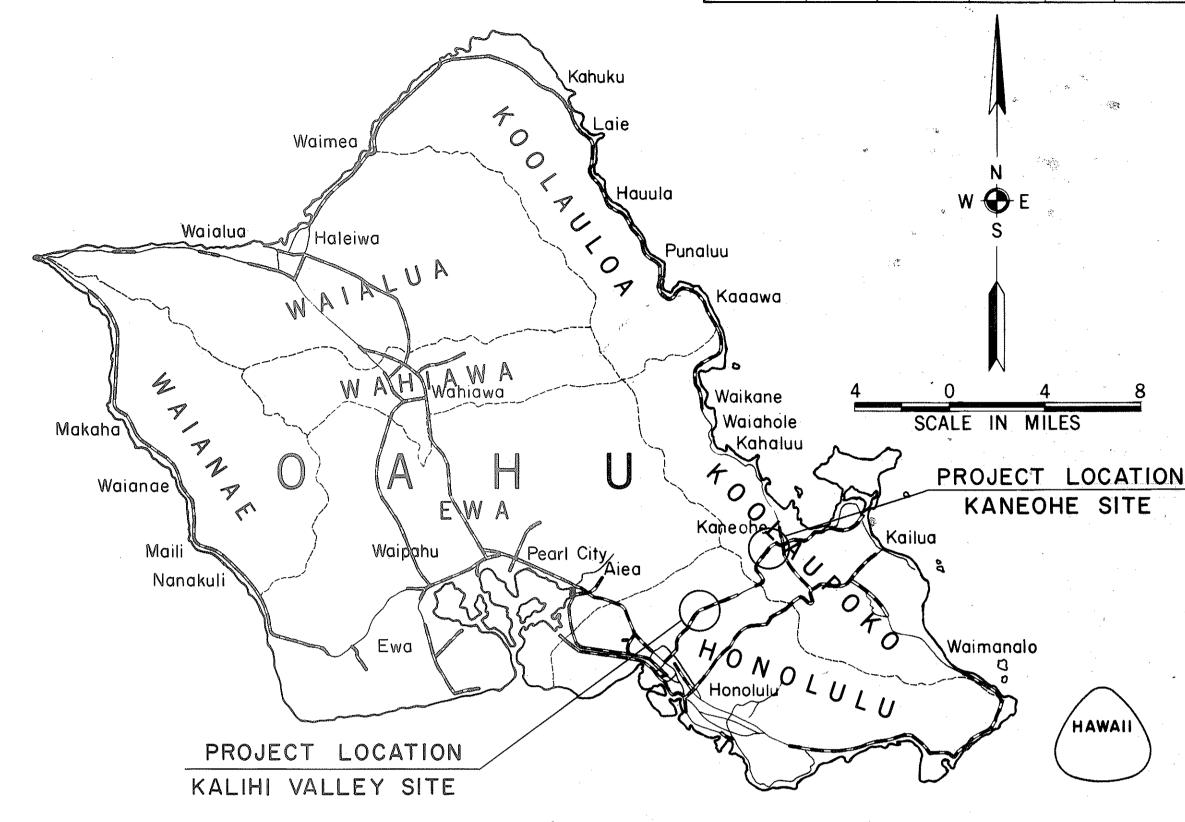

Federal Aid Projects Previously Constructed or Under Construction ALL CHANGES MADE DURING CONSTRUCTION HAVE BEEN INCORPORATED ON THESE PLANS IN RED EXCEPT CHANGES IN THE ORIGINAL THEORETICAL QUANTITIES, FOR ACTUAL QUANTITIES, REFER TO PROJECT LEDGER AND/OR COMPUTATION BOOK.

FED. ROAD DIST. NO.

STATE FED. AID FISCAL SHEET TOTAL PROJ. NO. YEAR NO. SHEETS

HAW. F-063-I(5) 1974

PROJECT ENGINEER

Dennin T. Hela

DESIGN CLASSIFICATION

DATE



THIS WORK WAS PREPARED BY ME OR UNDER MY SUPERVISION.

conteny of flinak

DEPARTMENT OF TRANSPORTATION
FEDERAL HIGHWAY ADMINISTRATION

APPROVED:

MUMILIAN 7.17.74

MOIVISION ENGINEER DATE

DEPARTMENT OF TRANSPORTATION
STATE OF HAWAII
APPROVED:

FOR DIR. OF TRANSPORTATION DATE

KALIHI VALLEY SITE

LAYOUT PLAN

LENGTH OF PROJECT . . . . 0.16 MILE

0 400 800 1200

KALIHI VALLEY

TURNOUT

FA PROJ.

NO. F-063-1(5)

SCALE IN FEET

S